

LATERAL 10, MAIN 9 SOUTHWEST INTERCEPTOR SEWER CITY OF WICHITA, KANSAS

M.E. LINDEBAK CITY ENGINEER

PROJECT NO. 468-76-245-81463-000-000-001

*As Built
9-85
Jfl*

INDEX OF SHEETS


SHEET NO.	DESCRIPTION
1	TITLE SHEET
2-3	PLAN & PROFILES
4-6	STANDARDS

NOTIFY THE FOLLOWING COMPANIES
PRIOR TO ANY TRENCHING.

ARKLA GAS CO.	942-8350
BELL TELEPHONE	268-3087
CABLEVISION	266-6817
GAS SERVICE CO.	263-7511
KANSAS GAS & ELEC.	261-6248
KANSAS ONE-CALL	1-800-DIG-SAFE
CALL BEFORE YOU DIG	1-800-571-2115

THE CONTRACTOR SHALL BE RESPONSIBLE FOR
PRESERVING PROPERTY IRONS. THE CONTRACTOR
SHALL BE REQUIRED TO ESTABLISH ANY PRO-
PERTY IRONS WHICH ARE DAMAGED OR DESTROYED
BY HIS CONSTRUCTION OPERATIONS. SUCH IRONS
SHALL BE RE-ESTABLISHED BY A LICENSED LAND
SURVEYOR OR A LICENSED PROFESSIONAL ENGINE-
ER IN ACCORDANCE WITH STATE LAWS.

DATE: JUNE 1985

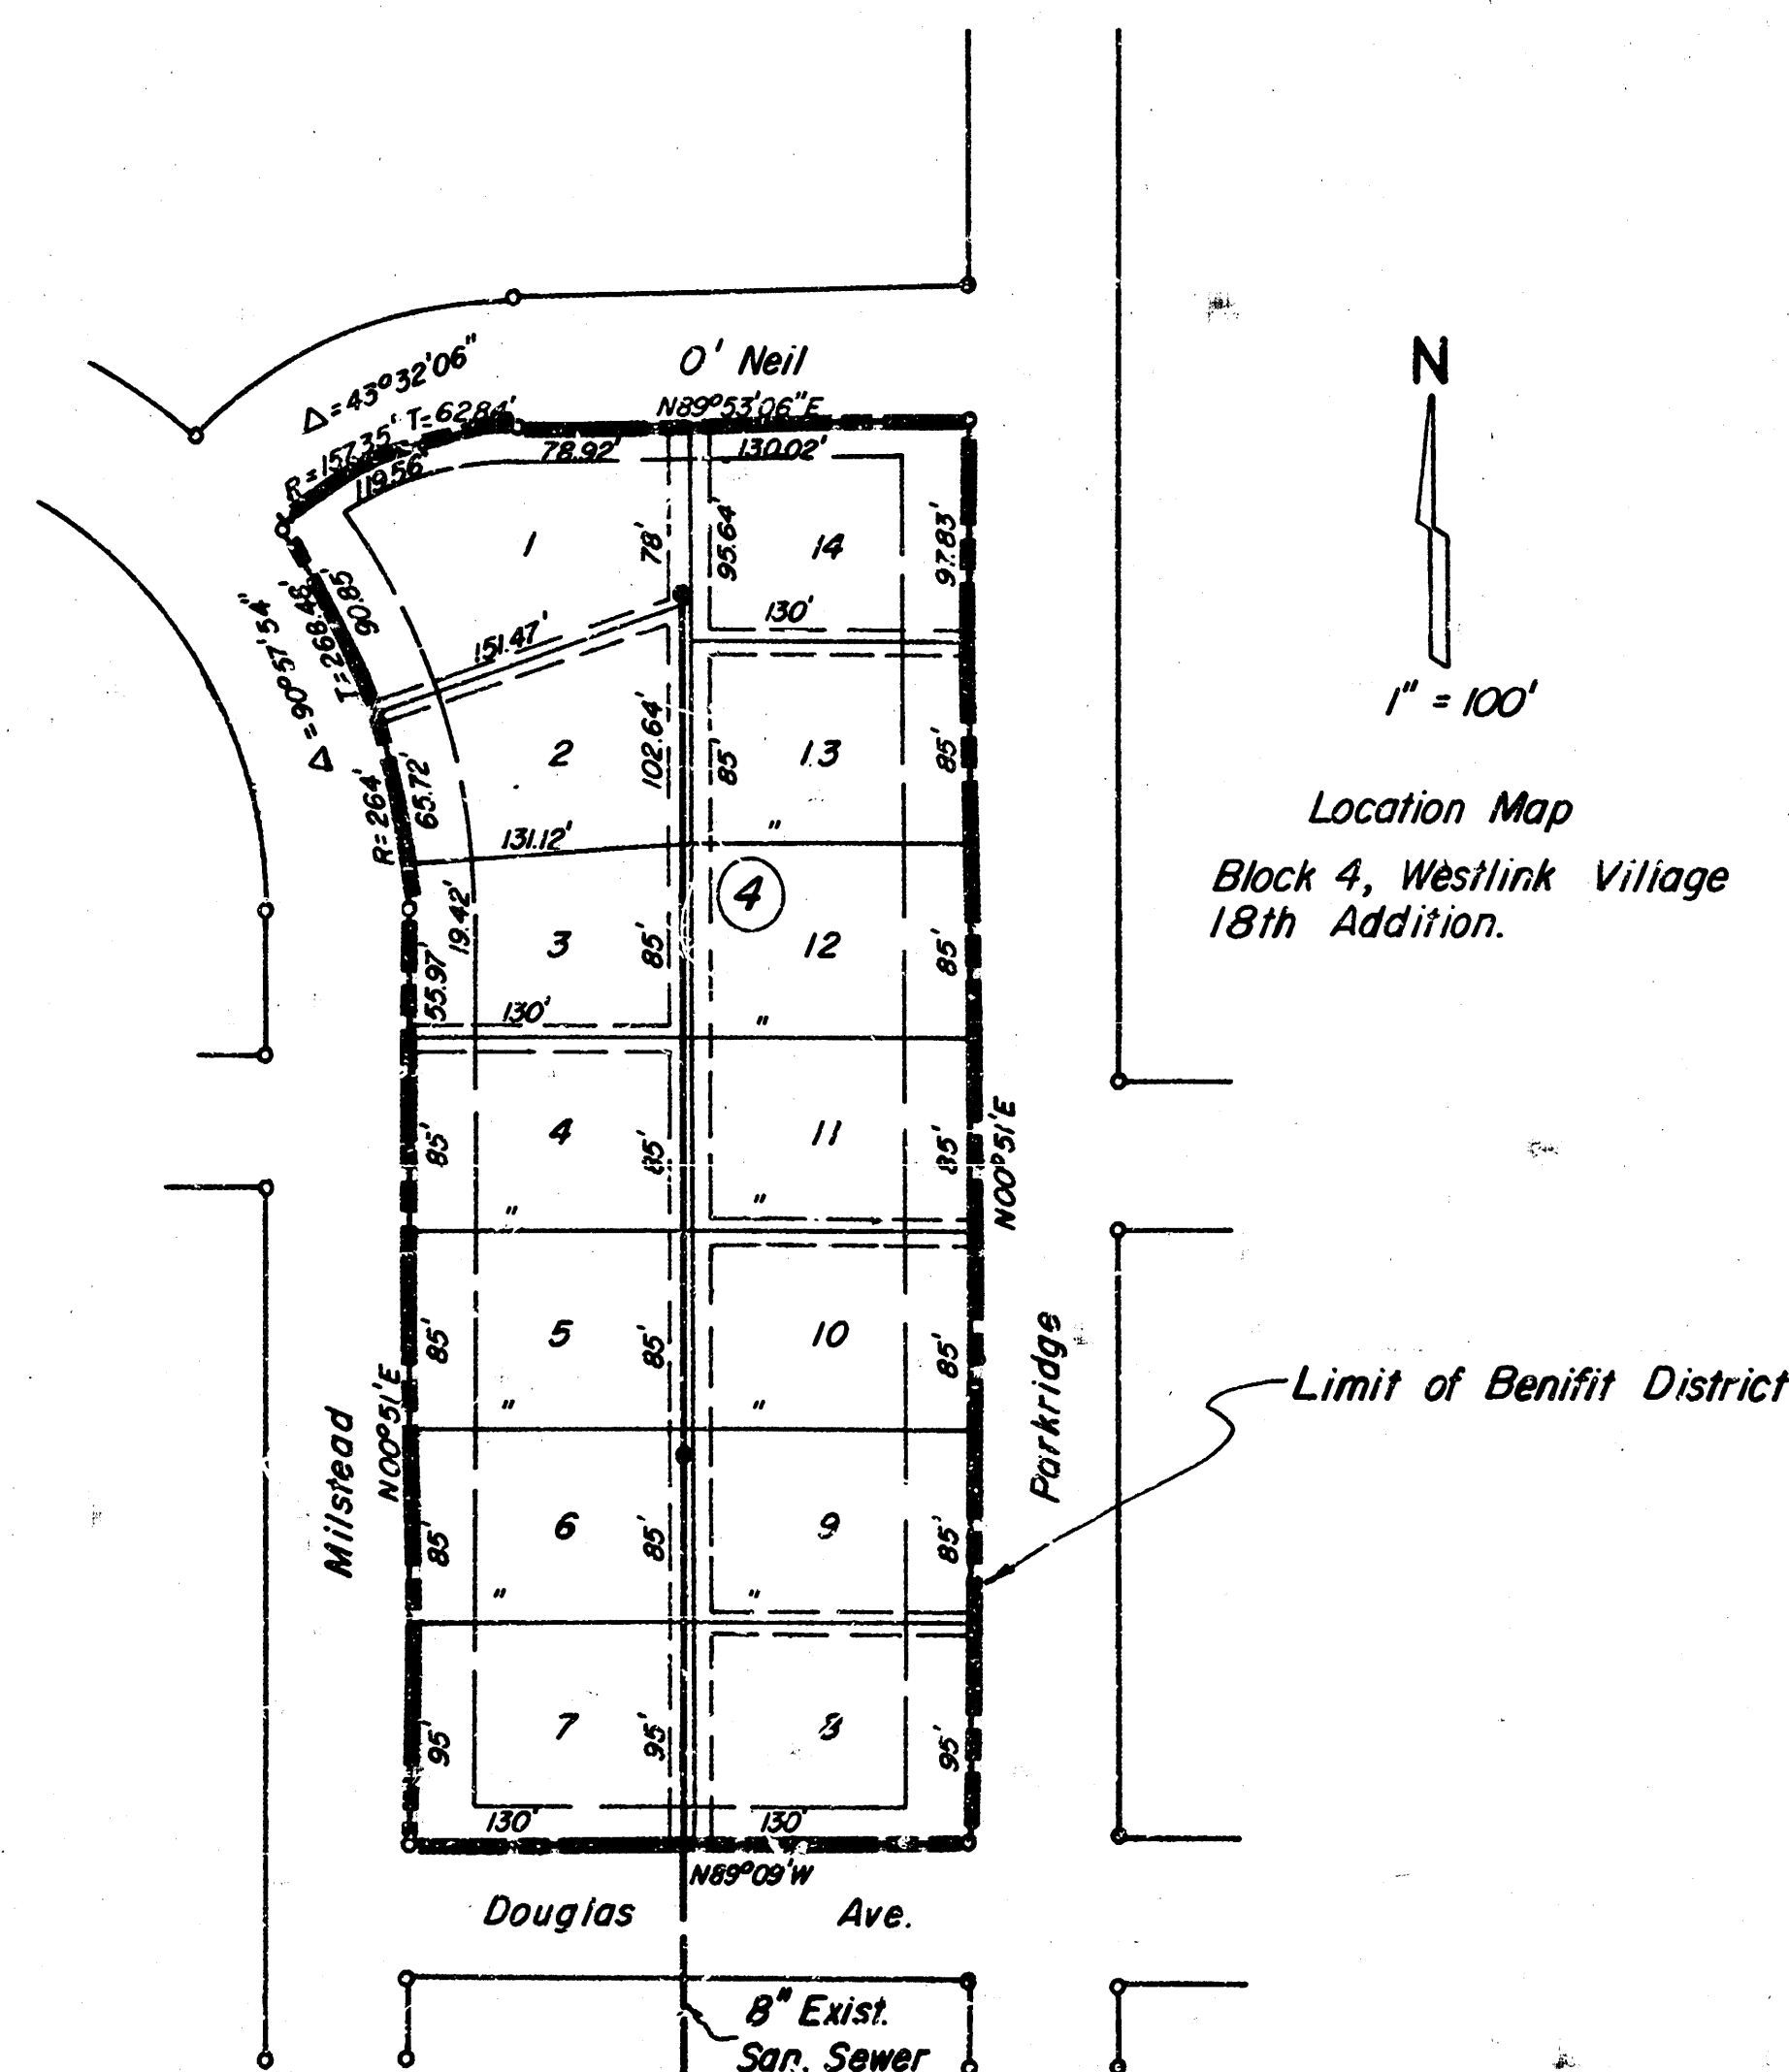



MOEHRING & ASSOCIATES
CONSULTING ENGINEERS
WICHITA




1/3

Sheet 1 of 6

FILMED FROM THE BEST
AVAILABLE COPY

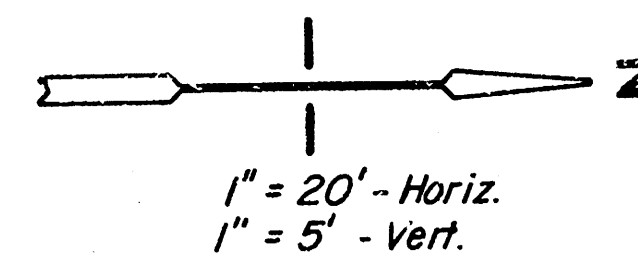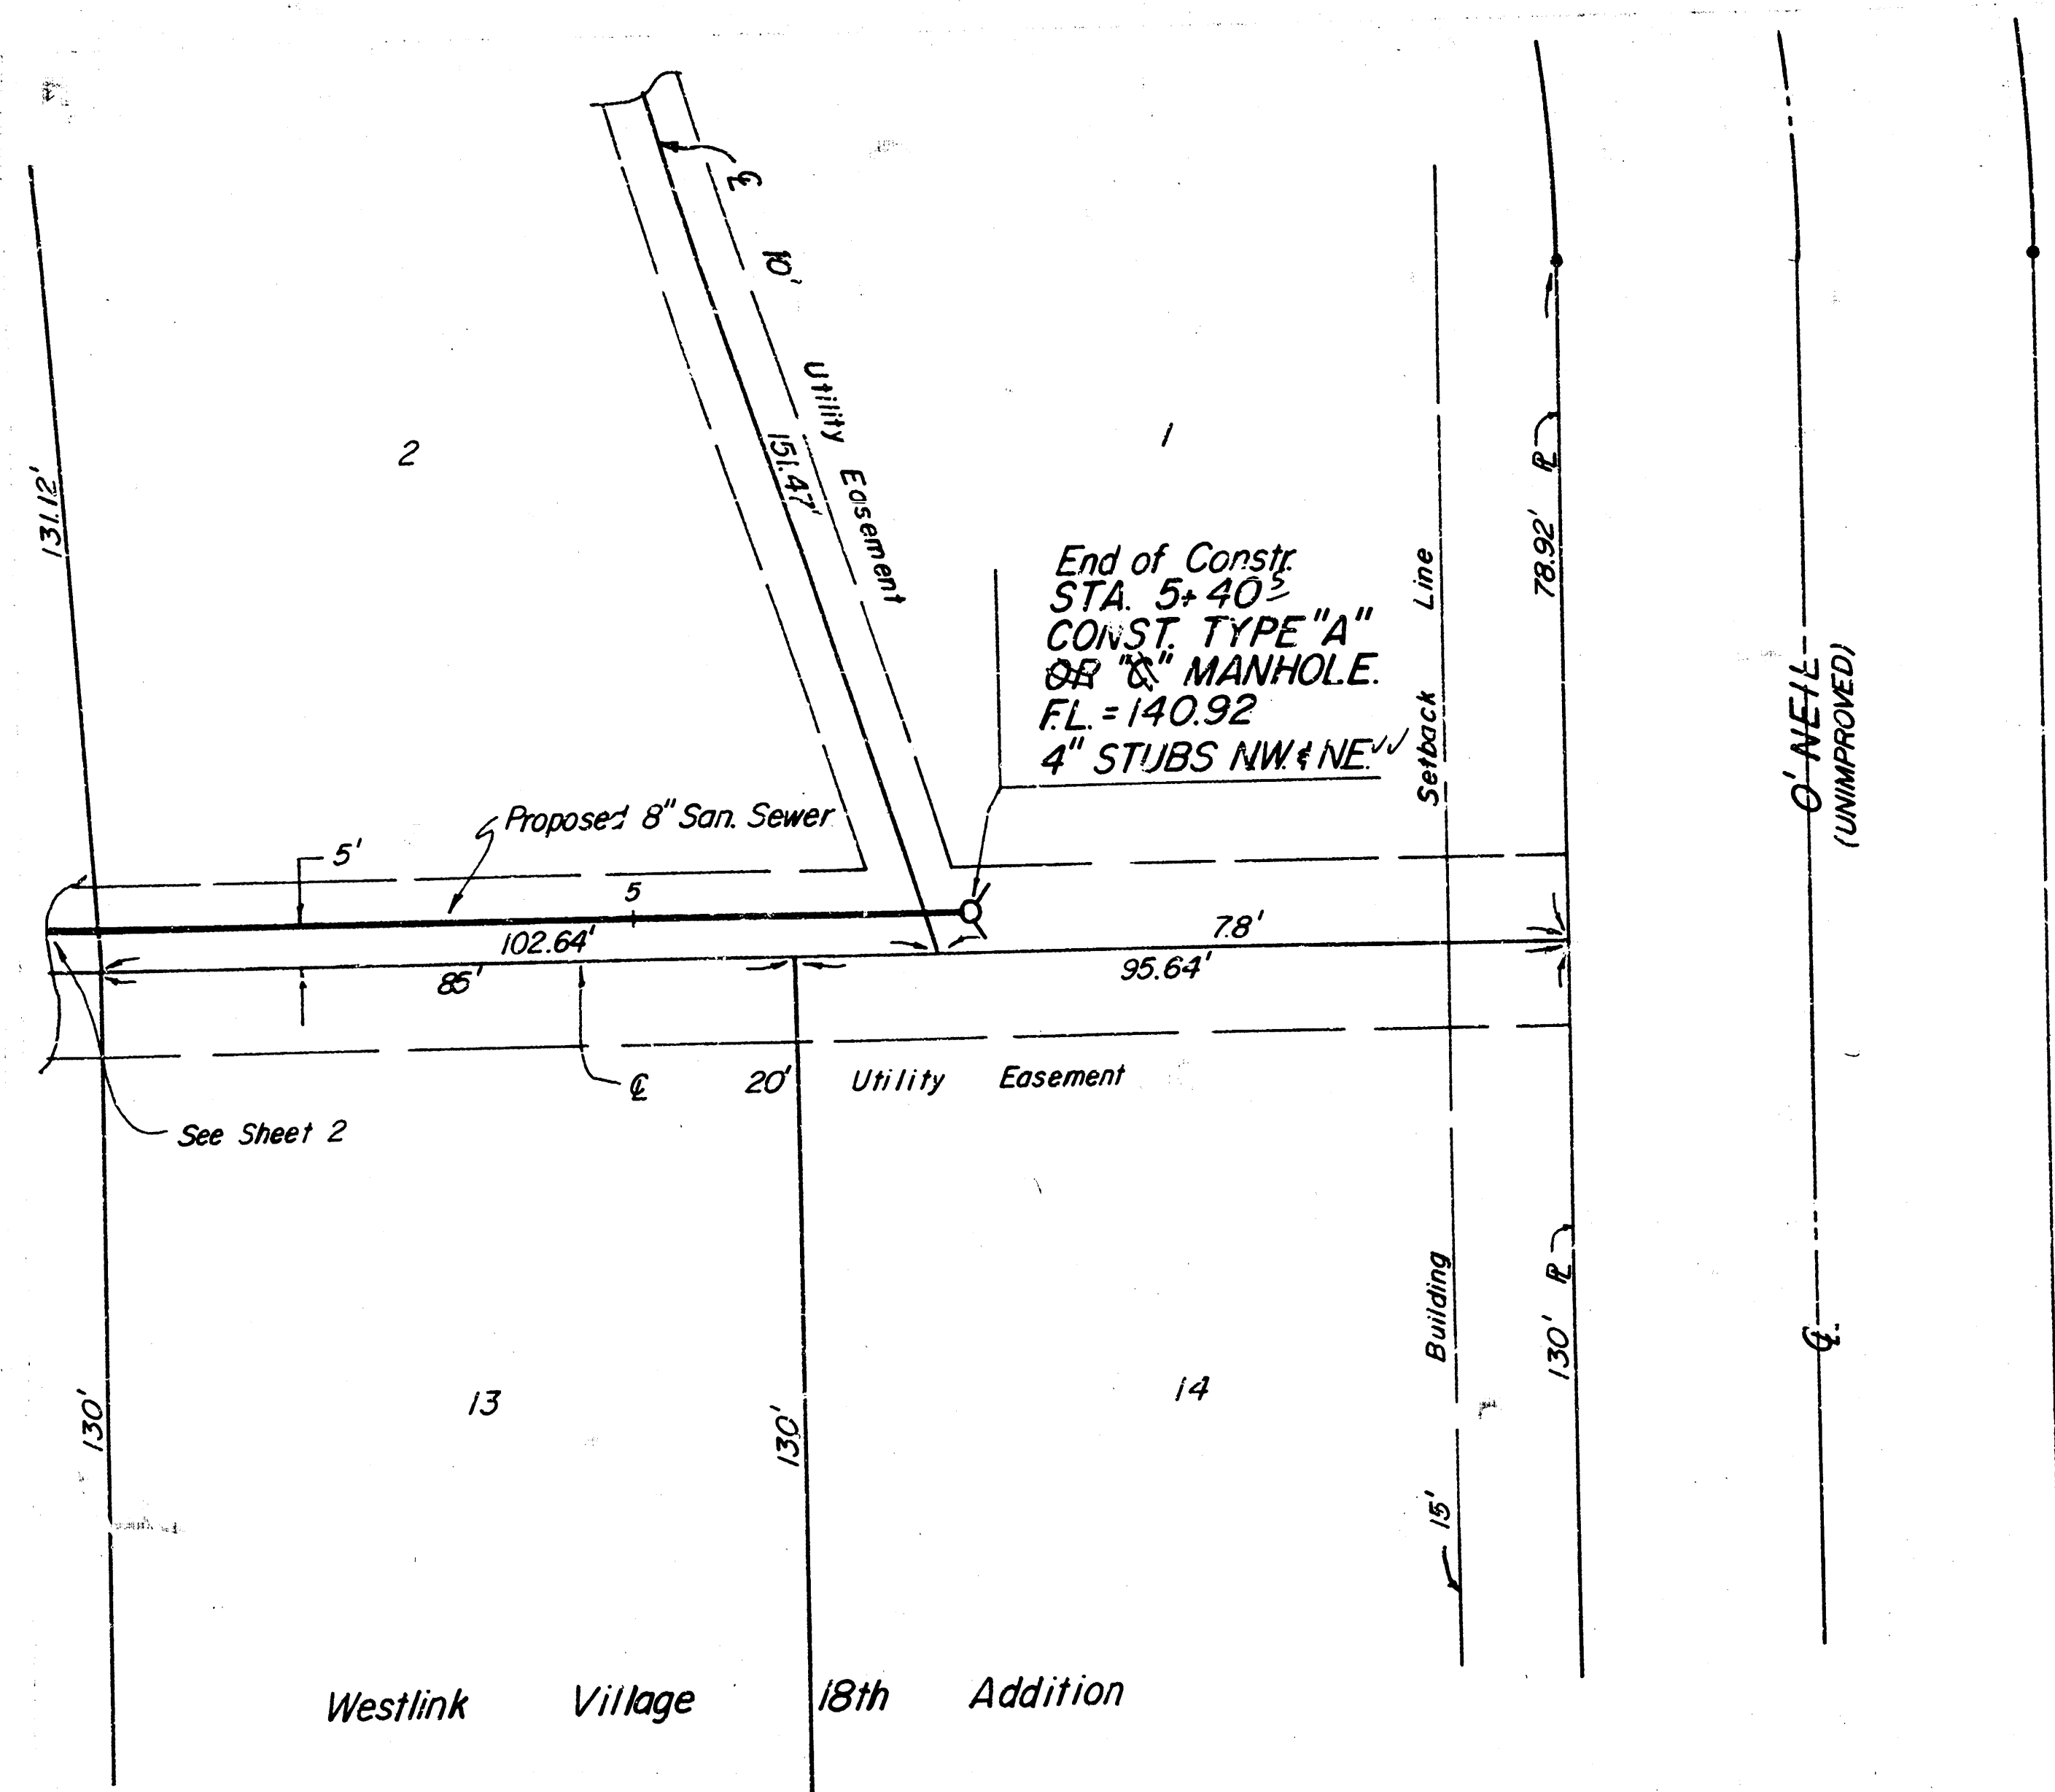

As Built
9-85
J. J.

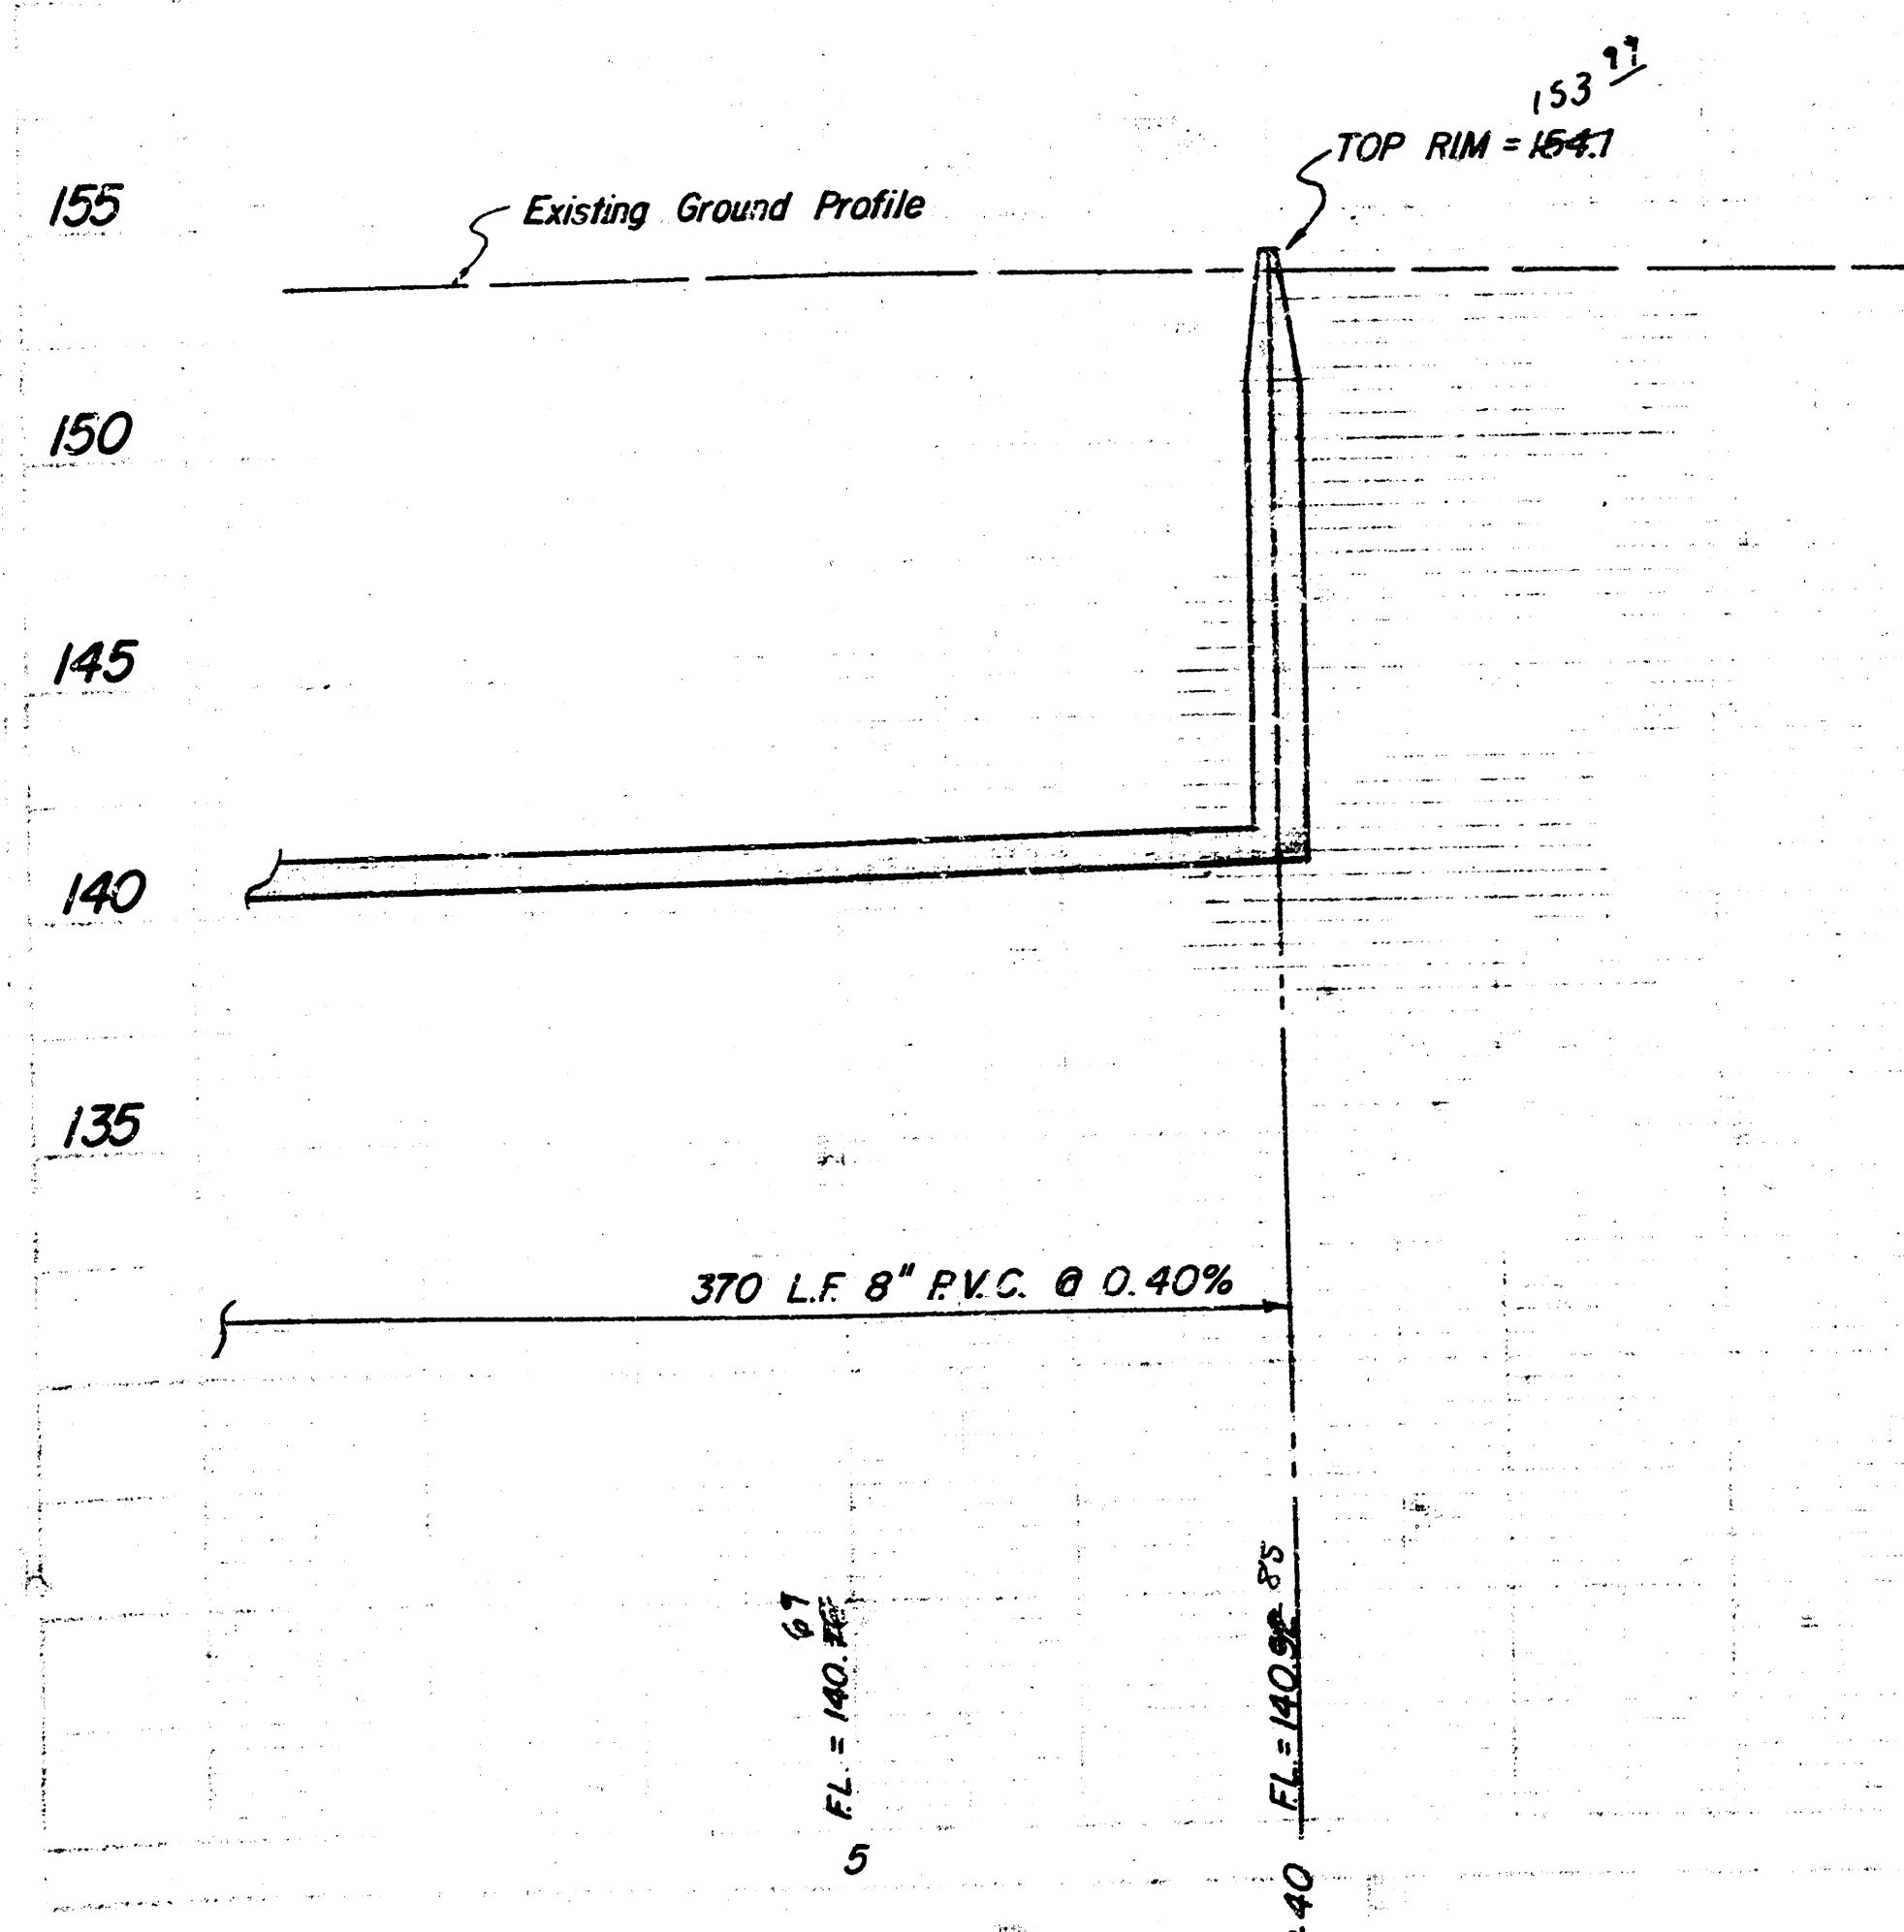

Lateral 10, Main 9, Southwest
Interceptor Sewer serving Lots
1 through 14, Block 4, Westlink
Village 18th Addition, to Wichita,
Sedgwick County, Kansas.
City Project No. 468-76-245-81463-000-000-001
MOEHRING & ASSOCIATES
CONSULTING ENGINEERS
WICHITA

85-058-P

1985
Sheet 3/3

14 5 1 2

FILMED FROM THE BEST
AVAILABLE COPY

