

SANITARY SEWER IMPROVEMENTS

WESTLINK 18TH ADDITION

LATERAL 11, MAIN 9, SOUTHWEST INTERCEPTOR SEWER

GENERAL NOTES:

- EXISTING UTILITIES AND THEIR LOCATIONS, AS SHOWN ON THE PLANS, REPRESENT THE BEST INFORMATION OBTAINABLE FOR DESIGN. LOCATION INFORMATION HAS BEEN OBTAINED FROM THE VARIOUS UTILITY COMPANIES AND IS EITHER FROM COMPANY RECORD DRAWINGS OR COMPANY PROVIDED FIELD LOCATIONS. THE PLAN LOCATIONS SHOWN ARE NOT GUARANTEED. ADDITIONAL EXISTING UTILITIES MAY ALSO BE ENCOUNTERED. THE CONTRACTOR WILL BE REQUIRED TO WORK AROUND EXISTING UTILITIES WITHIN THE RIGHT-OF-WAY WHICH DO NOT CONFLICT WITH PROPOSED CONSTRUCTION.
- THE CONTRACTOR SHALL BE RESPONSIBLE FOR PRESERVING PROPERTY IRONS. THE CONTRACTOR WILL BE REQUIRED TO RE-ESTABLISH ANY PROPERTY IRONS WHICH ARE DAMAGED OR DESTROYED BY HIS CONSTRUCTION OPERATIONS. SUCH IRONS SHALL BE RE-ESTABLISHED BY A LICENSED LAND SURVEYOR OR A LICENSED PROFESSIONAL ENGINEER IN ACCORDANCE WITH STATE LAW.
- RUBBLE FROM THE REMOVAL OF MISCELLANEOUS STRUCTURES AND EXCESS EXCAVATION WHICH IS TO BE WASTED SHALL BE DISPOSED OF ON SITES TO BE PROVIDED BY THE CONTRACTOR. THESE SITES SHALL BE APPROVED BY THE ENGINEER AS TO SUITABILITY, APPEARANCE AND SITE LOCATION. LOCATIONS THAT, IN THE OPINION OF THE ENGINEER, WILL LEAVE AN UNSIGHTLY APPEARANCE WILL NOT BE APPROVED.

BENCH MARKS:


BM.# 1 "x" Cut on top curb 18.0' E. and 35.0' S. of E's First and Pine Grove Elev. 155.75

BM.# 2 "x" Cut on top curb 4.0' S. and 18.0' W. of E's Douglas and Milstead Elev. 151.64

BM.# 3 City of Wichita disk 40.0' E. and 46.0' S. of E's Central and 119th. W. Elev. 156.33

INDEX:

SHEET 1	TITLE
SHEET 2	PLAN PROFILE LINE 1, LINE 1 A
SHEET 3	PLAN PROFILE LINE 1, LINE 1 B, LINE 2

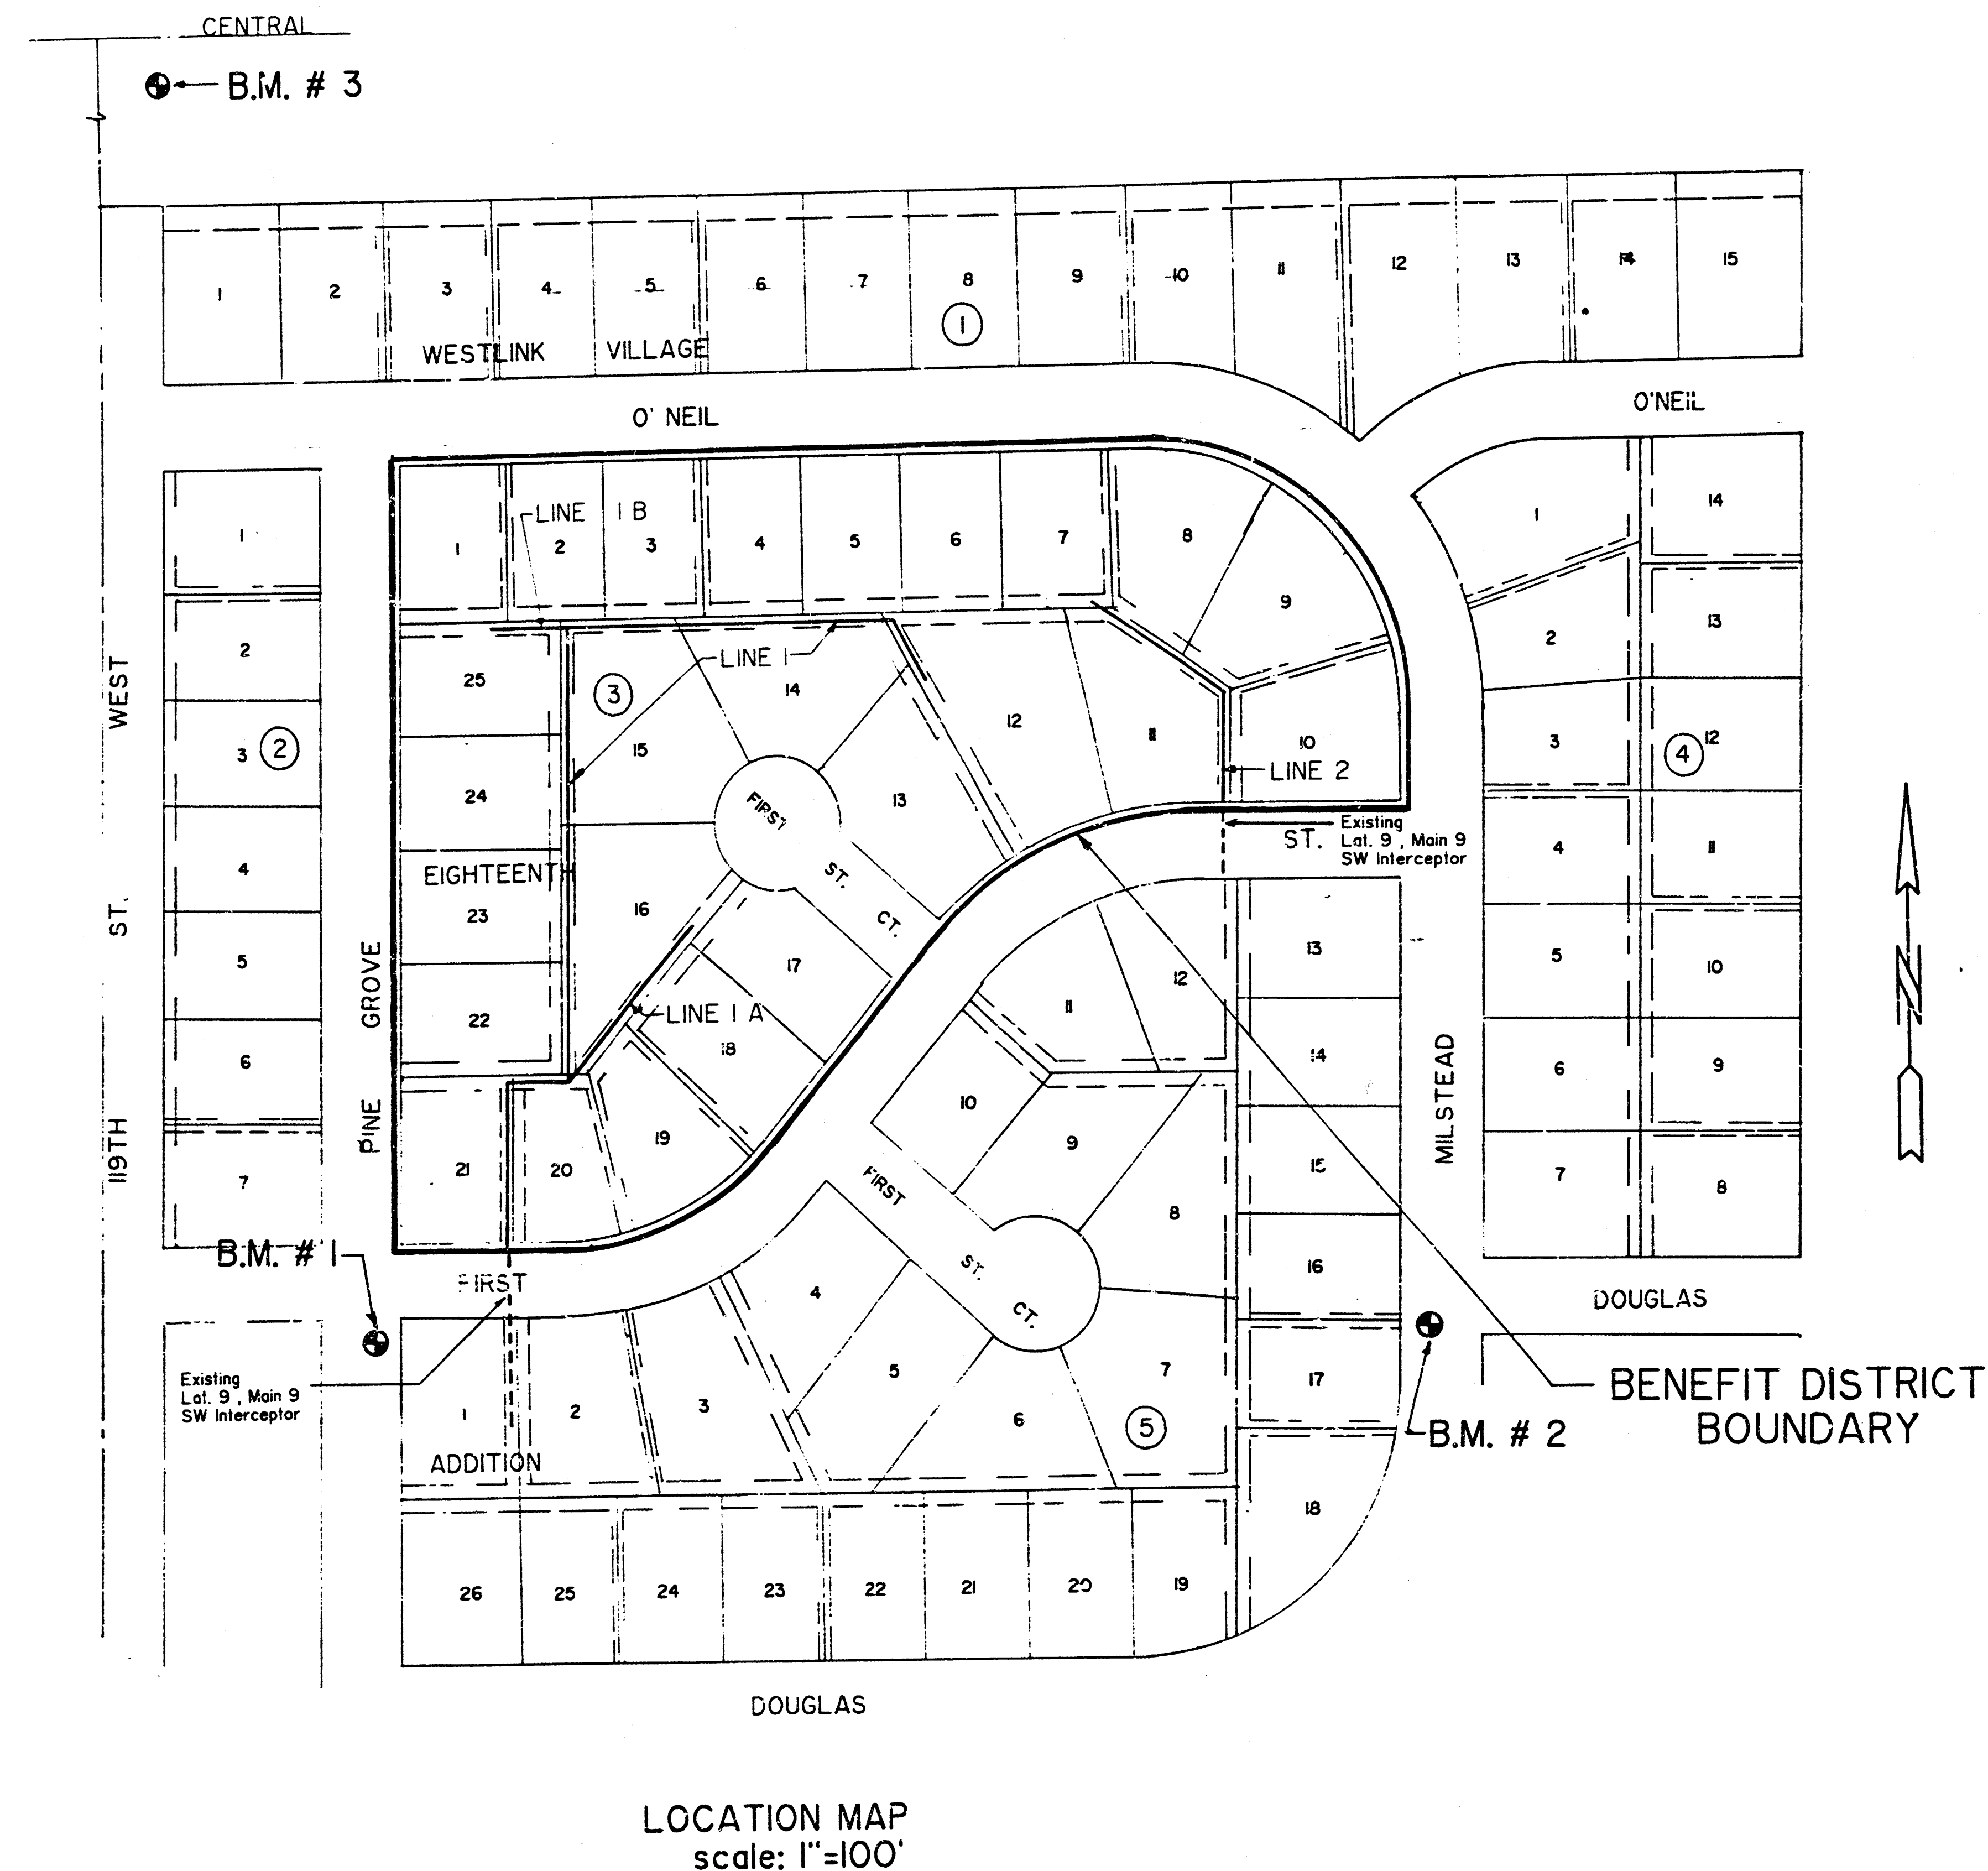

MICHAEL E. LINDEBAK, P.E., CITY ENGINEER

CITY OF WICHITA, KANSAS

PROJECT NO.: 468-76-245-81633-000-000-001


AS BUILT
Rd
5-87

MUNICIPAL ENGINEERS
Civil Engineers & Land Surveyors
254 Laura, Suite 201
Wichita, Kansas 67211


SCALE:	APPROVED BY:	DRAWN BY:
DATE: 2-87		REVISED:
DRAWING NUMBER		1 OF 3

PLAN
NOTES
1. ALL WORK SHALL BE IN ACCORDANCE WITH THE LATEST EDITIONS OF THE STANDARD SPECIFICATIONS FOR HIGHWAY CONSTRUCTION, AS APPLICABLE.
2. THE CONTRACTOR SHALL BE RESPONSIBLE FOR OBTAINING ALL NECESSARY PERMITS AND RIGHTS-OF-WAY.
3. THE CONTRACTOR SHALL MAINTAIN ACCESS TO ALL ADJACENT PROPERTIES AT ALL TIMES.
4. THE CONTRACTOR SHALL BE RESPONSIBLE FOR PROTECTING ALL EXISTING UTILITIES AND STRUCTURES.
5. THE CONTRACTOR SHALL MAINTAIN ADEQUATE DRAINAGE DURING CONSTRUCTION.
6. THE CONTRACTOR SHALL BE RESPONSIBLE FOR RESTORING ALL AREAS TO ORIGINAL OR BETTER CONDITION.
7. THE CONTRACTOR SHALL MAINTAIN ADEQUATE EROSION CONTROL MEASURES.
8. THE CONTRACTOR SHALL BE RESPONSIBLE FOR OBTAINING ALL NECESSARY INSURANCE.
9. THE CONTRACTOR SHALL MAINTAIN ADEQUATE SAFETY MEASURES DURING CONSTRUCTION.
10. THE CONTRACTOR SHALL BE RESPONSIBLE FOR OBTAINING ALL NECESSARY NOTICES.
11. THE CONTRACTOR SHALL MAINTAIN ADEQUATE RECORDING OF ALL WORK.
12. THE CONTRACTOR SHALL BE RESPONSIBLE FOR OBTAINING ALL NECESSARY APPROVALS.
13. THE CONTRACTOR SHALL MAINTAIN ADEQUATE COMMUNICATION DURING CONSTRUCTION.
14. THE CONTRACTOR SHALL BE RESPONSIBLE FOR OBTAINING ALL NECESSARY RECORDS.
15. THE CONTRACTOR SHALL MAINTAIN ADEQUATE ARCHIVING OF ALL WORK.

NOTE :
Prior to Beginning Construction the Contractor Shall Field Verify the Locations of Existing Sewer Pipes. The Contractor Shall Also Field Verify the Elevation, Size, and Type of the Existing 8" Sewer Pipes. Any Discrepancies Between Field Information and Information Shown in These Plans Shall Be Reported to the Engineer Prior to the Start of Construction.

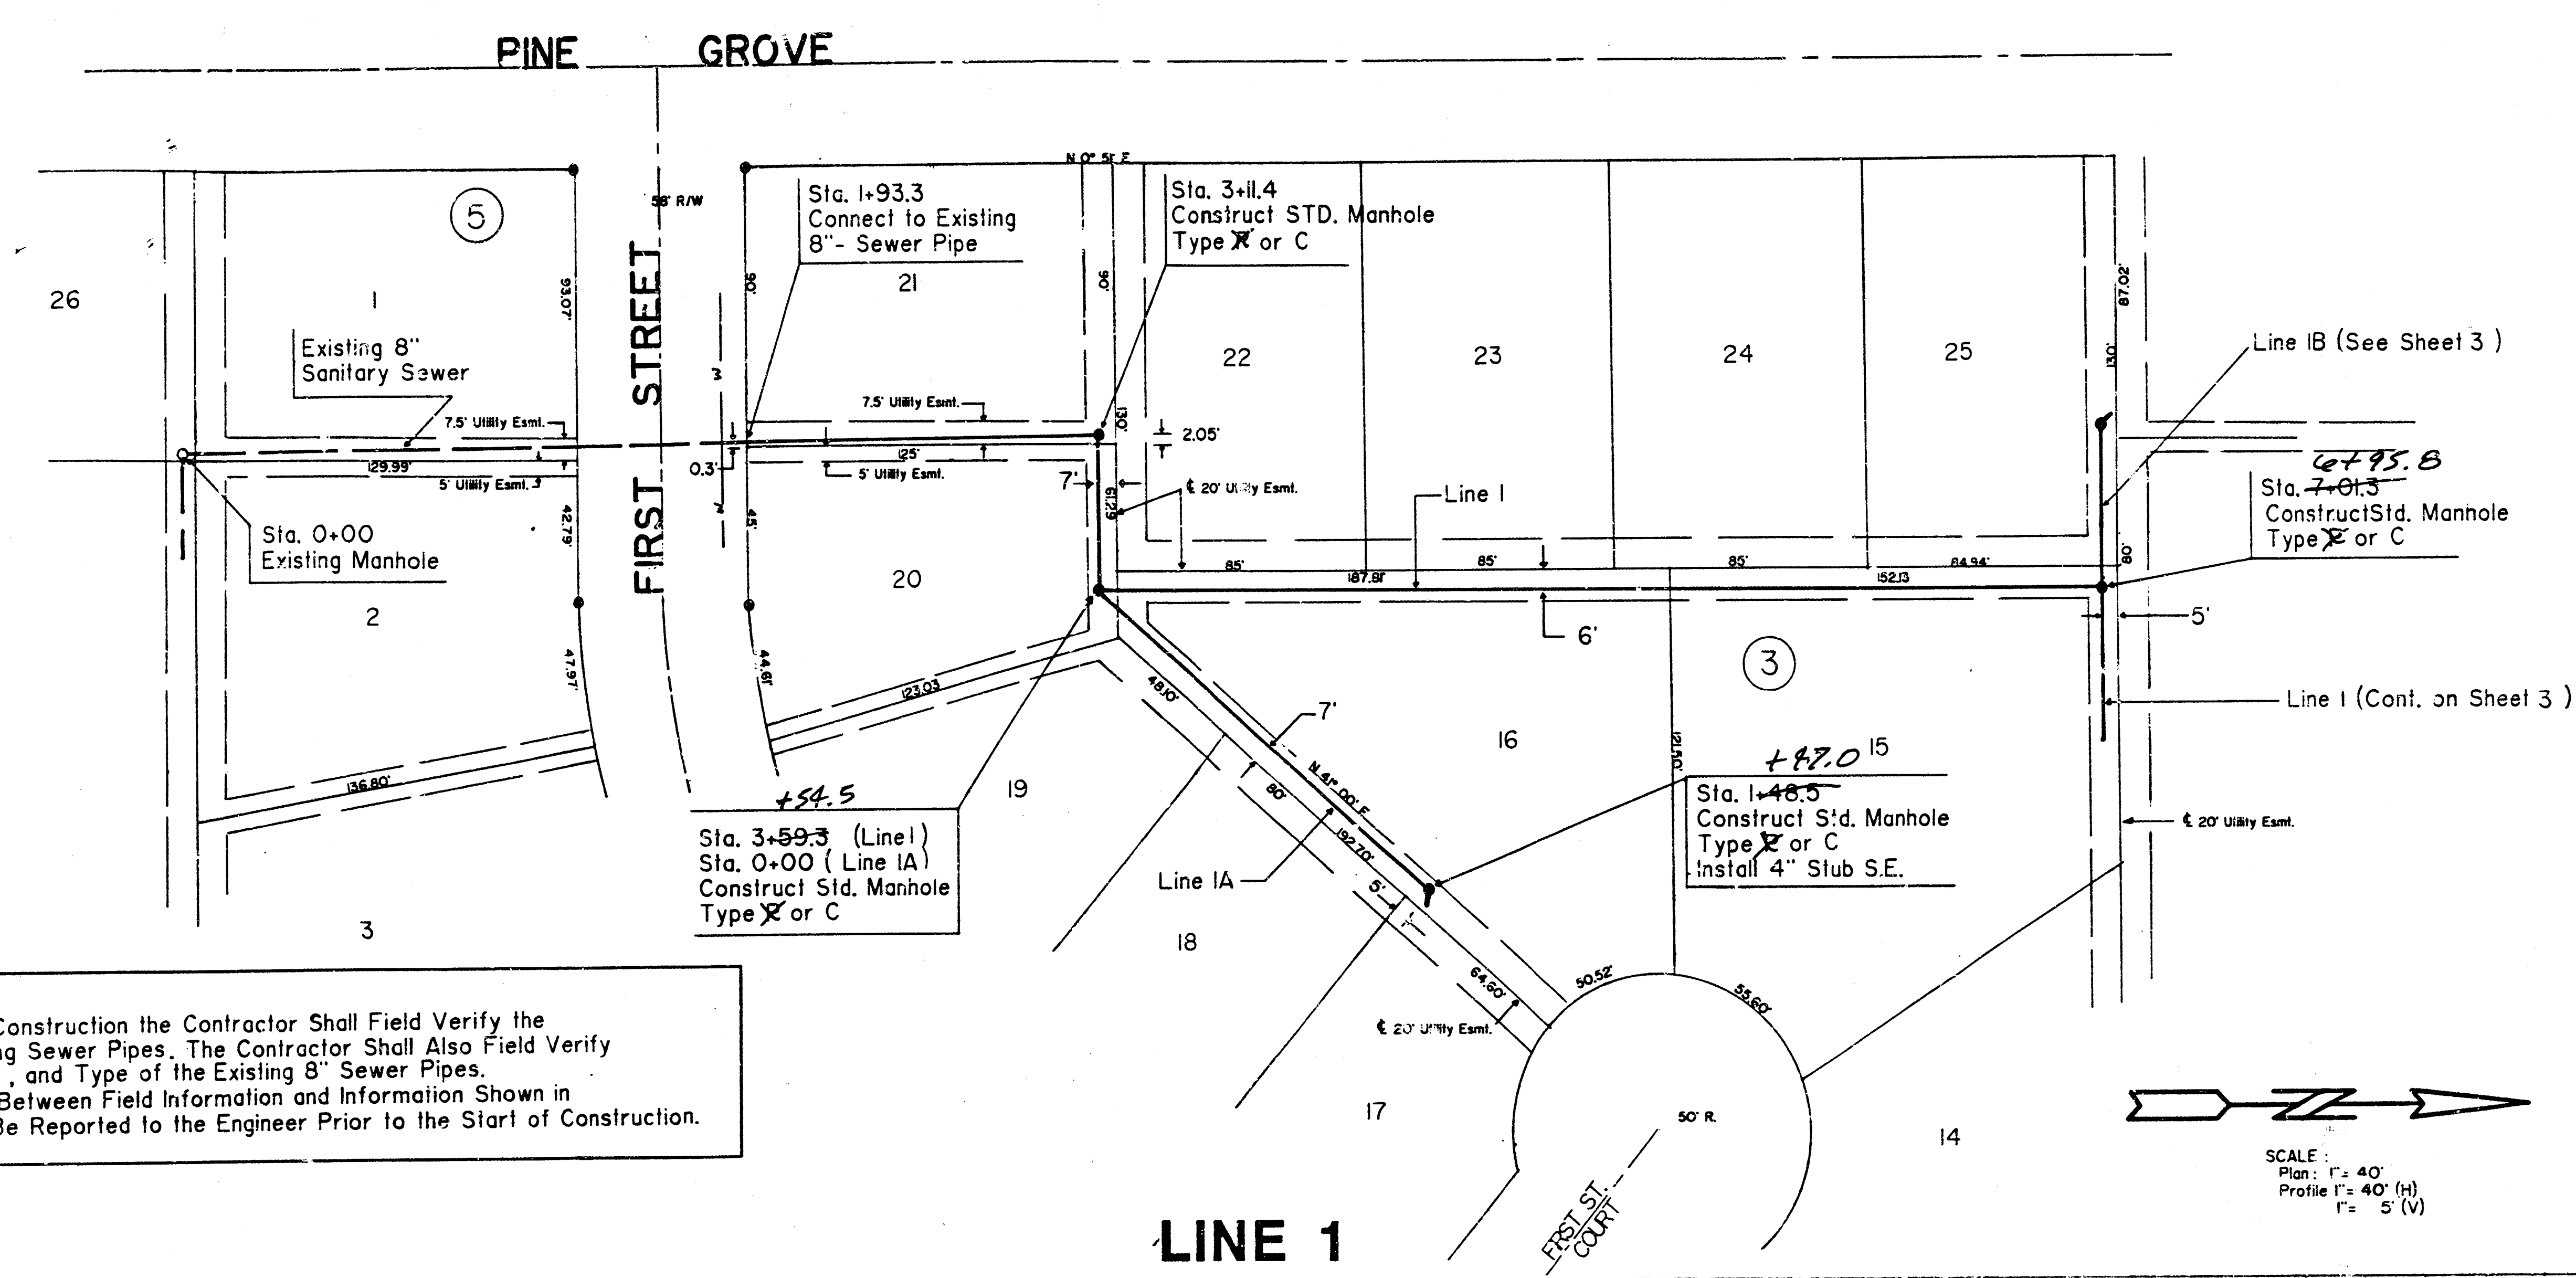

PROFILE
NOTES
1. ALL WORK SHALL BE IN ACCORDANCE WITH THE LATEST EDITIONS OF THE STANDARD SPECIFICATIONS FOR HIGHWAY CONSTRUCTION, AS APPLICABLE.
2. THE CONTRACTOR SHALL BE RESPONSIBLE FOR OBTAINING ALL NECESSARY PERMITS AND RIGHTS-OF-WAY.
3. THE CONTRACTOR SHALL MAINTAIN ACCESS TO ALL ADJACENT PROPERTIES AT ALL TIMES.
4. THE CONTRACTOR SHALL BE RESPONSIBLE FOR PROTECTING ALL EXISTING UTILITIES AND STRUCTURES.
5. THE CONTRACTOR SHALL MAINTAIN ADEQUATE DRAINAGE DURING CONSTRUCTION.
6. THE CONTRACTOR SHALL BE RESPONSIBLE FOR RESTORING ALL AREAS TO ORIGINAL OR BETTER CONDITION.
7. THE CONTRACTOR SHALL MAINTAIN ADEQUATE EROSION CONTROL MEASURES.
8. THE CONTRACTOR SHALL BE RESPONSIBLE FOR OBTAINING ALL NECESSARY INSURANCE.
9. THE CONTRACTOR SHALL MAINTAIN ADEQUATE SAFETY MEASURES DURING CONSTRUCTION.
10. THE CONTRACTOR SHALL BE RESPONSIBLE FOR OBTAINING ALL NECESSARY NOTICES.
11. THE CONTRACTOR SHALL MAINTAIN ADEQUATE RECORDING OF ALL WORK.
12. THE CONTRACTOR SHALL BE RESPONSIBLE FOR OBTAINING ALL NECESSARY APPROVALS.
13. THE CONTRACTOR SHALL MAINTAIN ADEQUATE COMMUNICATION DURING CONSTRUCTION.
14. THE CONTRACTOR SHALL BE RESPONSIBLE FOR OBTAINING ALL NECESSARY RECORDS.
15. THE CONTRACTOR SHALL MAINTAIN ADEQUATE ARCHIVING OF ALL WORK.

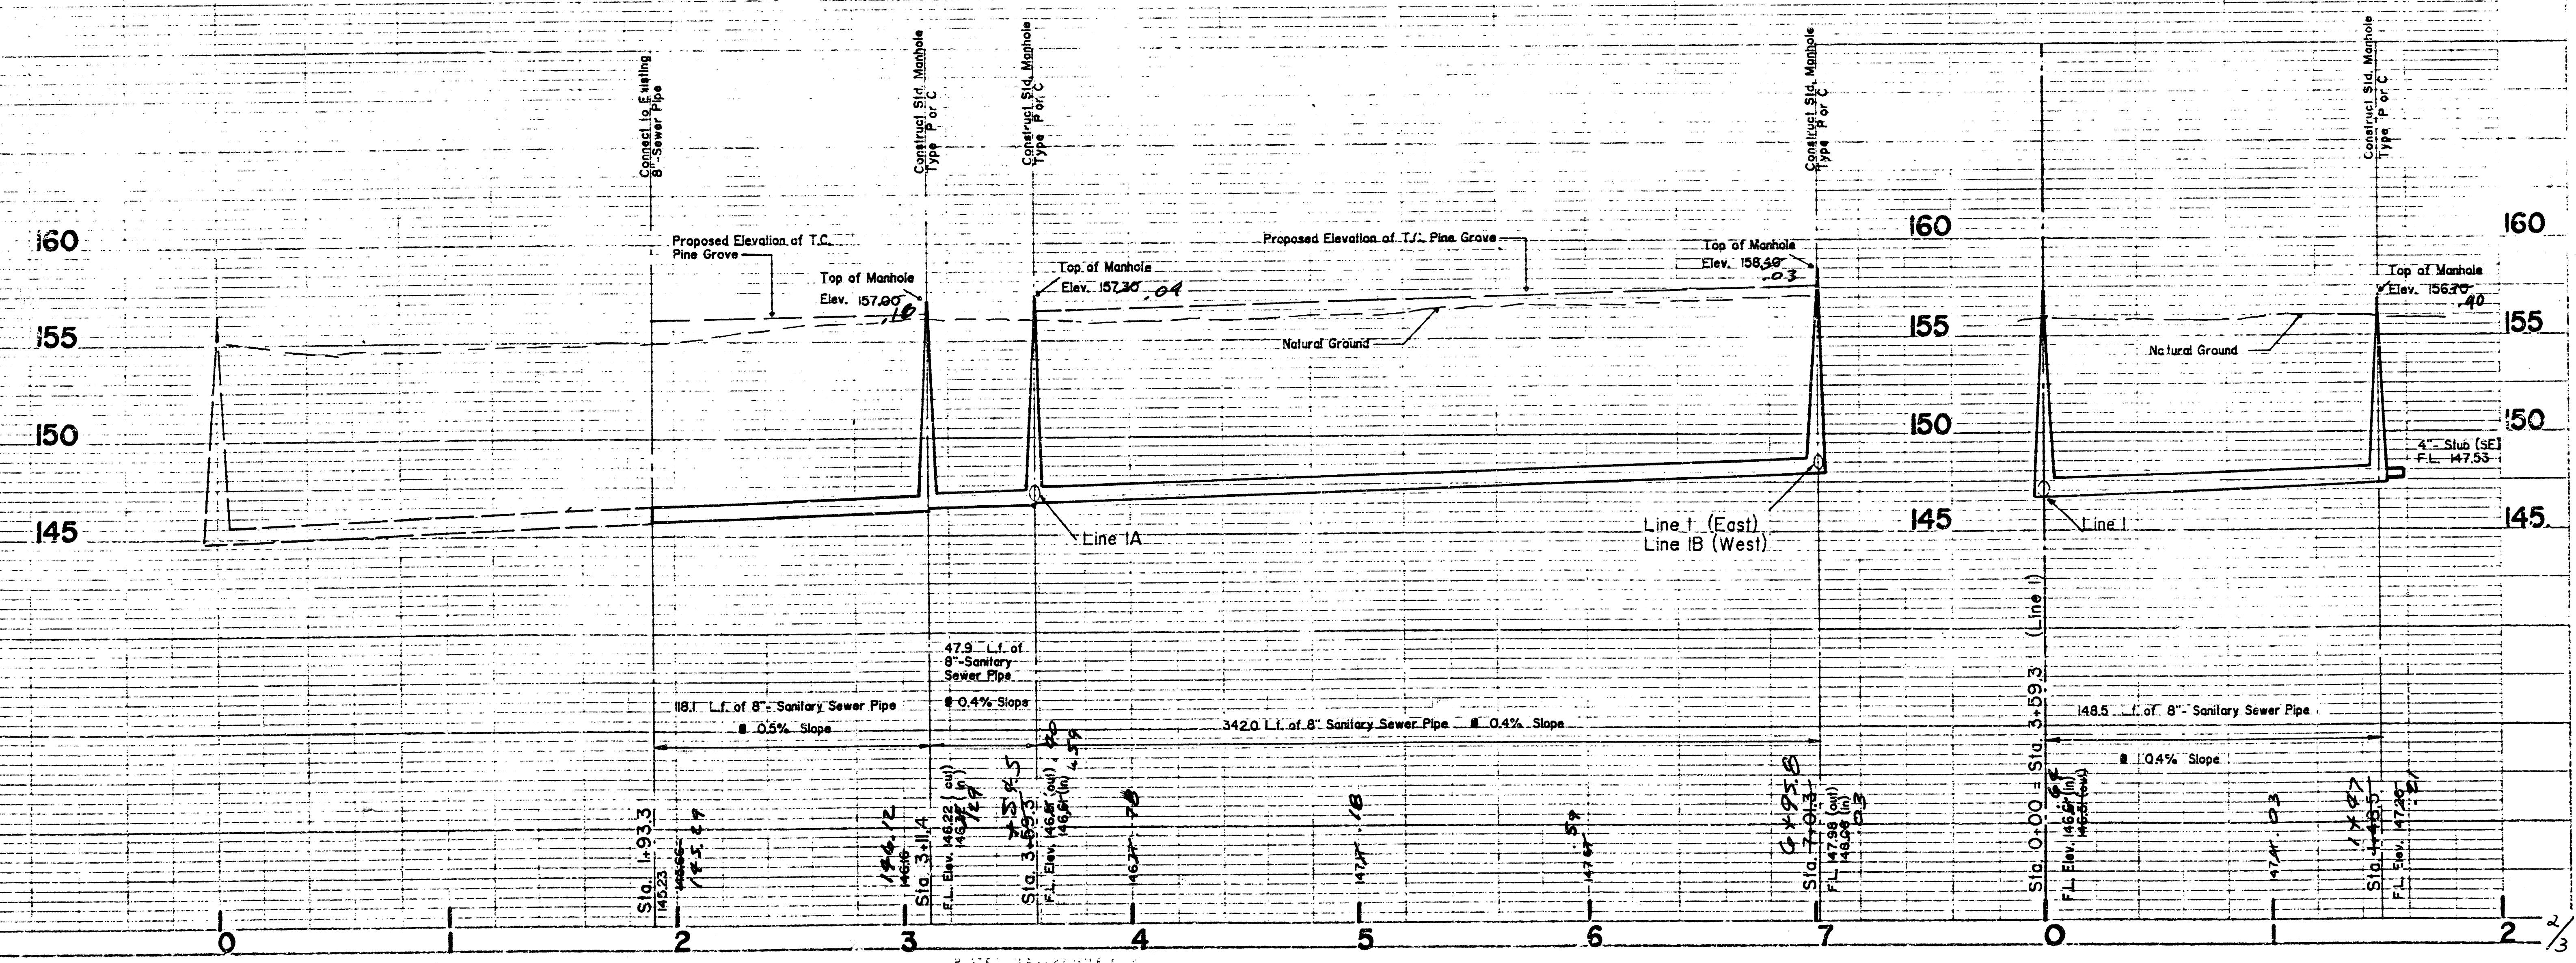

PLAN
SHEET NO. 14
DATE: 10/1/14
BY: J. M. HARRIS
CHECKED: J. M. HARRIS
SCALE: 1" = 40'

PROFILE
SHEET NO. 14
DATE: 10/1/14
BY: J. M. HARRIS
CHECKED: J. M. HARRIS
SCALE: 1" = 40' (H)
1" = 5' (V)

