



Scale Plan 1" = 40'
 Profile 1" = 40' Horiz.
 1" = 5' Vert.

B.M. 147.49 "A" cut in north end of concrete spillway 35' S.
 of N.L. of Hardtner and 40' E. of W.L. Westlink Seventeen.
 B.M. 149.60 "D" South Rim Manhole @ NE corner Hardtner
 and Shefford.

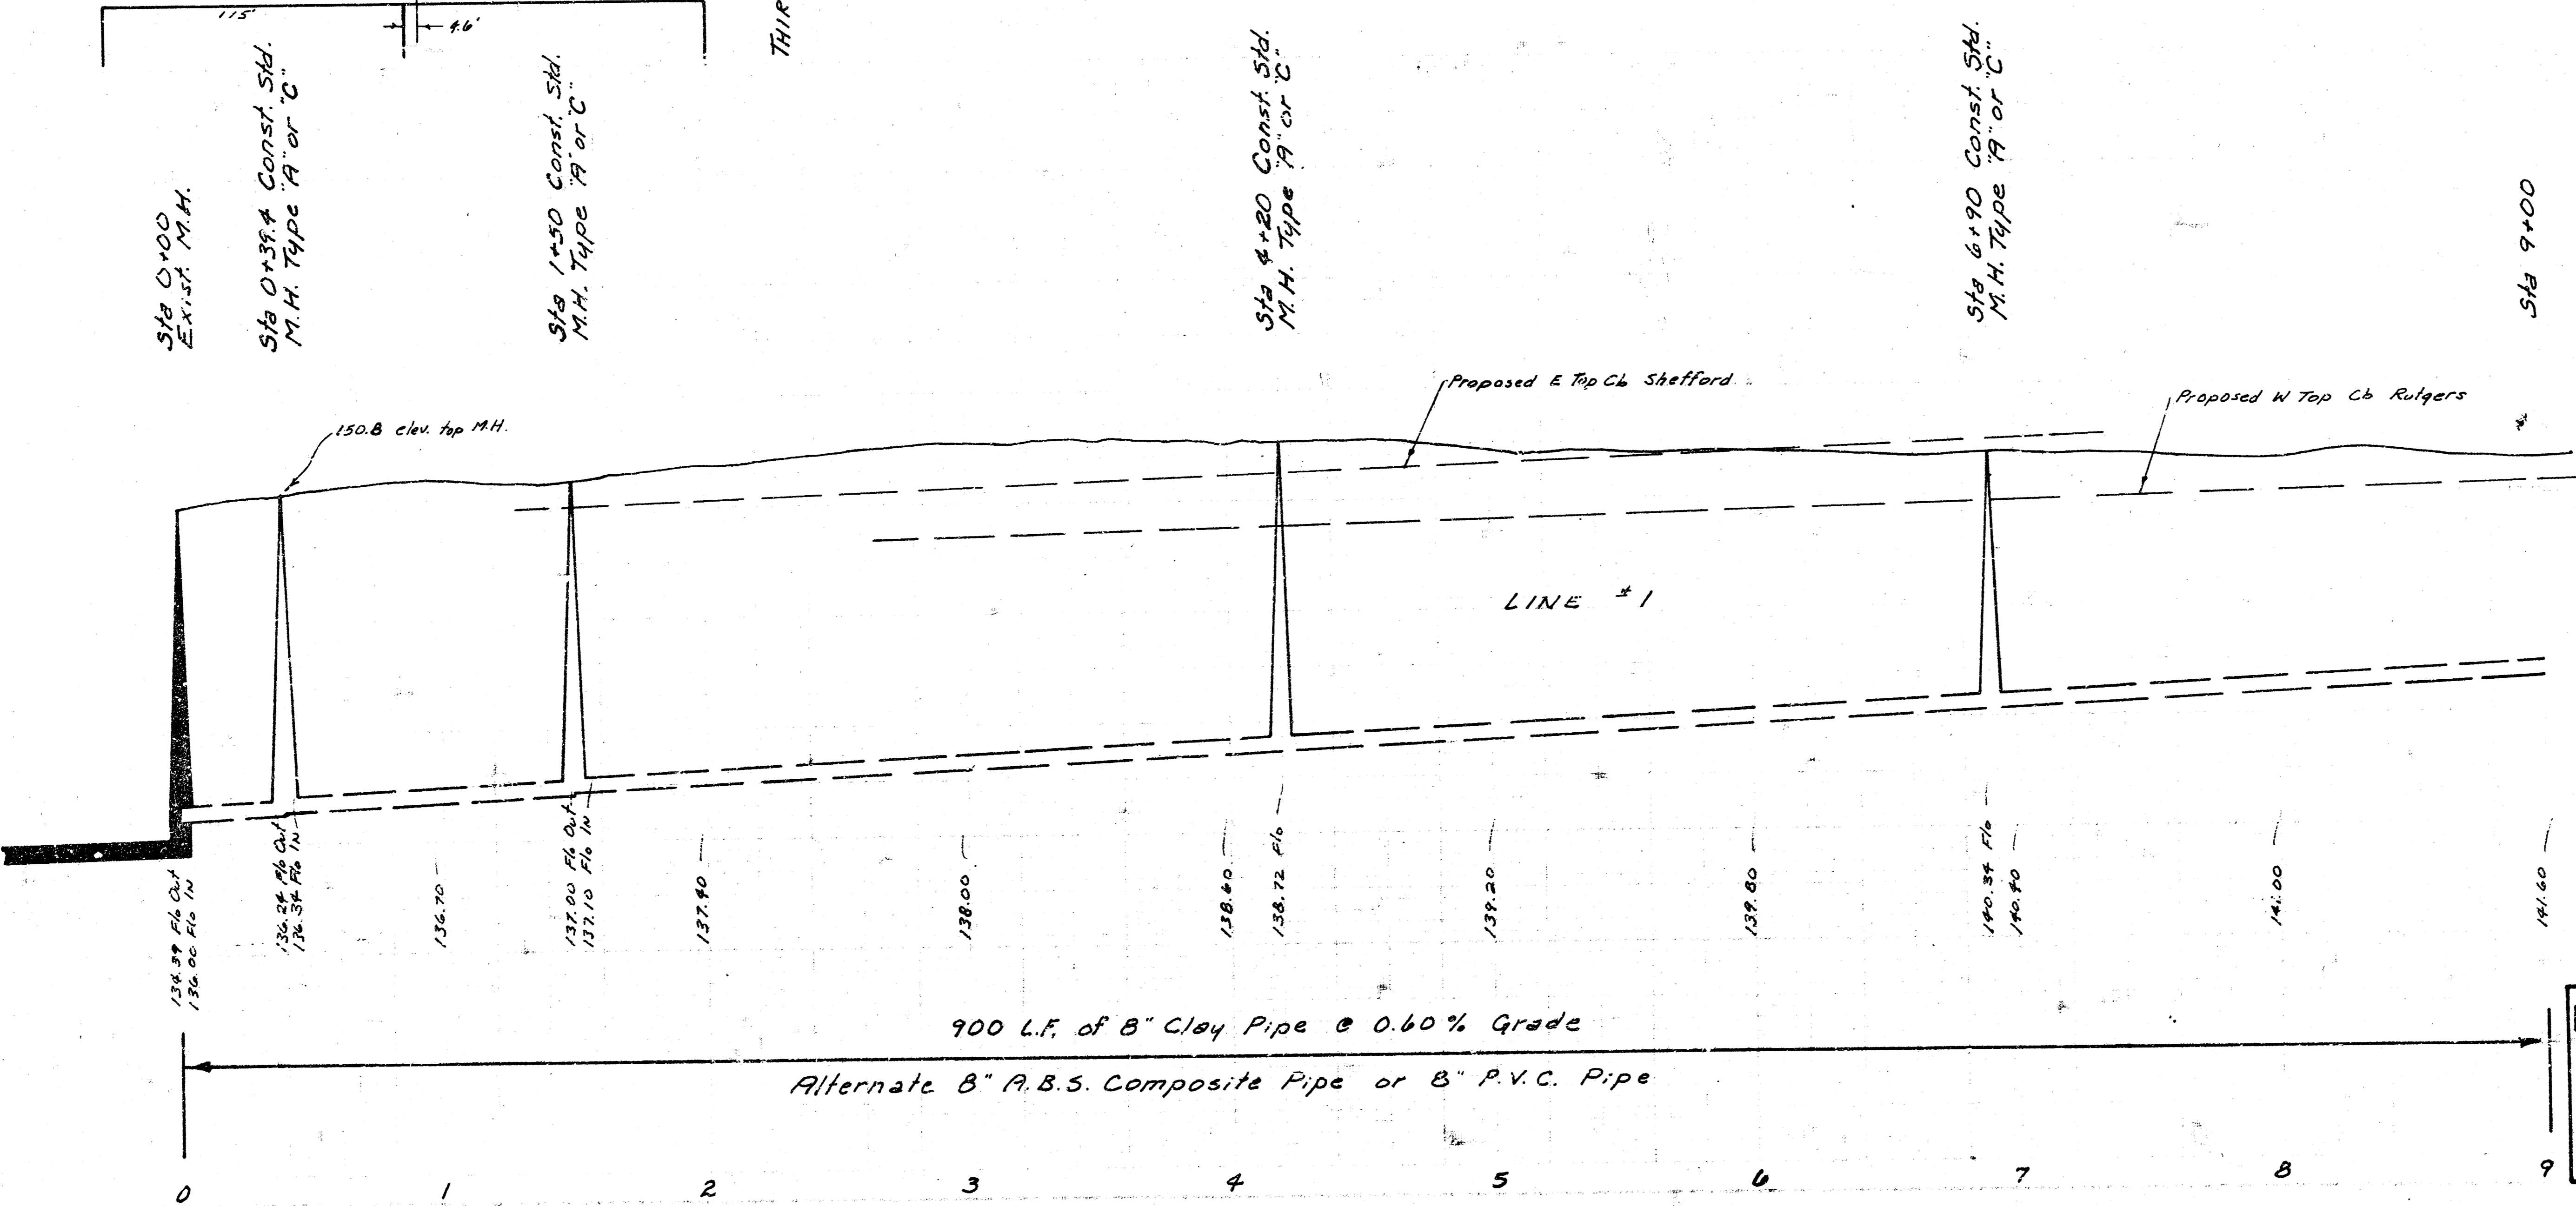

LAT 9, MAIN 10, SW. INTERCEPTOR SEWER
 CITY OF WICHITA, KANSAS
 RAY BRUGGEMAN — CITY ENGINEER
 PROJ. NO. 468-76-245-80987-000-000-001

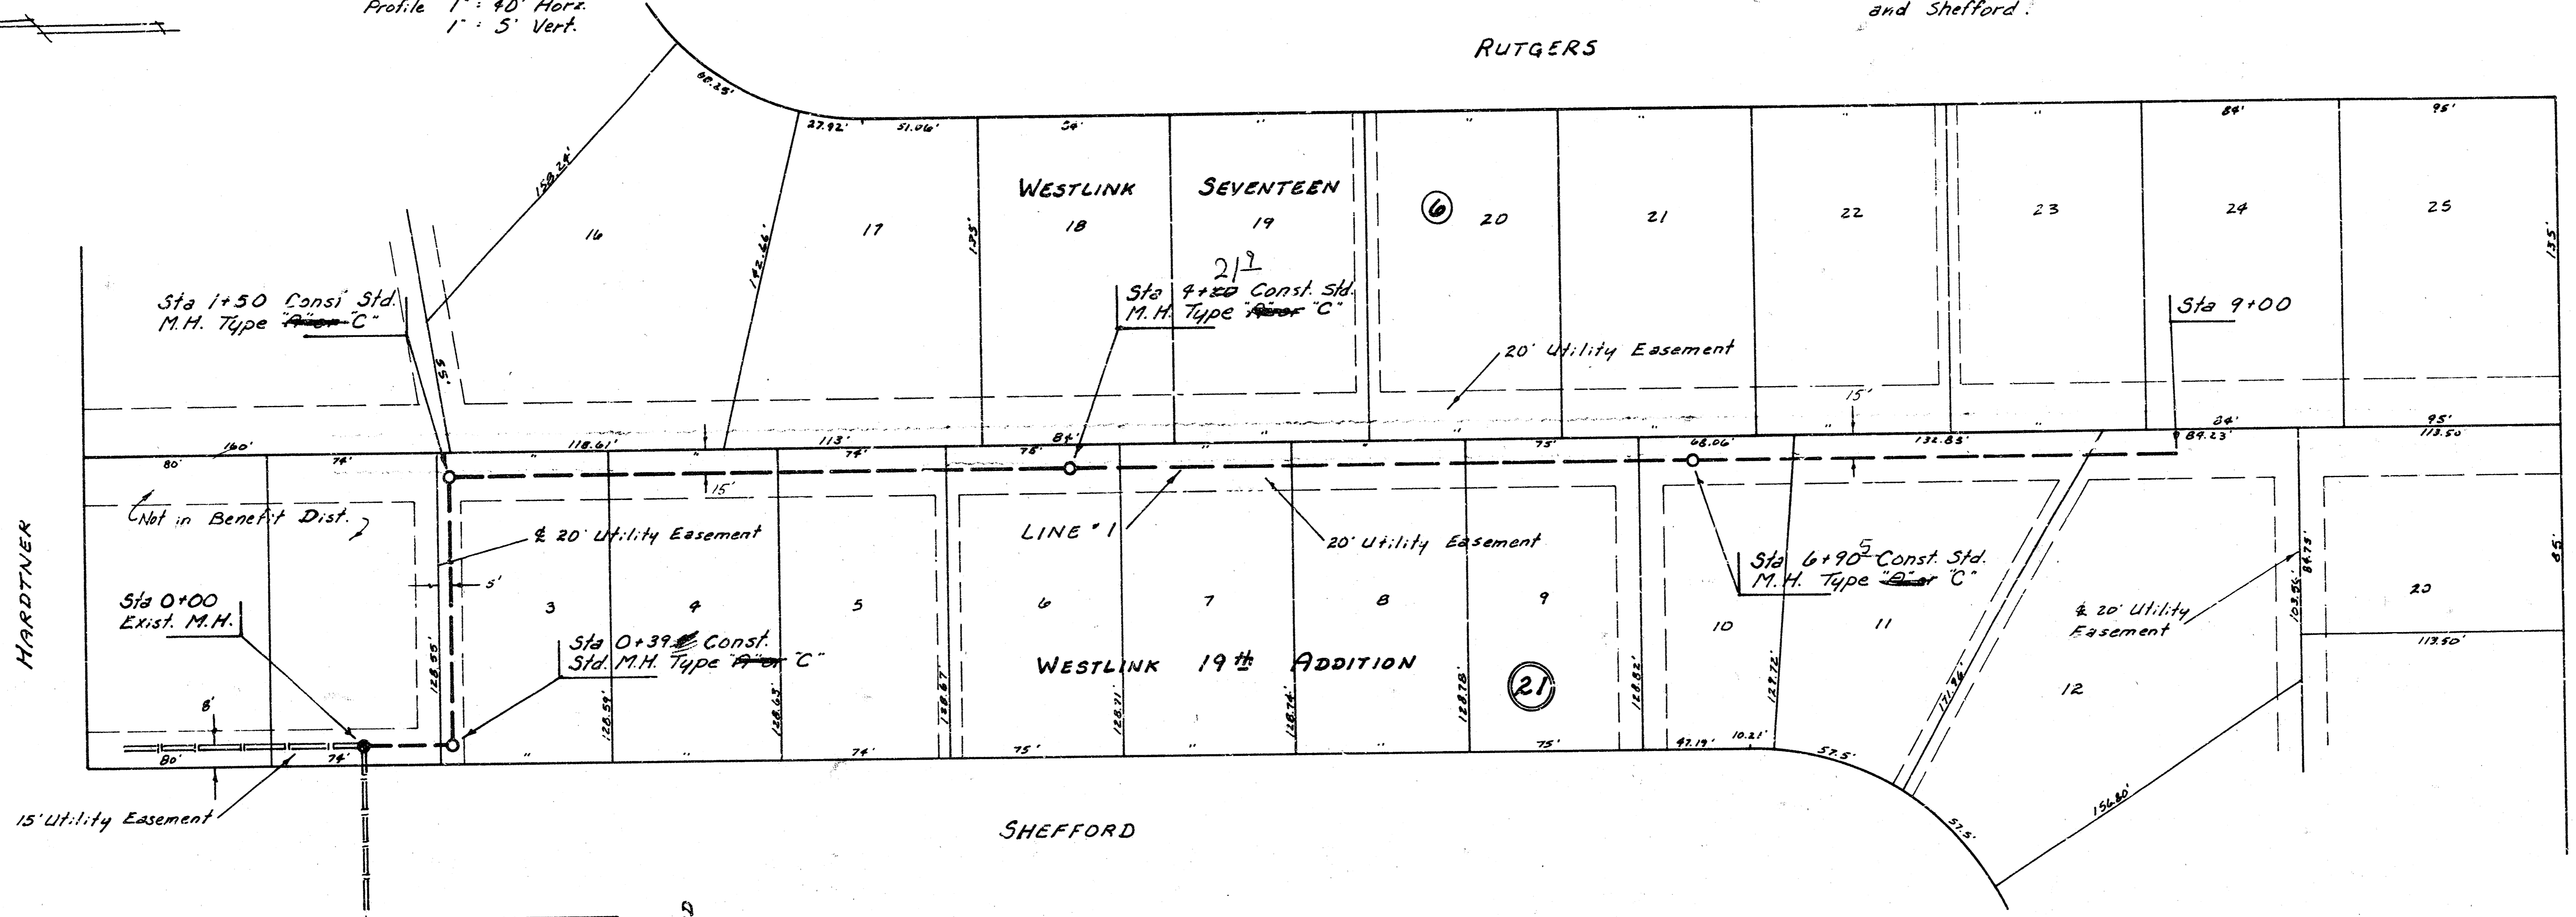

AS BUILT
 5/8
 2-81


K. Williams
 2/20/81

AM-2



155
 150
 145
 140
 135
 130

130
 16

Scale Plan 1" = 40'
 Profile 1" = 40' Horiz.
 1" = 5' Vert.

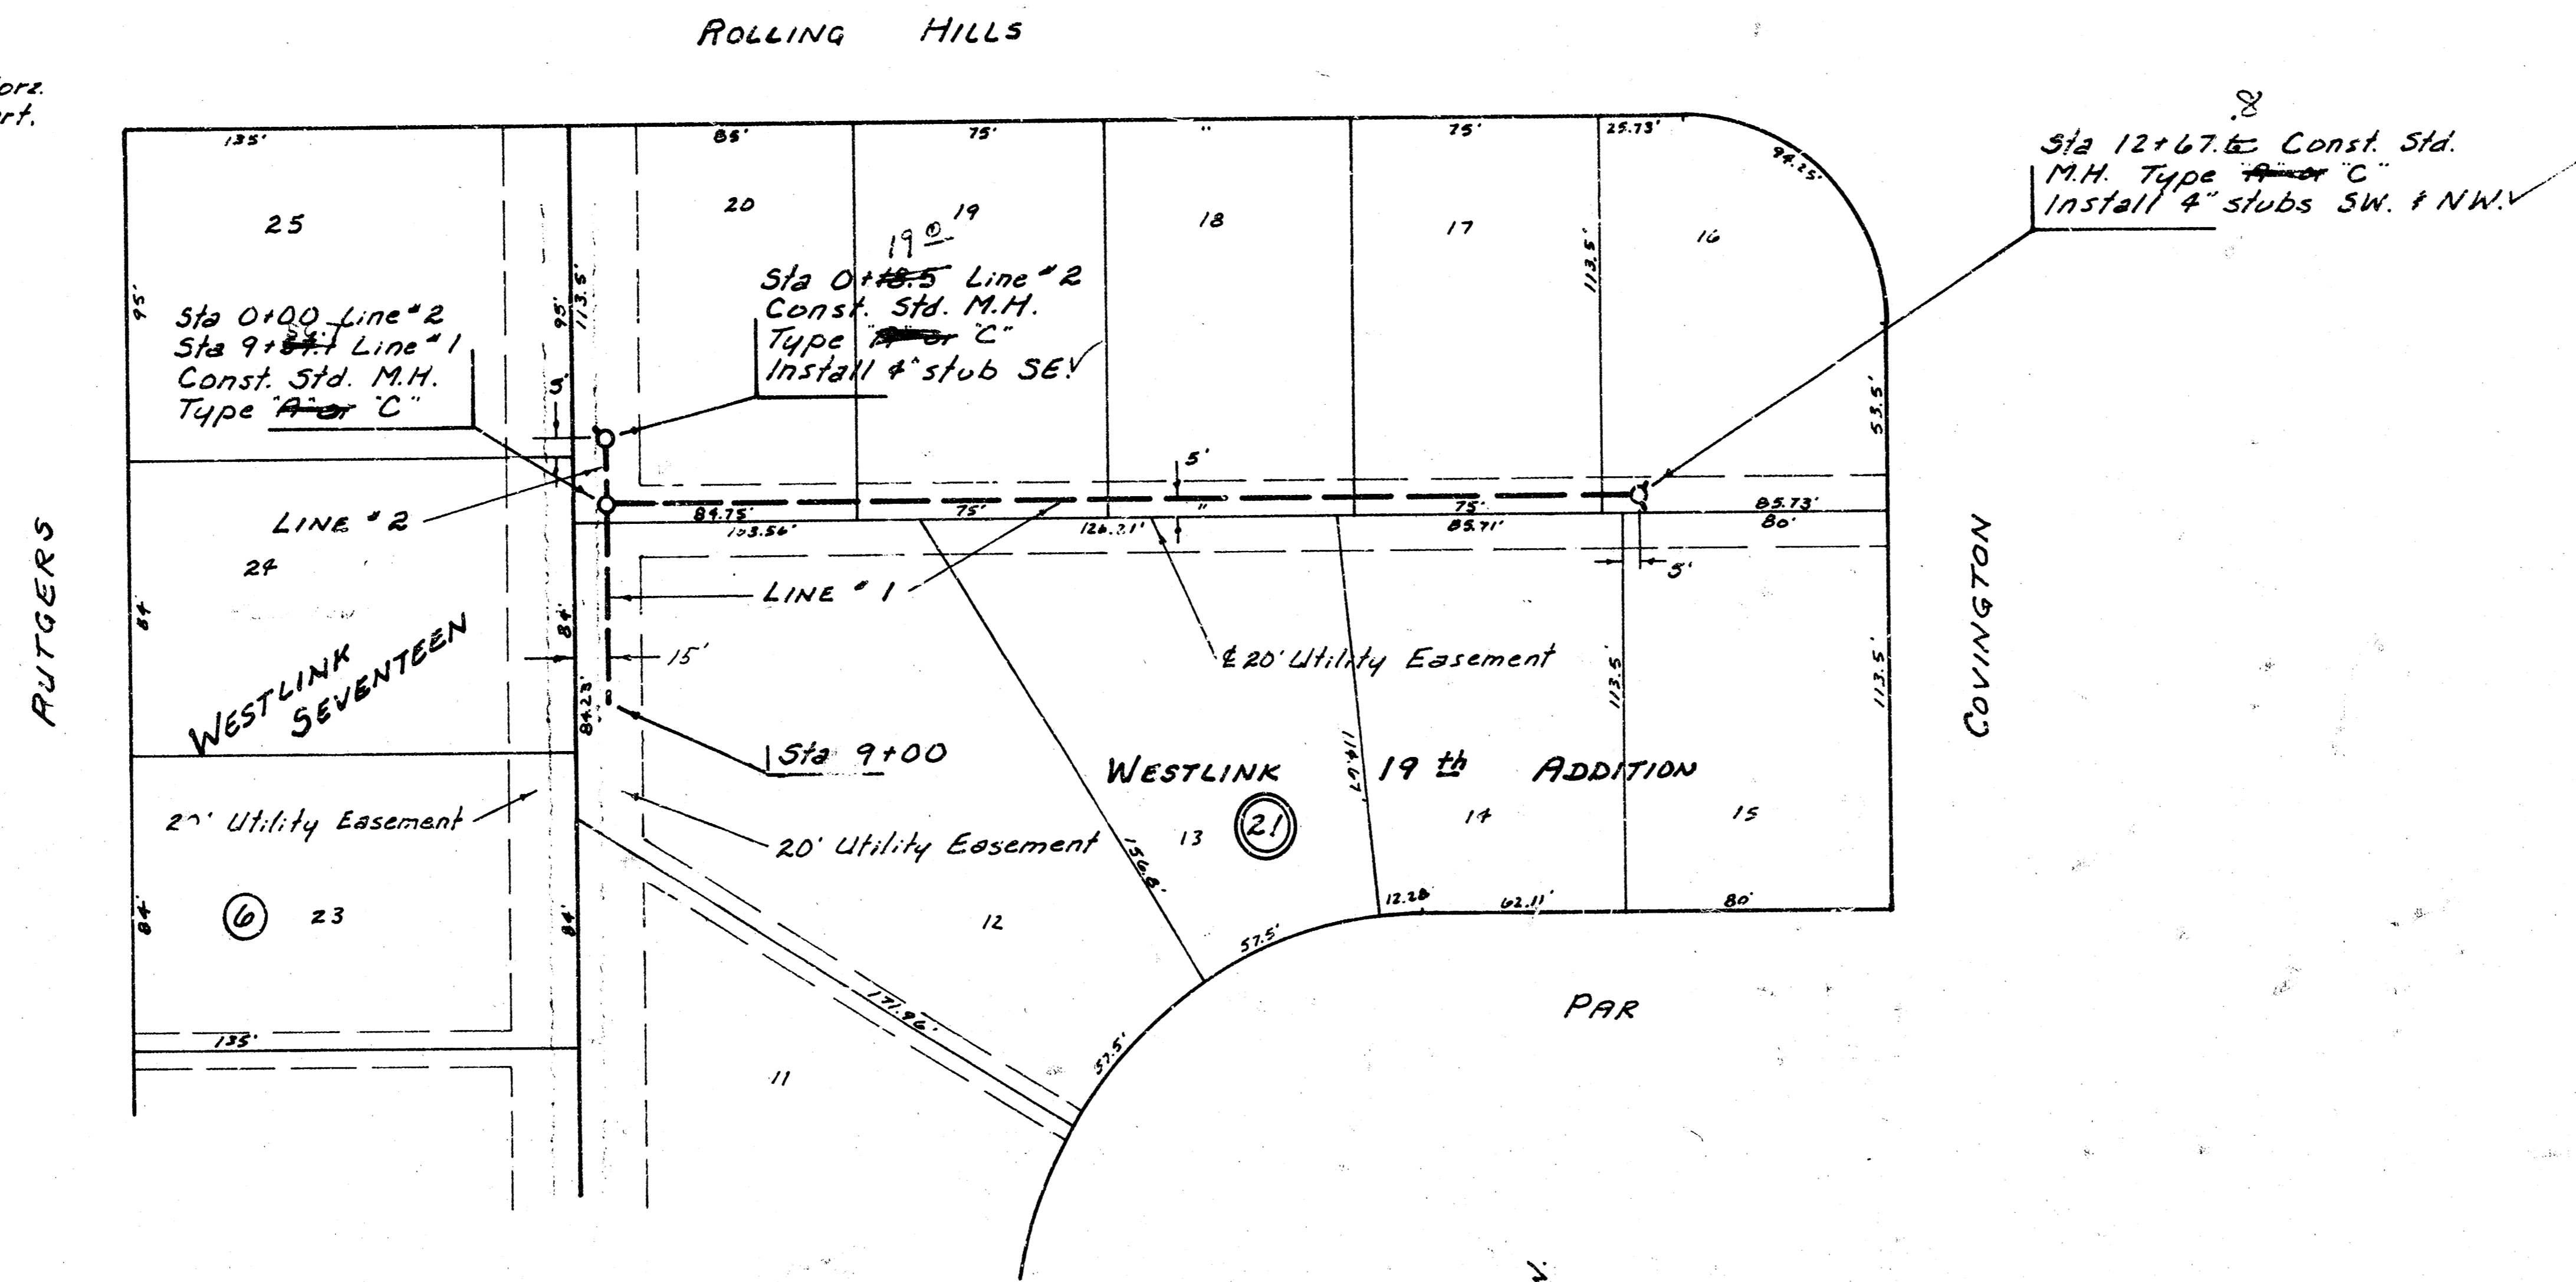

155
150
145
140
135

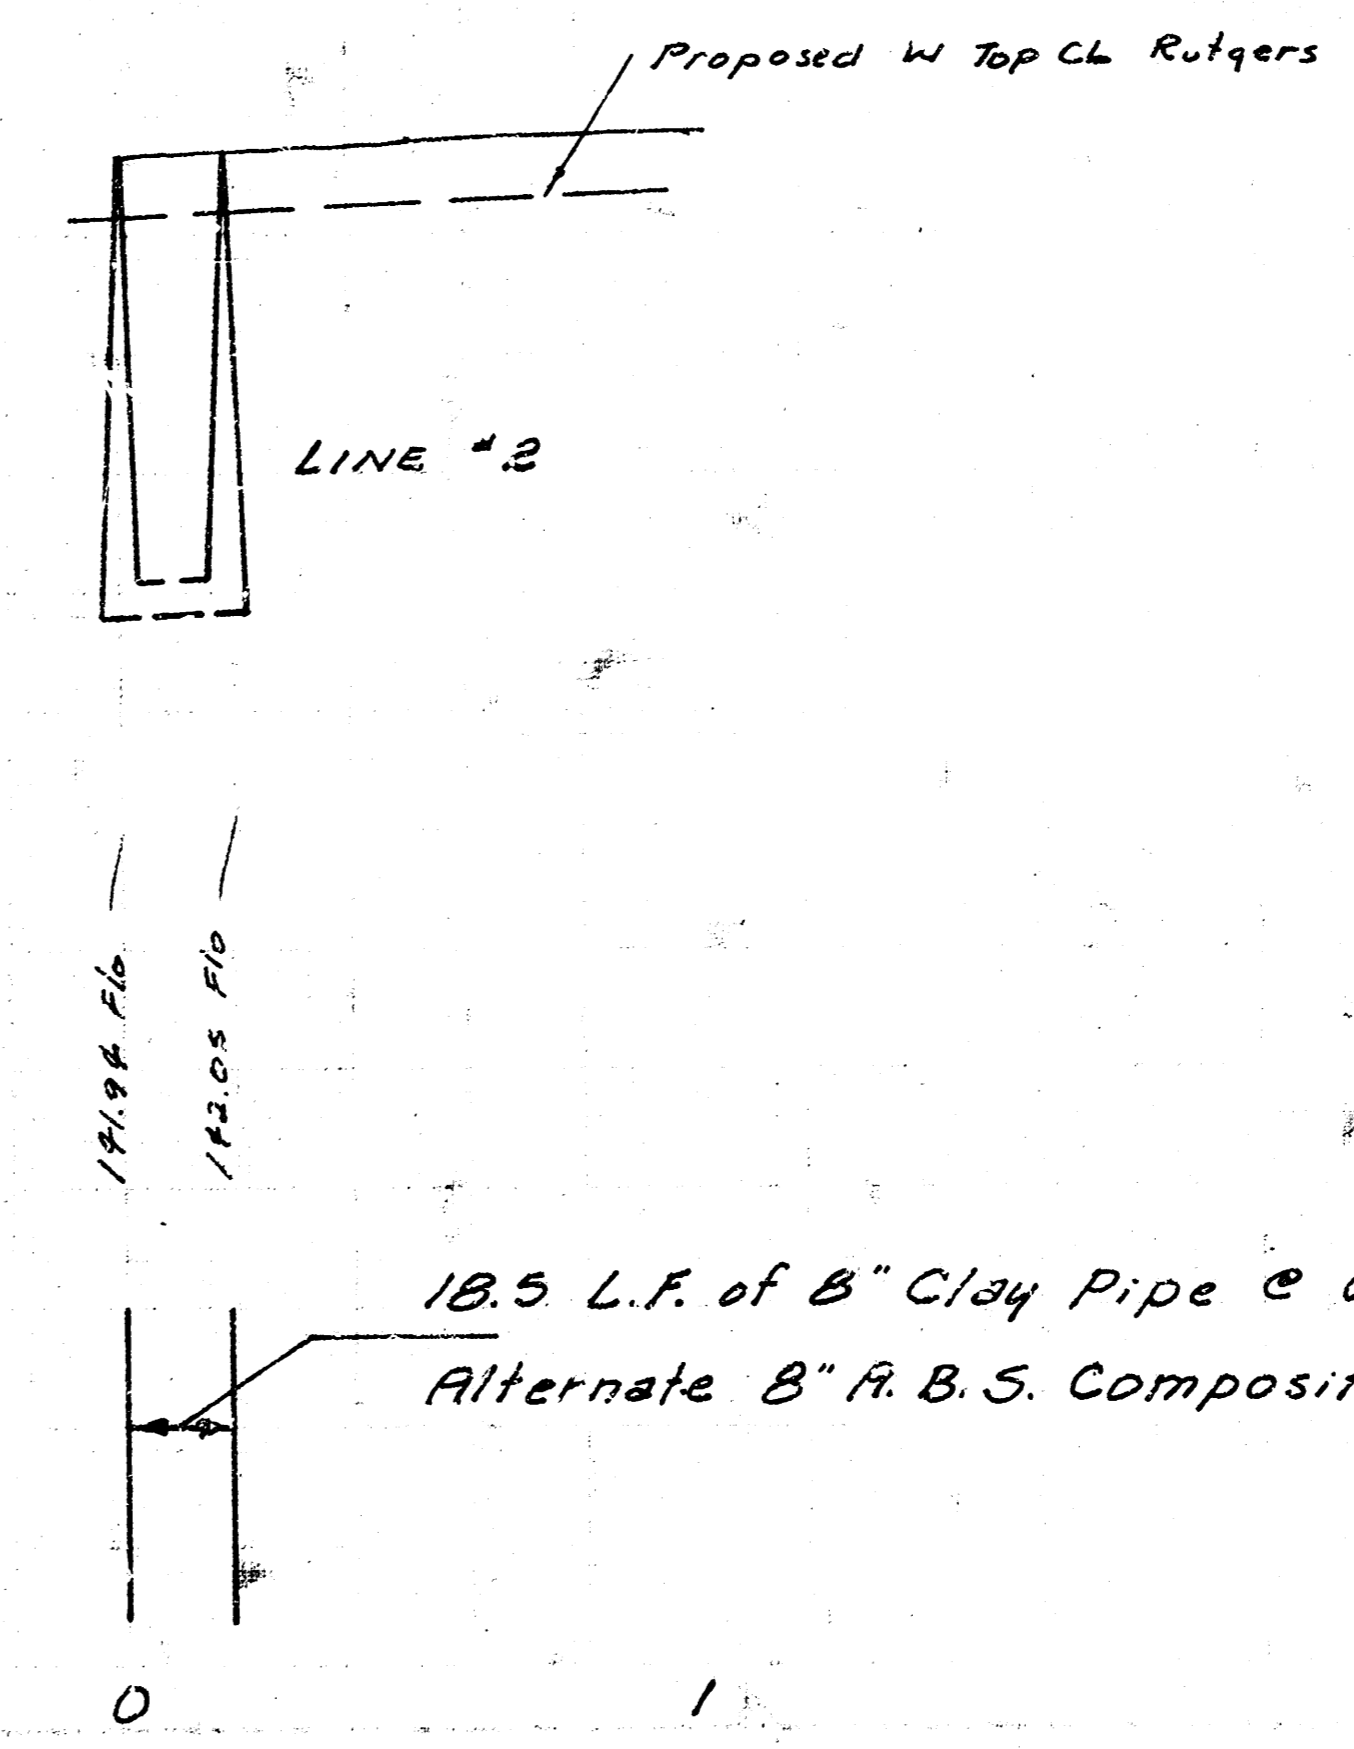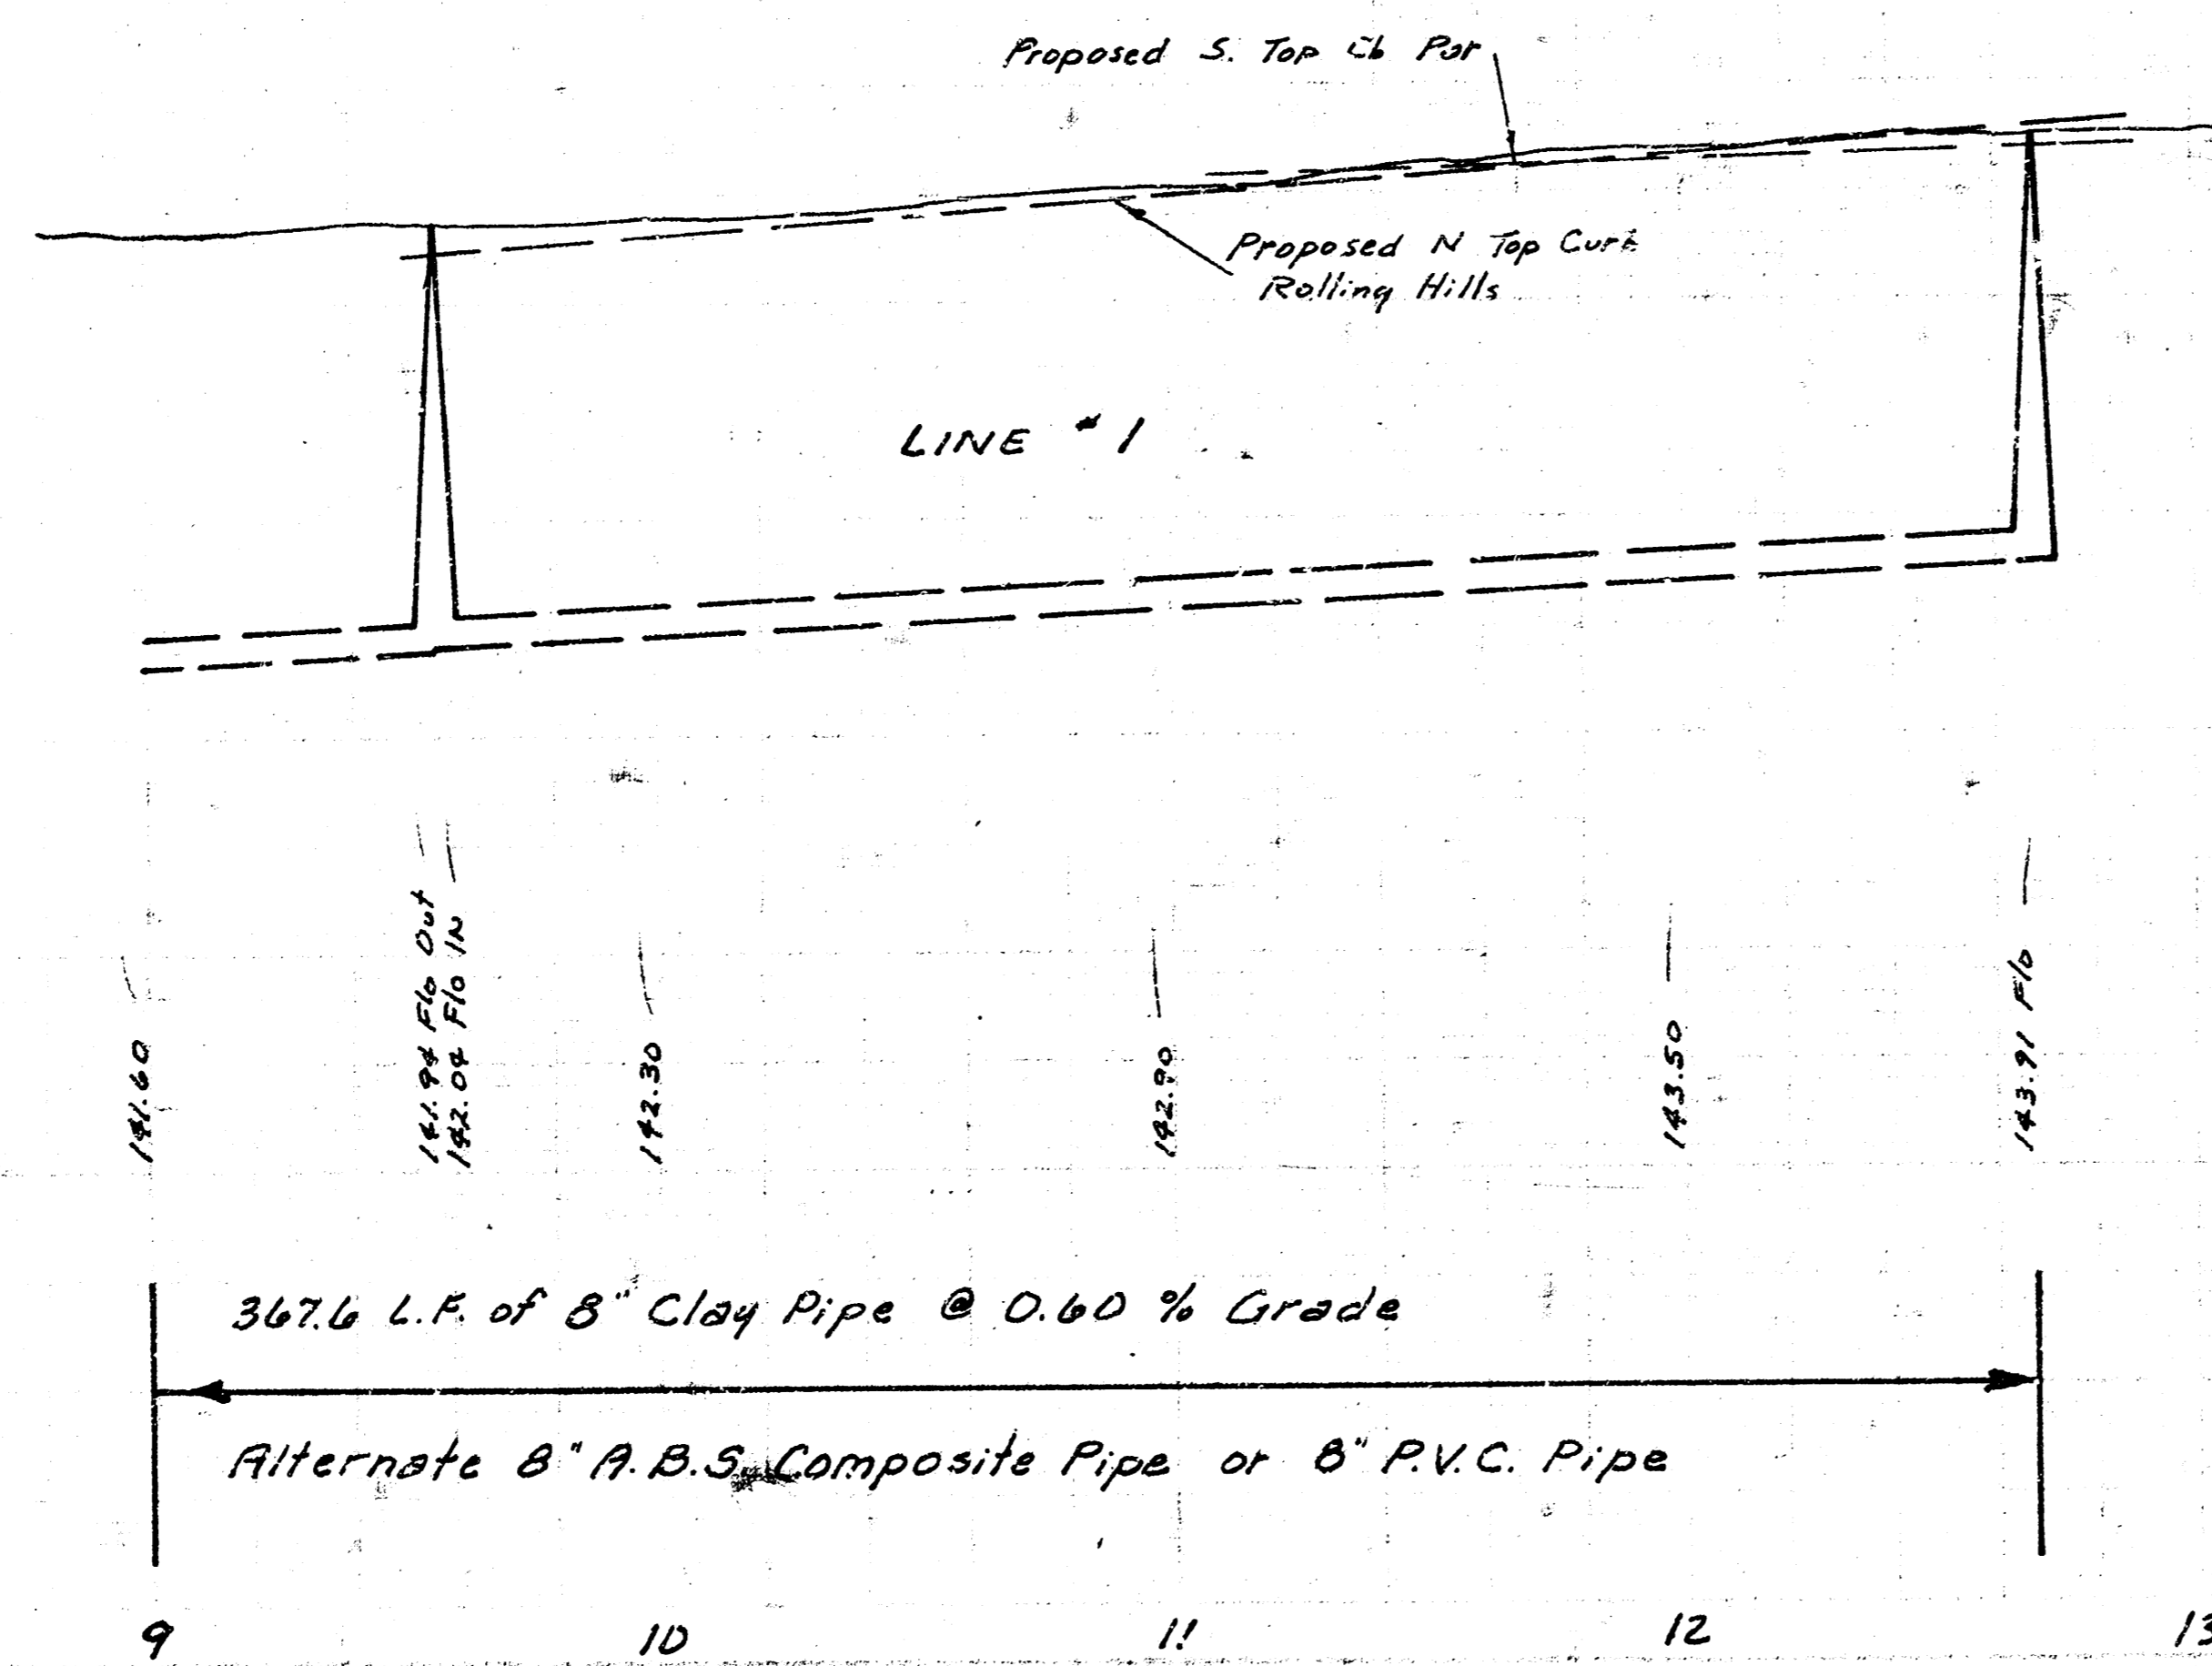

155
150
145
140
135

7/2