

The developer is to establish top of manhole elevations even if top of manhole elevations are shown.

NOTE:
Replace drive
and pavement.
Take ties to
cross on
pavement.

D. L. K.
J. R. W.

156

Plan Scale 1" = 40'
Profile Scale 1" = 40' Horiz.
1" = 5' Vert.

Sta. 12+36.5 Const.
Std. M. N. Type "A"
Sta. 0+00.0 Line No. 7 So.

B. M. 181.33 So. Rim of M.H. 14' S. of 0+00.0
Line No. 1 - This M.H. is 280' W. of
M.H. shown on Addn. Plat.

B. M. 189.42 SE cor. conc. perch 6002 Murdock.

B. M. 194.42 "t" top N-ch Murdock 12' W. of W.L.
Marjorie NW cor. Murdock - Marjorie.








B. M. 201.18 SE cor. bot. conc. step 6302 Murdock.

LAT. 95, DRY CREEK MAIN 2, S. S. NO. 12
CITY OF WICHITA, KANSAS
R. W. LINN — CITY ENGINEER
DEC. 1973 PROJECT NO. DBKL 573054

As Built
Final Meas
IH-84

B. M. 39.42 SE conc. porch
6002 E. Murdock.

KAPAUN SECOND ADDITION

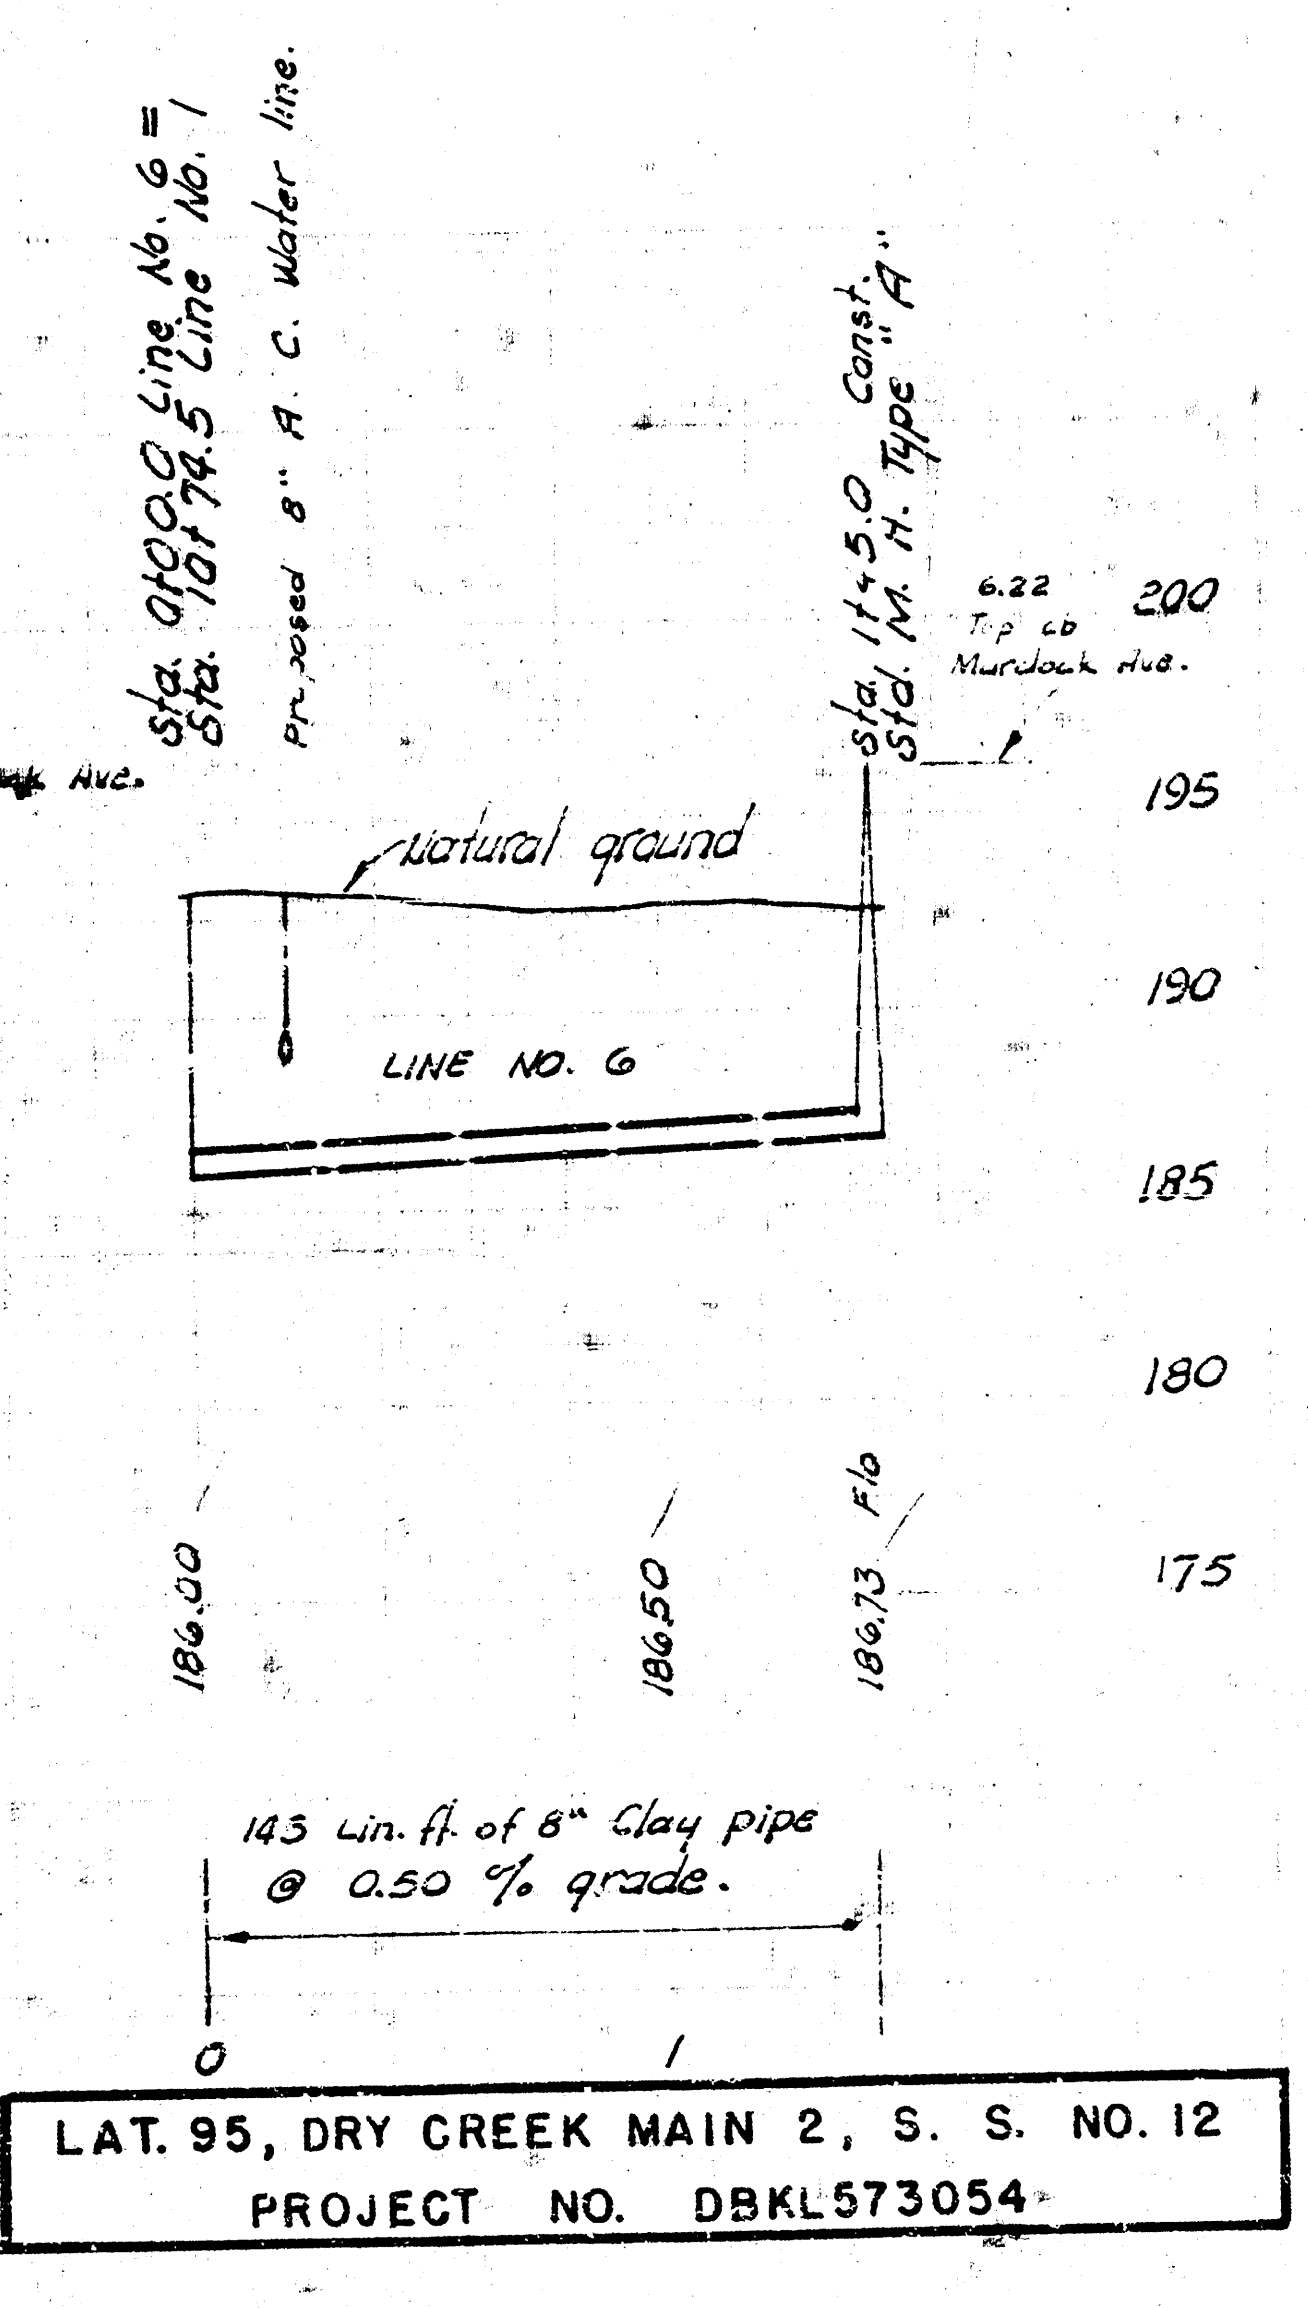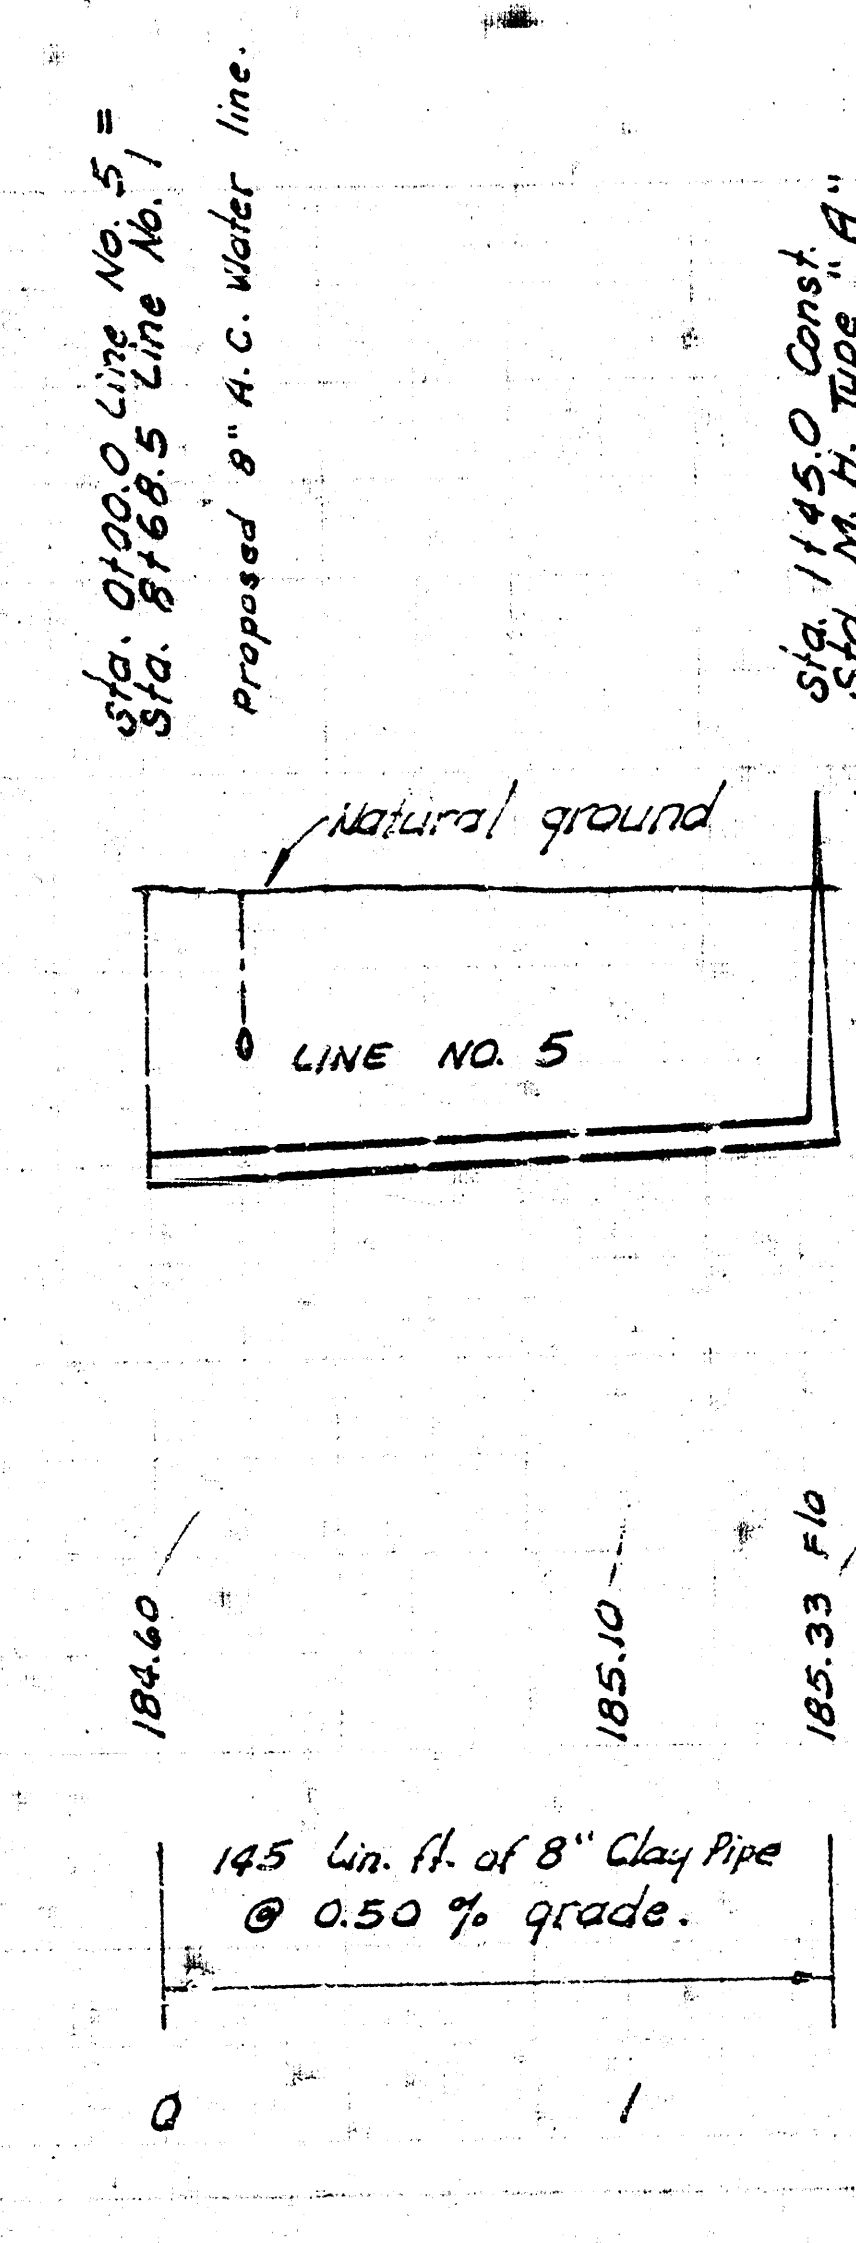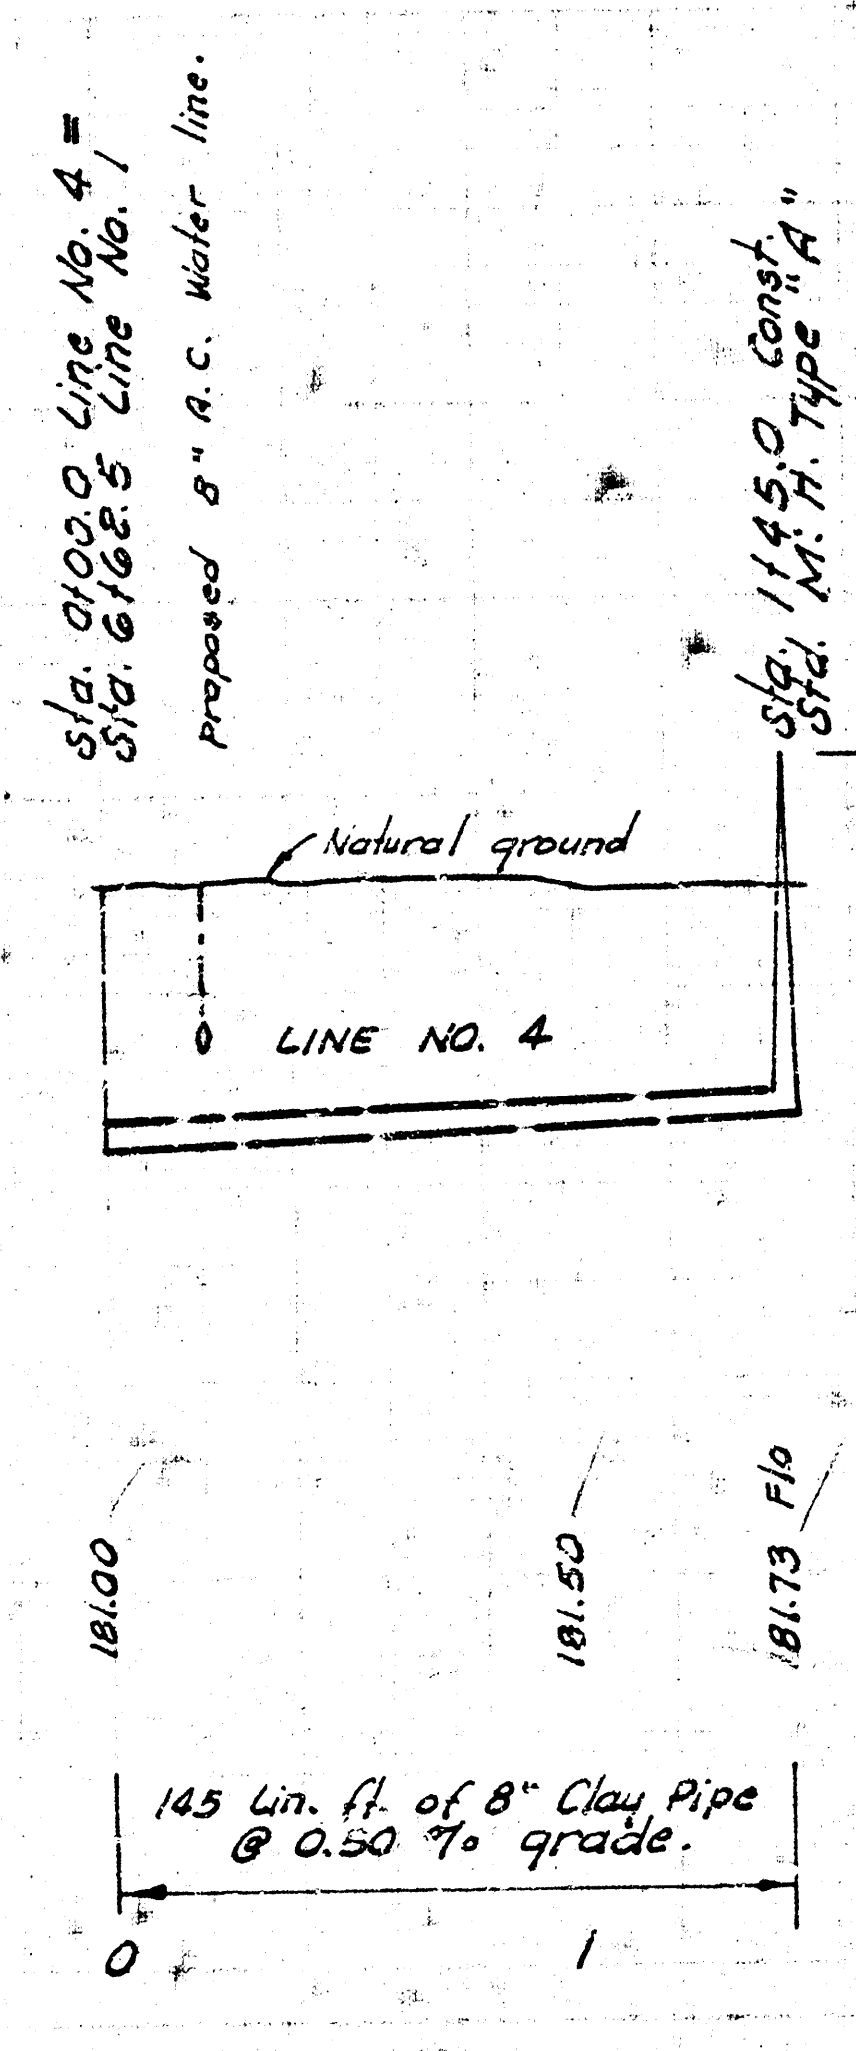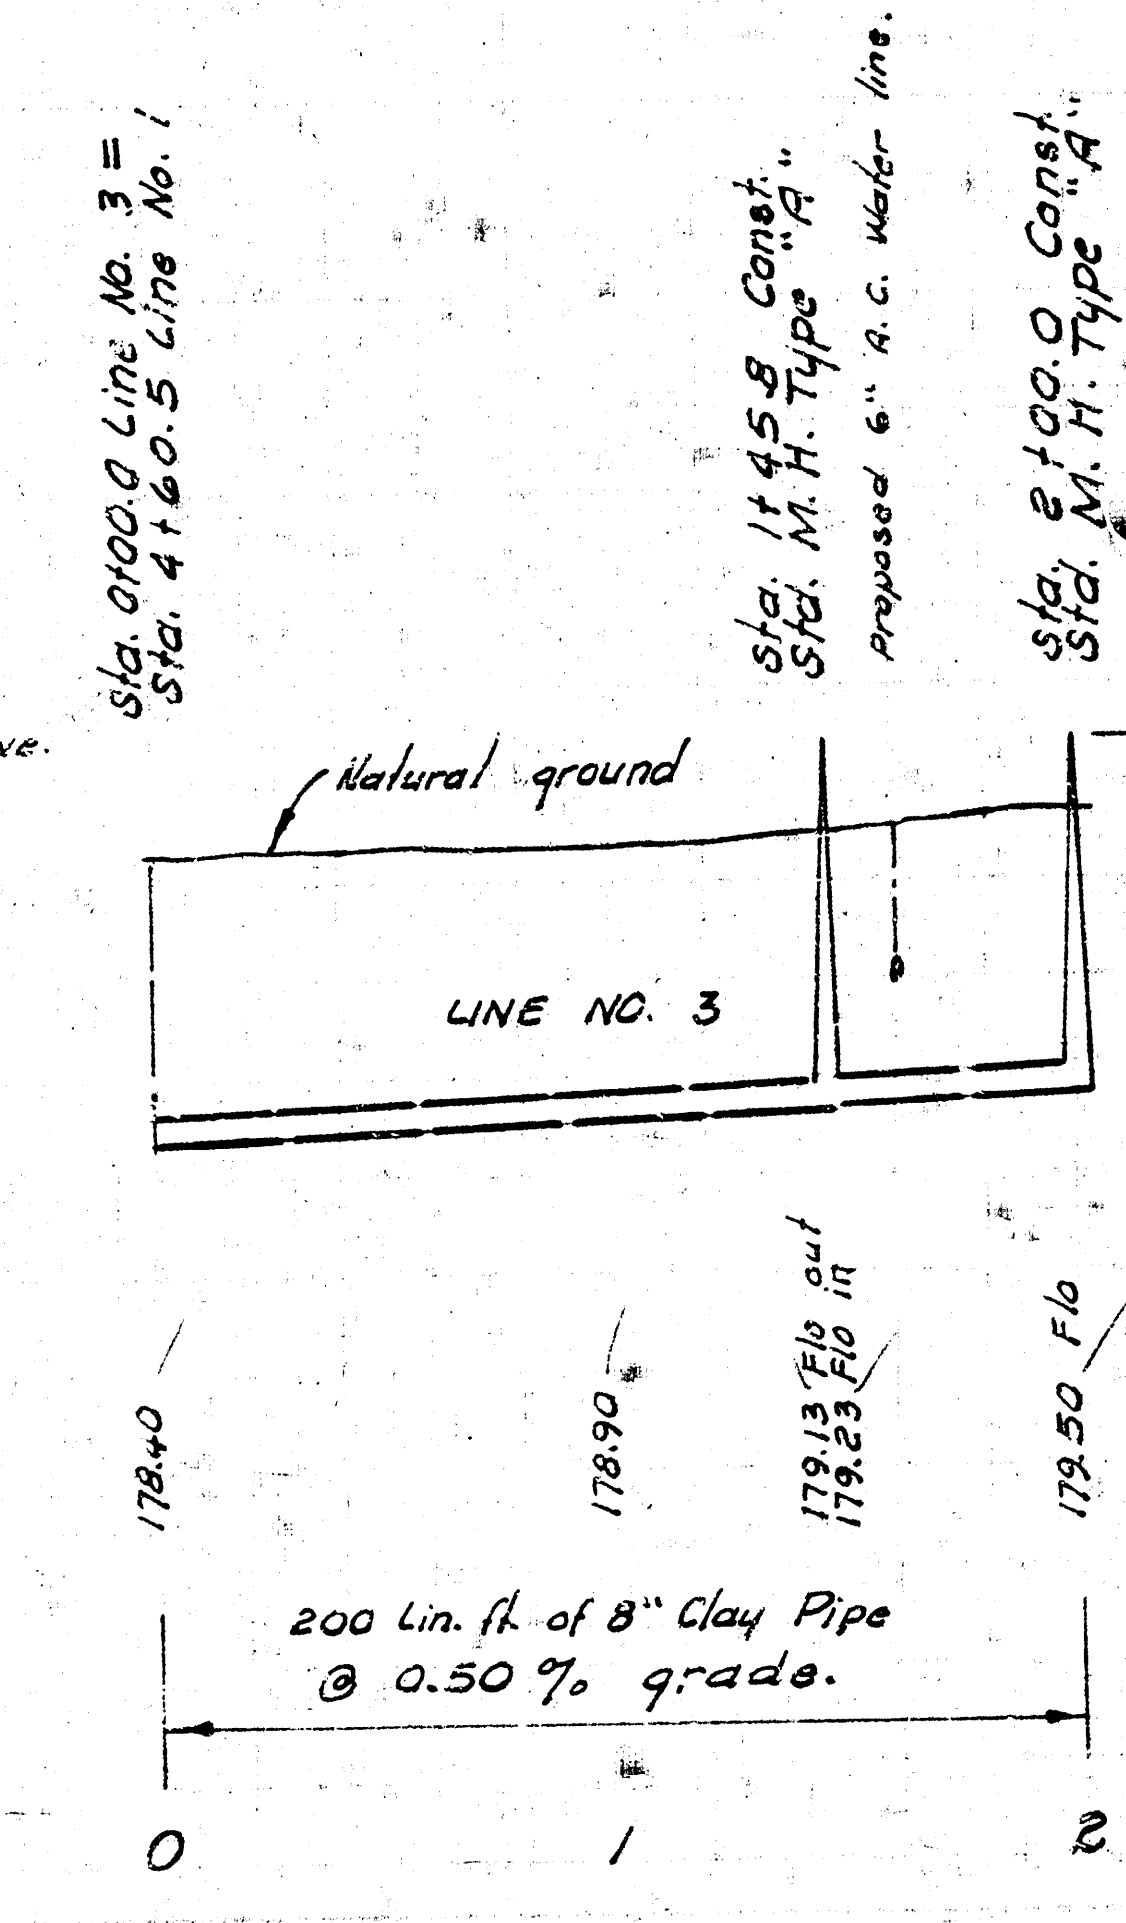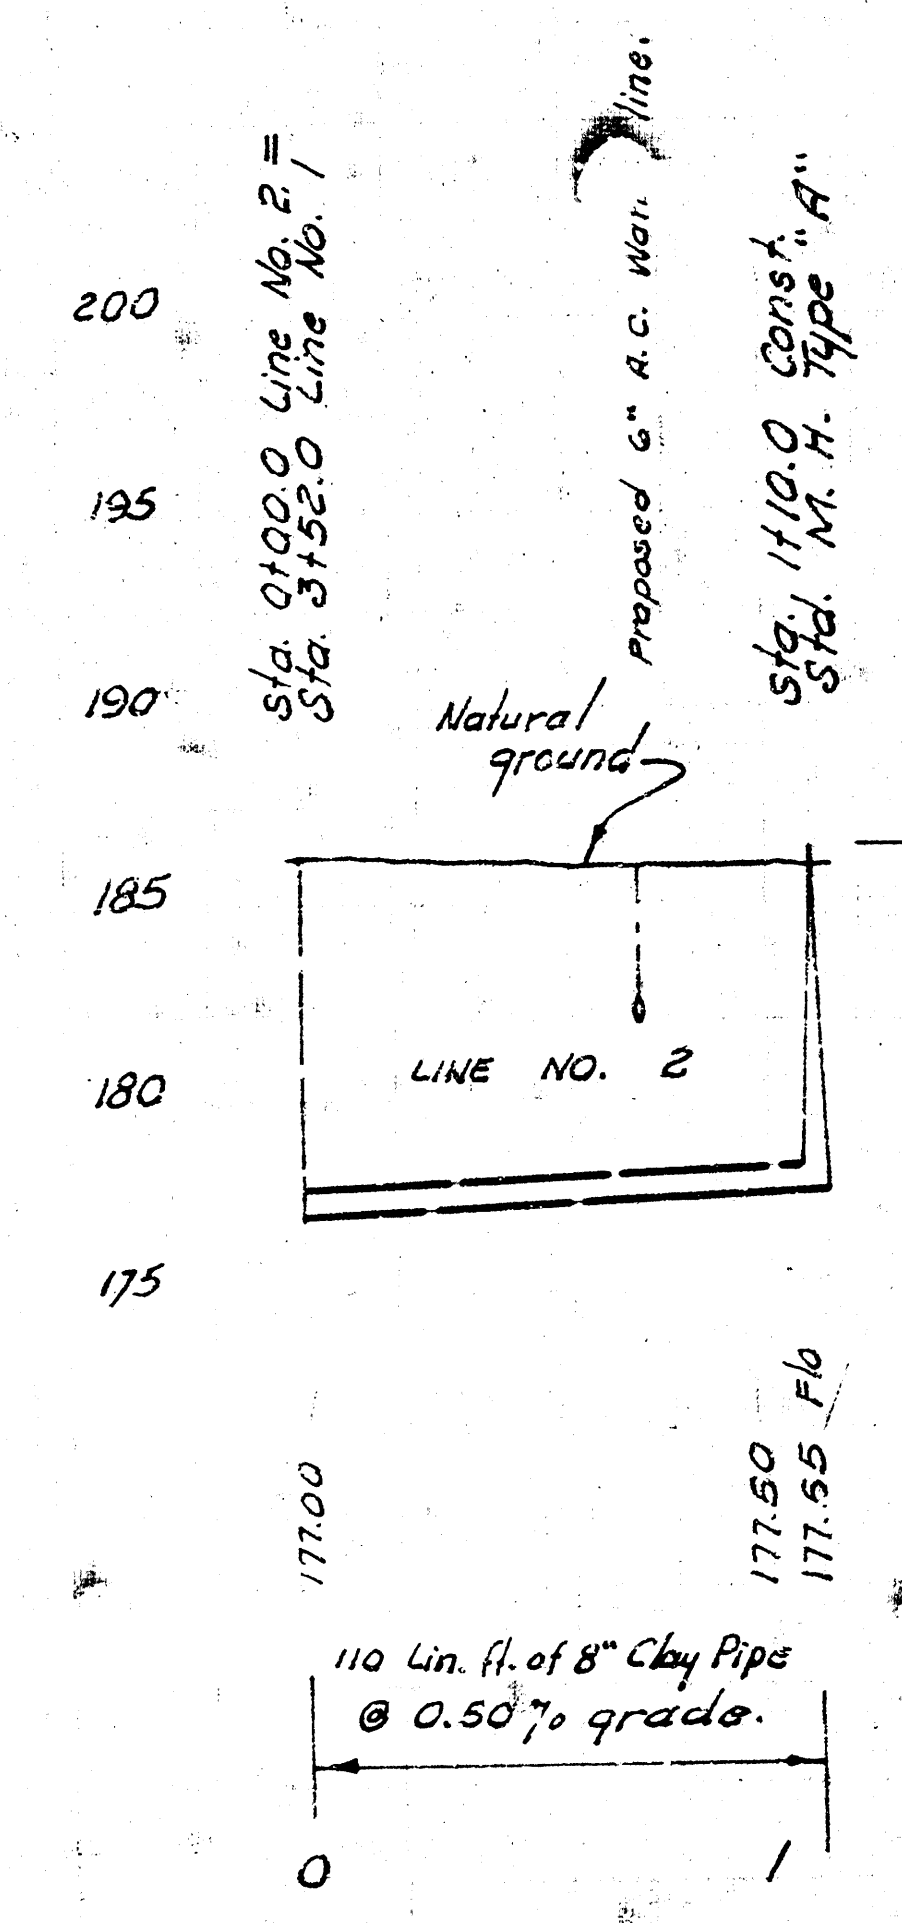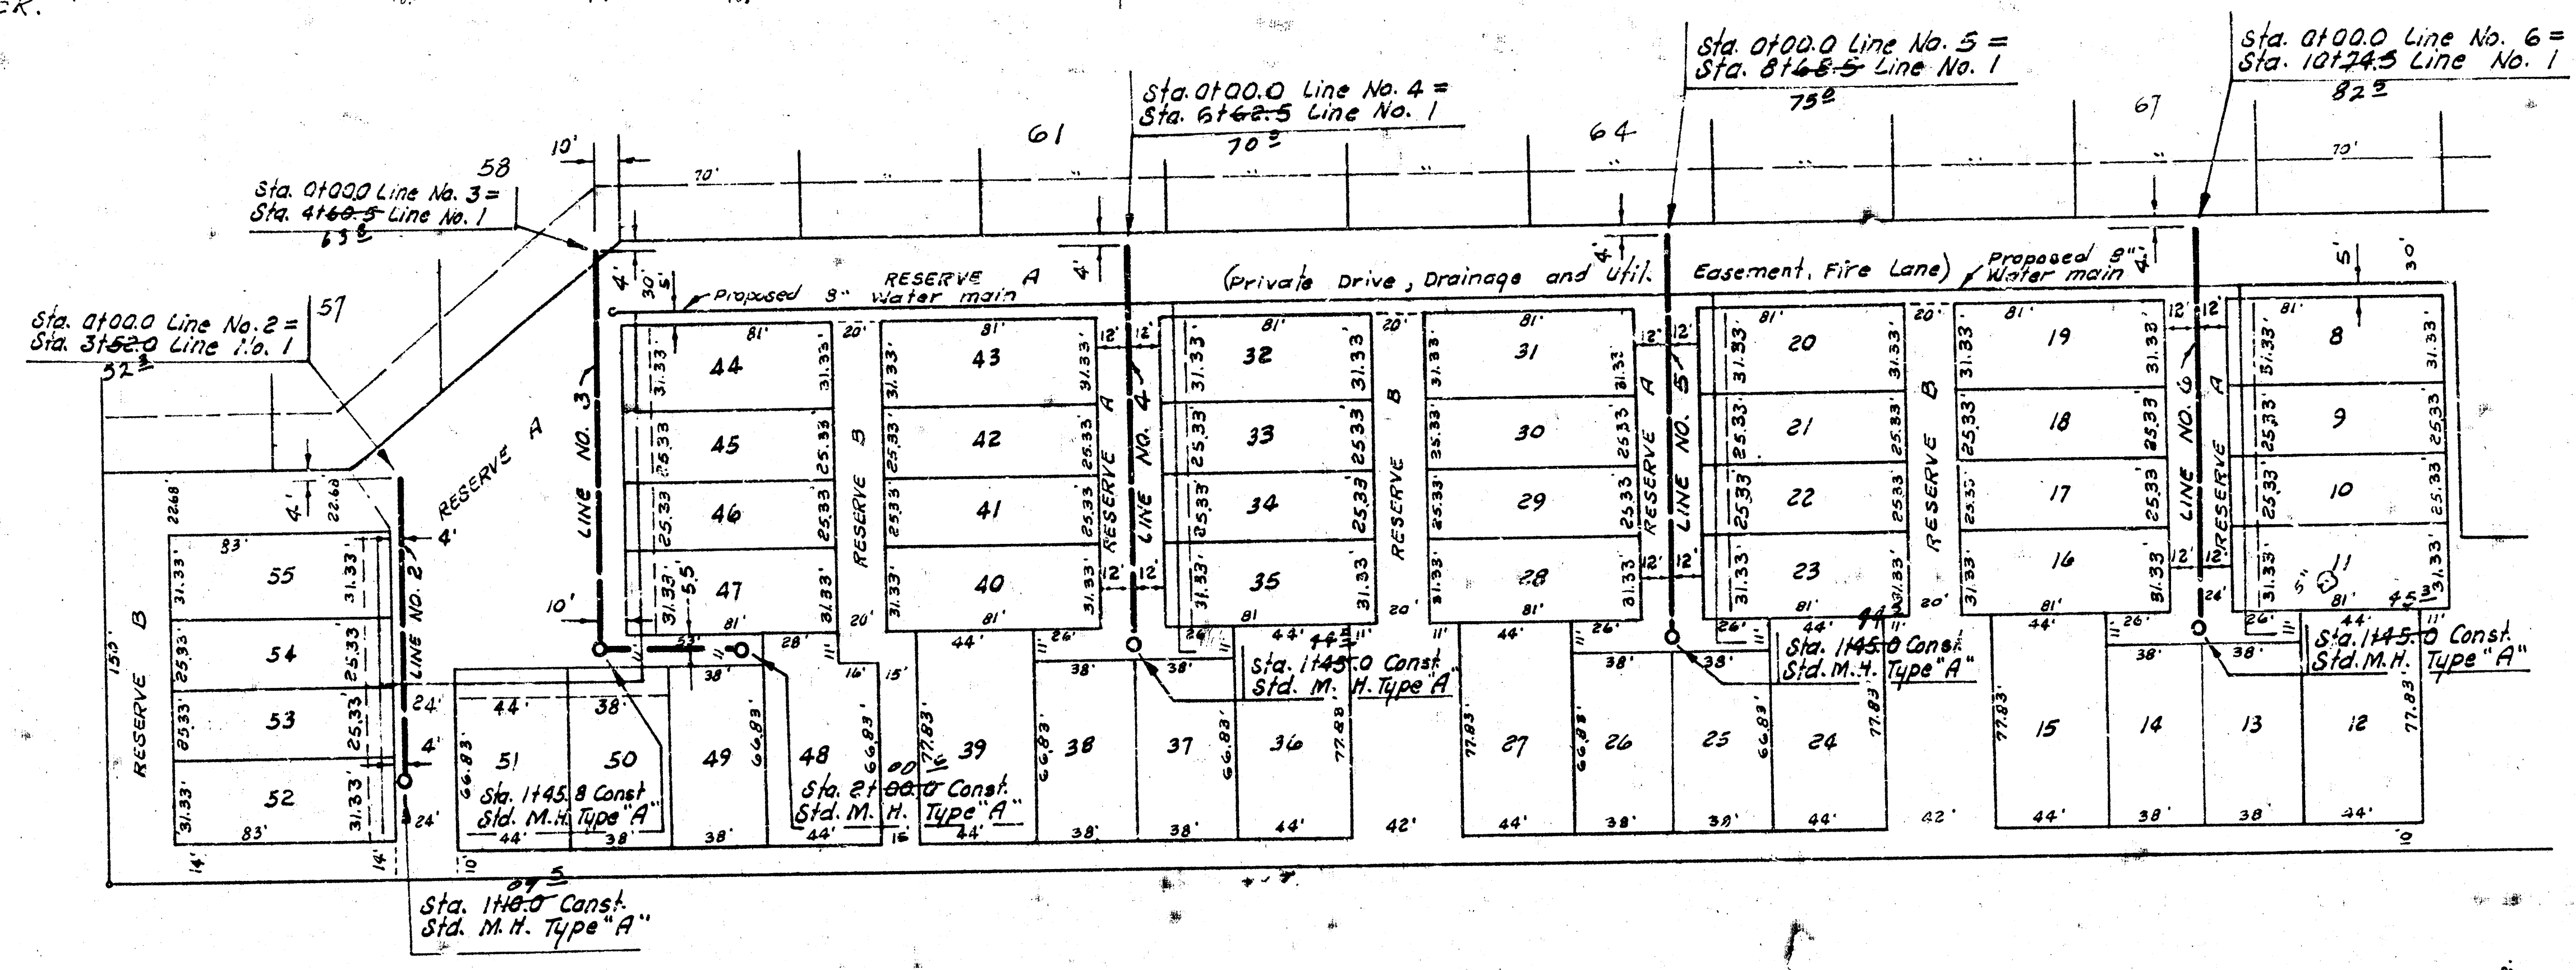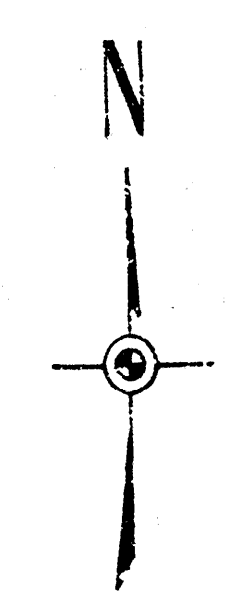

LAT. 95, DRY CREEK MAIN 2, S. S. NO. 12
PROJECT NO. DBKL573054

