

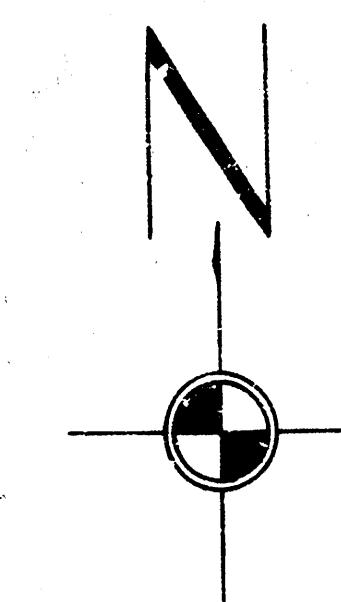
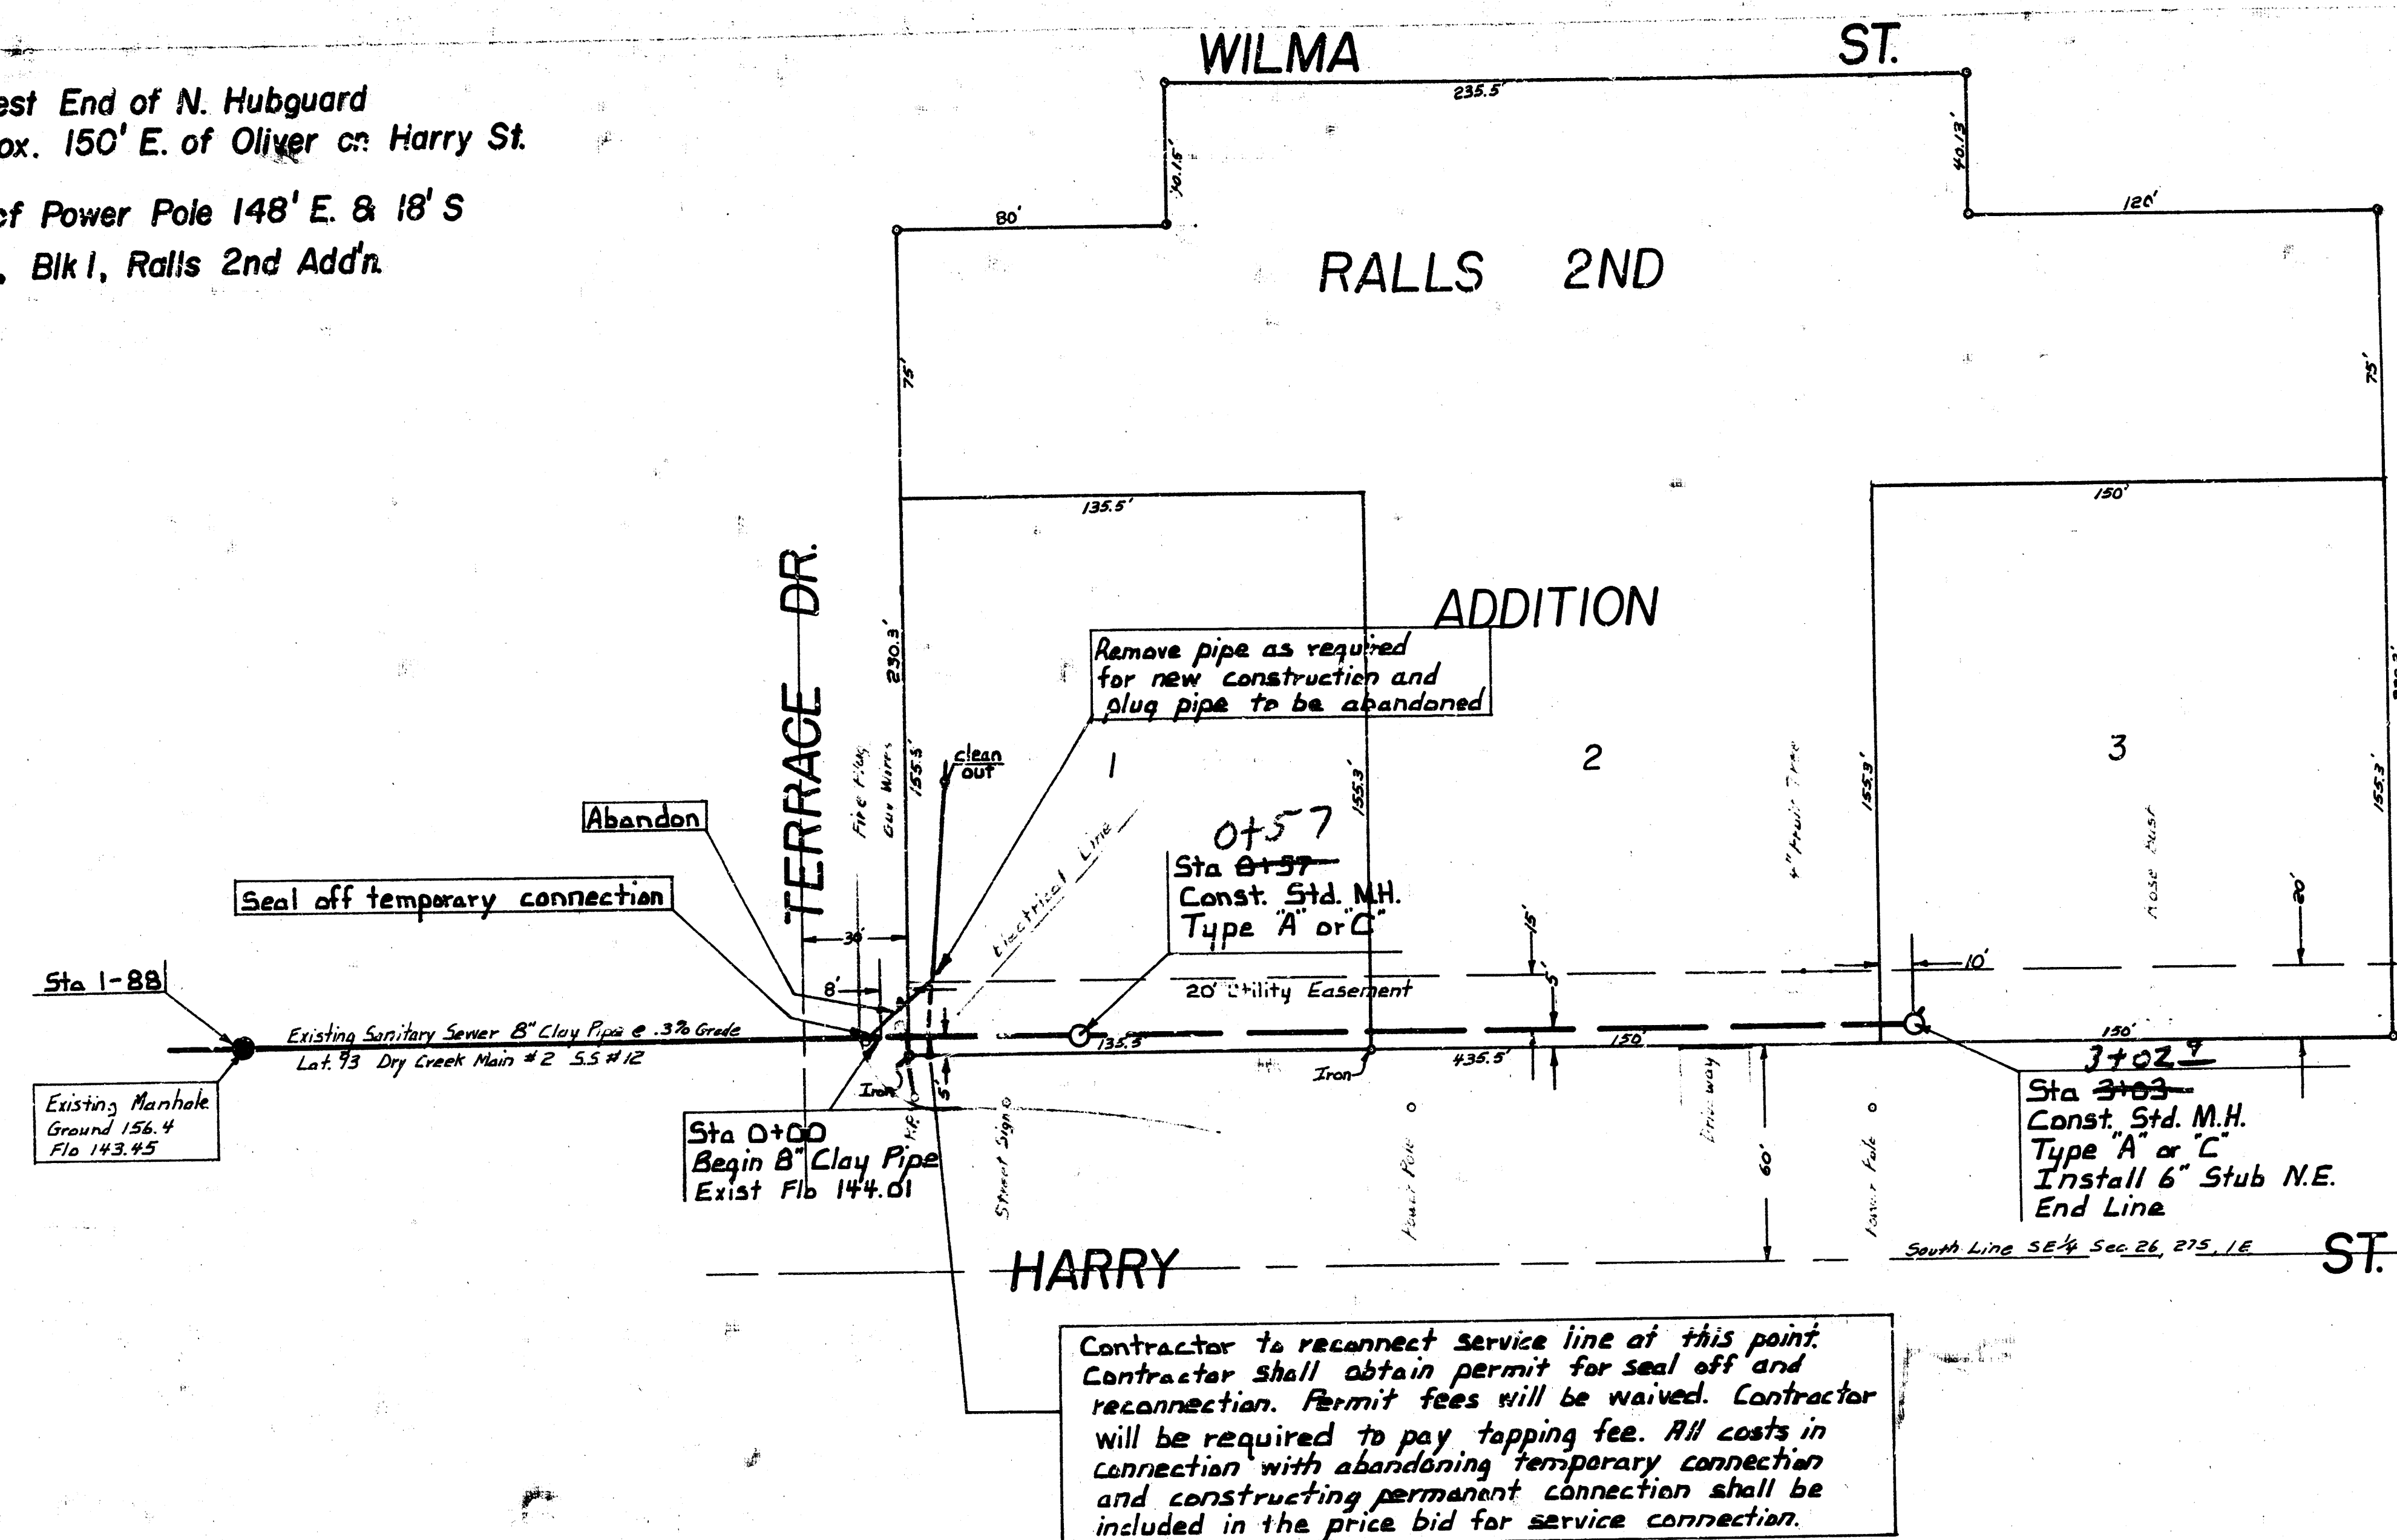


BM 142.43 City Std. Disc on West End of N. Hubguard
to new R.C.B. Approx. 150' E. of Oliver on Harry St.

BM 152.19 R.R. Spike N. Side of Power Pole 148' E. & 18' S
of SE. Cor. of Lot 1, Blk 1, Ralls 2nd Add'n.

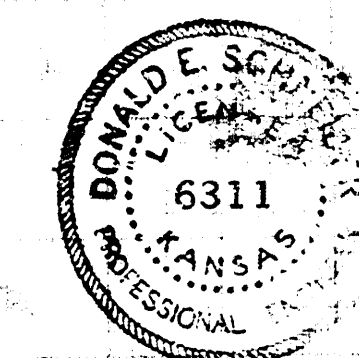

Plan Scale 1" = 40'
Profile Scale 1" = 40' Hor.
1" = 5' Vert.

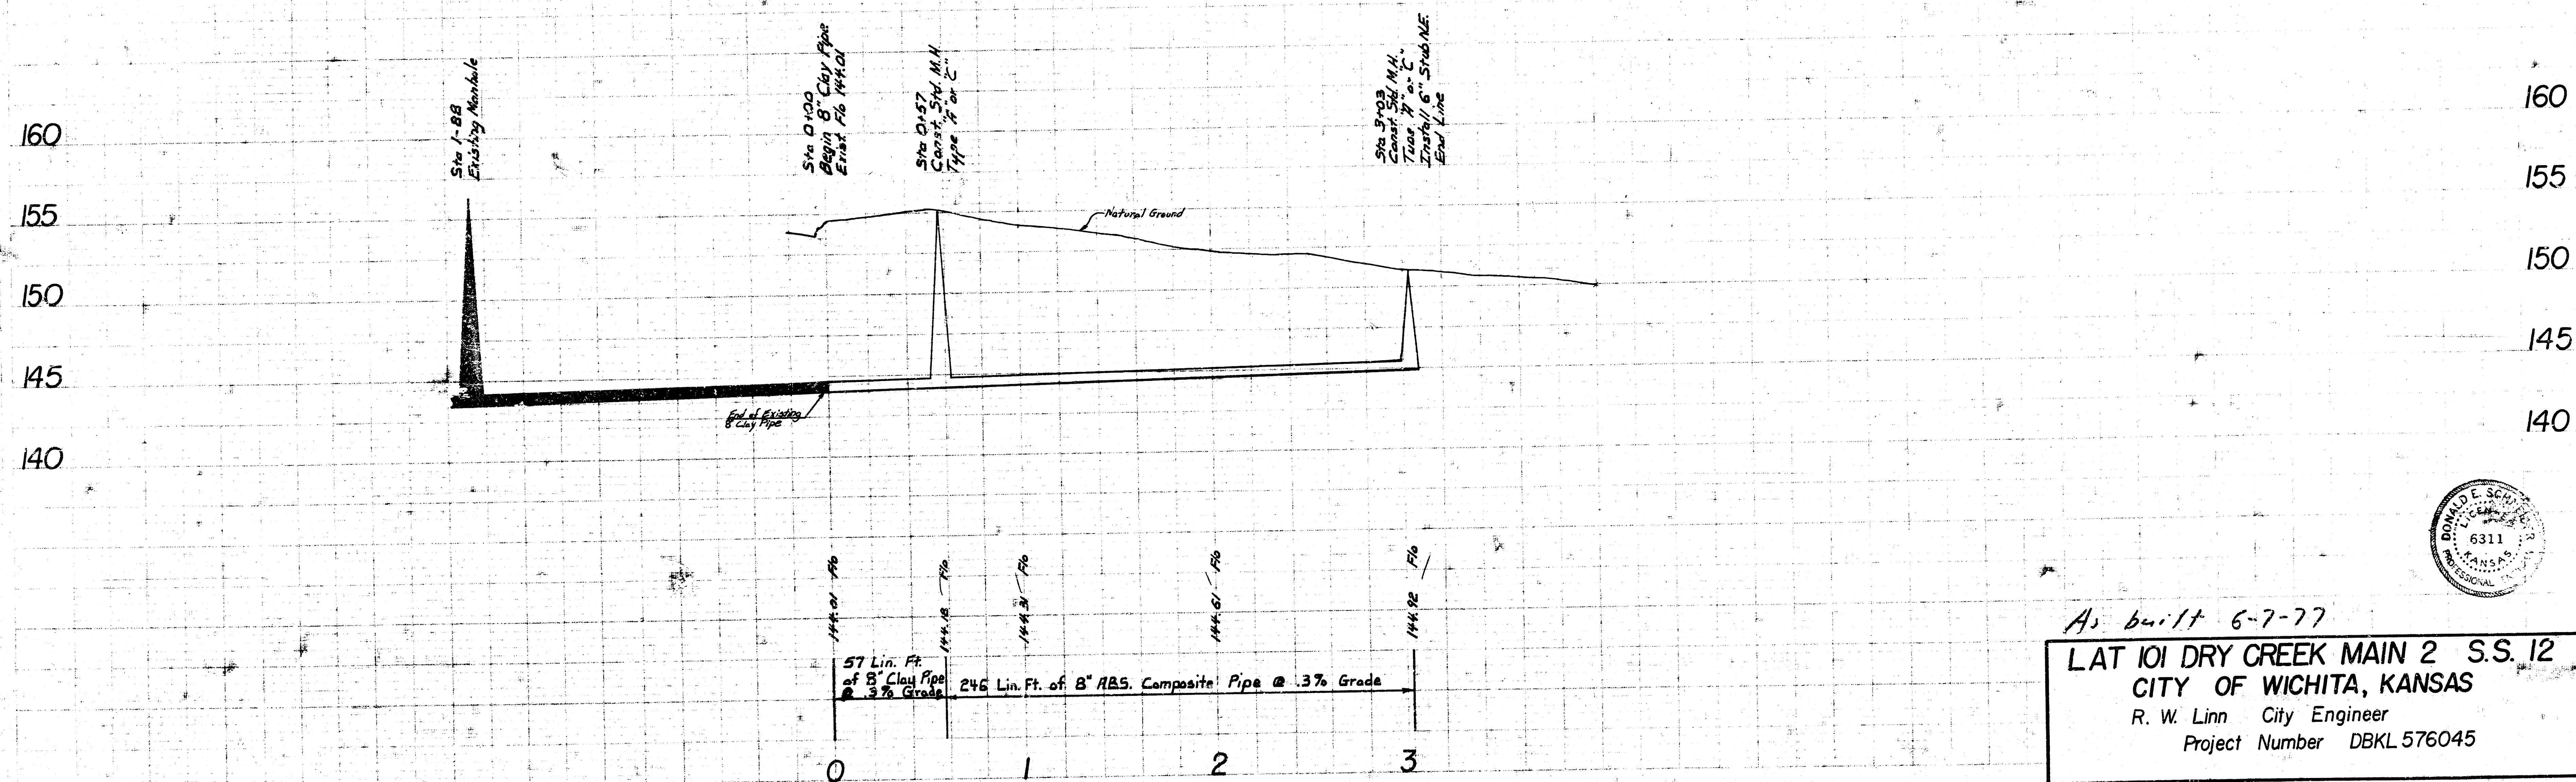

As built 6-7-77

LAT 101 DRY CREEK MAIN 2 S.S. 12
CITY OF WICHITA, KANSAS
R. W. Linn City Engineer
Project Number DBKL 576045

14 10 3 10