
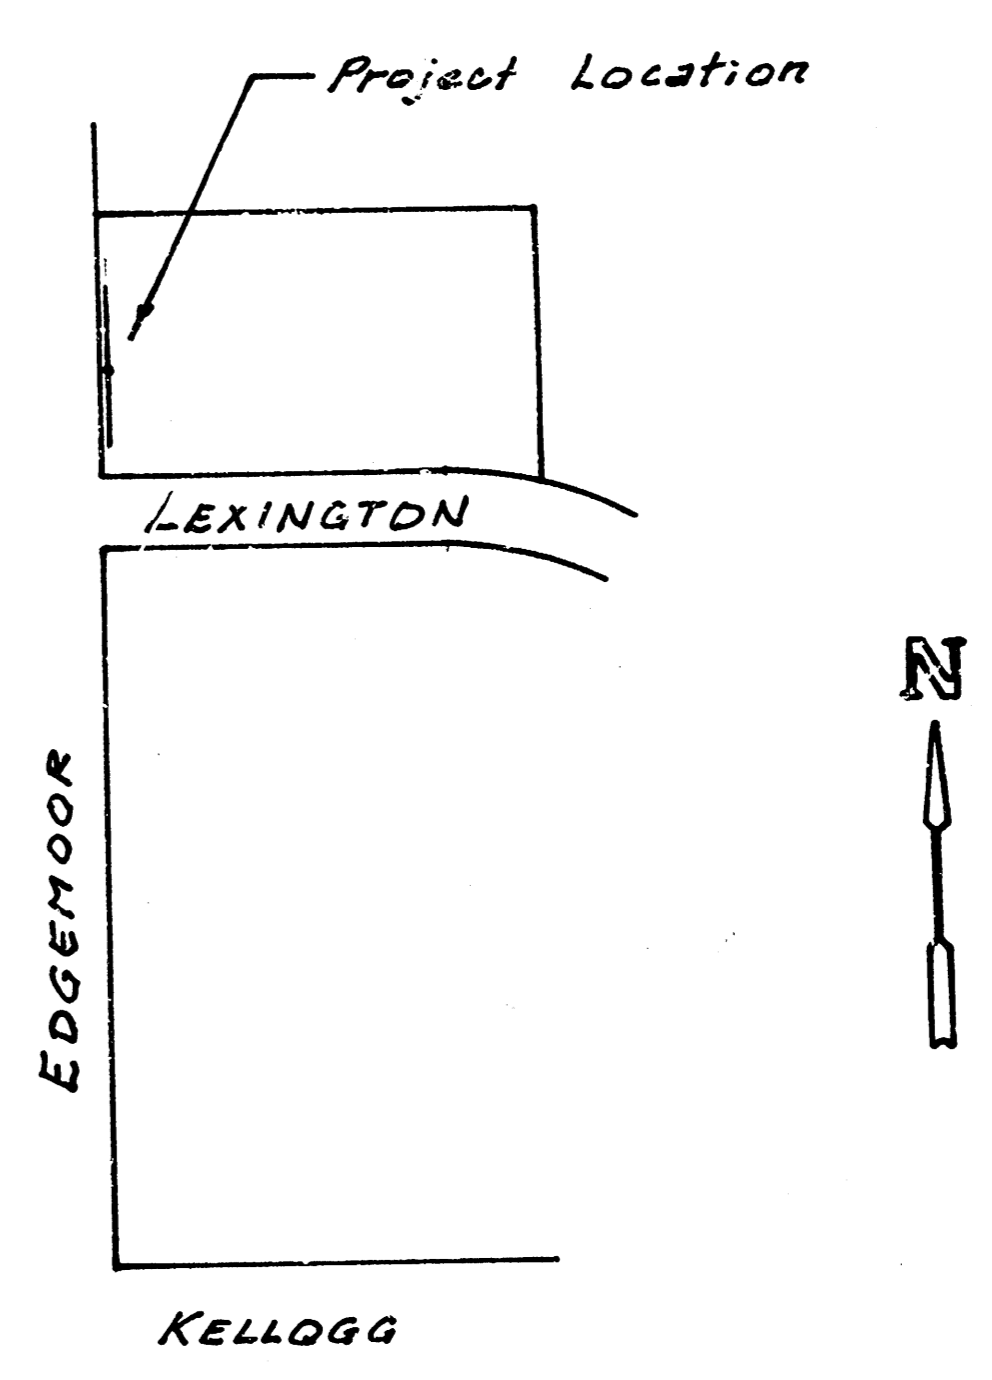



159.99 Elev. City of Wichita Bench Mark Disc.  
N.E. Corner R.C.B.C. at Edgemoor and  
East Branch Dry Creek (North of Kellogg).

Scale Plan 1" = 40'  
Profile 1" = 40' Horiz.  
1" = 5' Vert.

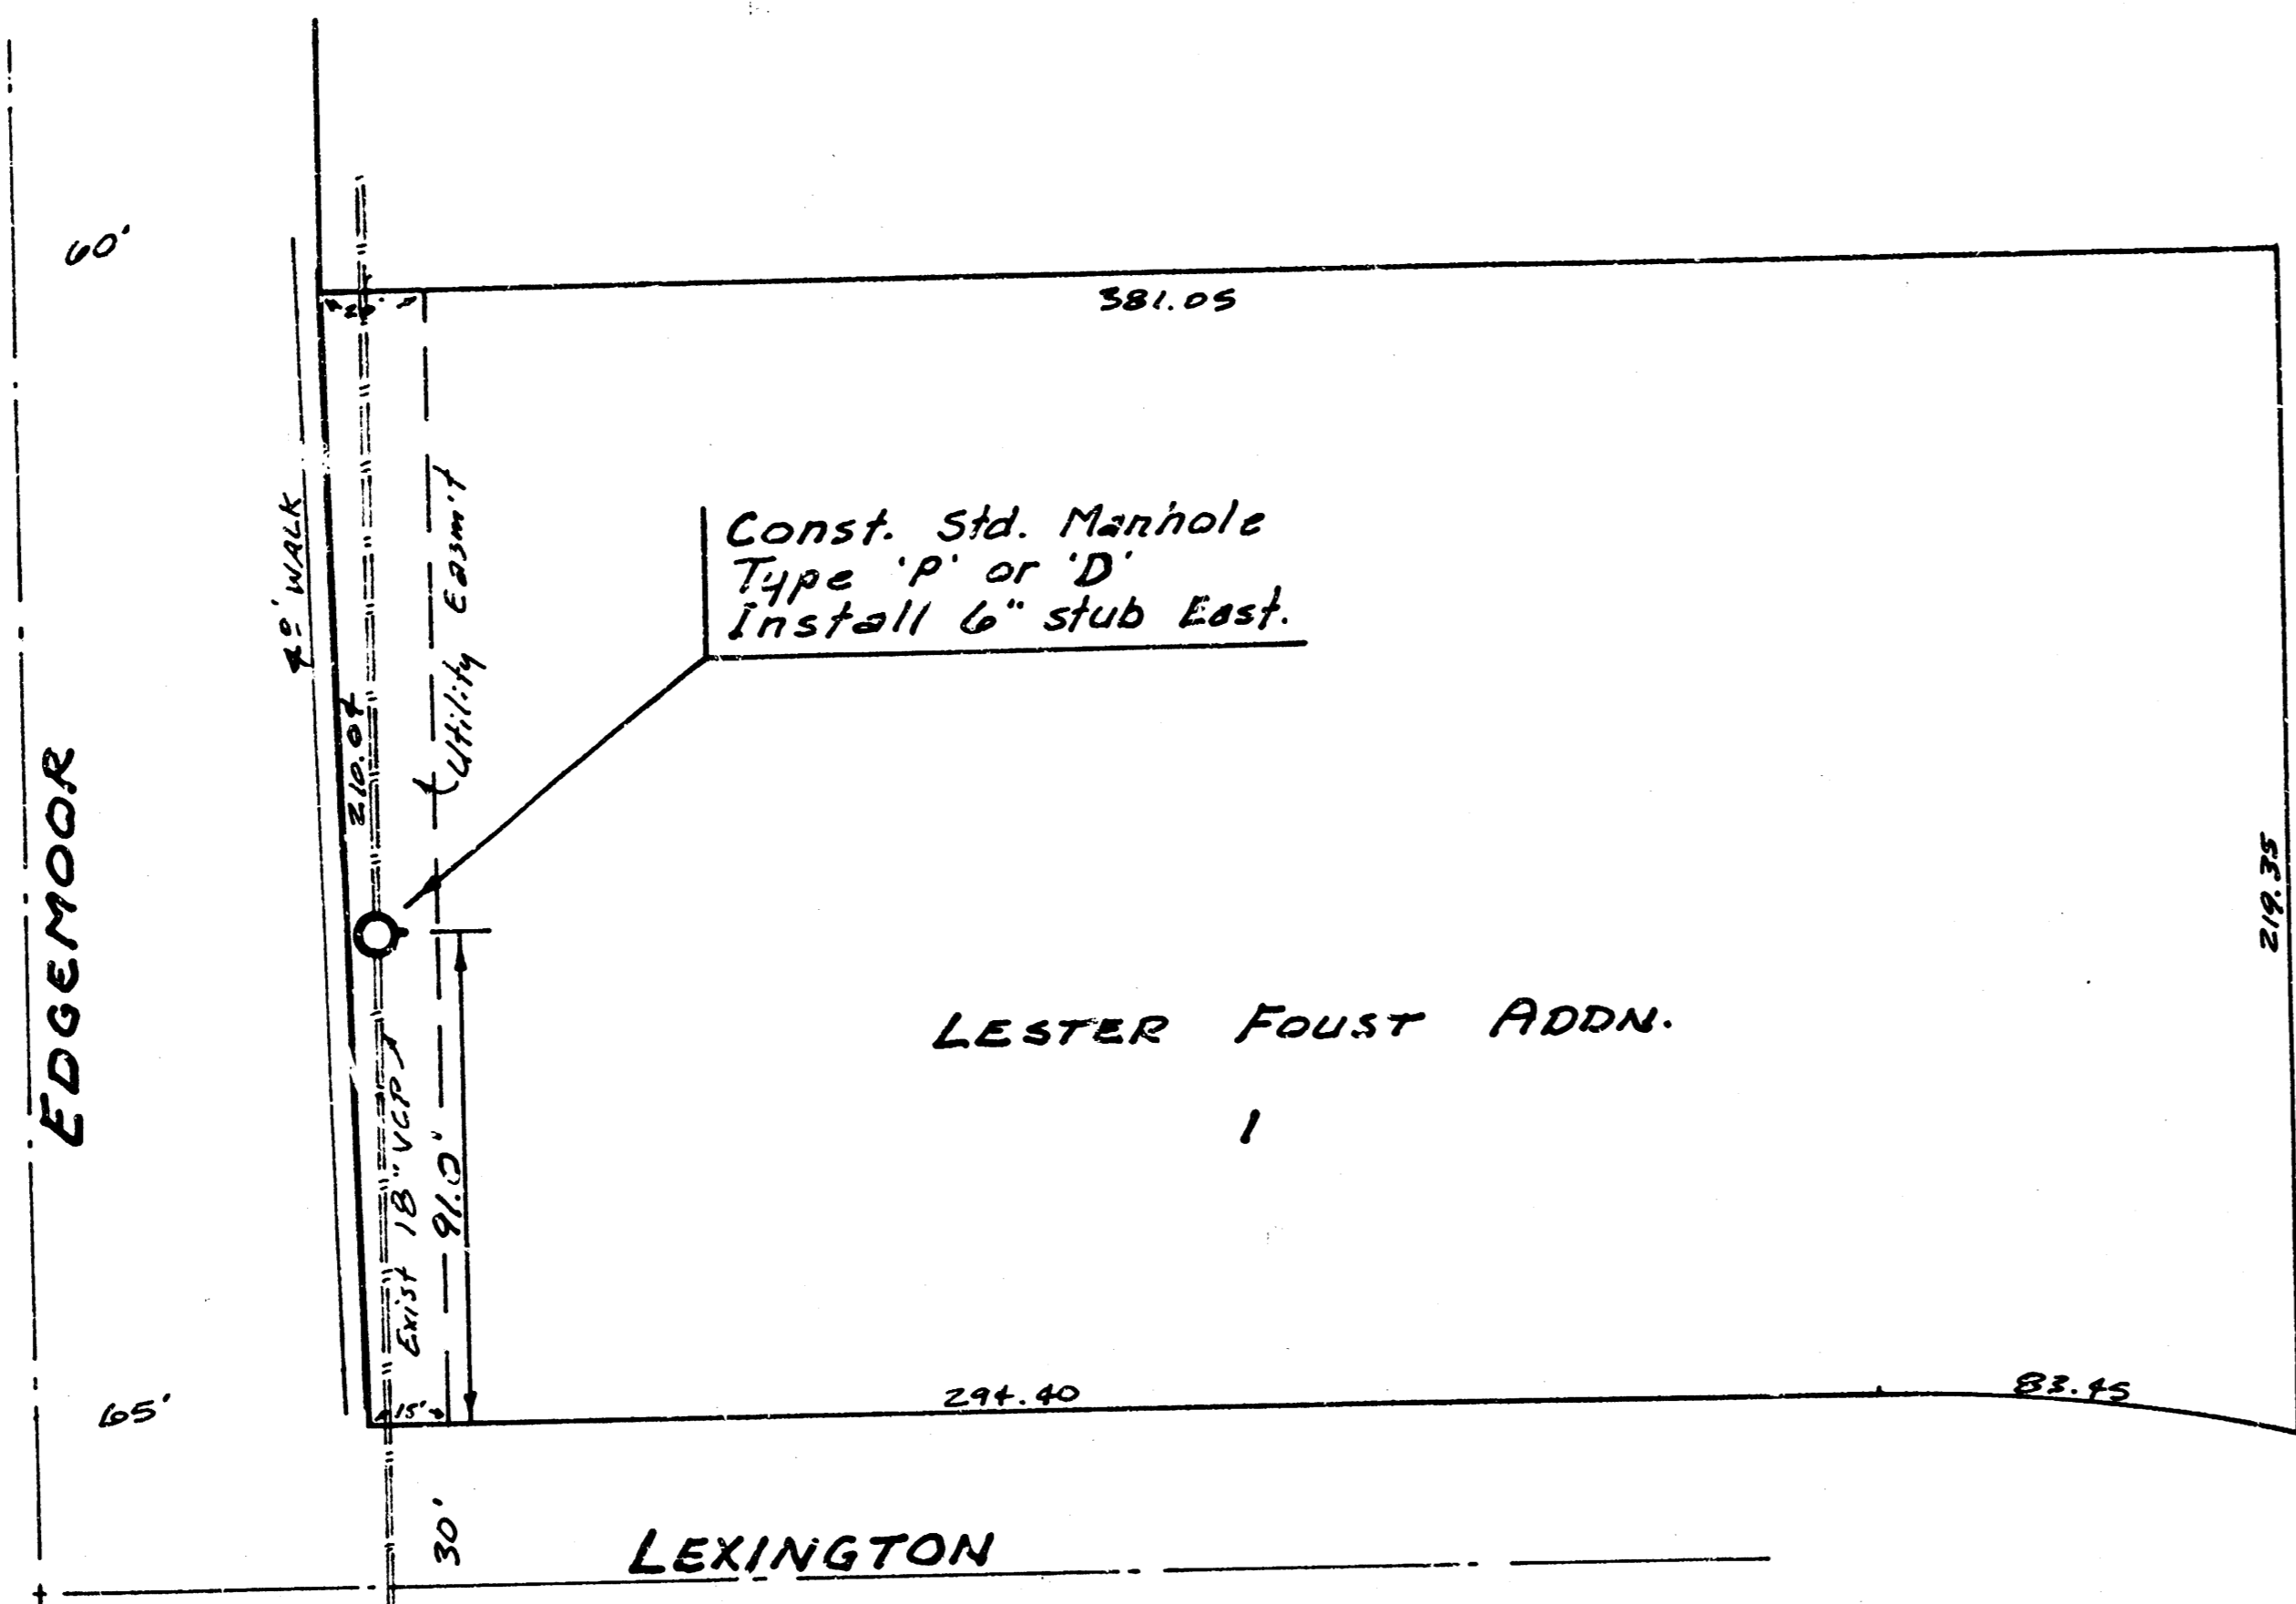

Const. Std. Manhole  
Type 'P' or 'D'.  
Top elev. 161.51


160  
155  
150

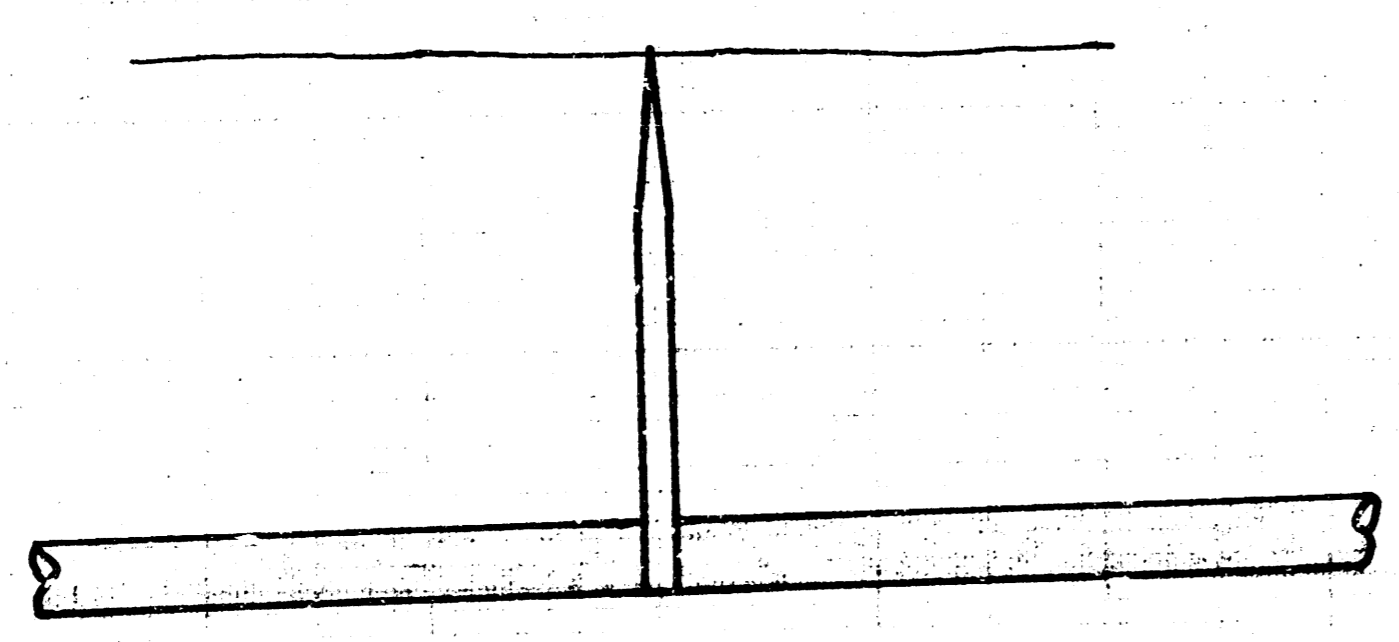

AS BUILT  
RPL  
12.87

149.98 Fto Exst. 18" VCP  
150.98 Fto 6" stub E.  
107

**LATERAL 110, MAIN 2, SANITARY SEWER NO. 12**  
**PROJ. NO. 458-76-245- 81682-000-000-001**  
**CITY OF WICHITA, KANSAS**  
**M. E. LINDEBAK - CITY ENGINEER**

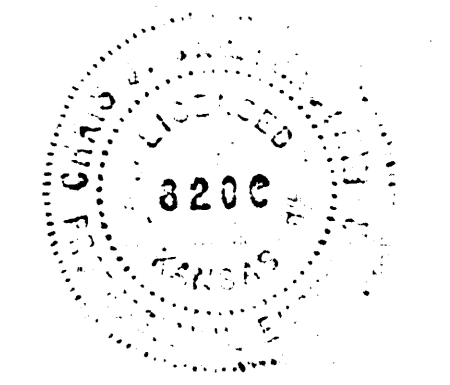

PROJECT DESCRIPTION
PROJECT NUMBER

1/2 FT 4 0 FT 8 FT

FILMED FROM THE BEST AVAILABLE COPY