


120
115
110
105

B. Rehder
J. Lindsey

120
115
110
105

B. Rehder
J. Lindsey

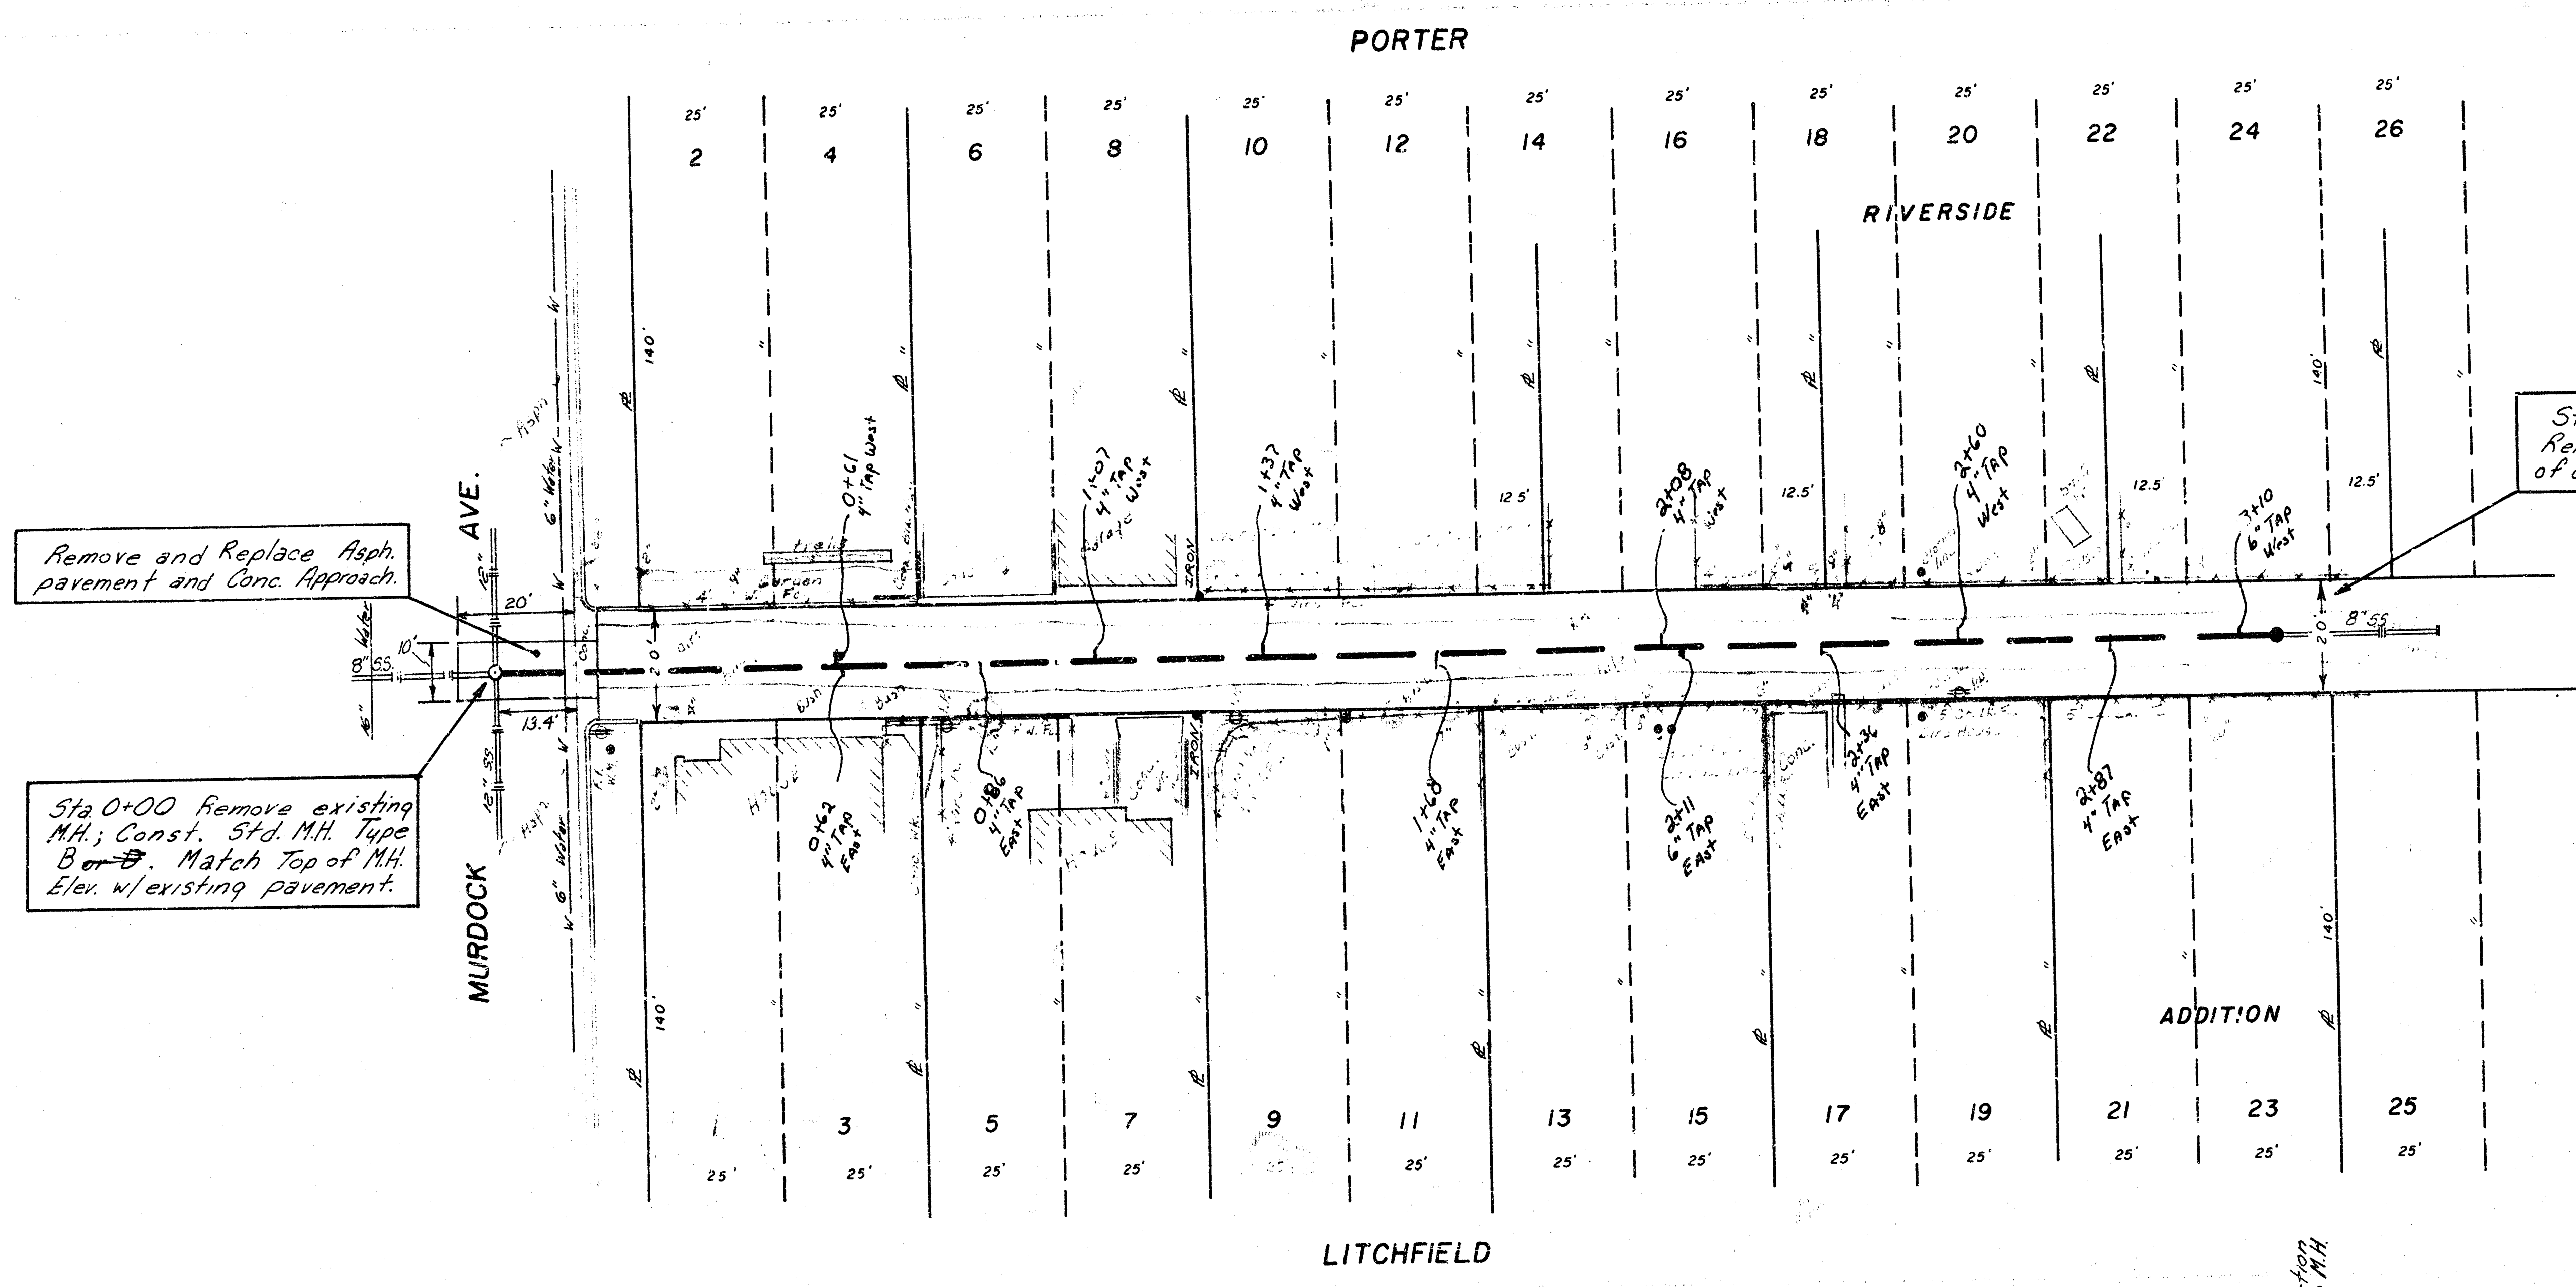

Notify Central Inspection (268-4341)
for Service Connection Permits


Stationing for Service Connections
As Booked (B-218)

0+36	West
0+38.5	East
0+60	West
0+62.5	East
0+80.5	East
1+07	West
1+36.5	East
1+60.5	East
2+06	West
2+08.5	East
2+60	West
2+87.5	East

Note: Notify Property Owners 48 hrs before construction begins.

SCALE 1" = 20' Plan
Horz 1" = 20' Profile
Vert 1" = 5' Profile

Bench Marks - 115.61 Brass Rod in conc. post, 27' W. and 22.5' N. of Q. Buffum and Franklin
120.19 RR Spk., W. Fe. RR, E. side of Alley between Porter and Litchfield, 4th PP N. Side Murdock
117.03 RR Spk., W. Fe. RR, E. side Alley between Porter and Litchfield, 1st PP N. Side Murdock

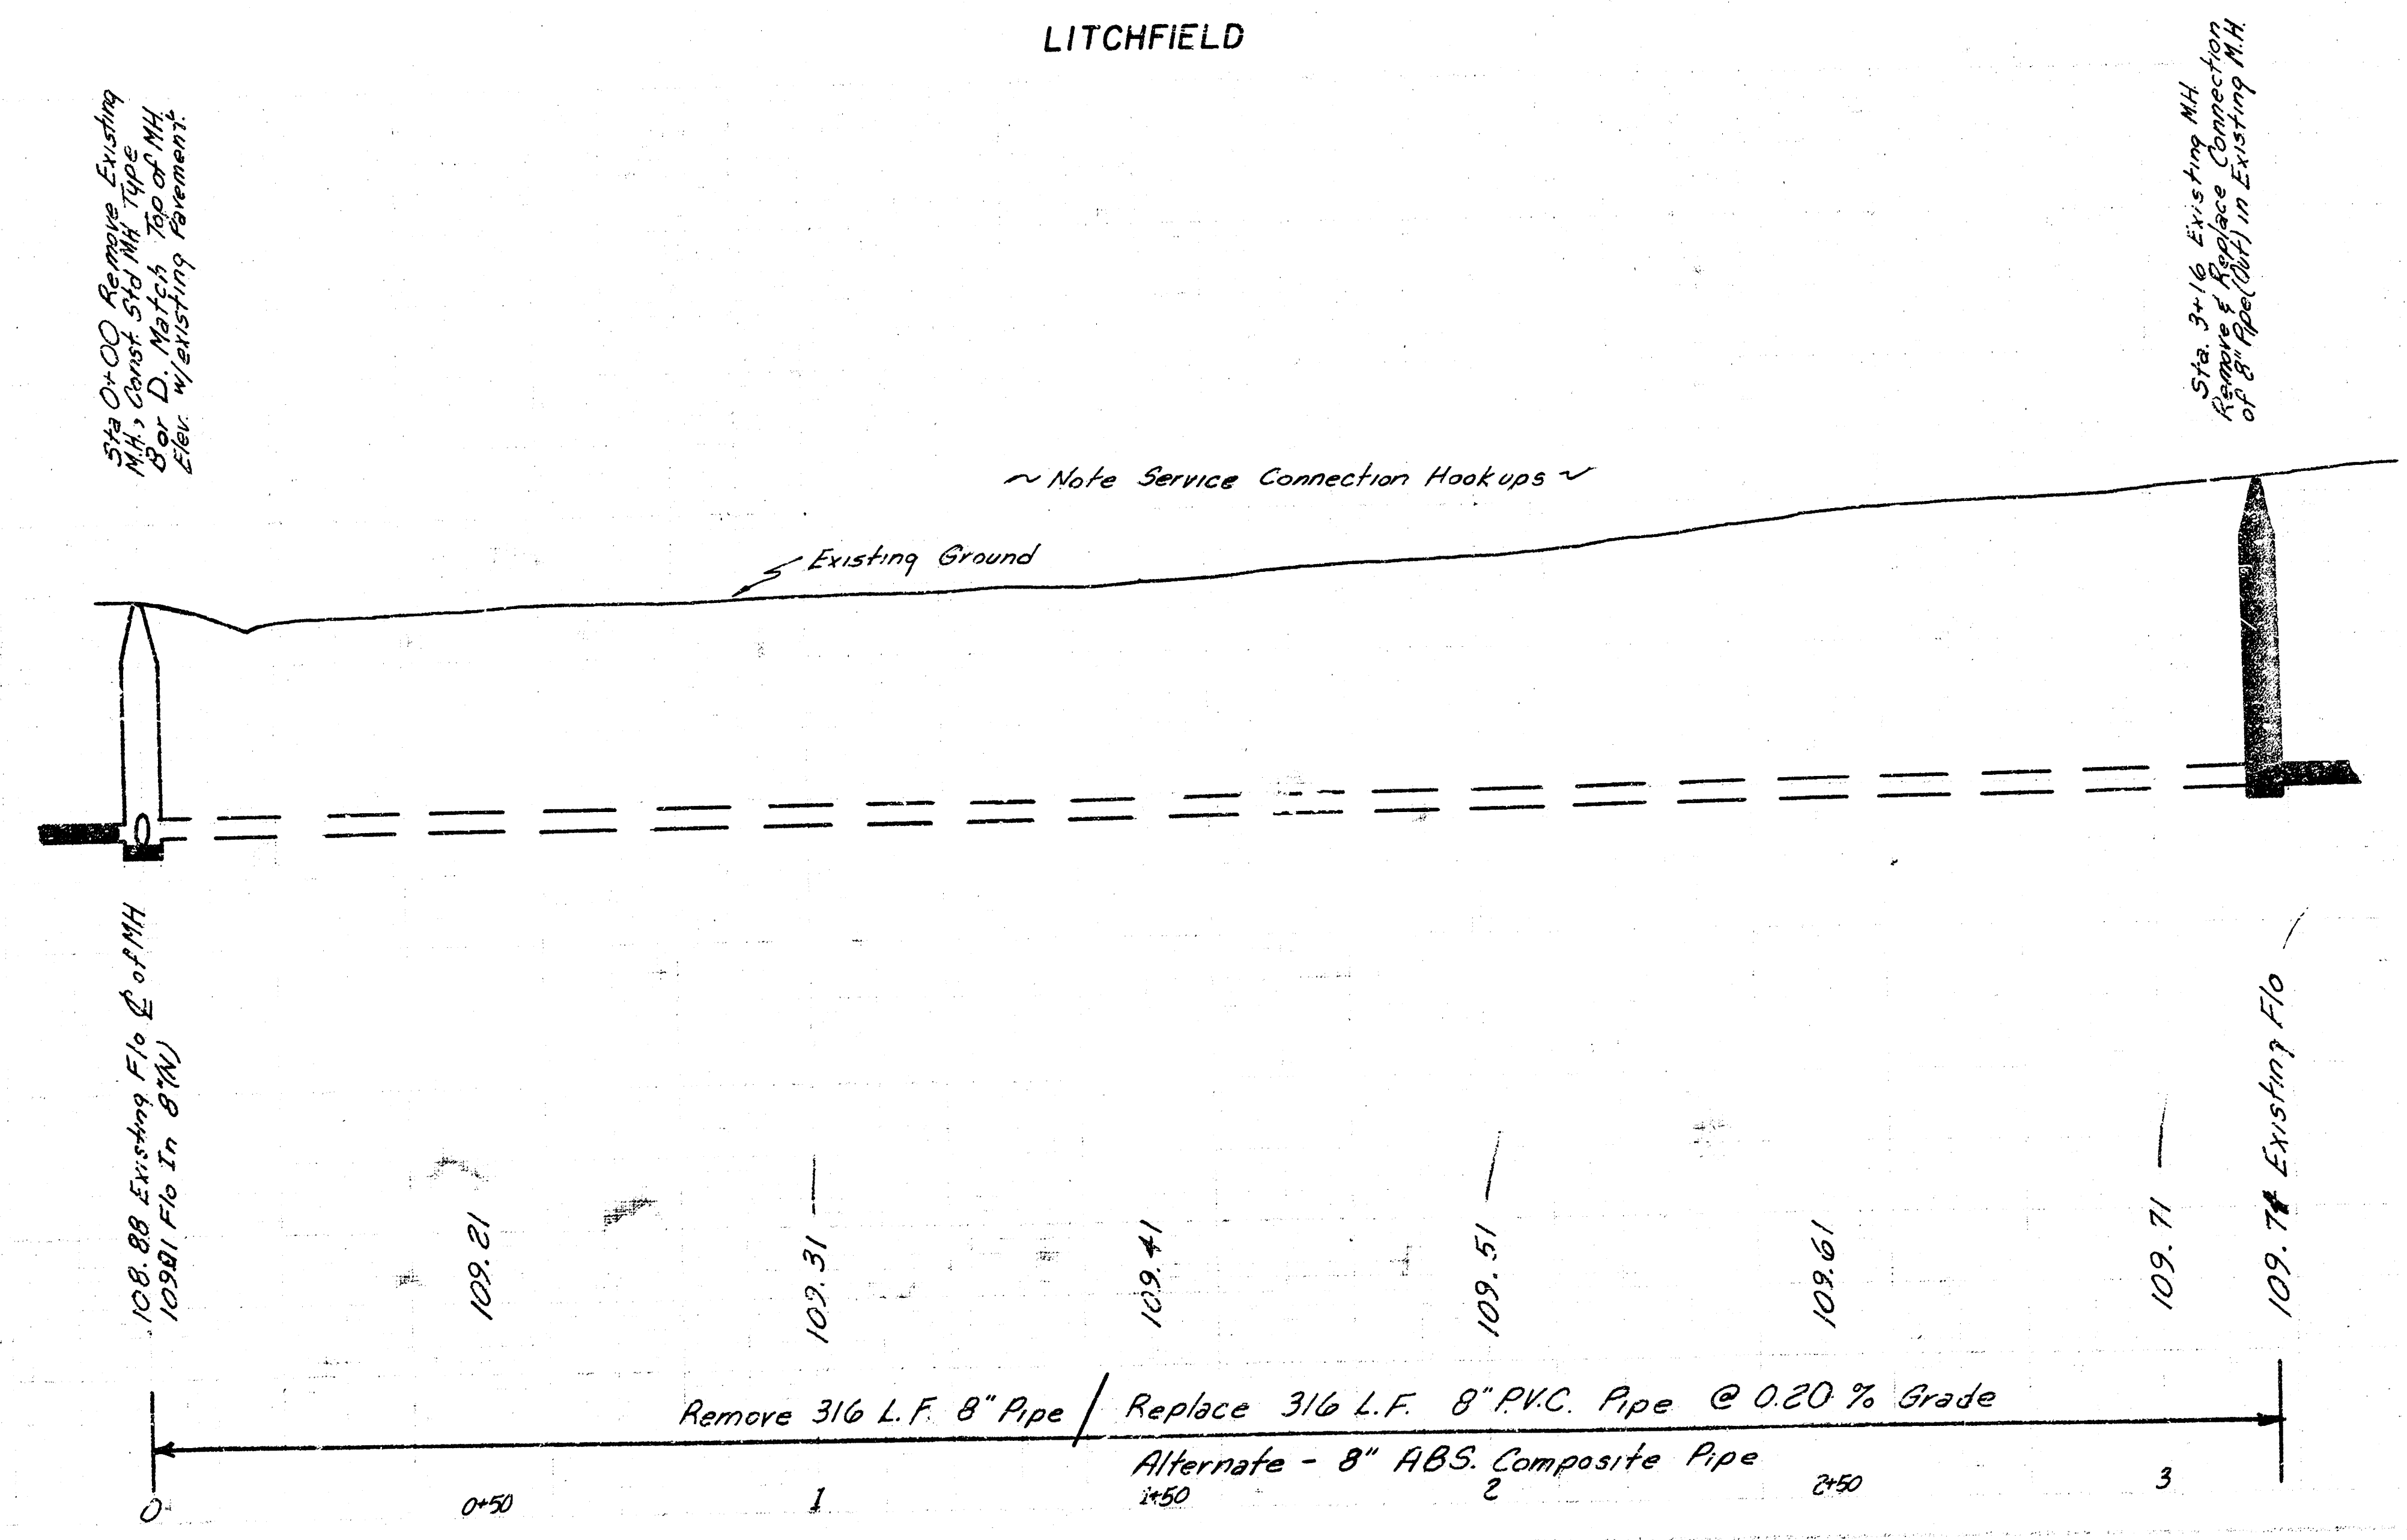

As Built
J.L.L.
5/82



RECONSTRUCTION OF A PORTION OF
S.S. NO. 15, BETWEEN PORTER &
LITCHFIELD ON N.S. OF MURDOCK.
CITY OF WICHITA, KANSAS
R.W. BRUGGEMAN
DIRECTOR OF ENGINEERING / CITY ENGINEER
PROJ. NO. 468-76-245-81167-000-000-001
DATE _____ SHEET 1 OF 1