




San. Sewer 962 15.

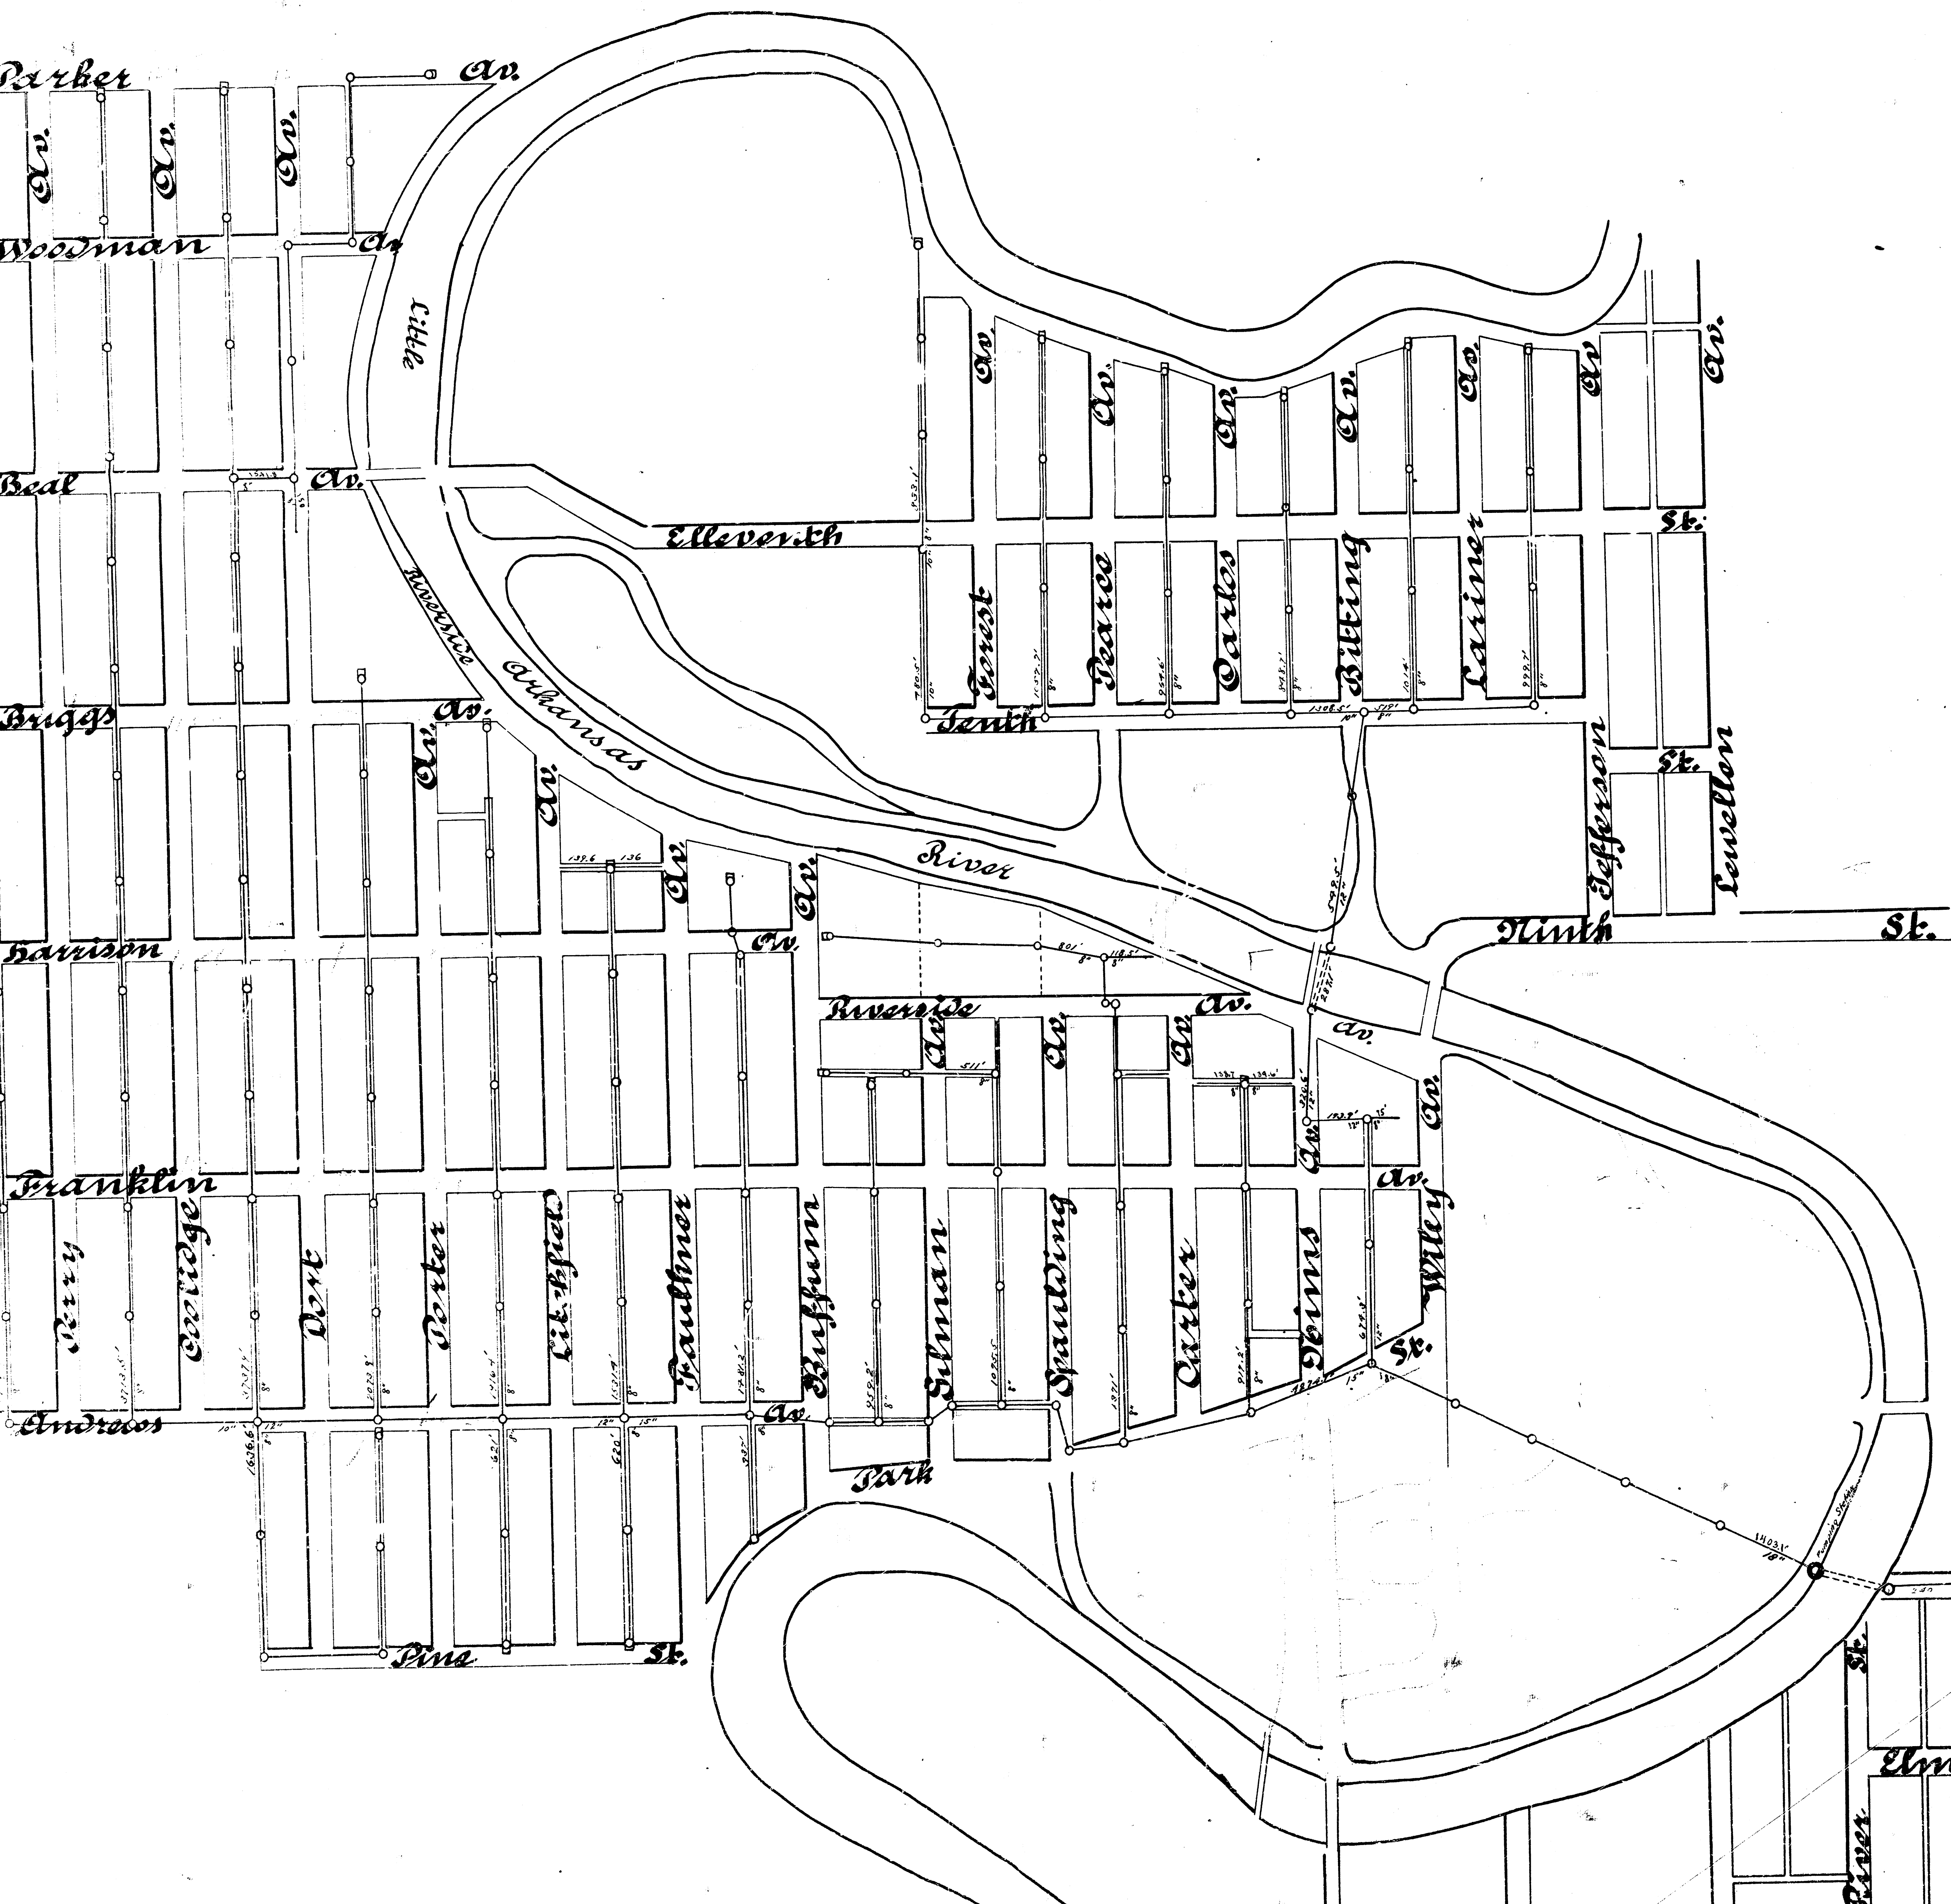