


DeCaso
J. Lindsey

8-81

J. DeCaso
J. Lindsey

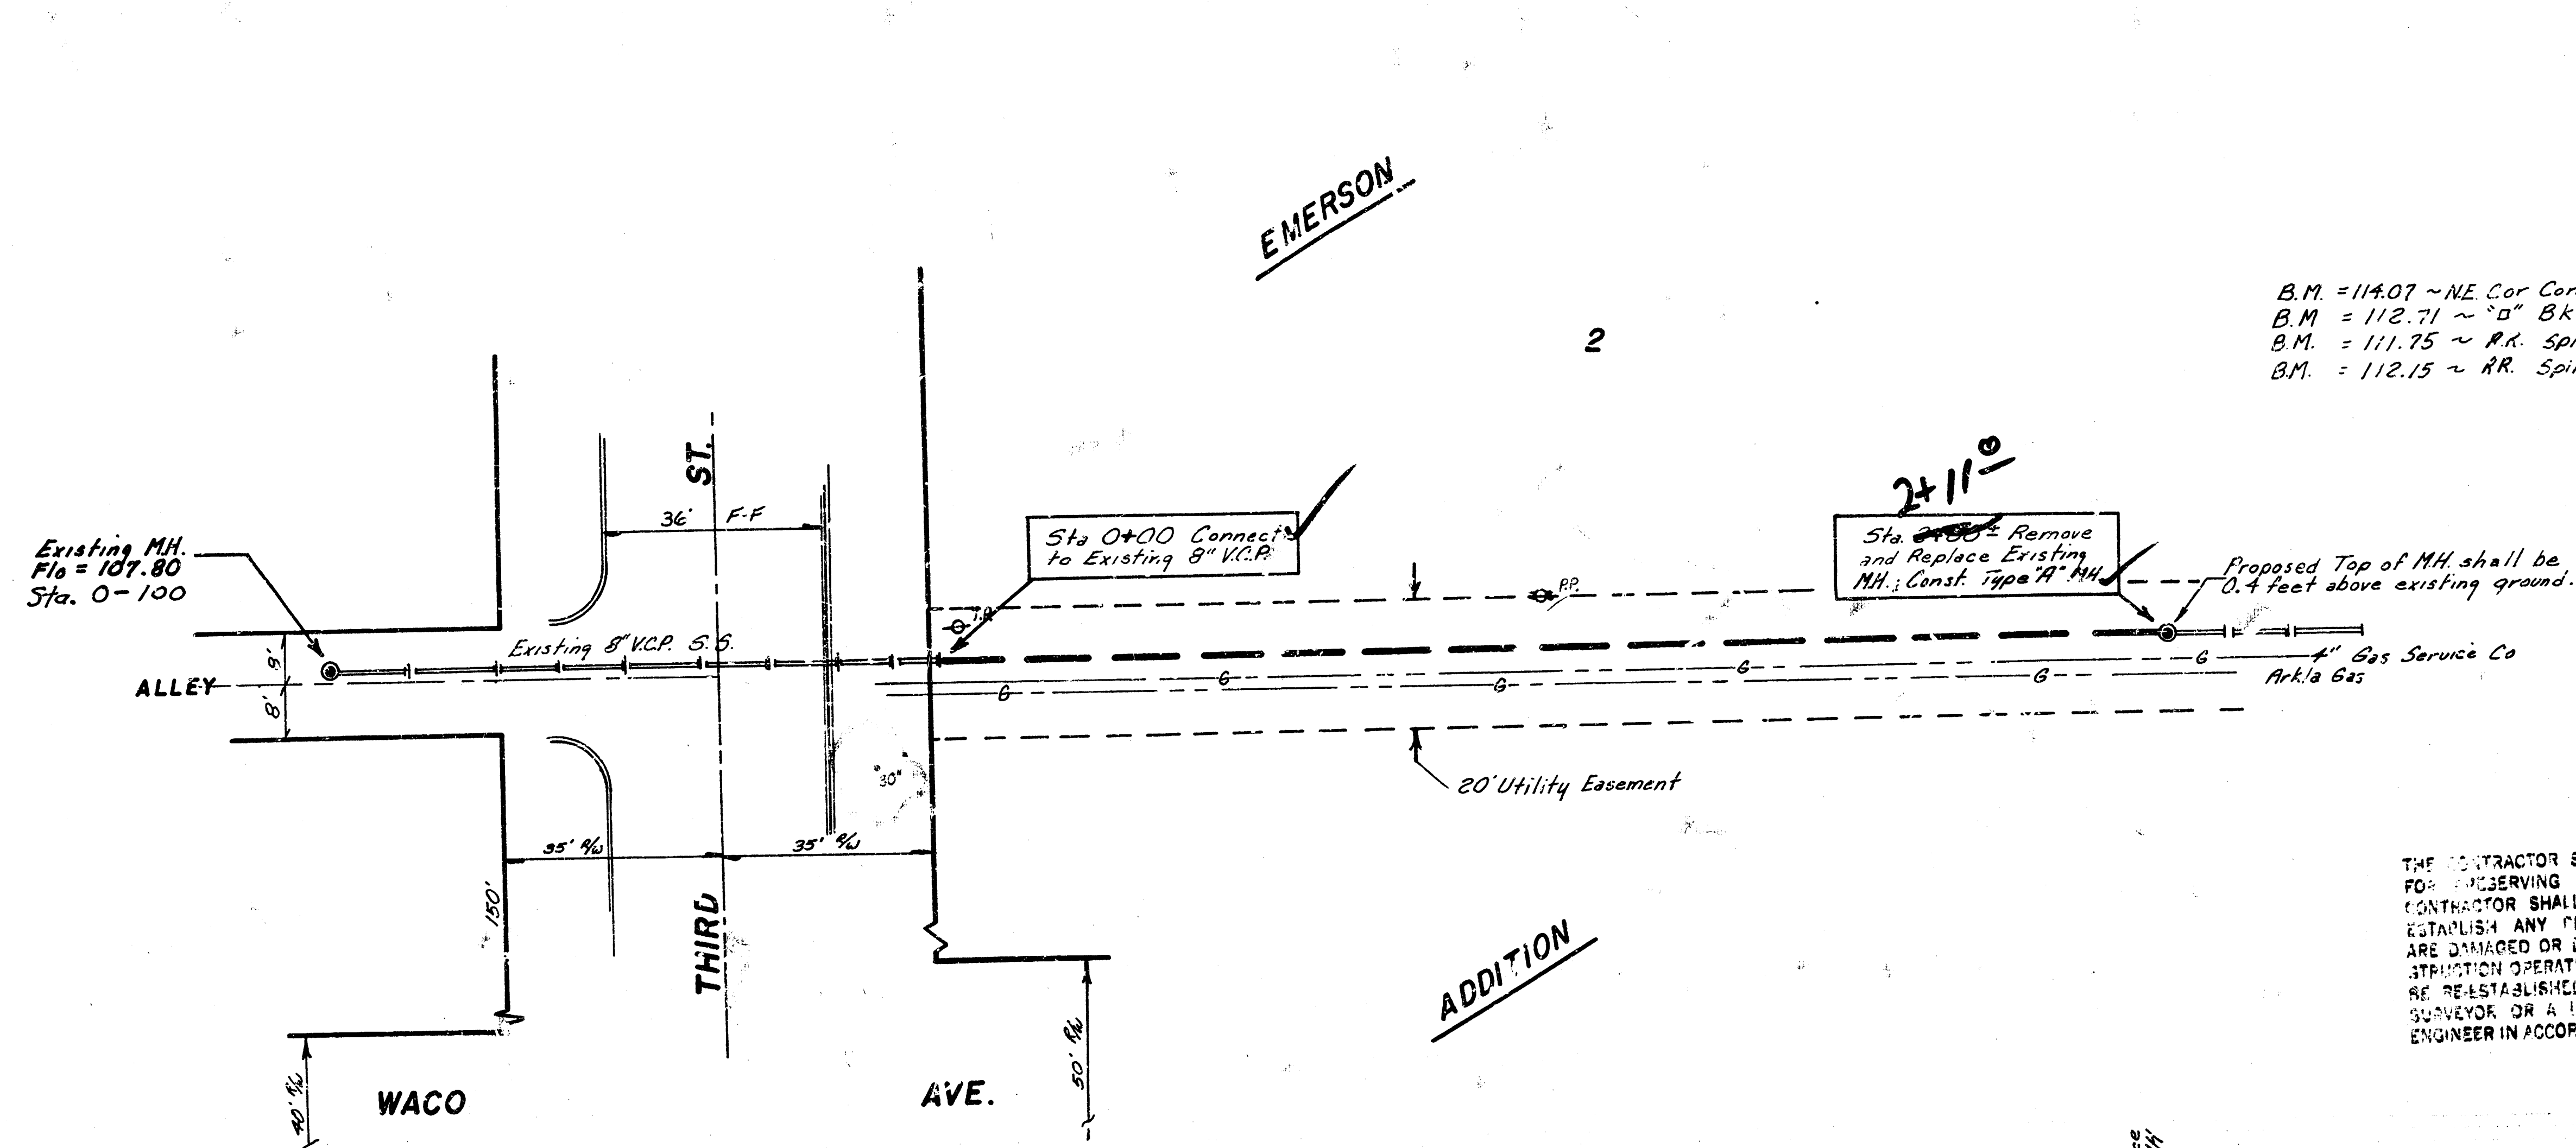


Scale: 1"=20' Plan
Here 1"=20' Profile
Vert. 1"=5'

B.M. = 114.07 ~ NE Cor. Conc. Base RR. Signal Box, SW. Cor. 3rd & Wichita.
B.M. = 112.71 ~ "B" Bk. V.R. N.L. 3rd St, 5' E. of E.L. Main.
B.M. = 111.75 ~ R.R. Spike in PP. N. Side, S.E. Cor. Waco & 3rd.
B.M. = 112.15 ~ R.R. Spike, N. Fe. PP., SW. Cor. 3rd & Riverview.



Note: Contact Gas Companies -
24 hrs. Notice for location of Gas
Lines and service connections before
starting construction.

THE CONTRACTOR SHALL BE RESPONSIBLE
FOR PRESERVING PROPERTY ADJACENT TO THE
CONSTRUCTION. ANY PROPERTY ADJACENT TO THE
CONSTRUCTION OPERATIONS, SUCH AS IRONS, SHALL
BE REESTABLISHED BY A LICENSED SURVEYOR OR A
LICENSED PROFESSIONAL ENGINEER IN ACCORDANCE WITH STATE LAWS.

CAUTION
UNDERGROUND
UTILITIES
Please check with K & E or
Southwestern Bell
Telephone Co. for location.

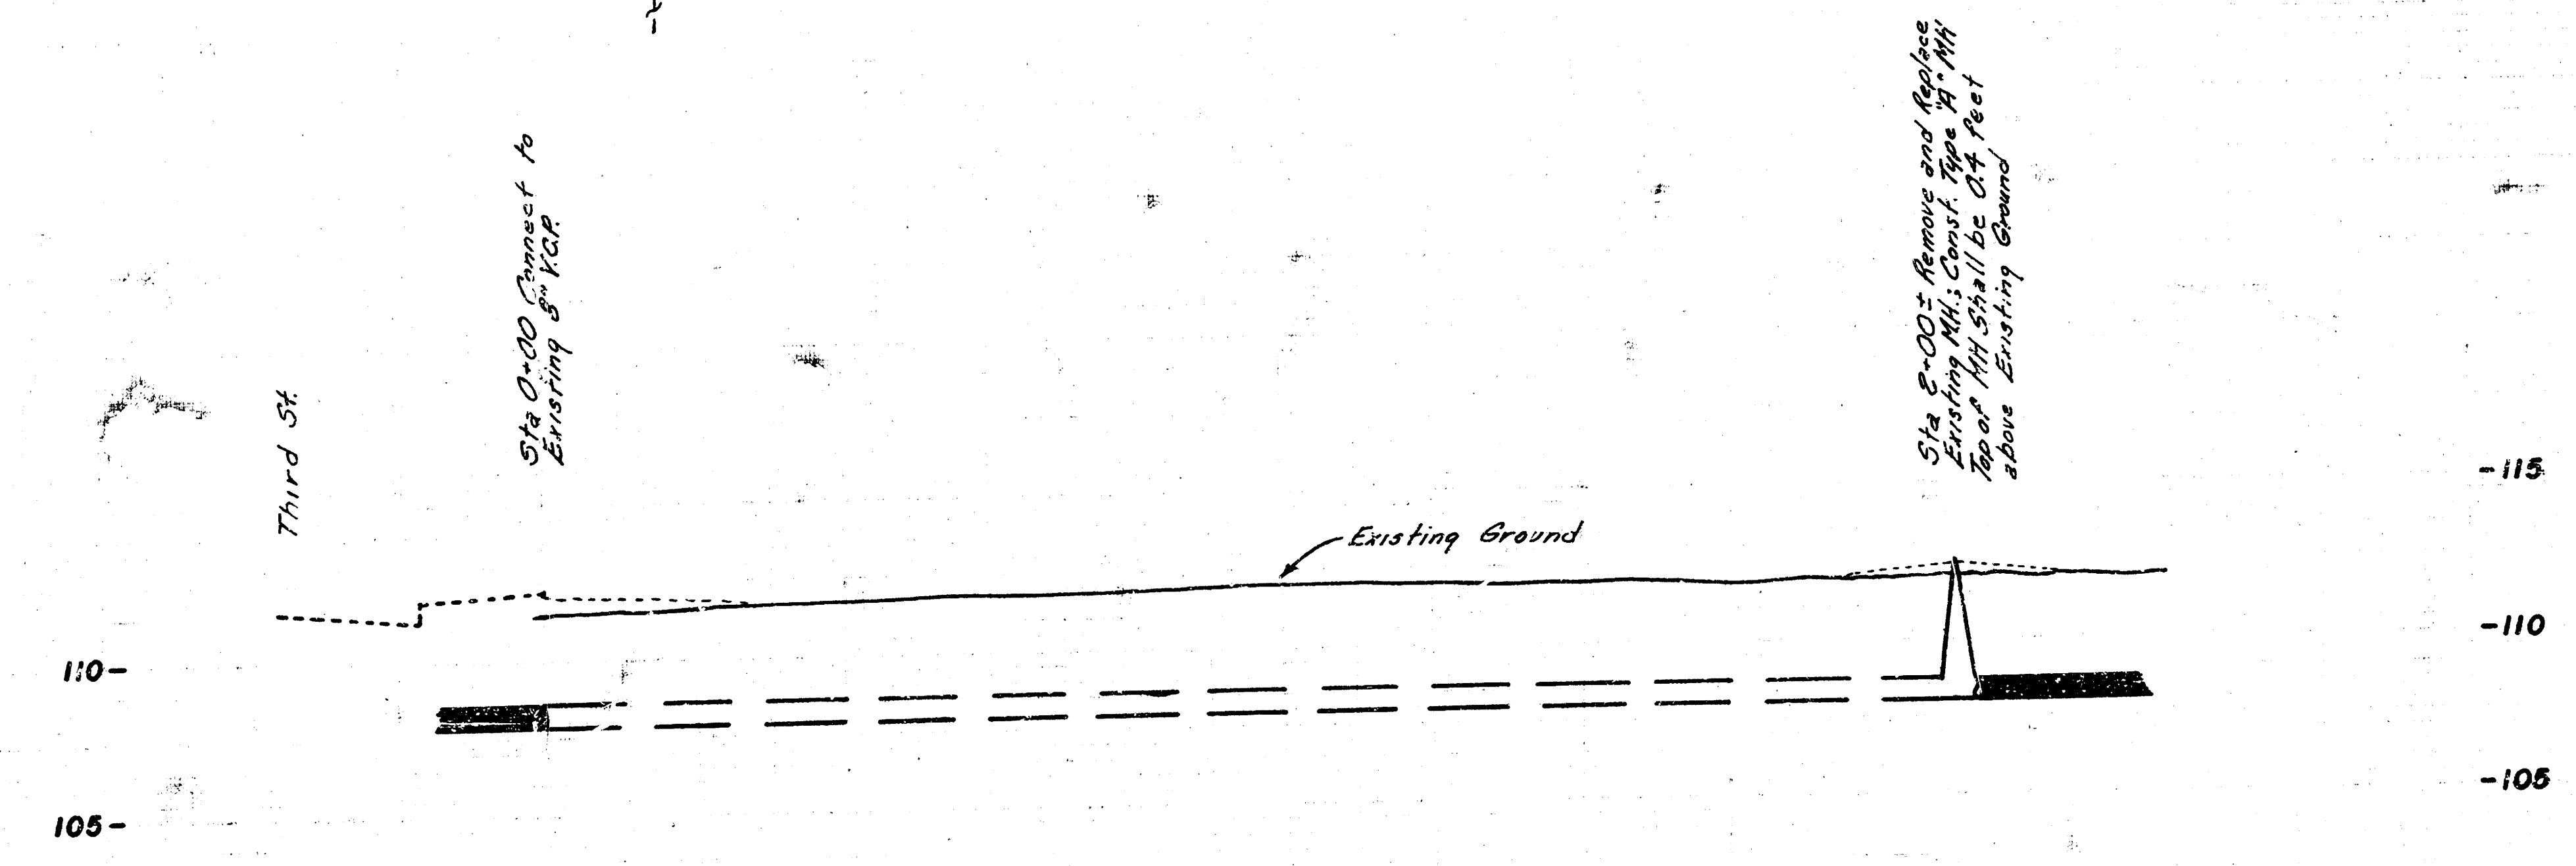

As Built
1/82
J. J.

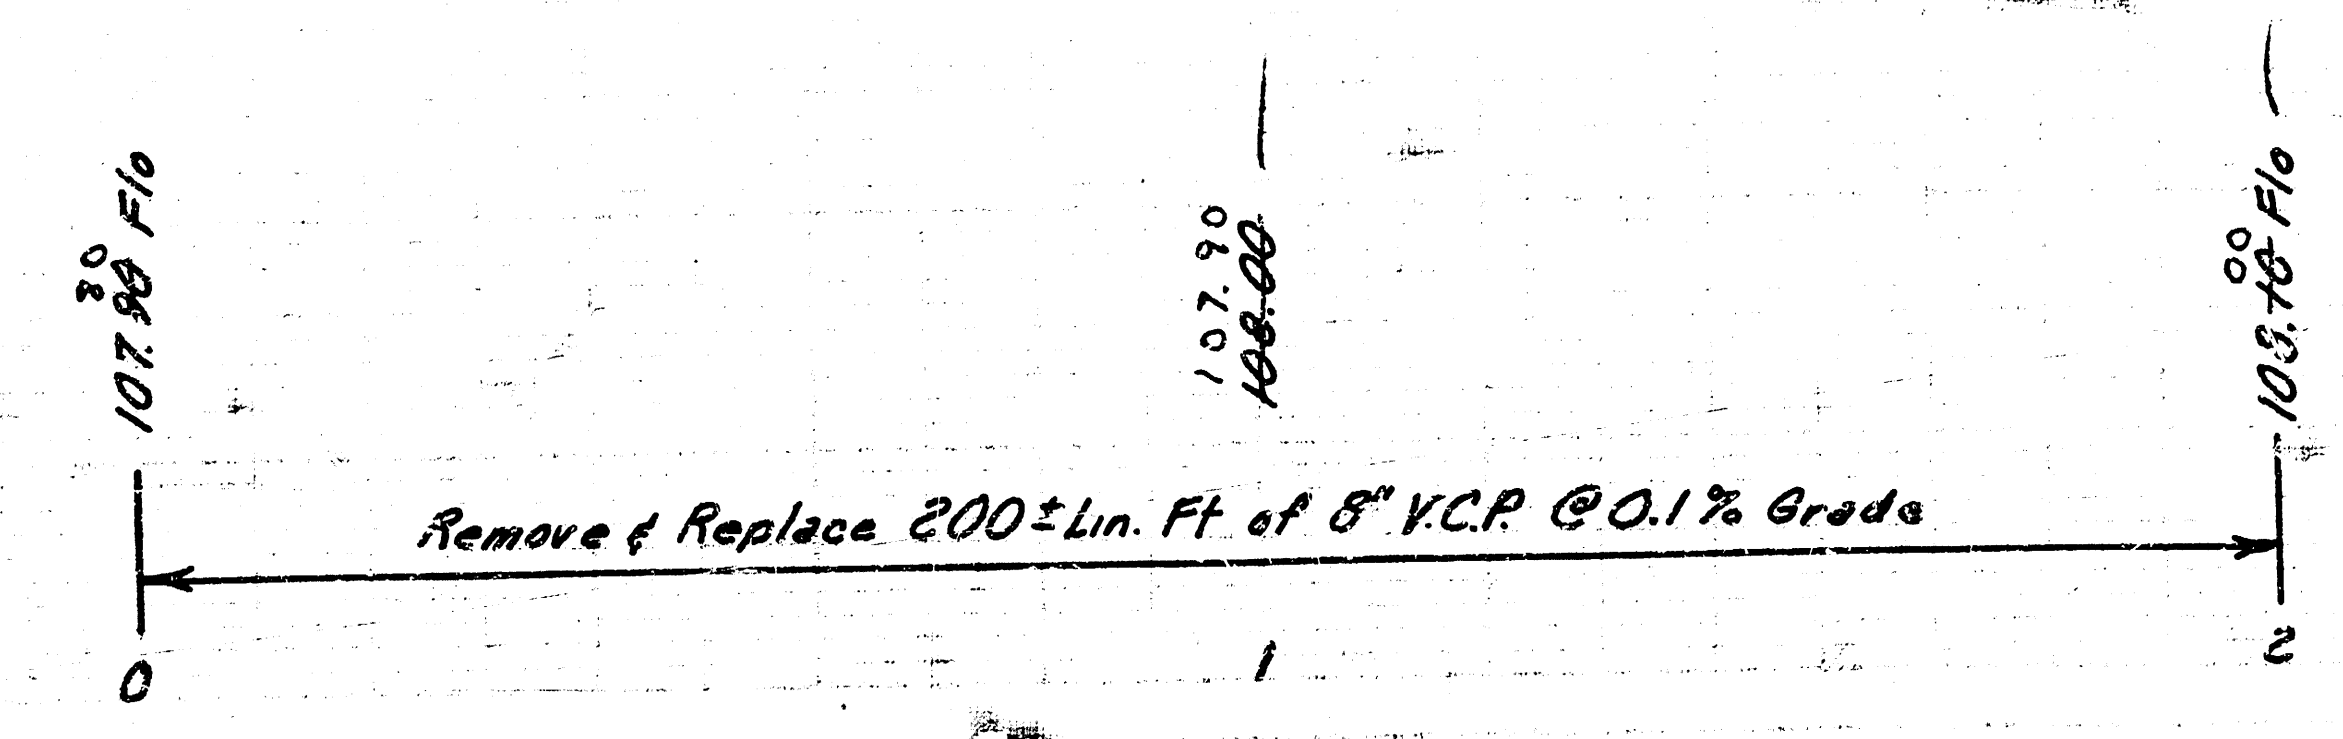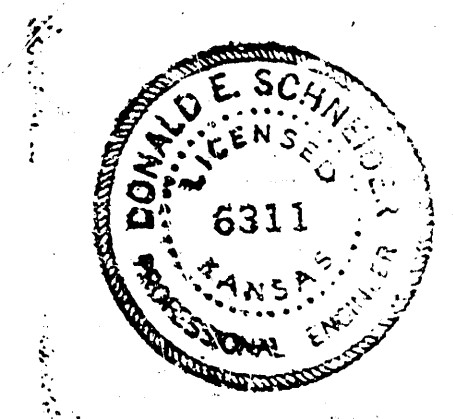

Reconstruction of a portion of SANITARY
SEWER NO. 17, North of Third St.
between Riverview & Waco
CITY OF WICHITA, KANSAS
R.W. BRUGGEMAN, DIRECTOR OF ENGINEERING/CITY ENGINEER
PRG. NO. 468-76-245-81151-000-000-001
Date _____ Sheet 1 of 1

FILMED FROM THE BEST
AVAILABLE COPY.....