



SAN. SEWER NO. 18.



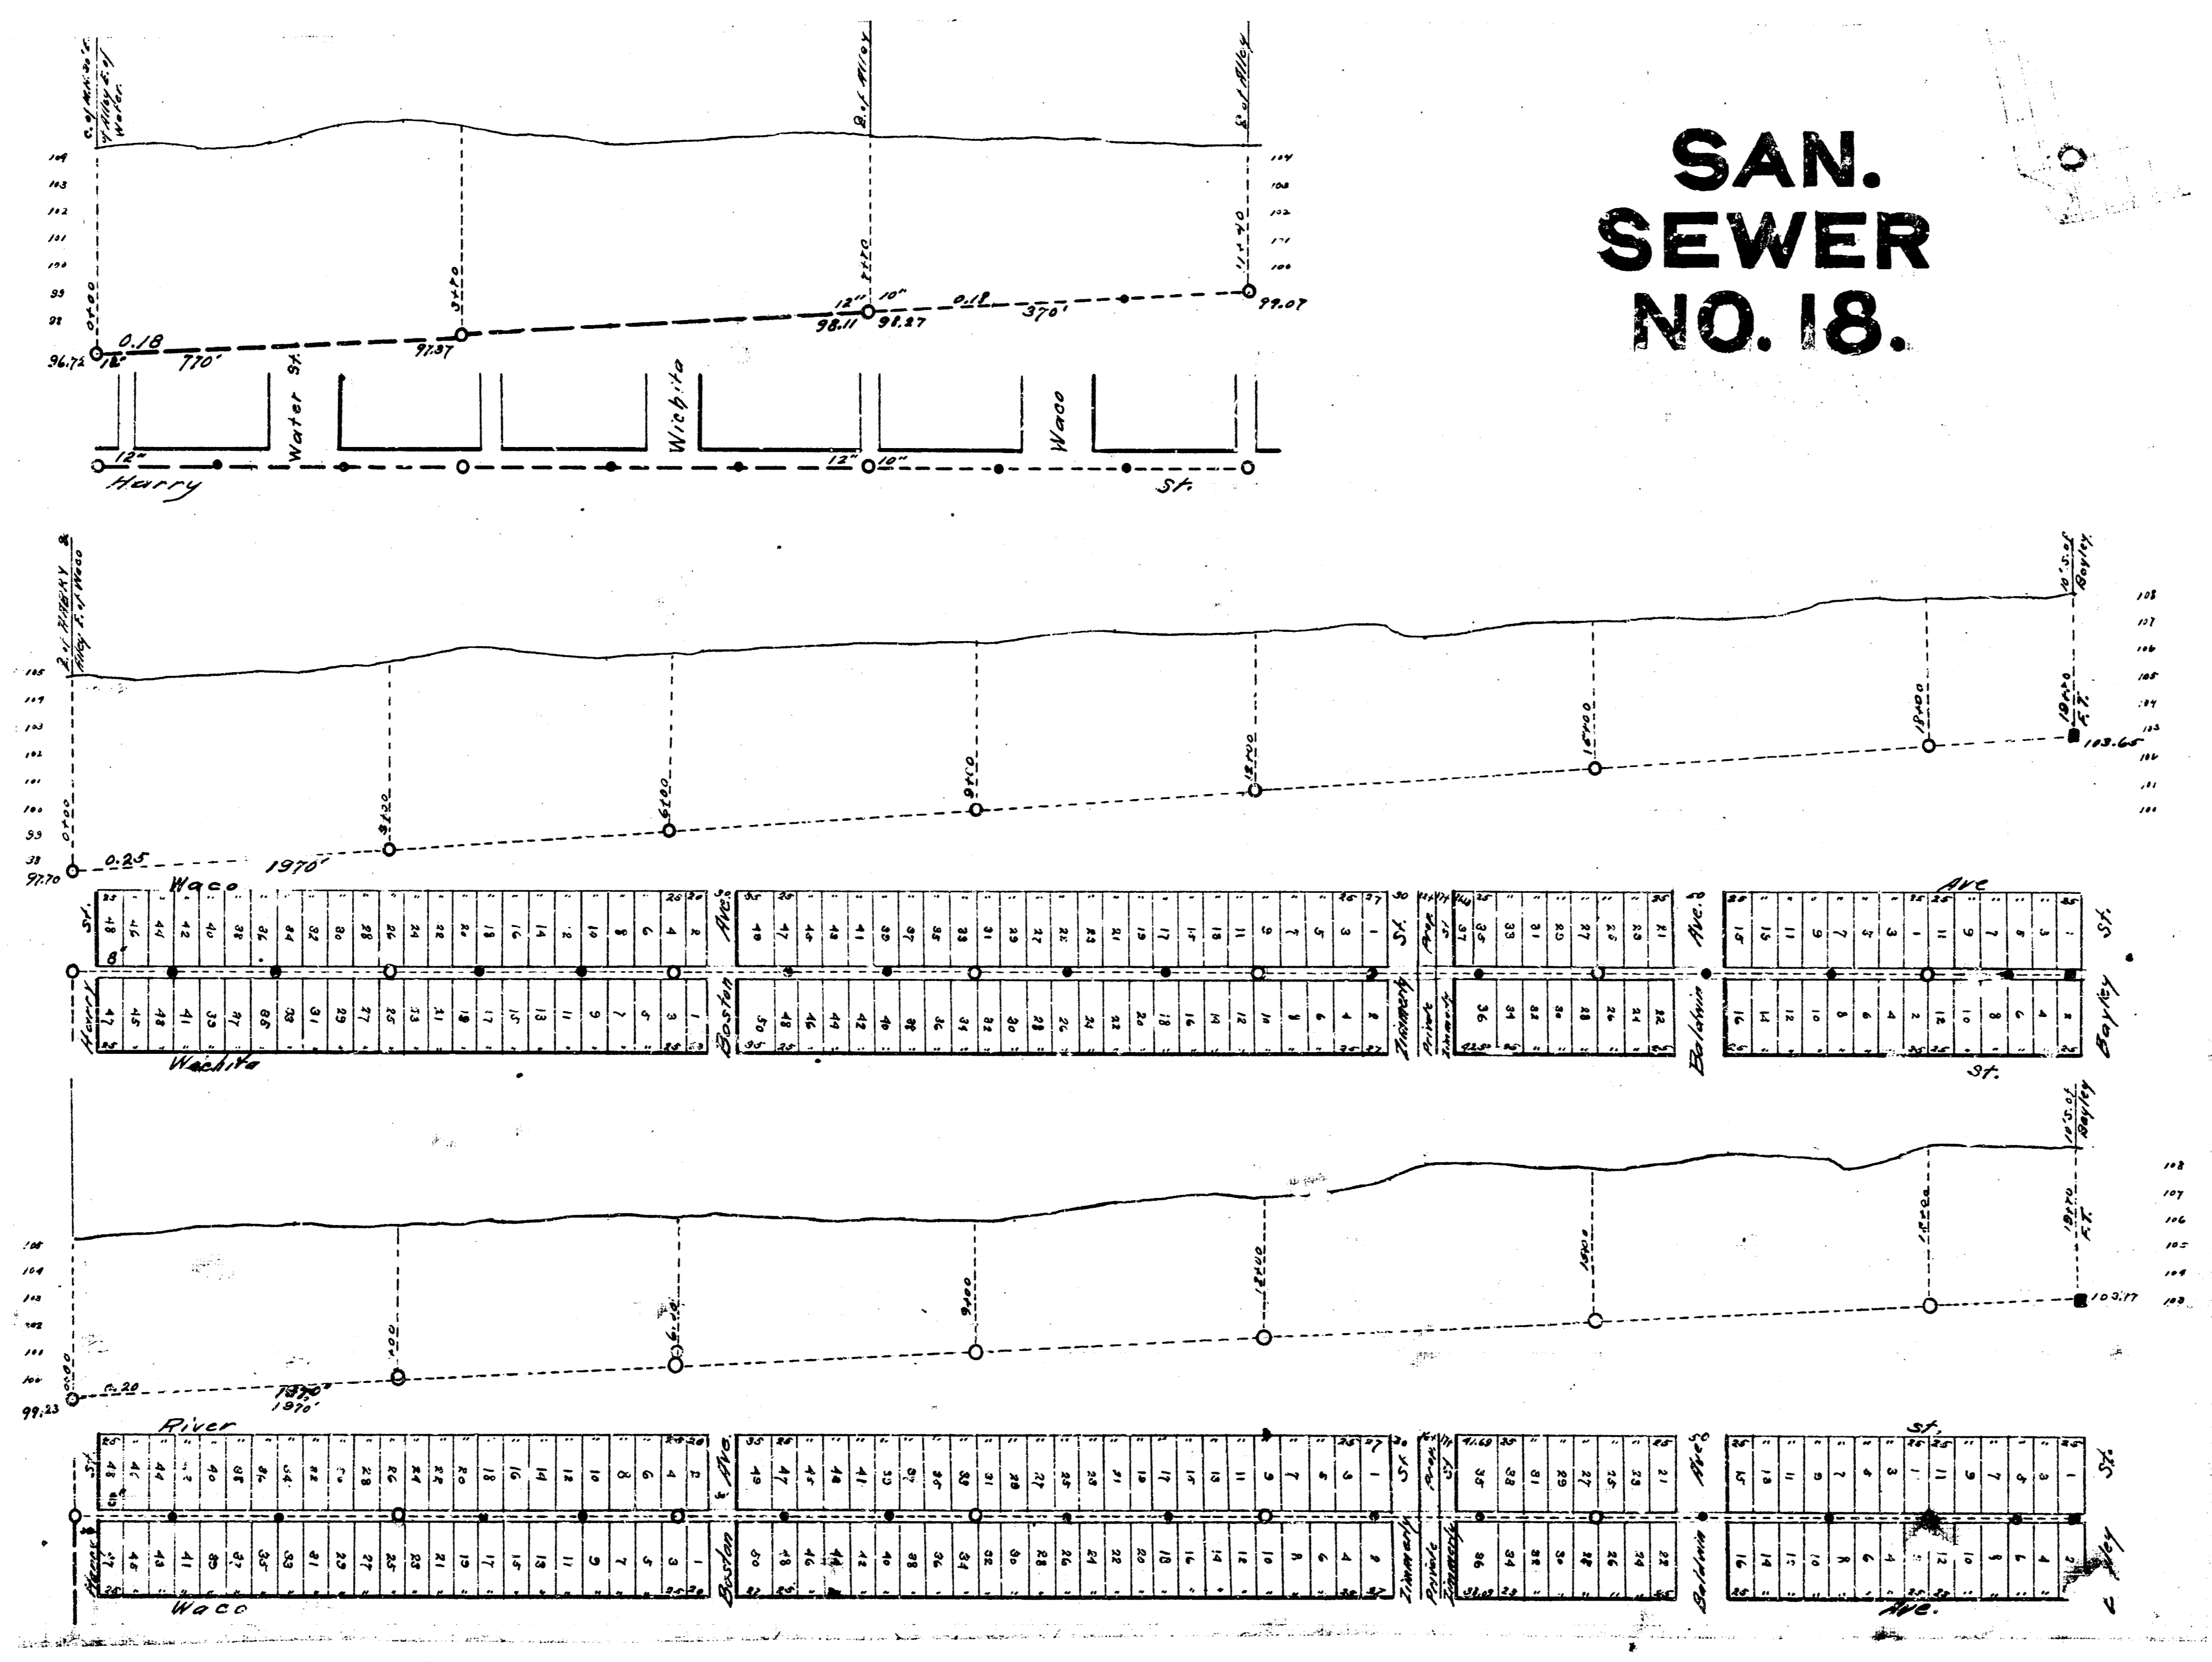

SAN. SEWER N° 18

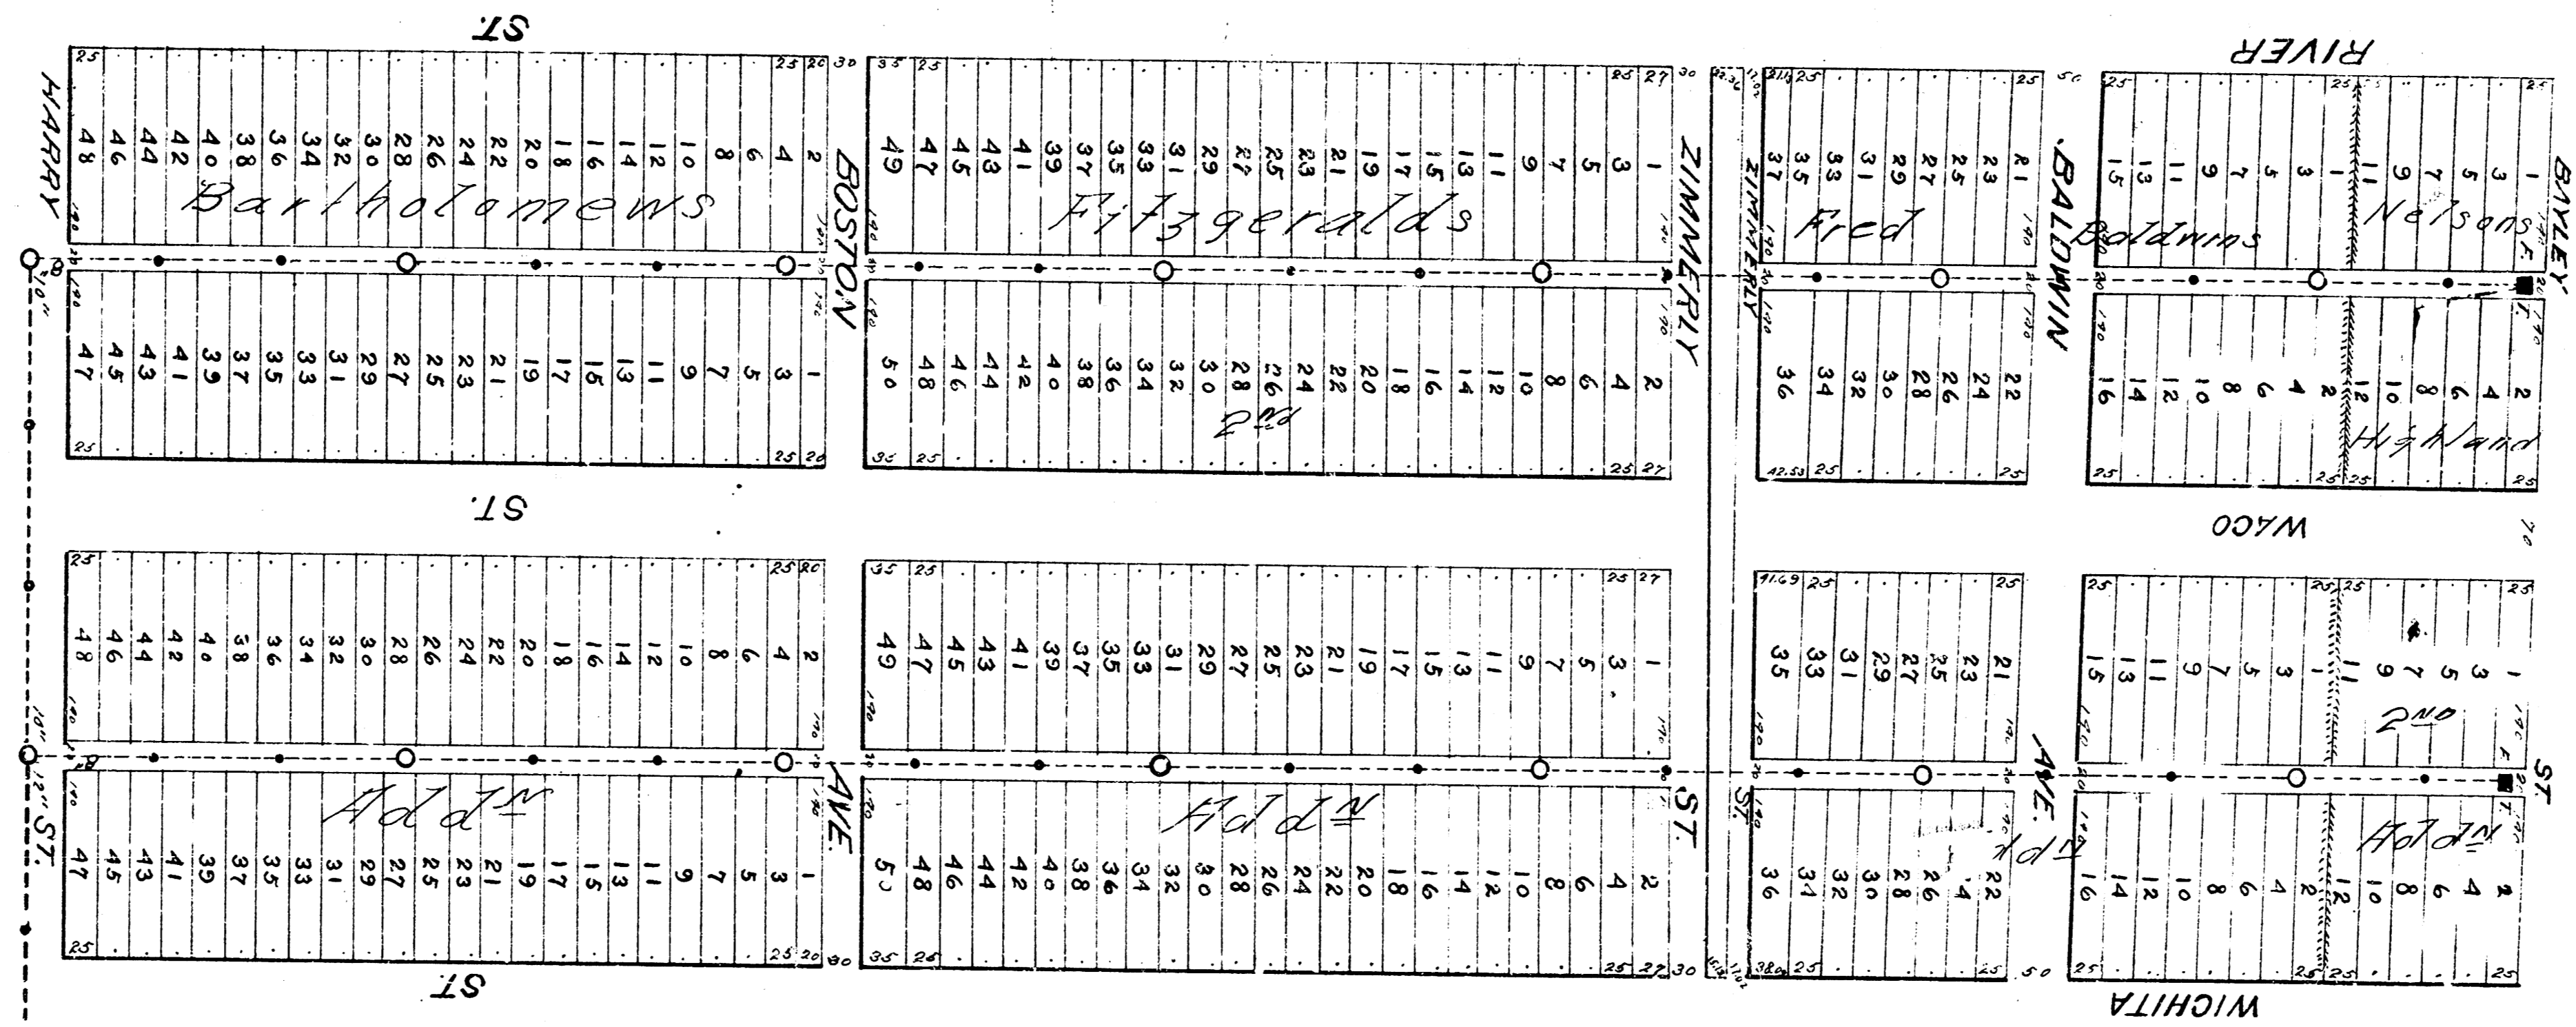