


CAUTION
 UNDERGROUND
 UTILITIES

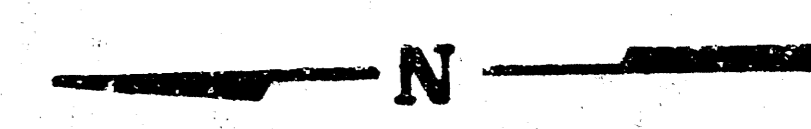

BM. 111.17 S.E. Cor. Conc Walk E-Side SW
 Elev. Co. M.W. Cor. 1st & Hyd.
 B.M. 108.99 S.E. Cor. Bot. Step 18/18 E. First
 Being 1' N. of Blk. of 4' Wlk. E-W

Remove Concrete Pavement
 and Replace

First St.


SCALE
 Plan 1" = 20'
 Profile 1" = 20'
 Horiz 1" = 20'
 Vert 1" = 5'

110
 105
 100
 95
 90

Const 4315 LF of 8" Pipe @ 0.18% Grade
 RBS Comp. or PVC Pipe

As built
 4-81
Chief

Reconstruct a Portion of Dist. 1, SS. # 20 in the Alley East
 of KANSAS Between 1st and 2nd
 Proj. No.: 542-80-245-80031-000-000-001
 City of WICHITA, KANSAS
 Dean Sellers ~ Acting City Engineer
 DITE

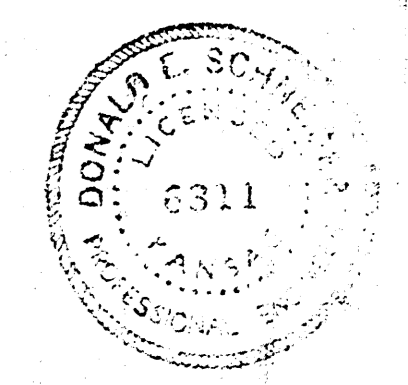

5/80
 JPC 22