


D.M. 112.68 Top E. of Riverview St. East. 73' North of Cr. 3rd St.
B.M. 112.79 3' 3" from N.W. cor. 3rd St. E. of City W. & Water St.
N.W. Cor. 3rd & 2nd St.

6+54.6

Sta. 6+55 Constr. 3rd Type
13' M.H. over existing line
South. Rim Elev. = 113.06

Removed & replaced
45 L.F. 8" pipe
south of M.H.

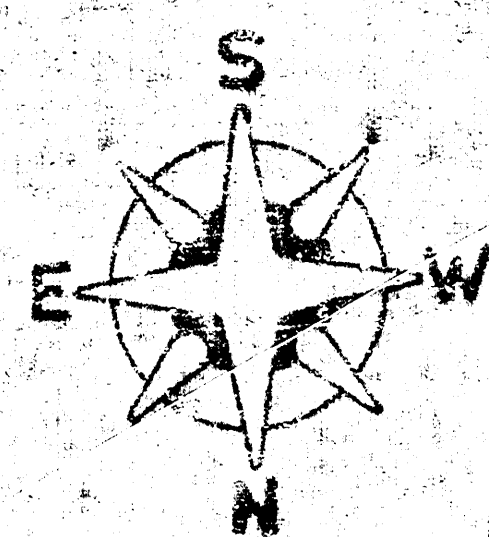

Scale: 1" = 35'

8+09.3

Sta. 8+09 Constr. 3rd
Type 13' M.H. Rim Elev.
111.40

SECOND ST.

Existing Pavement

6+87.0

Sta. 6+88 Constr.
3rd Type 13' M.H. over
existing line North.

Remove M.H. & 3' 3" S.S.
to Proposed
Manhole

Caution - Bell Manhole
(size = 8'6" x 3'7" W. x 5'7" H.)

NOTE: TREES INDICATED TO BE SAVED AT STA. 7+45 AND 9+06
SHALL BE REMOVED IN SUCH A MANNER THAT WILL PREVENT DAMAGE
TO THE TREES, SO THAT THEY ARE SUITABLE FOR REPLANTING.
TREE AT STA. 7+45 SHALL BE REPLANTED IN ITS ORIGINAL LOCATION.
TREE AT STA. 9+06 SHALL BE TRANSPLANTED TO A LOCATION
DESIGNATED BY THE ENGINEER. TREES SHALL BE WATERED AFTER
THEY HAVE BEEN REPLANTED. THIS WORK WILL NOT BE PAID FOR
DIRECTLY AND SHALL BE CONSIDERED AS SUBSIDIARY TO THE OTHER
ITEMS OF WORK.

GREENWAY BLVD

10+81.6

Sta. 10+80 Constr. 3rd
Type 13' M.H. over existg
8" San Sewer North.

Note: See Sheet No. 2 For General Notes

**CAUTION
UNDERGROUND
UTILITIES**
Please check with K & E or
Southwestern Bell
Telephone Co. for Location.

Sta. 6+53 Constr. 3rd Type 13' M.H.
6' North of Prop. 8" rim elev. = 113.06

Sta. 8+09 Constr. 3rd Type 13' M.H.
18' East of E. of Riverview
Rim Elev. = 111.40


End Project
Sta. 10+80 Constr. 3rd Type 13' M.H. over
existg San Sewer

Sta. 6+85 Constr. 3rd Type 13' M.H.
40' north of existg 8" over existg
8" San Sewer. rim elev. = existg Put.



375' L.F. 8" A.B.S. Composite Pipe at 0.10% Grade

10" A.B.S. Composite Pipe at 0.10% Grade

Reconstruction of a Sewer to Supplement
a Portion of Dist. 4, S.W. No. 20
in 2nd St. from Greenway to Main
K&E No. 1000 376061

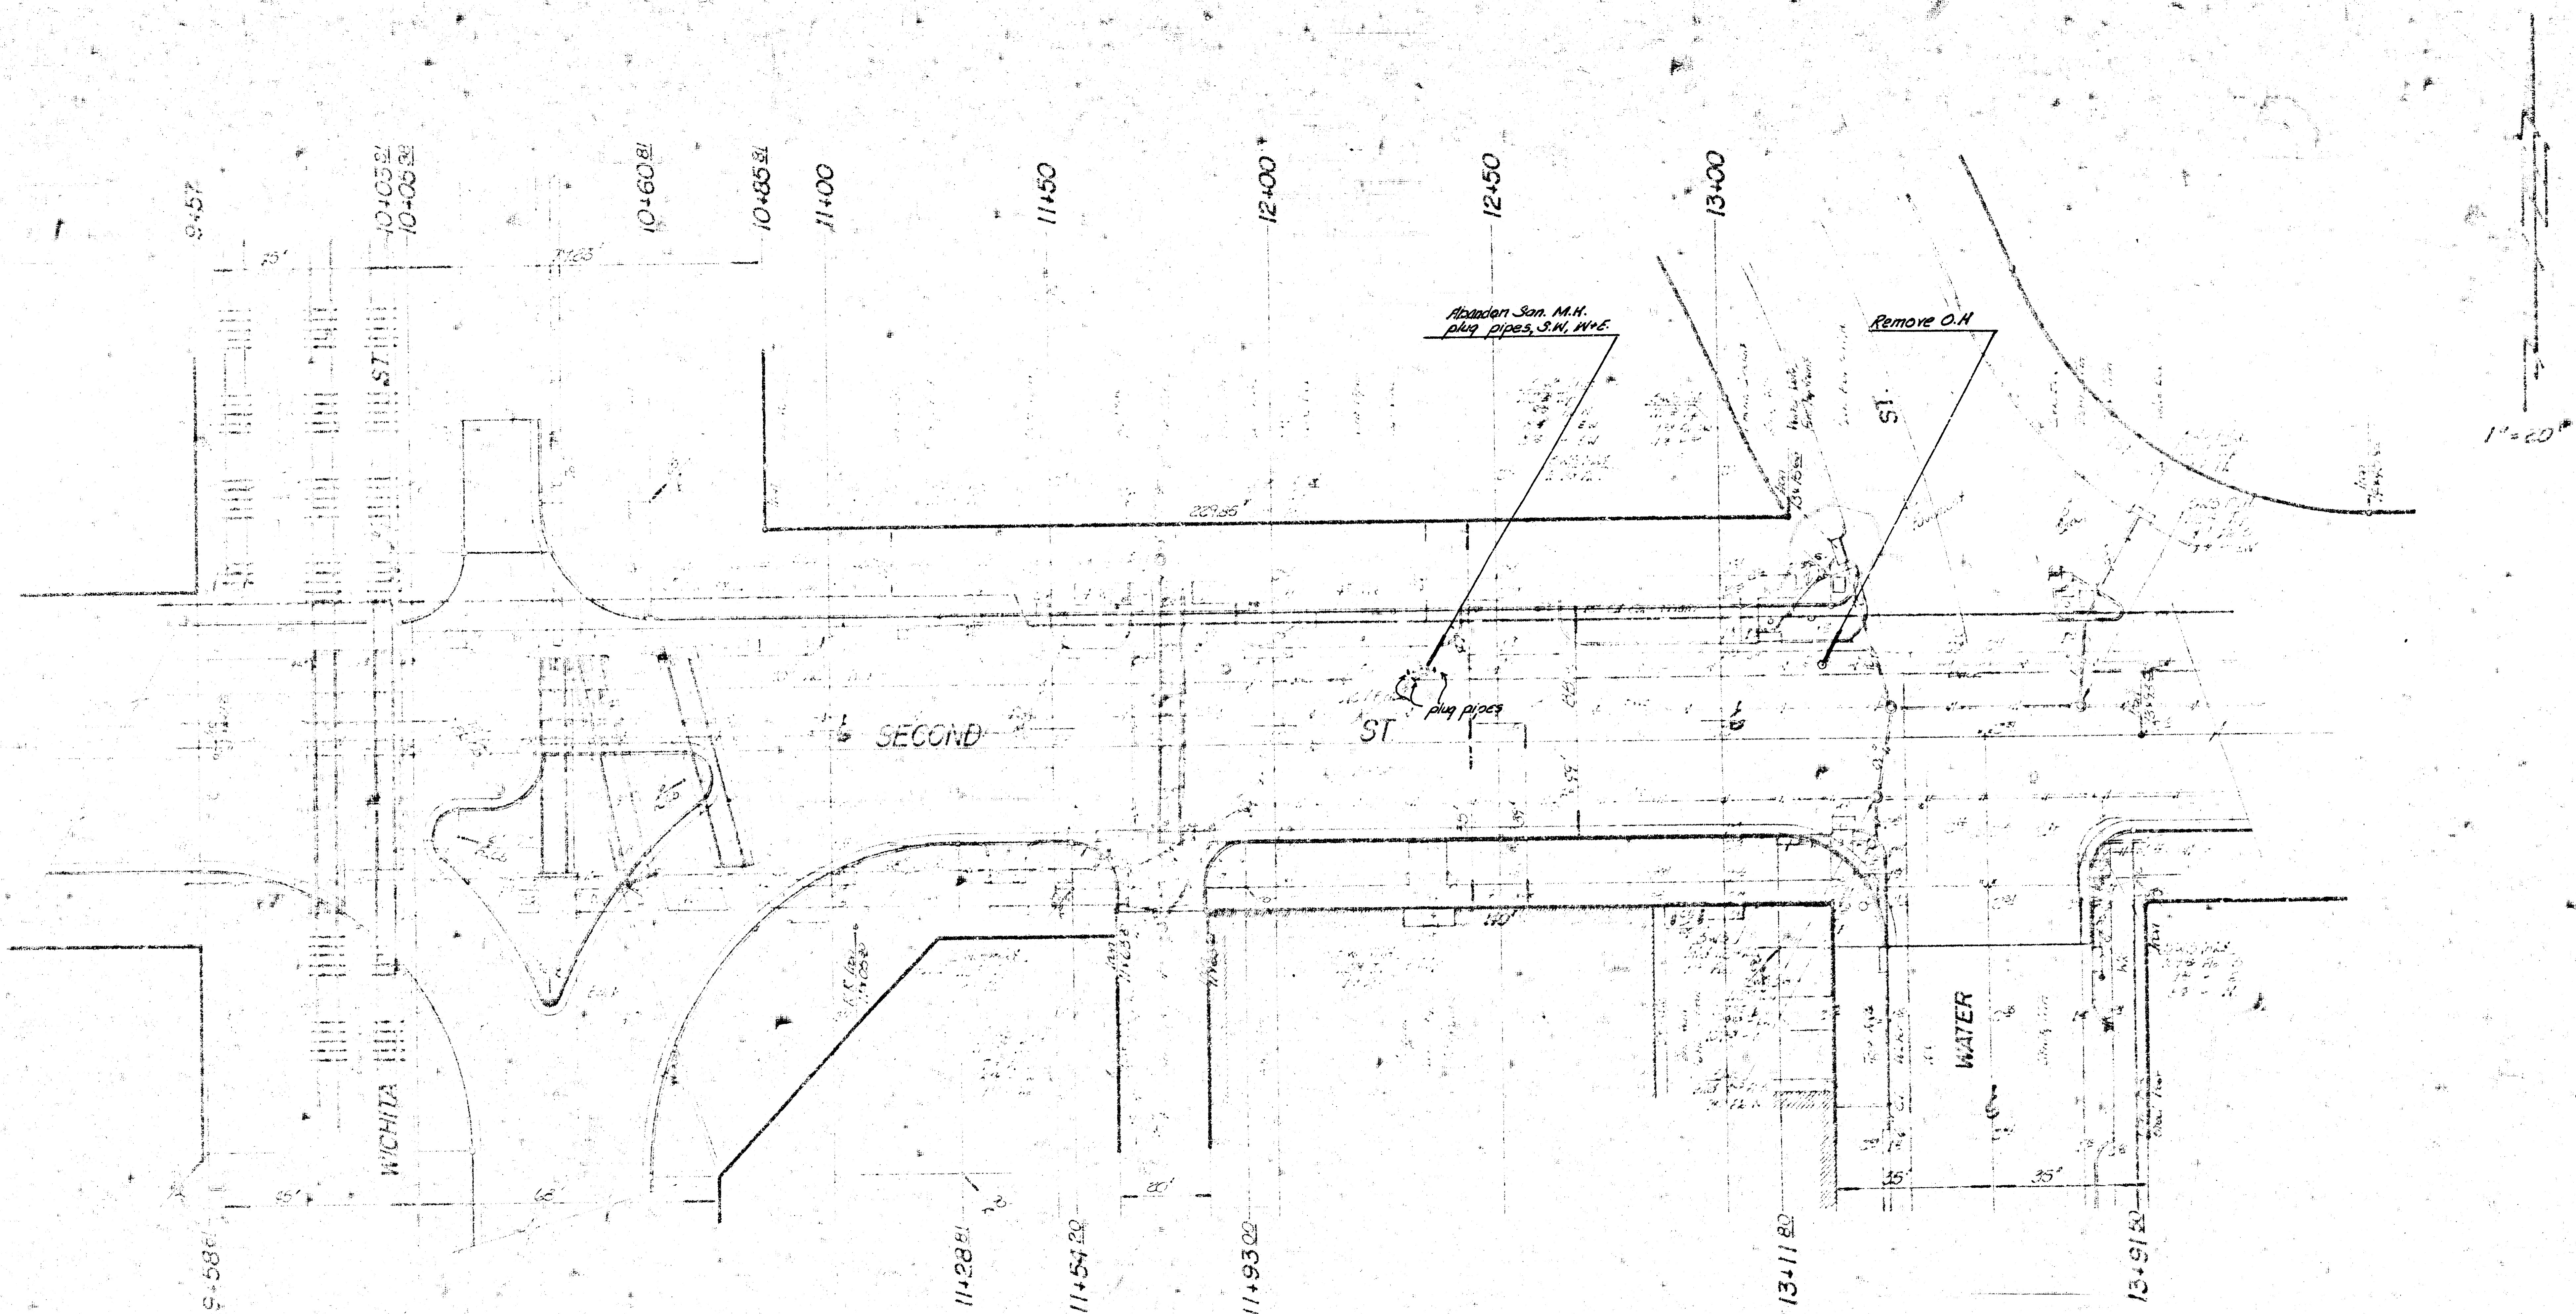

Reconstruct a Sewer to Supplement a Portion of
District '4', Sanitary Sewer No. 20
IN Second St. from Greenway to Main Street
Project Number: DBKJ 574061

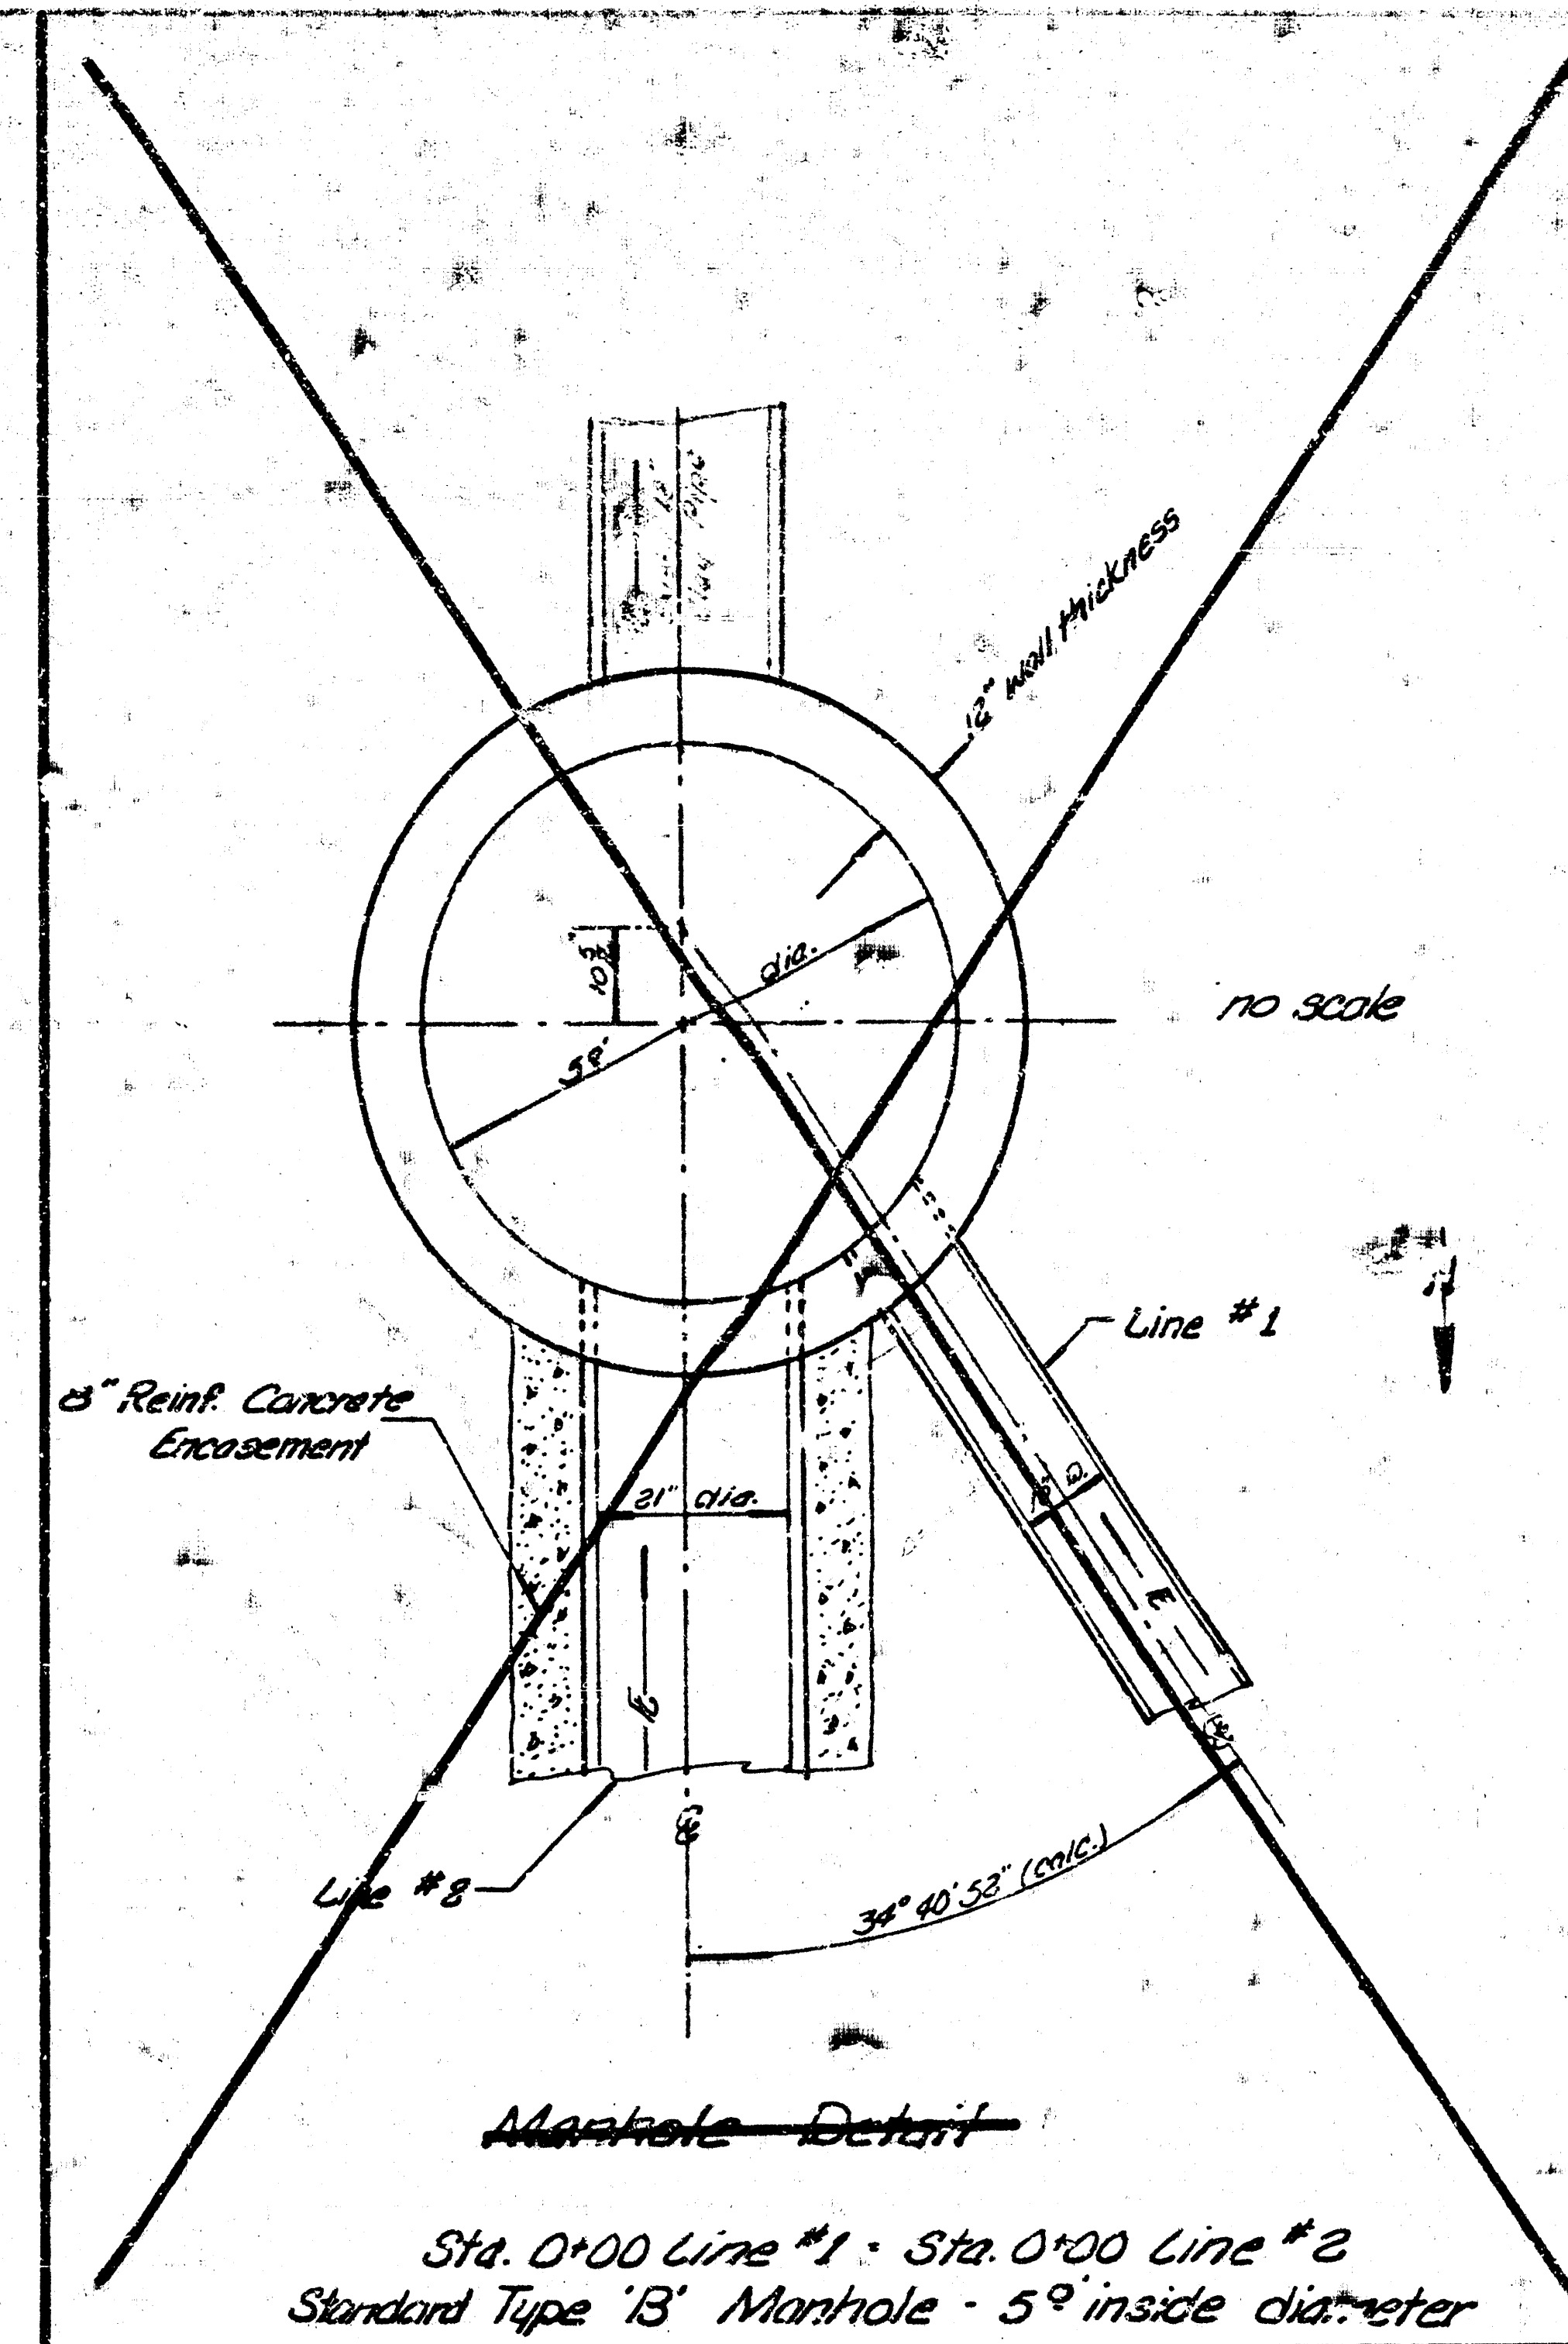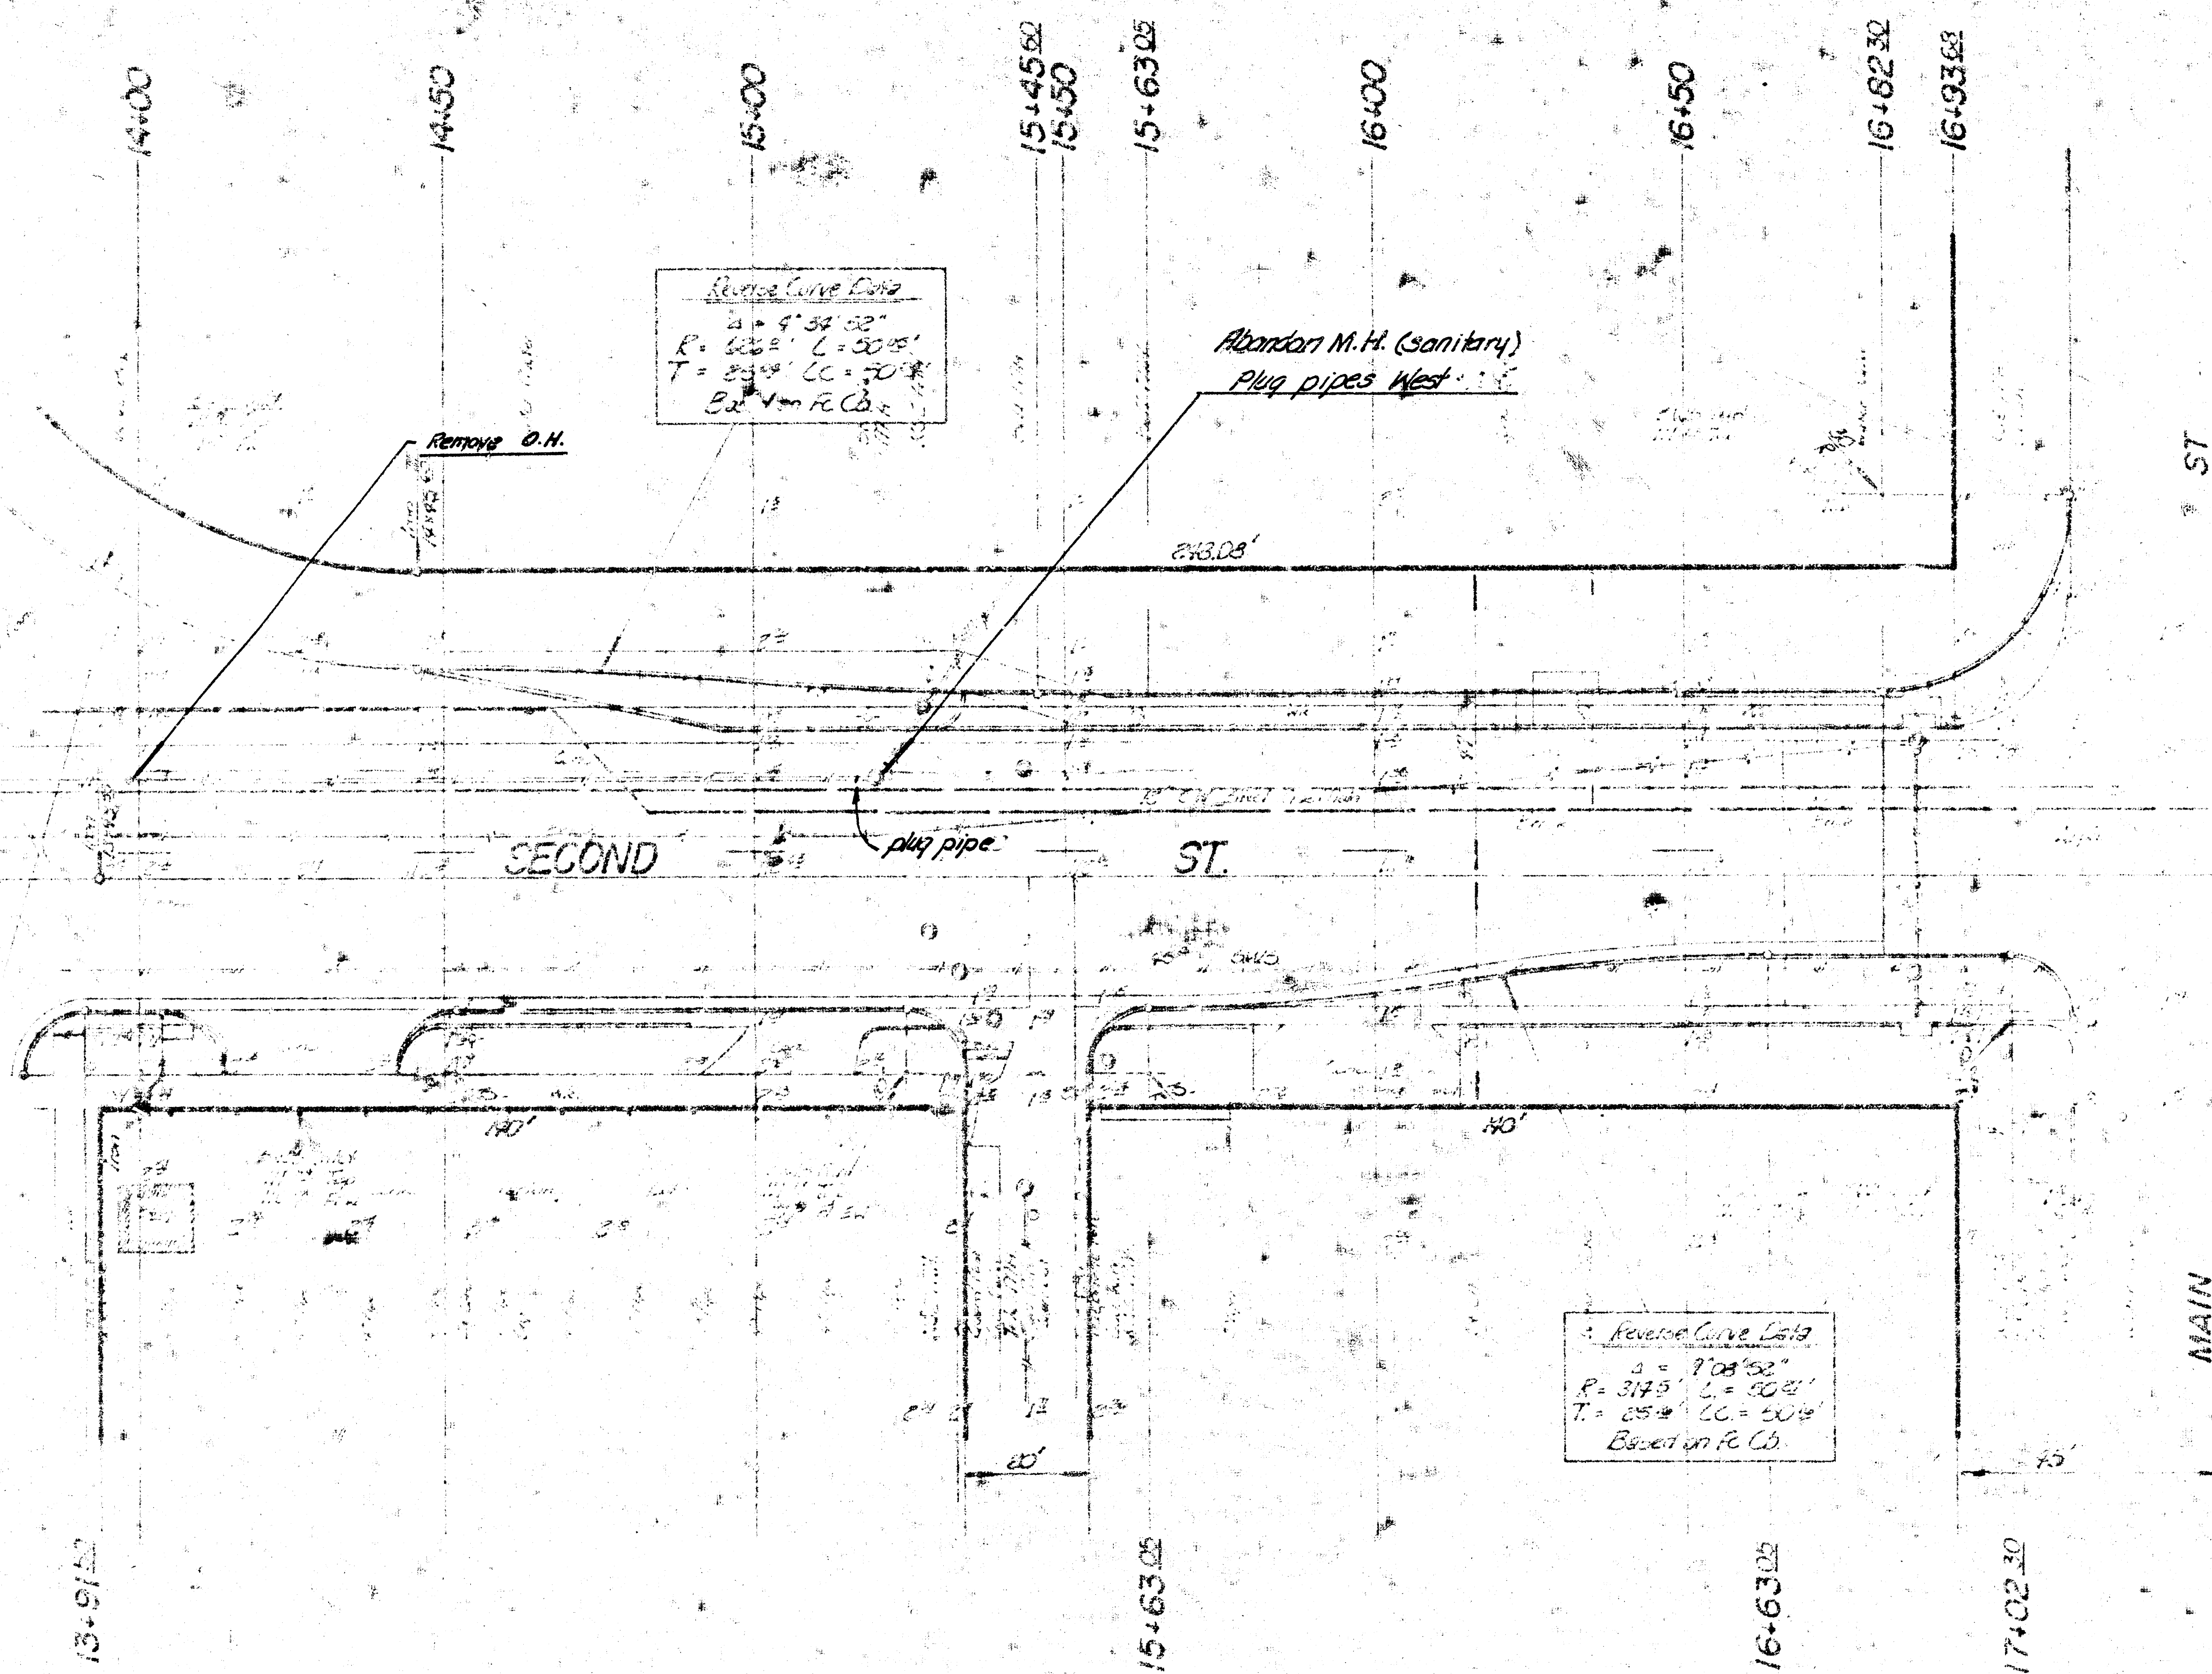

GENERAL NOTES

1. THE CONTRACTOR FOR THIS PROJECT WILL BE REQUIRED TO COORDINATE HIS WORK WITH THE CONTRACTOR FOR CONSTRUCTION OF THE STORM SEWER IN SECOND STREET FROM GREENWAY BOULEVARD TO MAIN STREET.
2. THE WORK SPECIFIED AS MANHOLES ABANDONED SHALL CONSIST OF REMOVING THE TOP 4' OF THE MANHOLE, PLUGGING ALL PIPES IN THE MANHOLE, AND FILLING THE REMAINING PORTION OF THE MANHOLE WITH SAND. THE TOP TWO FEET OF THE EXCAVATION SHALL BE BACKFILLED WITH EXCAVATED MATERIAL COMPACTED TO A DENSITY EQUAL TO OR GREATER THAN THE ADJACENT MATERIAL. PIPE PLUGS WILL BE PAID FOR SEPARATELY AT THE PRICE BID PER EACH PIPE PLUG.
3. ALL EXISTING SANITARY AND STORM SEWER PIPES WHICH ARE TO BE ABANDONED SHALL BE REMOVED WHERE THEY CONFLICT WITH NEW CONSTRUCTION AS APPROVED BY THE ENGINEER. THE ENDS OF THE REMAINING PORTIONS OF THE ABANDONED SEWERS SHALL BE PLUGGED.
4. THE LIMITS OF PAVEMENT REMOVAL AND WALK REMOVAL SHALL BE AS APPROVED BY THE ENGINEER.
5. THE LIMITS FOR PAVEMENT REPLACEMENT AND WALK REPLACEMENT SHALL BE AS DIRECTED BY THE ENGINEER.

Reconstruct a Sewer to Supplement a Portion of
 District '4' Sanitary Sewer No. 20
 in Second St. from Greenway to Main Street
 PROJECT NUMBER: DSKJ 574061