

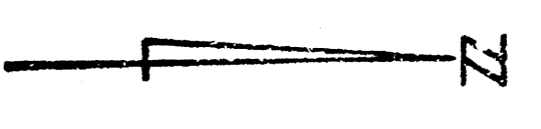


B.M. 102.87 N.E. Cor. 1<sup>st</sup> Slap on back porch of House S.E. Cor. Willwood & St. Paul  
 B.M. 98.40 4" R. and S.E. curb Return S.E. Cor. 30<sup>th</sup> & Gordon

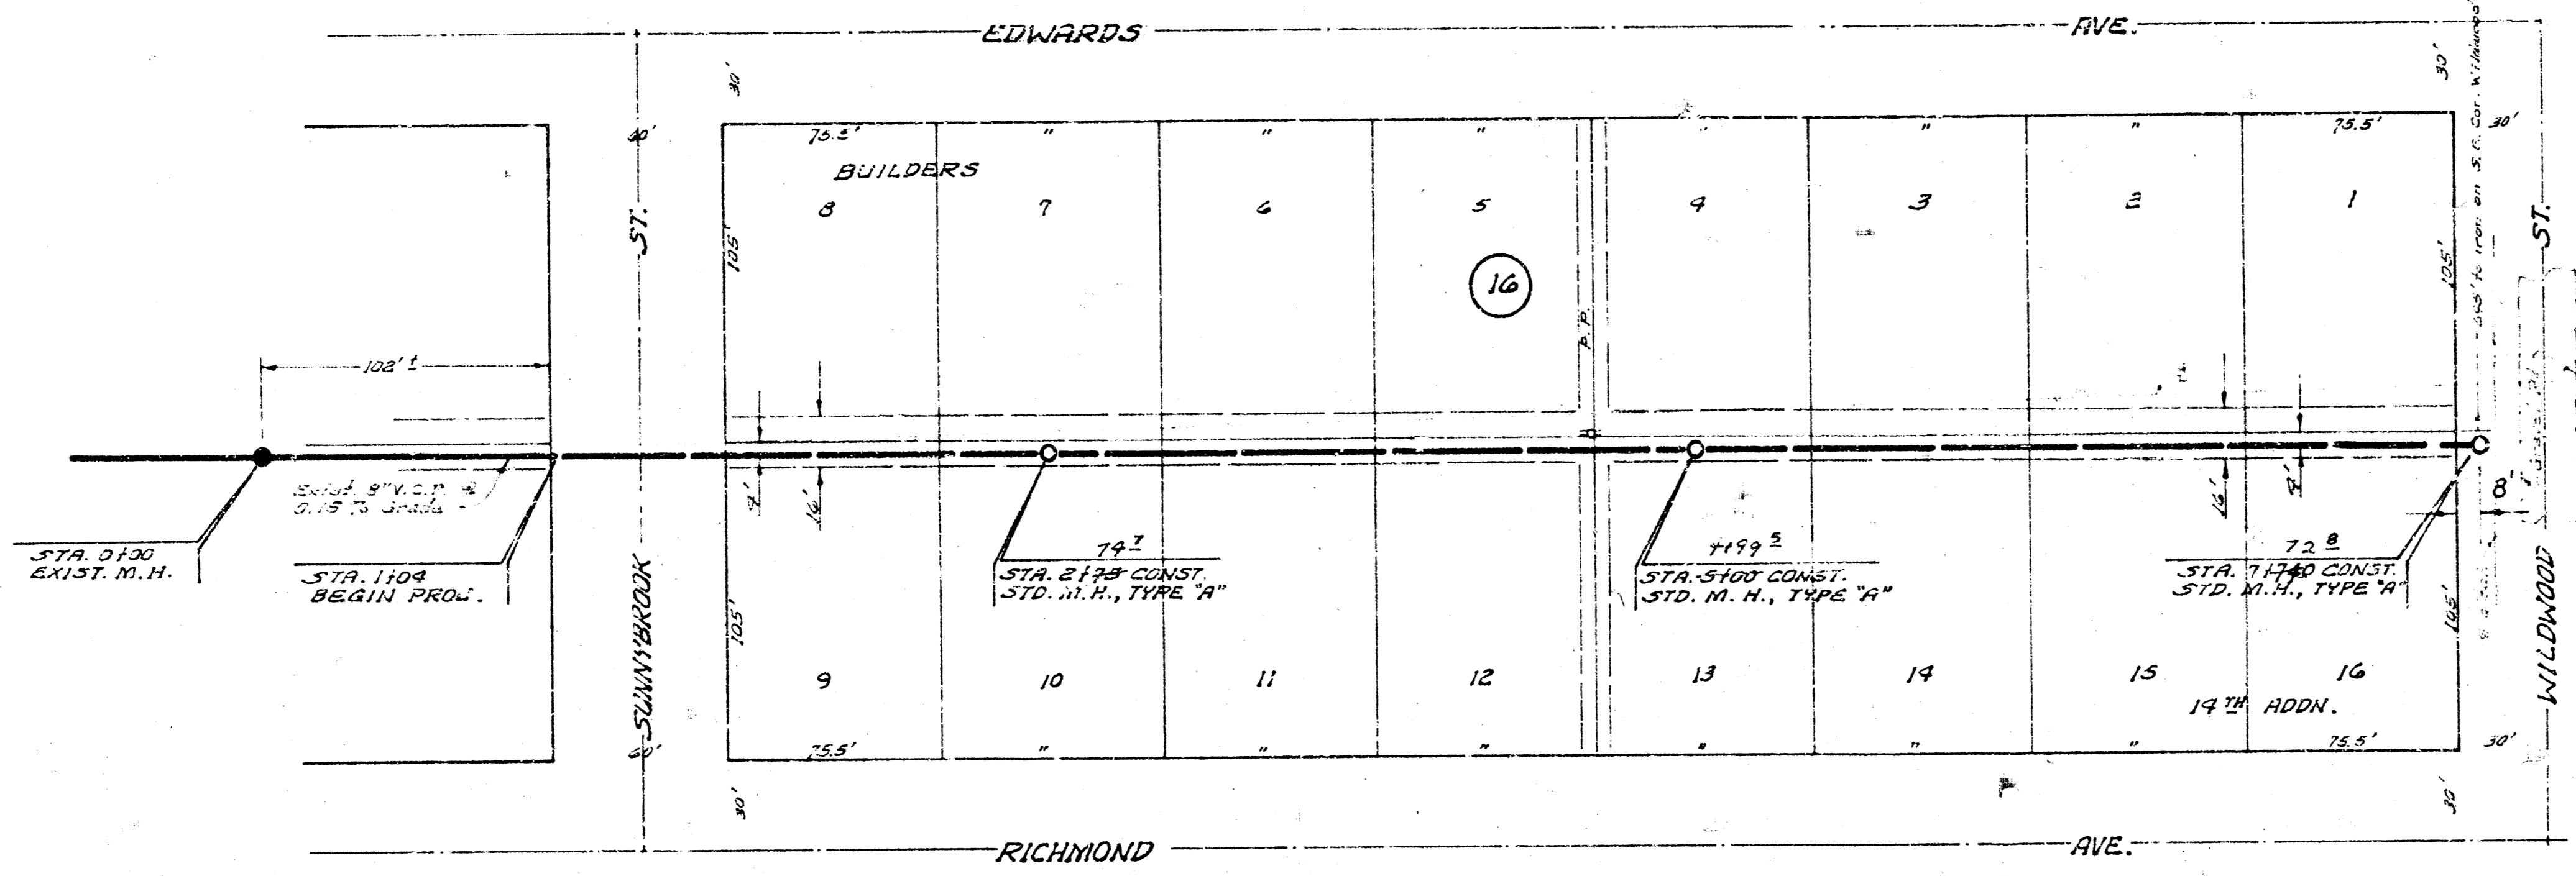

Plan Scale 1" = 40'  
 Profile Scale 1" = 40' vert.  
 1" = 40' hor.

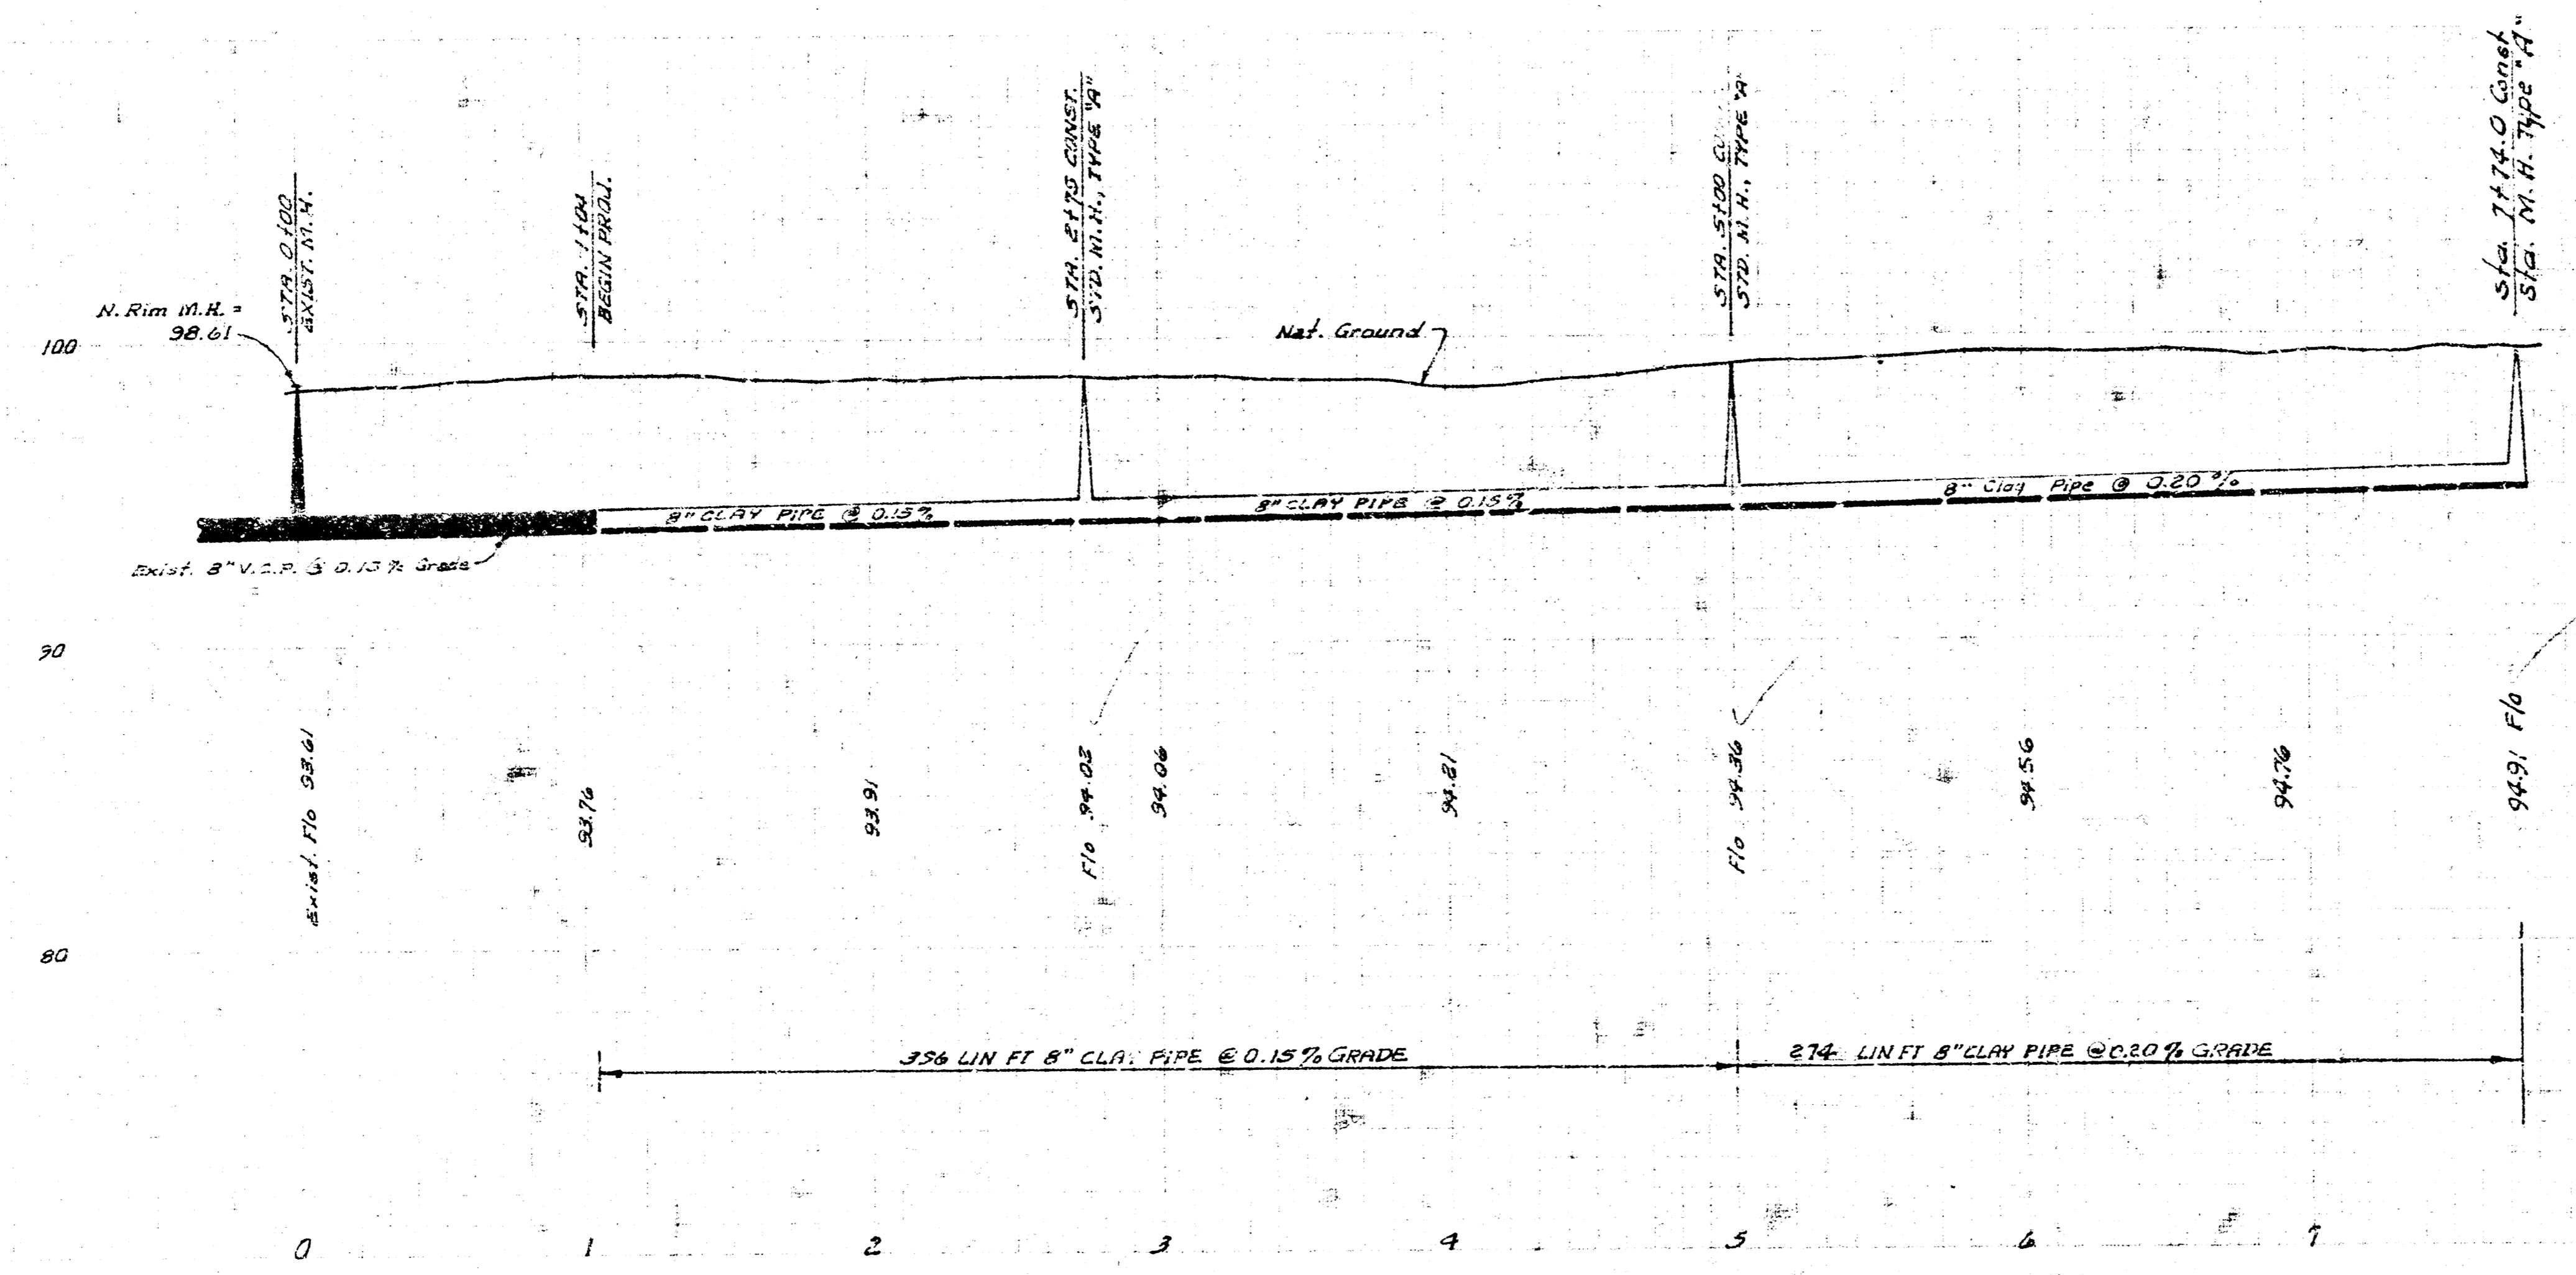

"As Built" Final Mean 50' U.S.A.

LAT. 105, SAN. SEWER 22  
 CITY OF WICHITA, KANSAS  
 R. W. LINN, CITY ENGINEER  
 PROJ. NO. DBKLS68005  
 DATE: NOV. 1973