

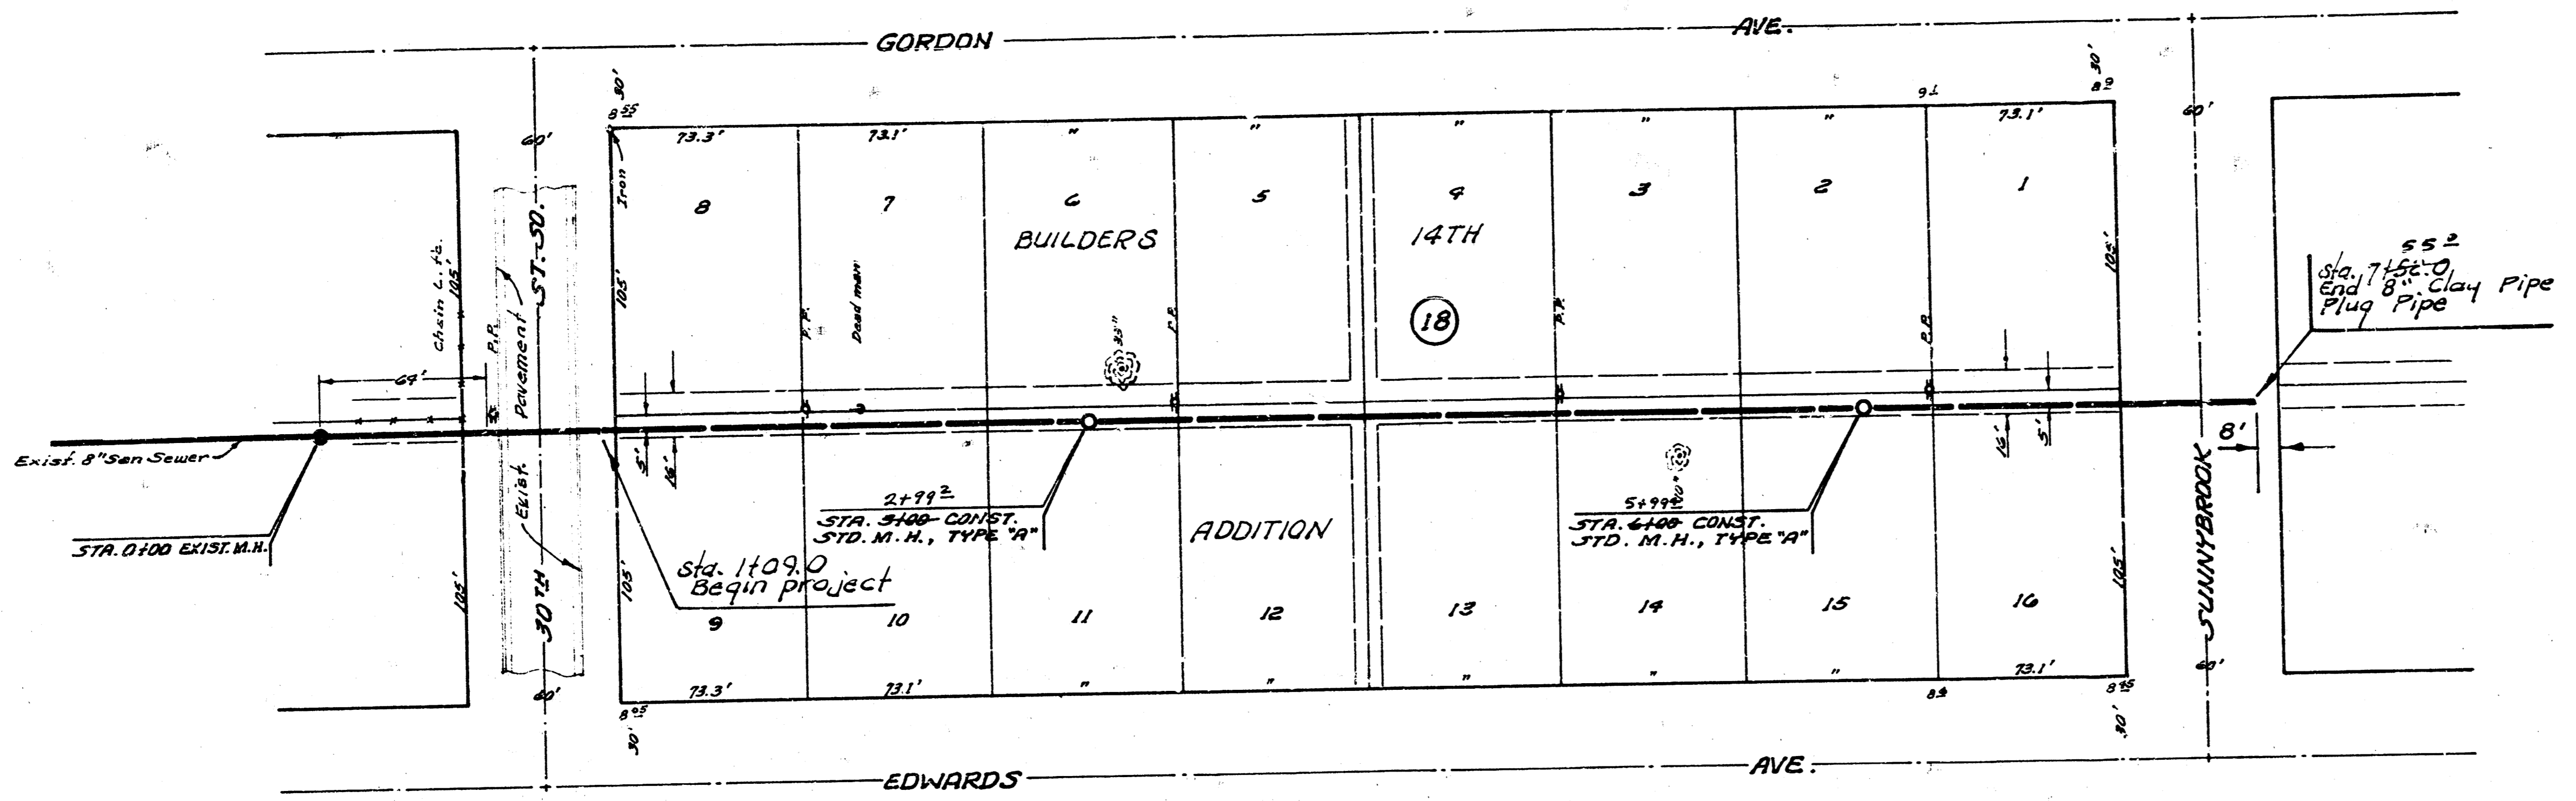


Surveyed by Linn & Linn
 Plan D. Linn
 Ex. Linn
 Checked T. Linn


B.M. 99.90 1" E. End S.E. Curb Return S.E. Cor. 30th & Gordon
 B.M. 102.87 N.E. Cor. 1st Step on back porch of No. S.E. Cor. Wildwood & St. Paul

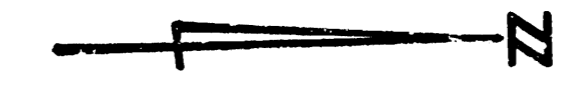

Plan Scale 1"=40'
 Profile Scale 1"=40' Hor.
 1"=4' Vert.

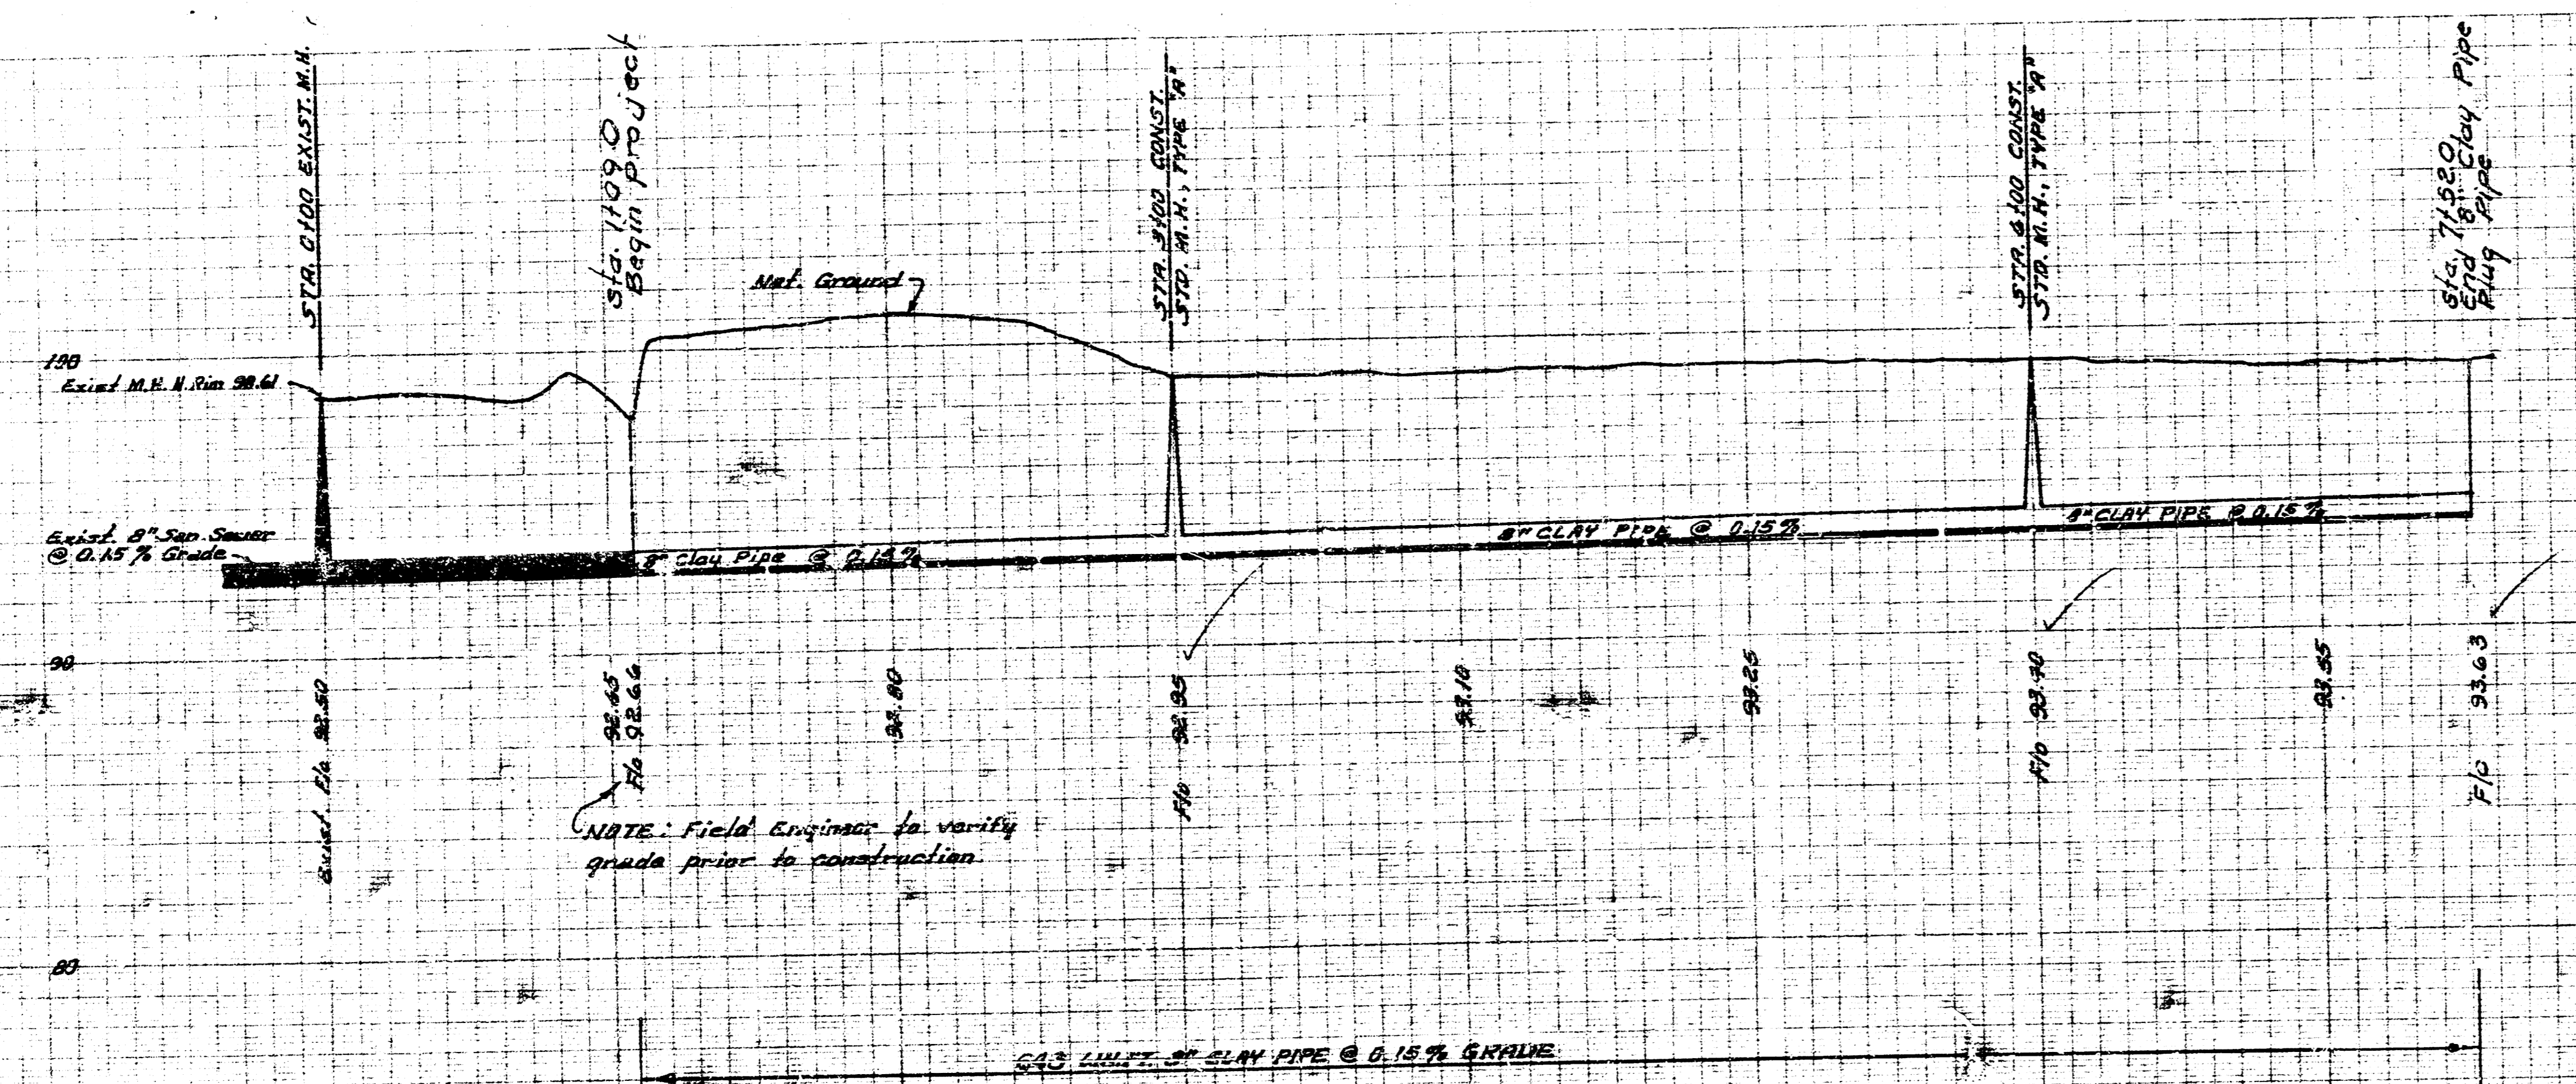

NOTE: Field Engineer to verify
 grade prior to construction

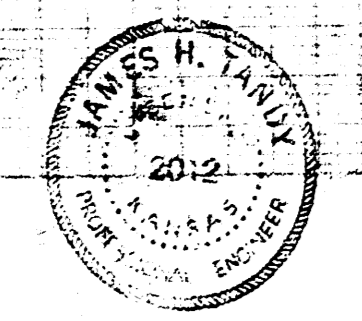

As Built Final Map 55-12 JK
 LAT. 109, SAN SEWER 22
 CITY OF WICHITA, KANSAS
 R. W. LINN, CITY ENGINEER
 PROJ. NO. DBK1568009
 DATE: NOV. 1973