

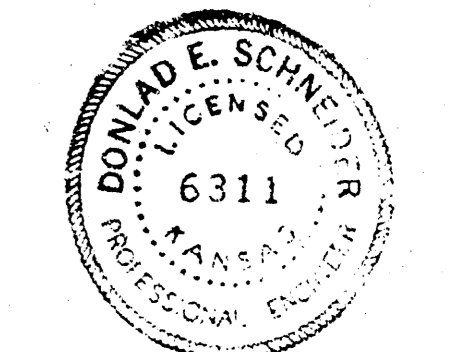
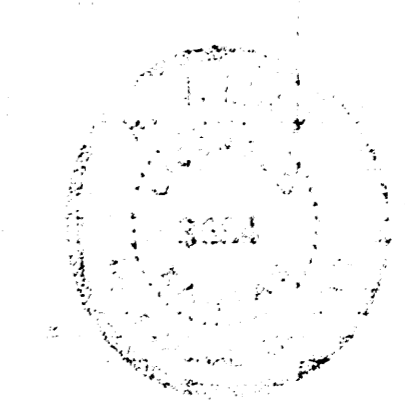


N  
 SCALE  
 VERTICAL ~ 1"=5'  
 HORIZONTAL ~ 1"=40'

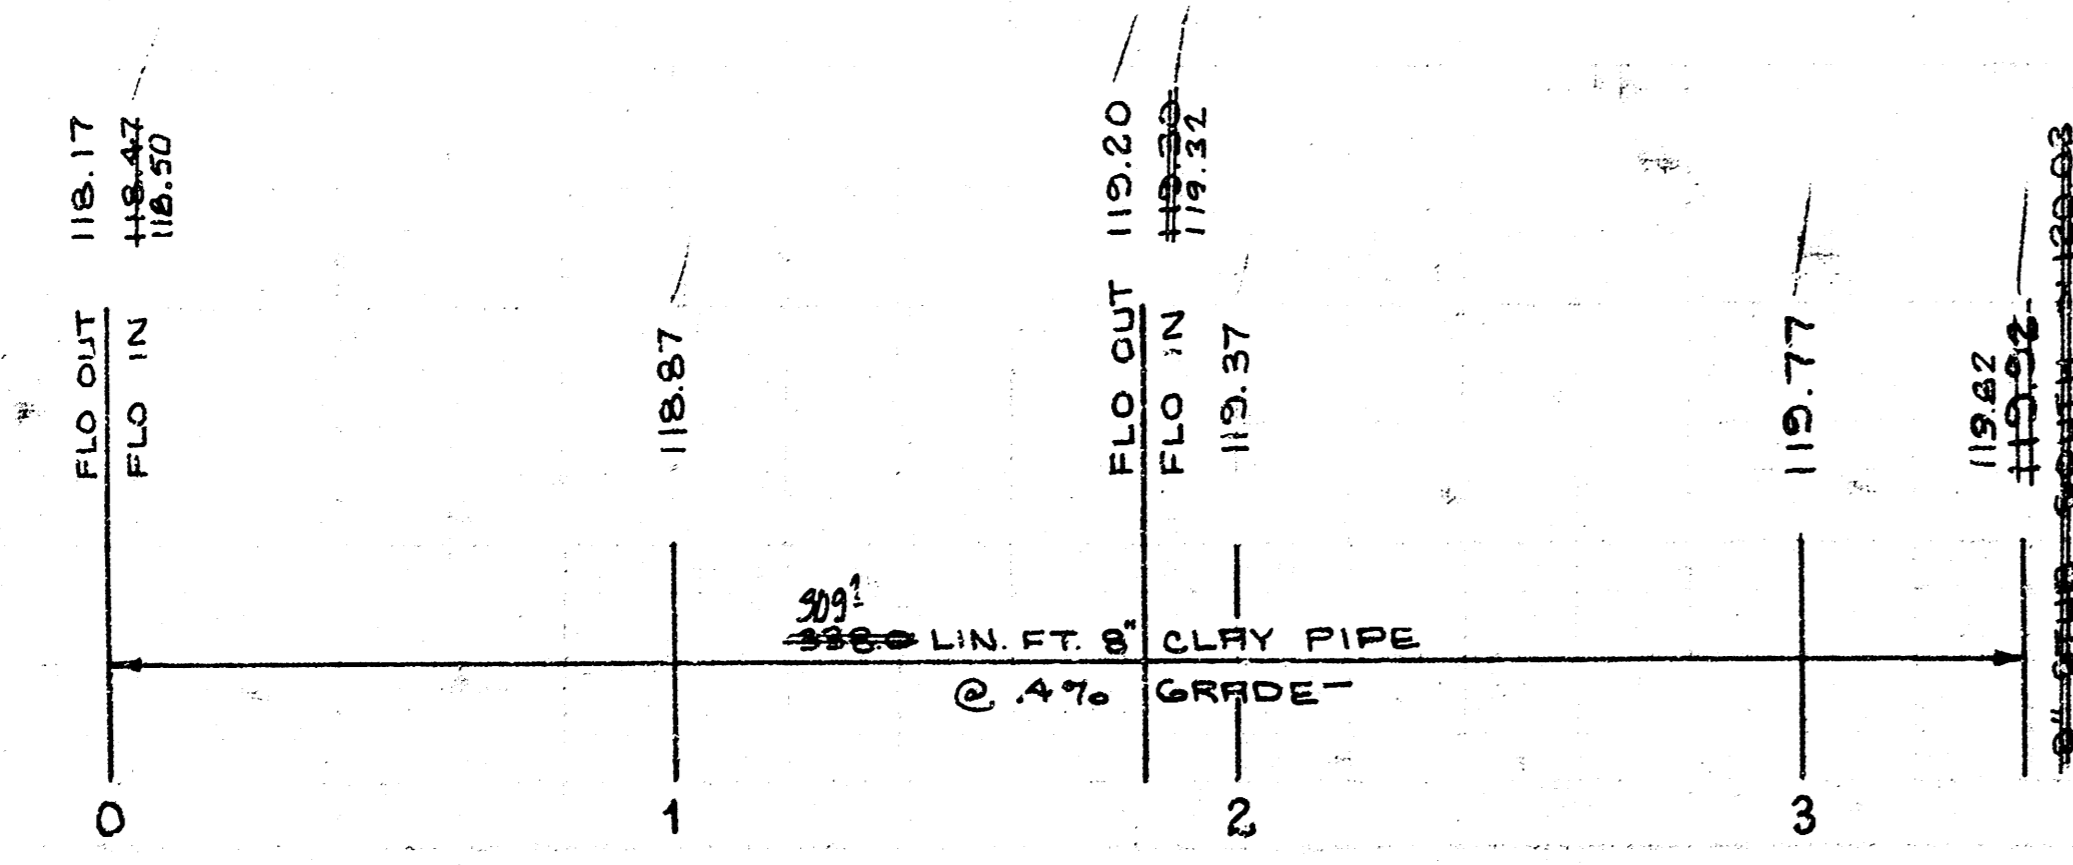

130  
 125  
 120  
 115  
 110

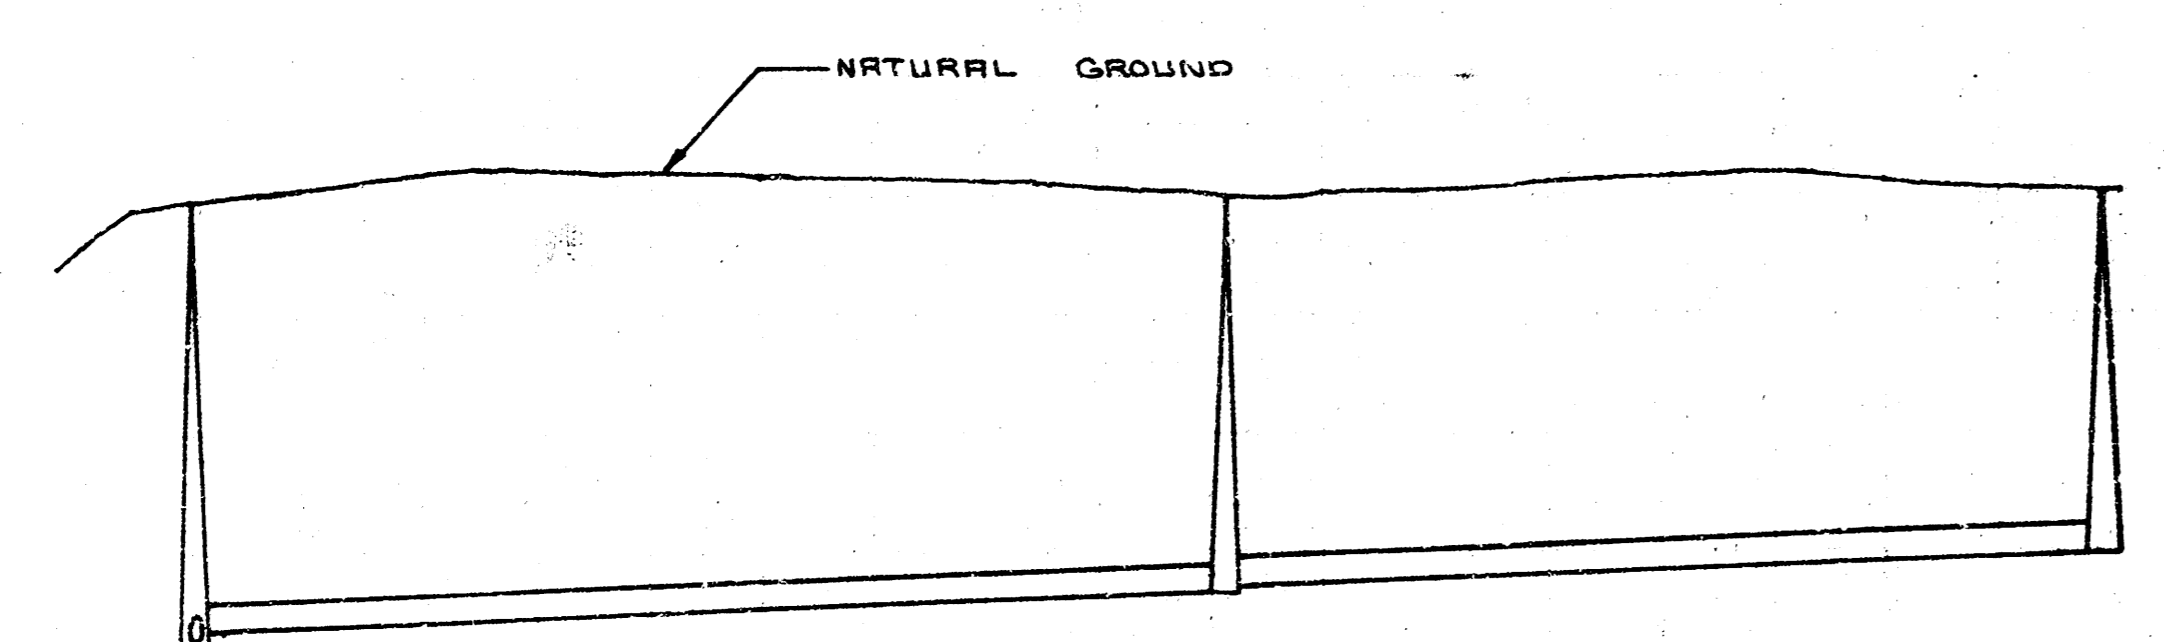

"As Built" 21 Aug 72 FINAL MEASUREMENT IN K-89  
 LAT 117 SS 22  
 CITY OF WICHITA  
 R.W. LINN CITY ENGINEER  
 DATE Aug. 1972 PROJECT NO. DBKL571029

FILMED FROM THE BEST