


N

SCALE
 VERTICAL - 1" = 10'
 HORIZONTAL - 1" = 40'

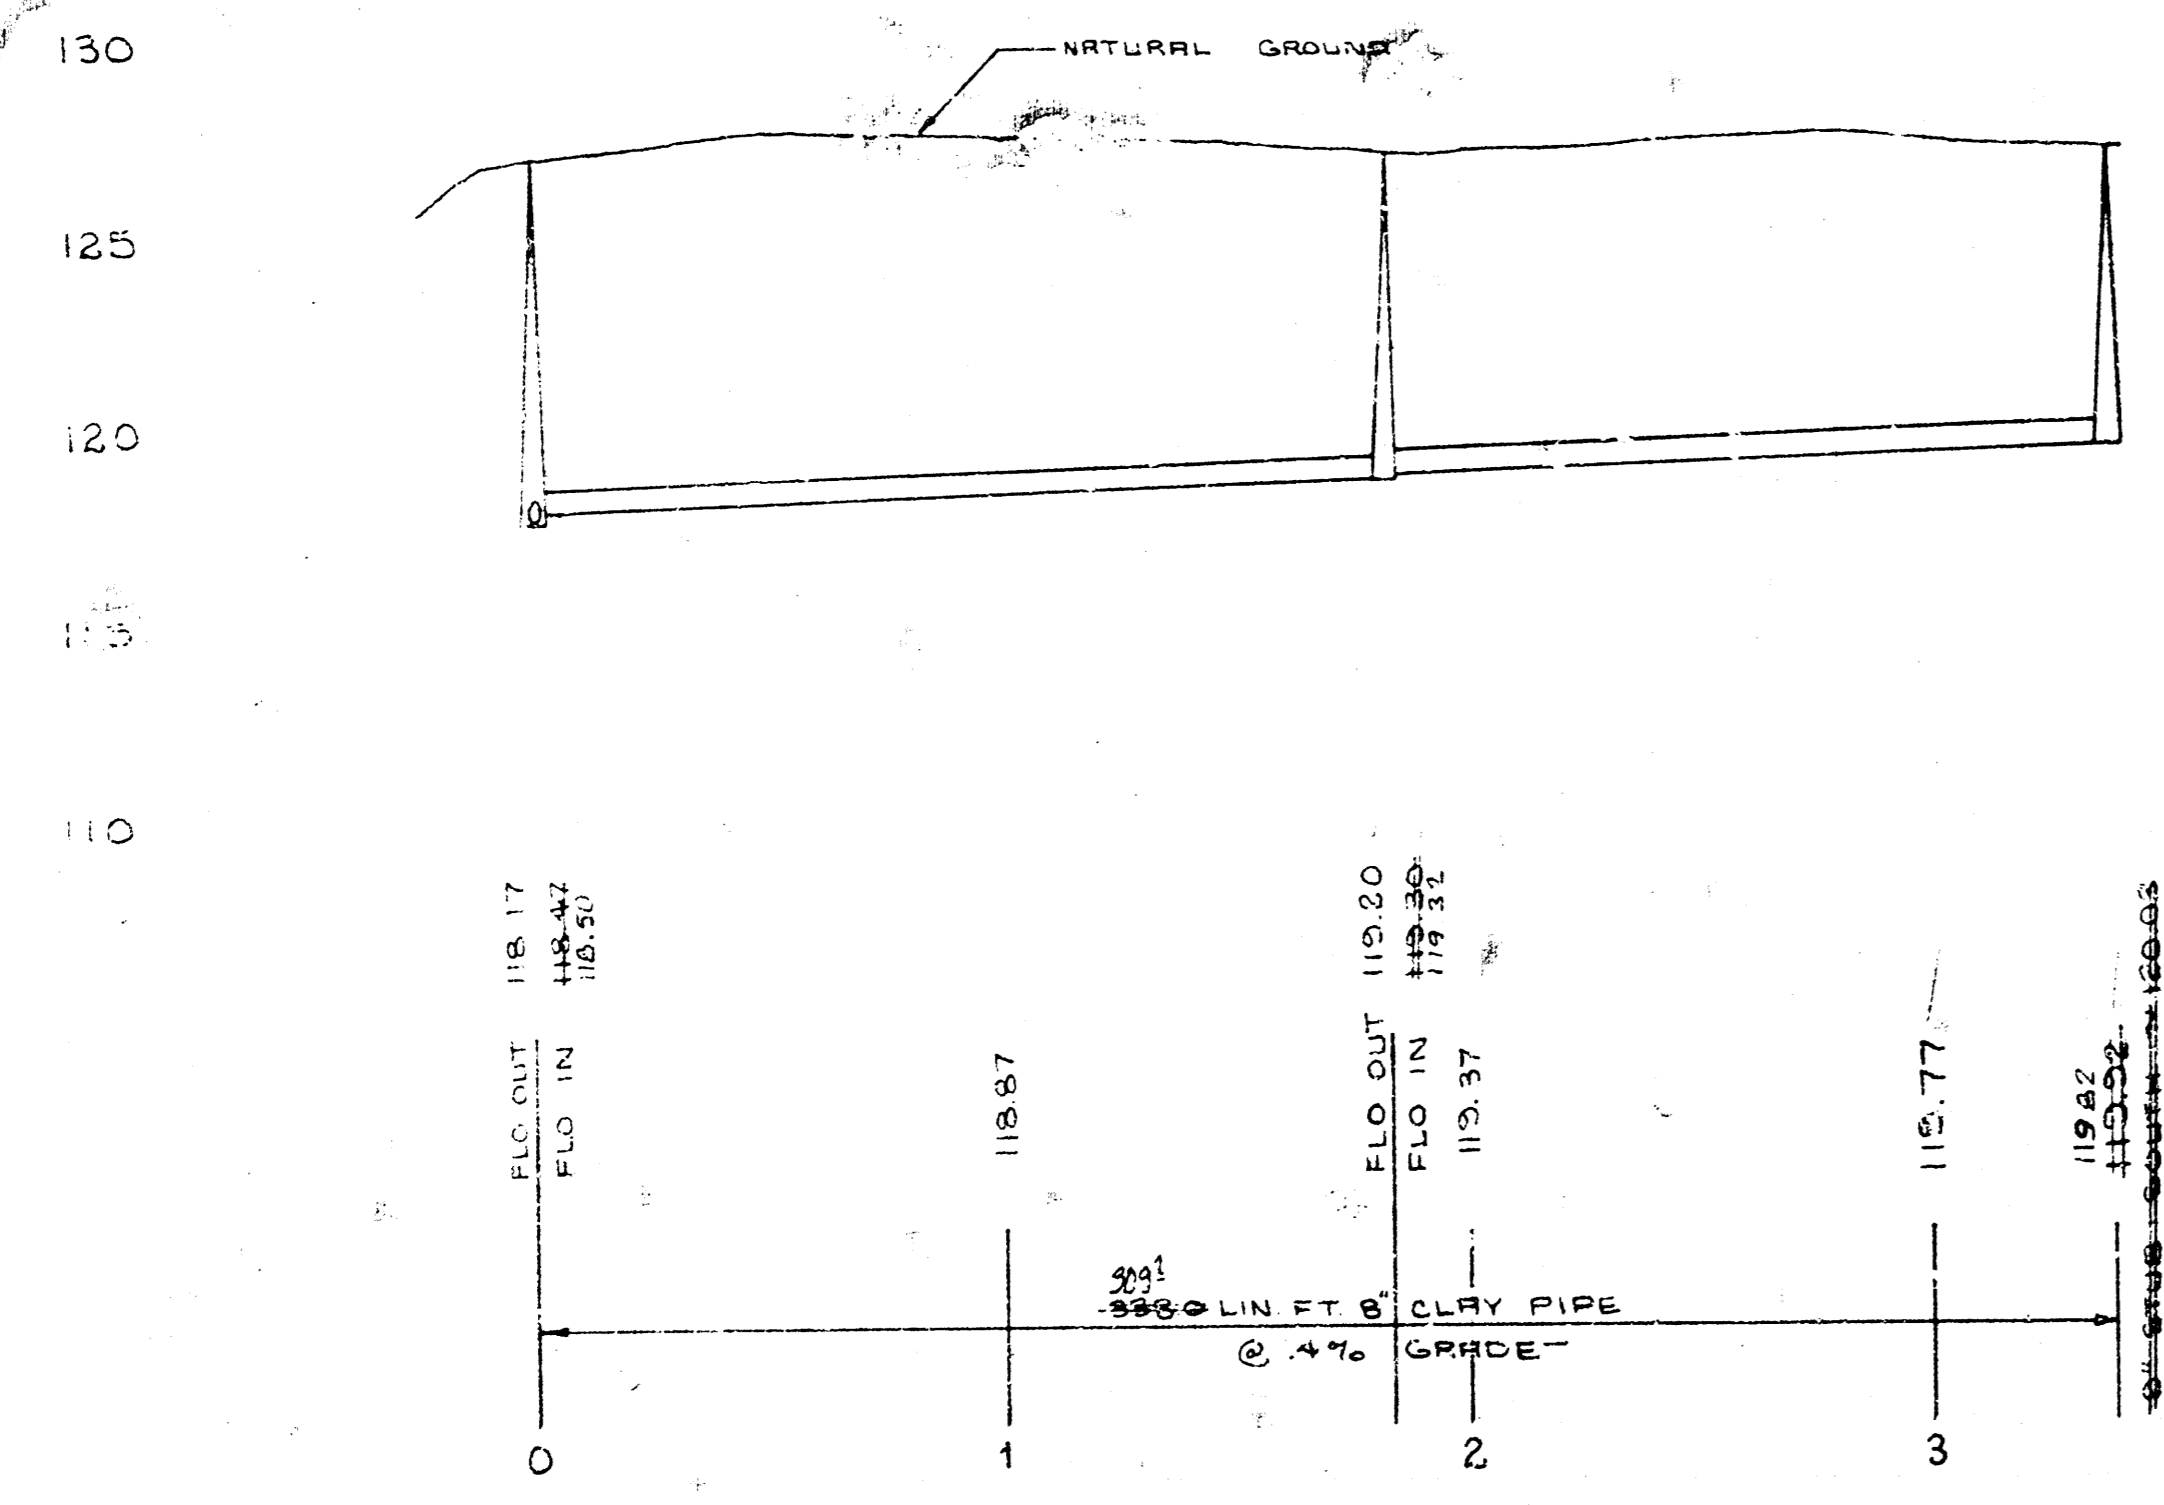

LAT 117 SS 22
CITY OF WICHITA
R.W. LINN CITY ENGINEER
 DATE Aug. 1972 PROJECT NO. DBKL571029