


8/22/14
B. J. Brill
Engineer

8/22/14

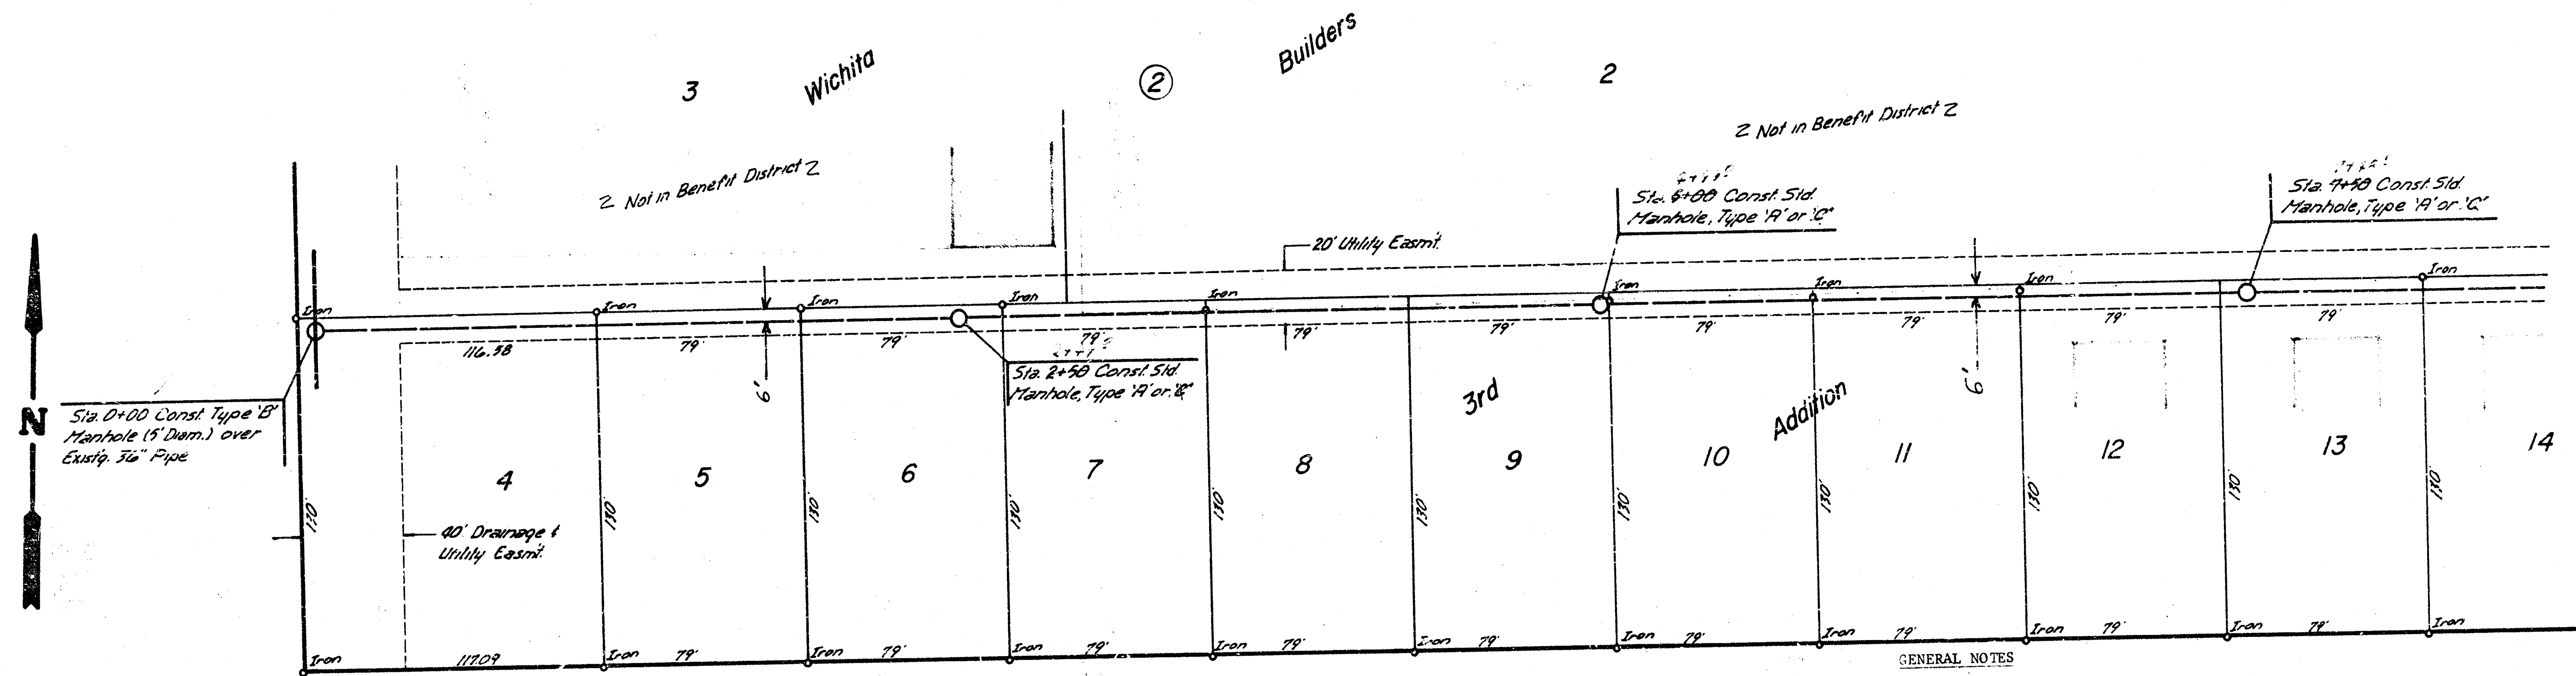



NOTE: FIELD ENGINEER SHALL SET TOPS OF MANHOLES TO MATCH PROPOSED FINISHED GRADE AS DETERMINED BY THE DEVELOPER. RISERS AND ADDITIONAL STUBS SHALL BE INSTALLED ON THIS PROJECT TO SERVE INDIVIDUAL LOTS WHEN ORDERED BY THE FIELD ENGINEER. RISER OF CONSTRUCTION SHALL CONFORM TO THE REQUIREMENTS AS SHOWN ON STANDARD RISER DETAIL SHEET. LOCATIONS OF THE ENDS OF RISERS SHALL BE MARKED BY PASTING GREEN PLASTIC COLOR TAPE TO THE END OF THE RISER AND BROUGHT TO THE GROUND. TAPE AS THE EXCAVATION IS BACKFILLED SUCH THAT THE COLORED TAPE WILL BE VISIBLE WHEN THE PROJECT IS COMPLETED. ALL RISERS SHALL BE CONSTRUCTED USING S.D.R. 23.5 A.B.S. OR P.V.C. PIPE. ELEVATIONS OF STUBS AND TOPS OF RISERS SHALL BE SUCH THAT WILL FACILITATE CONNECTION OF BASEMENT DRAINS WHEN THESE LOTS ARE DEVELOPED.

27th St. So.


1. CONTRACTOR TO CONTACT UTILITY COMPANIES BEFORE BEGINNING CONSTRUCTION FOR LOCATION OF ANY UNDERGROUND LINES.
2. FIELD ENGINEER TO TAKE TIES TO ALL IRONS THAT MAY BE DISTURBED DURING CONSTRUCTION AND REPLACE ANY THAT ARE DESTROYED.
3. FIELD ENGINEER SHALL SET TOPS OF MANHOLES TO MATCH PROPOSED FINISHED GRADE AS DETERMINED BY THE DEVELOPER.
4. OUTSIDE OF MANHOLE AT STATION 0+00 SHALL BE WATERPROOFED WITH TWO HEAVY COATS OF KOPERS BITUMASTIC SUPER SERVICE BLACK, TNEPEC 450 HEAVY TNEPECOL, U.S.S. TARMASTIC 103, OR APPROVED EQUAL.
5. CONTRACTOR SHALL GIVE OWNER OF LOT 2 ADVANCE NOTICE PRIOR TO REMOVING FENCE.

B.M. 101.76 R.R. Spike N.W. Side Power Pole
S.E. Corner Corradot St. Paul
B.M. 103.29 City Ditch 57' S. + 6' E. of 1/4 Sec.
of Pomeroy & Sheridan

Scale
Plan 1"=40'
Profile Horiz. 1"=40'
Vert. 1"=5'

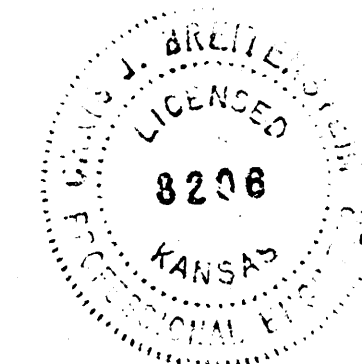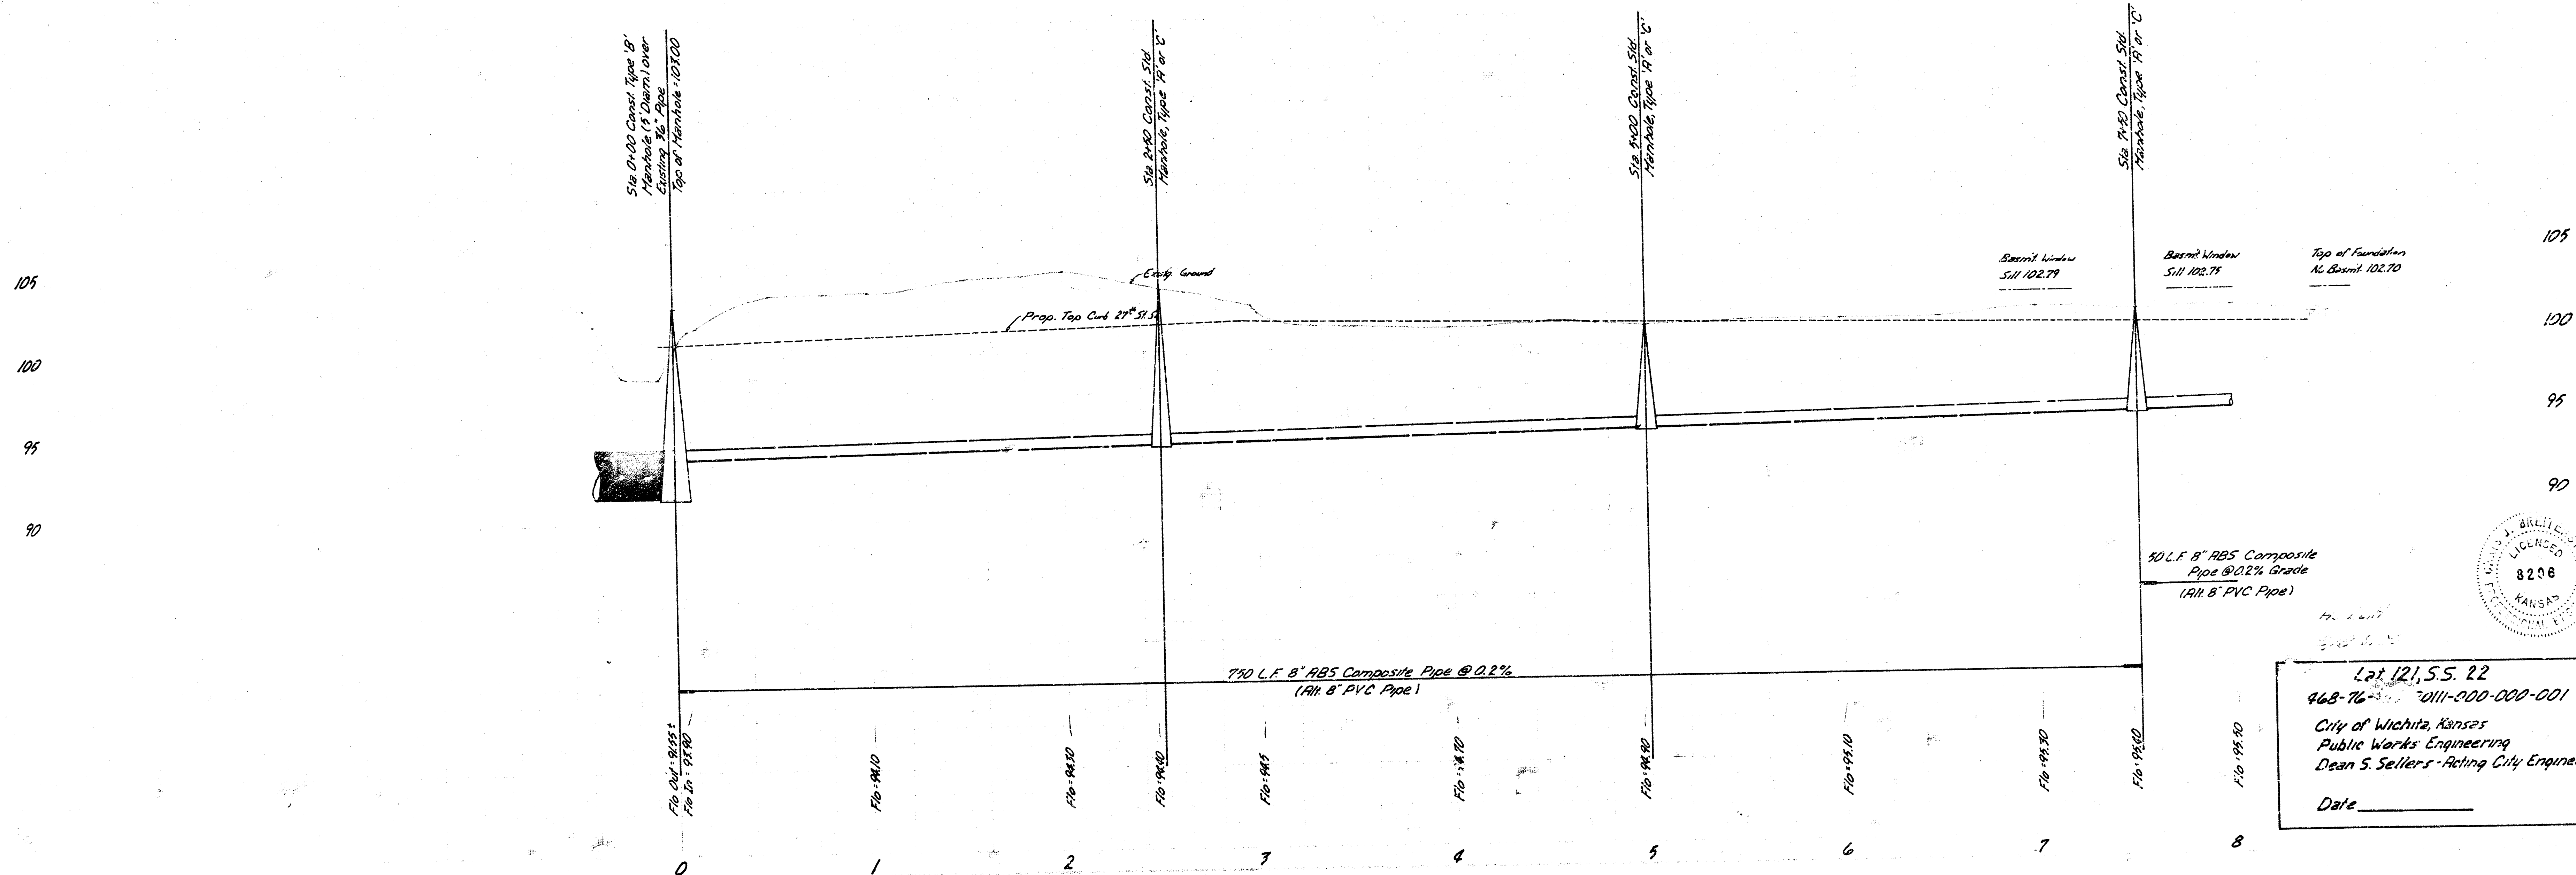

Lot 12, S. 22
468-76-1111-000-001
City of Wichita, Kansas
Public Works Engineering
Dean S. Sellers - Acting City Engineer
Date _____

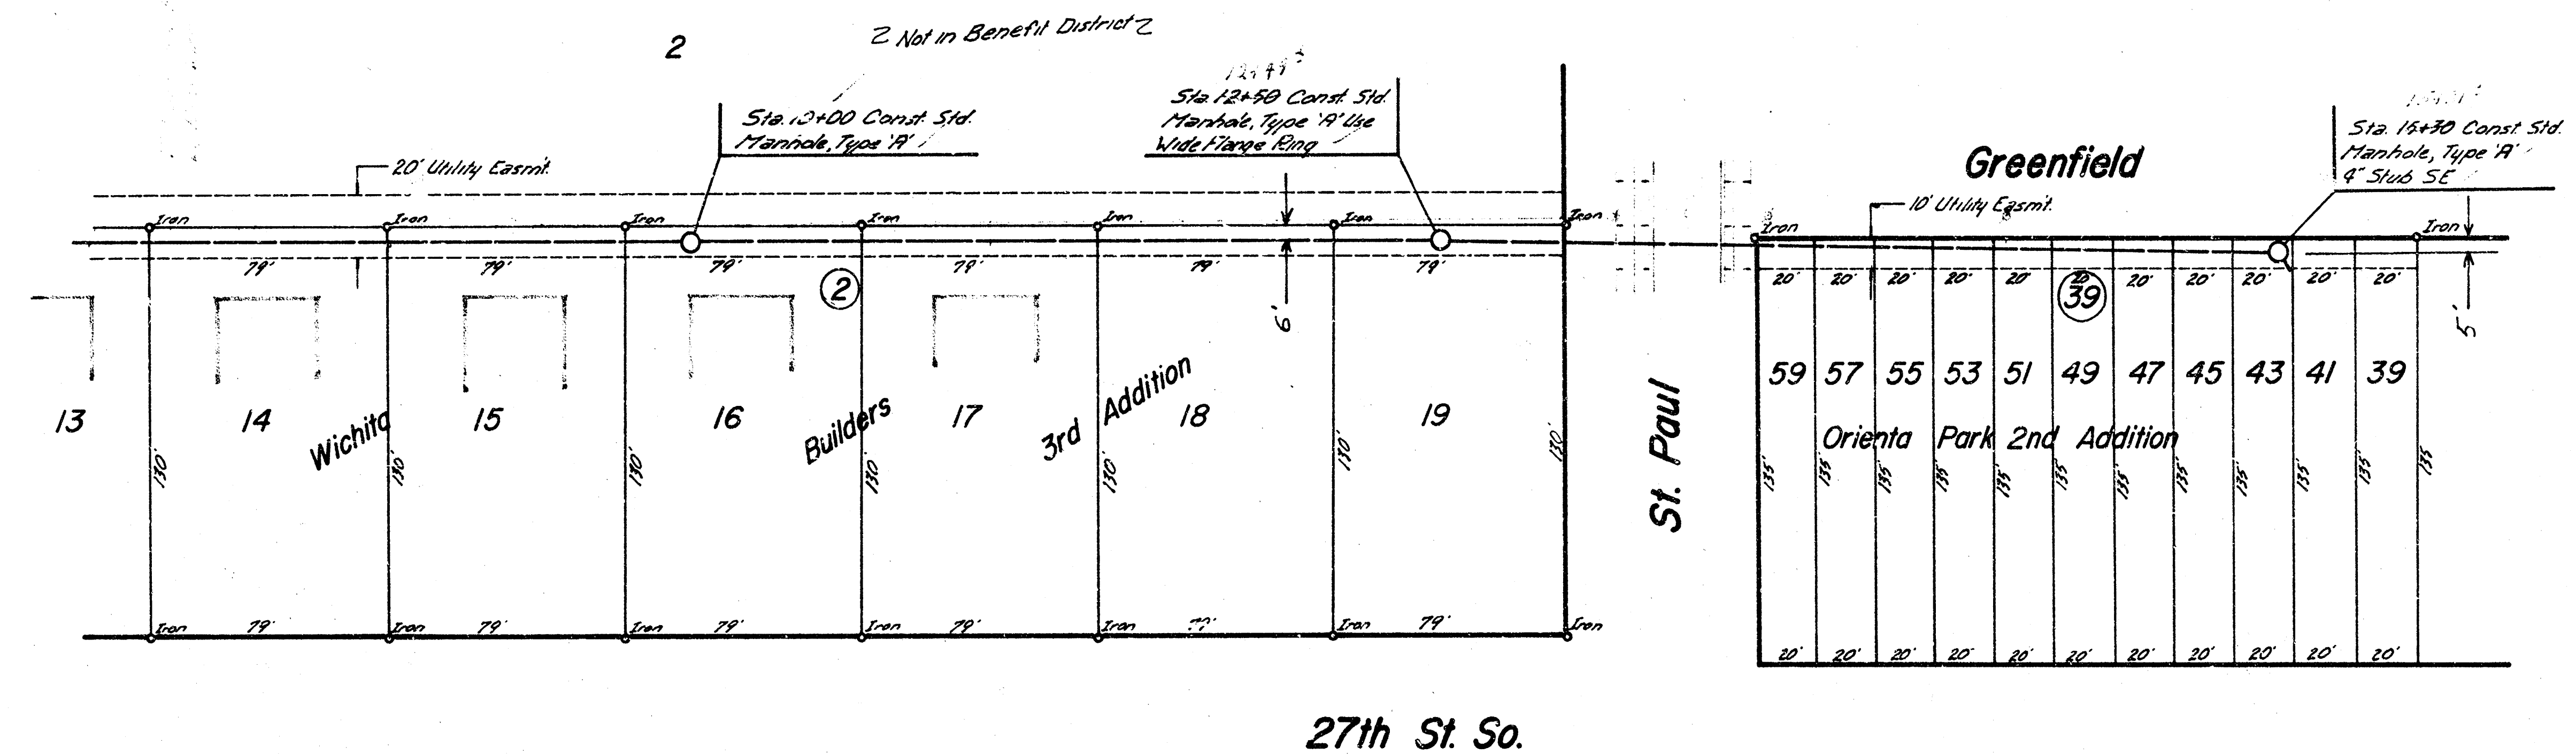

Scale
Plan 1"=40'
Profile Horiz 1"=40'
Vert 1"=5'

