

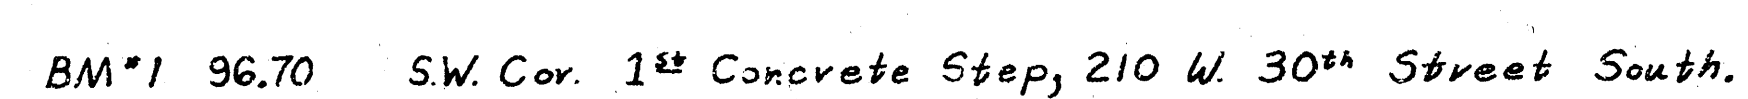


LSI-870

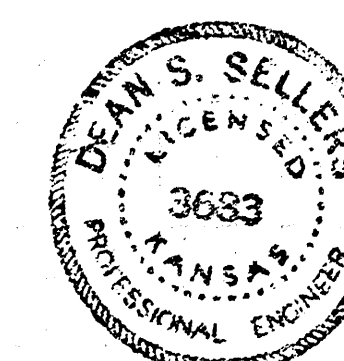

Plan Scale : 1" = 40'
Profile Scale: Horizontal 1" = 40'
Vertical 1" = 5'

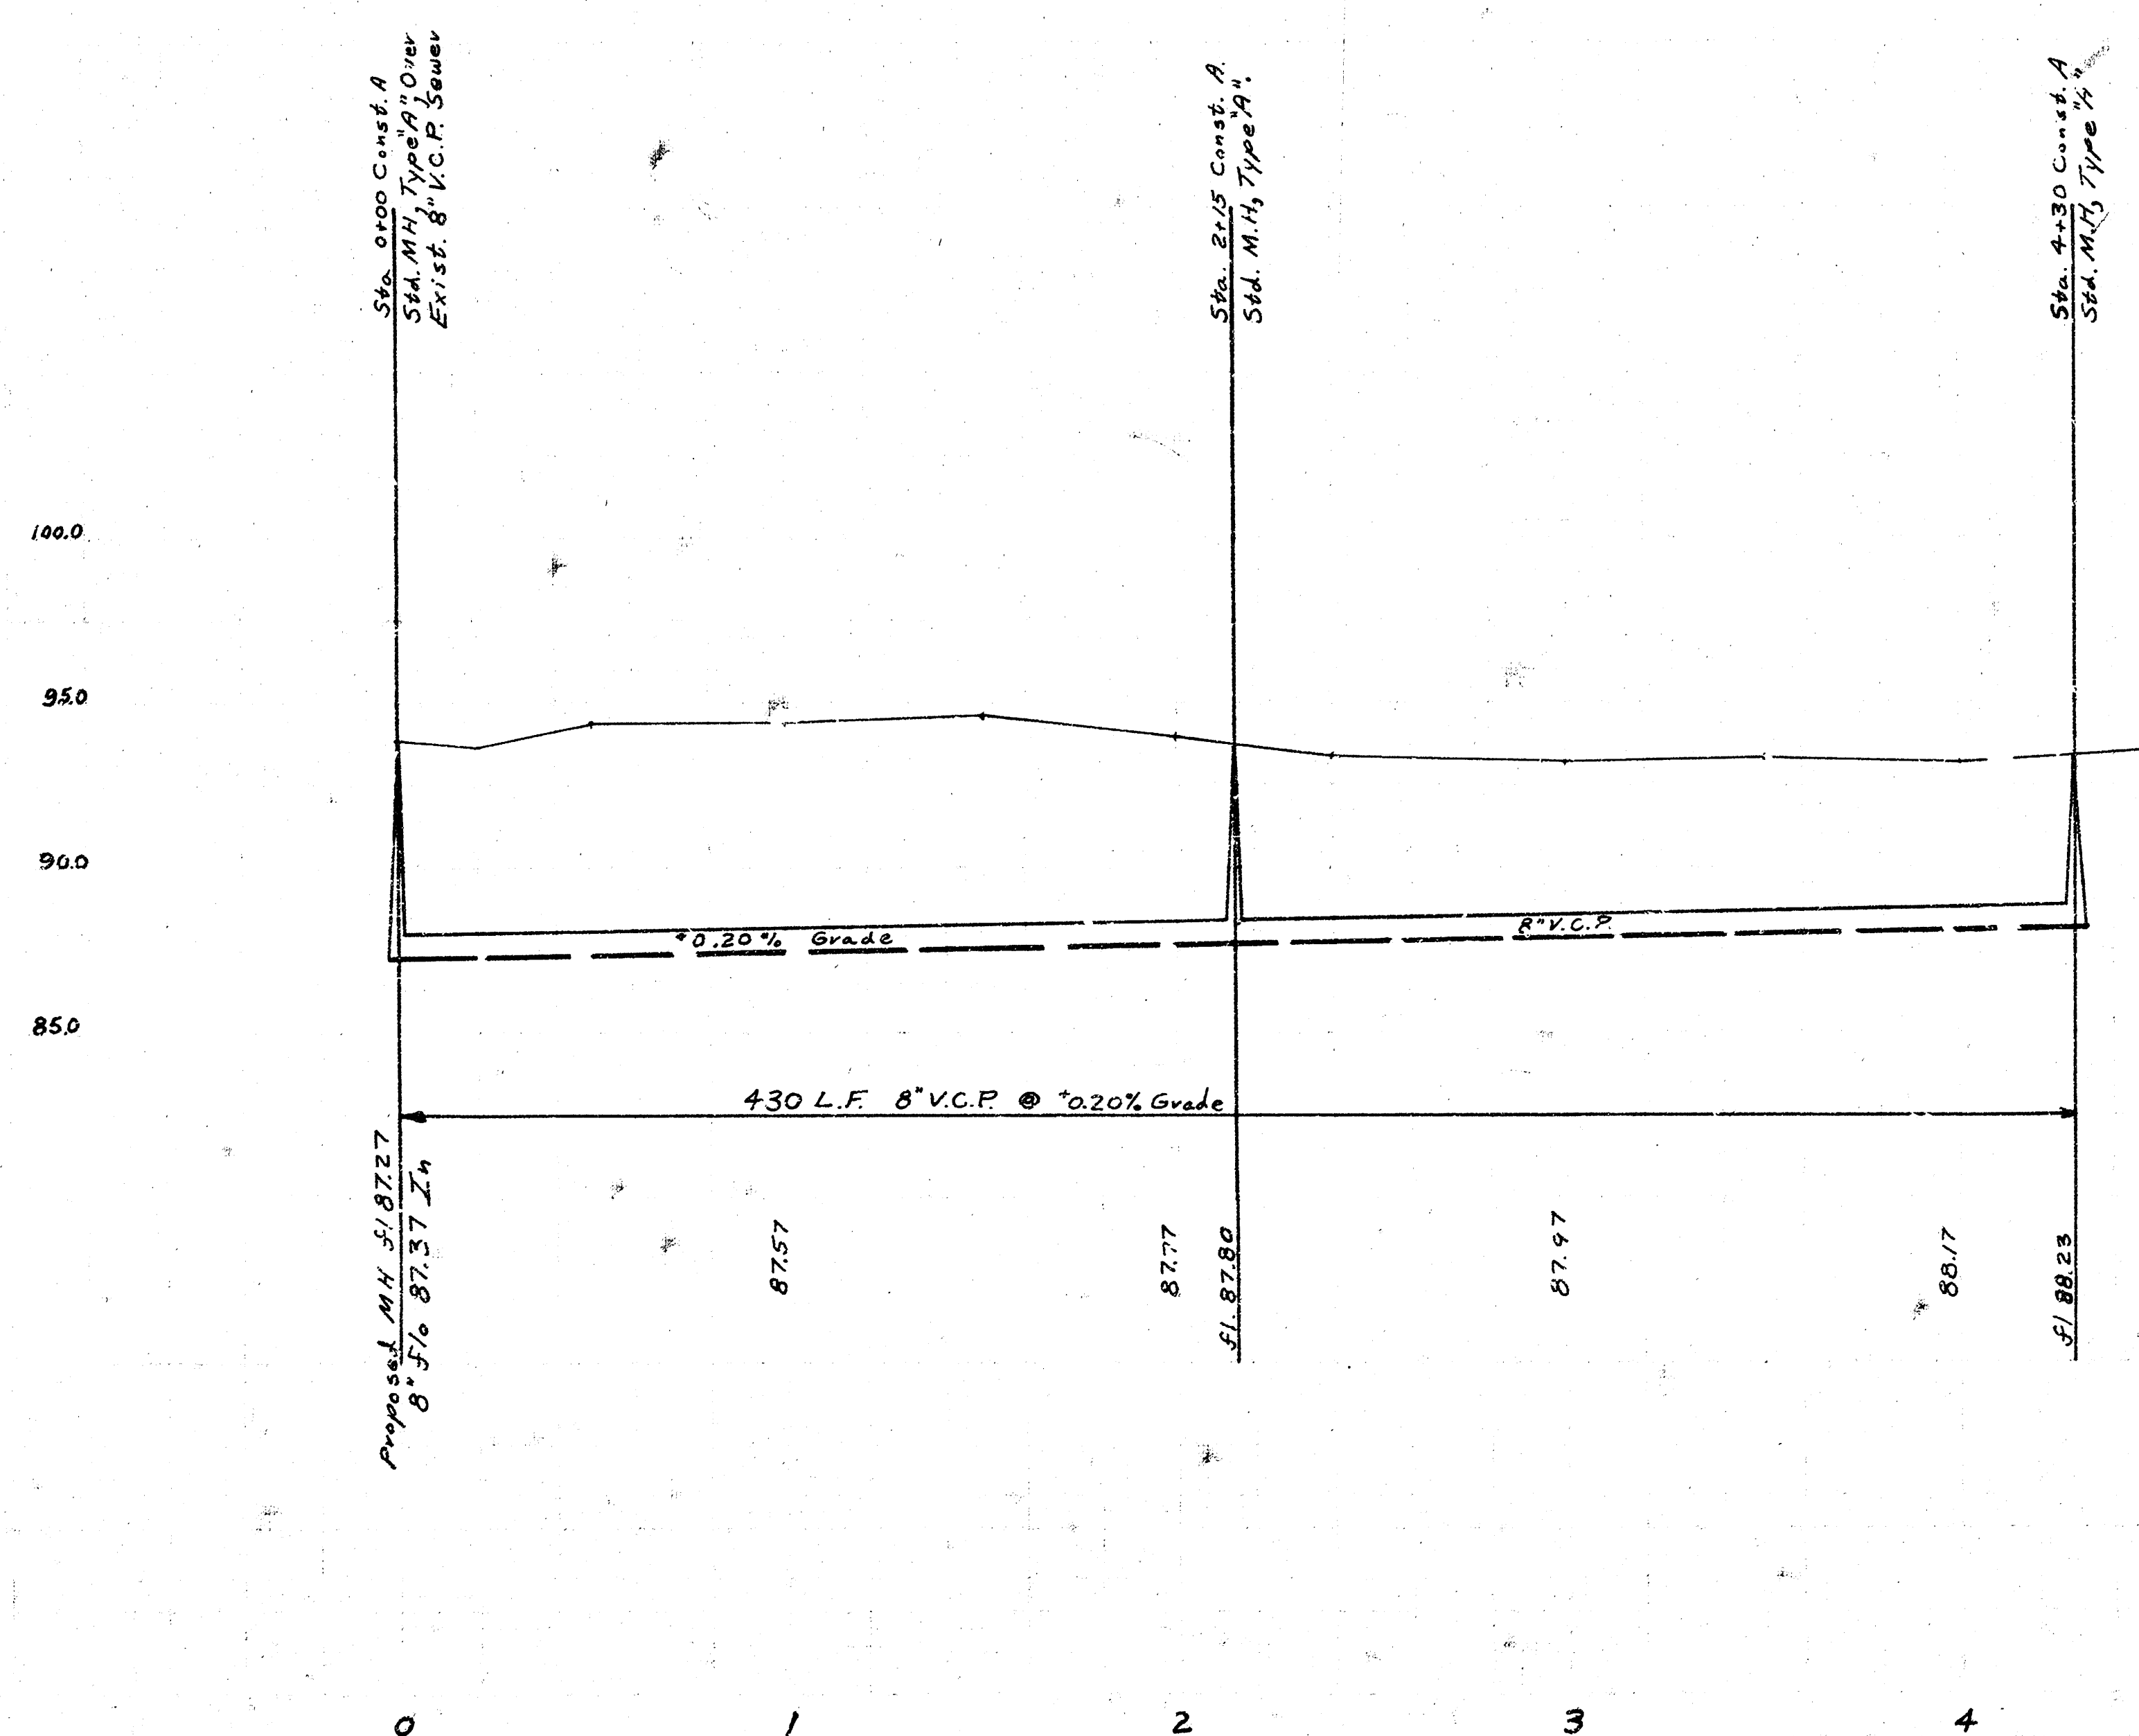

"As Built" Final Measmt. SS JK # 9

LAT. 122 S.S. NO. 22
CITY OF WICHITA, KANSAS
R.W. LINN CITY ENGINEER
DATE: JULY 1973
SHEET: 1 OF 1
PROJECT NO. DBKL 573031

(13) Eng.
-water