

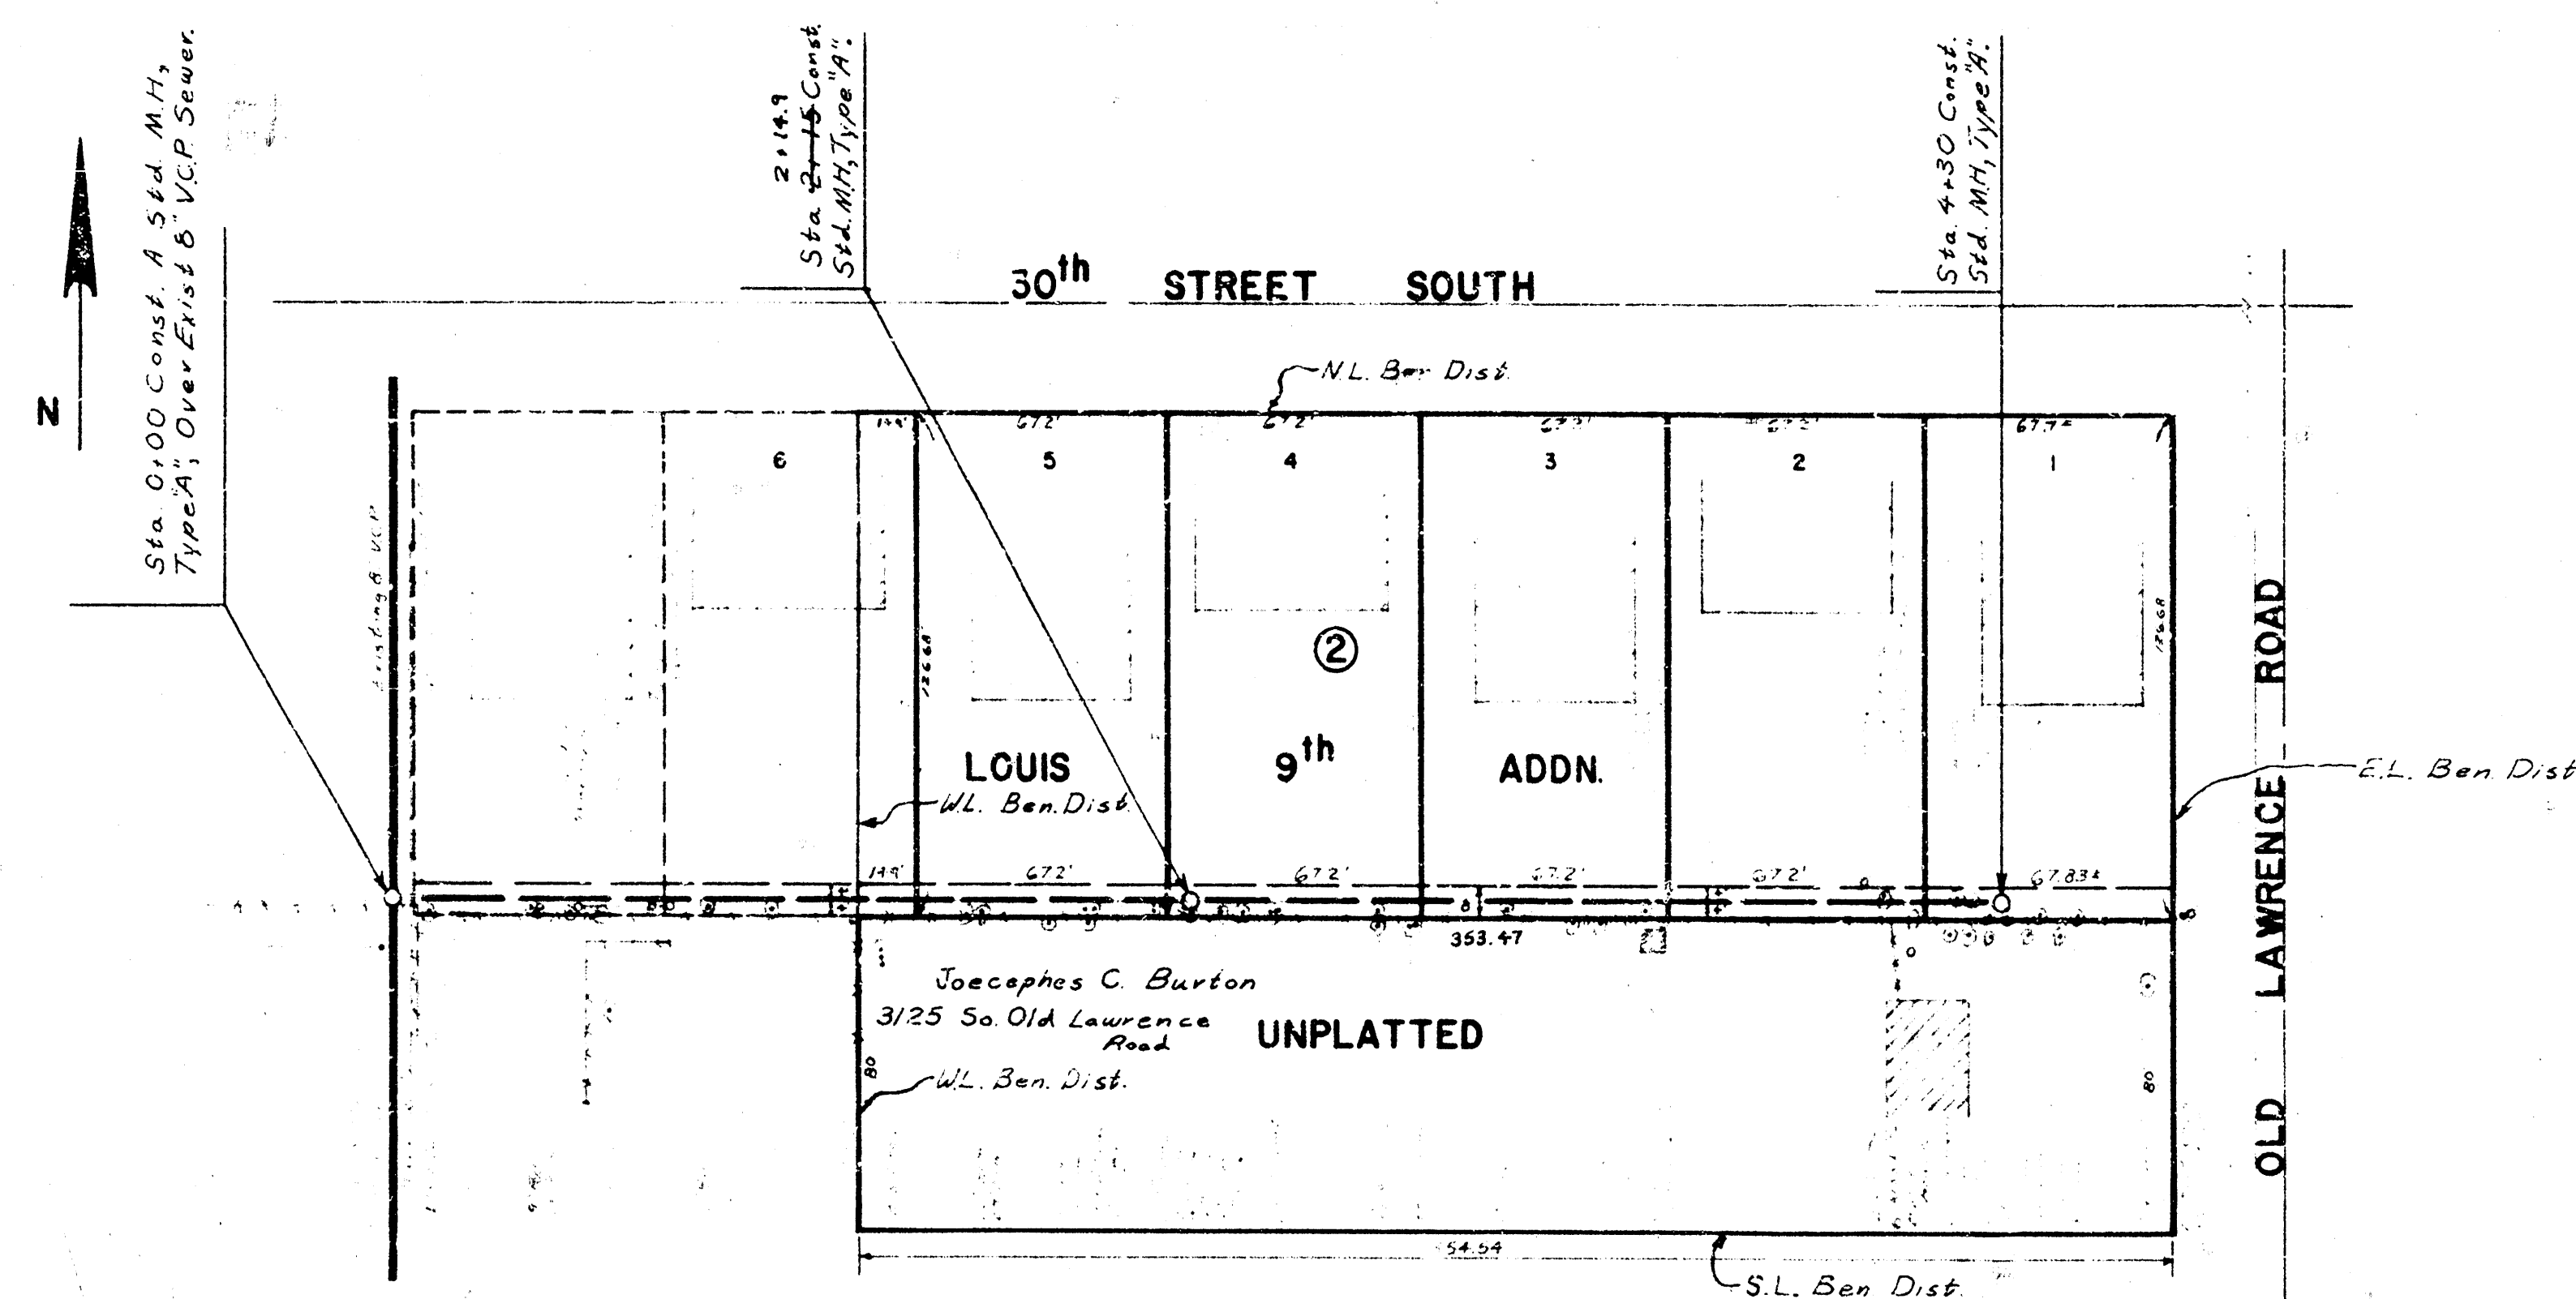


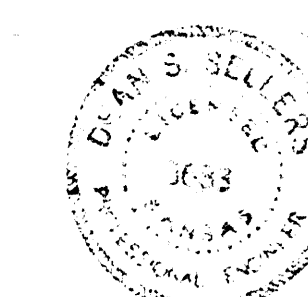

BM #1 96.70 W. Cor. 14" Concrete Step, 210 W. 30th Street South.

Plan Scale: 1" = 40'
Profile Scale: Horizontal 1" = 40'
Vertical 1" = 5'

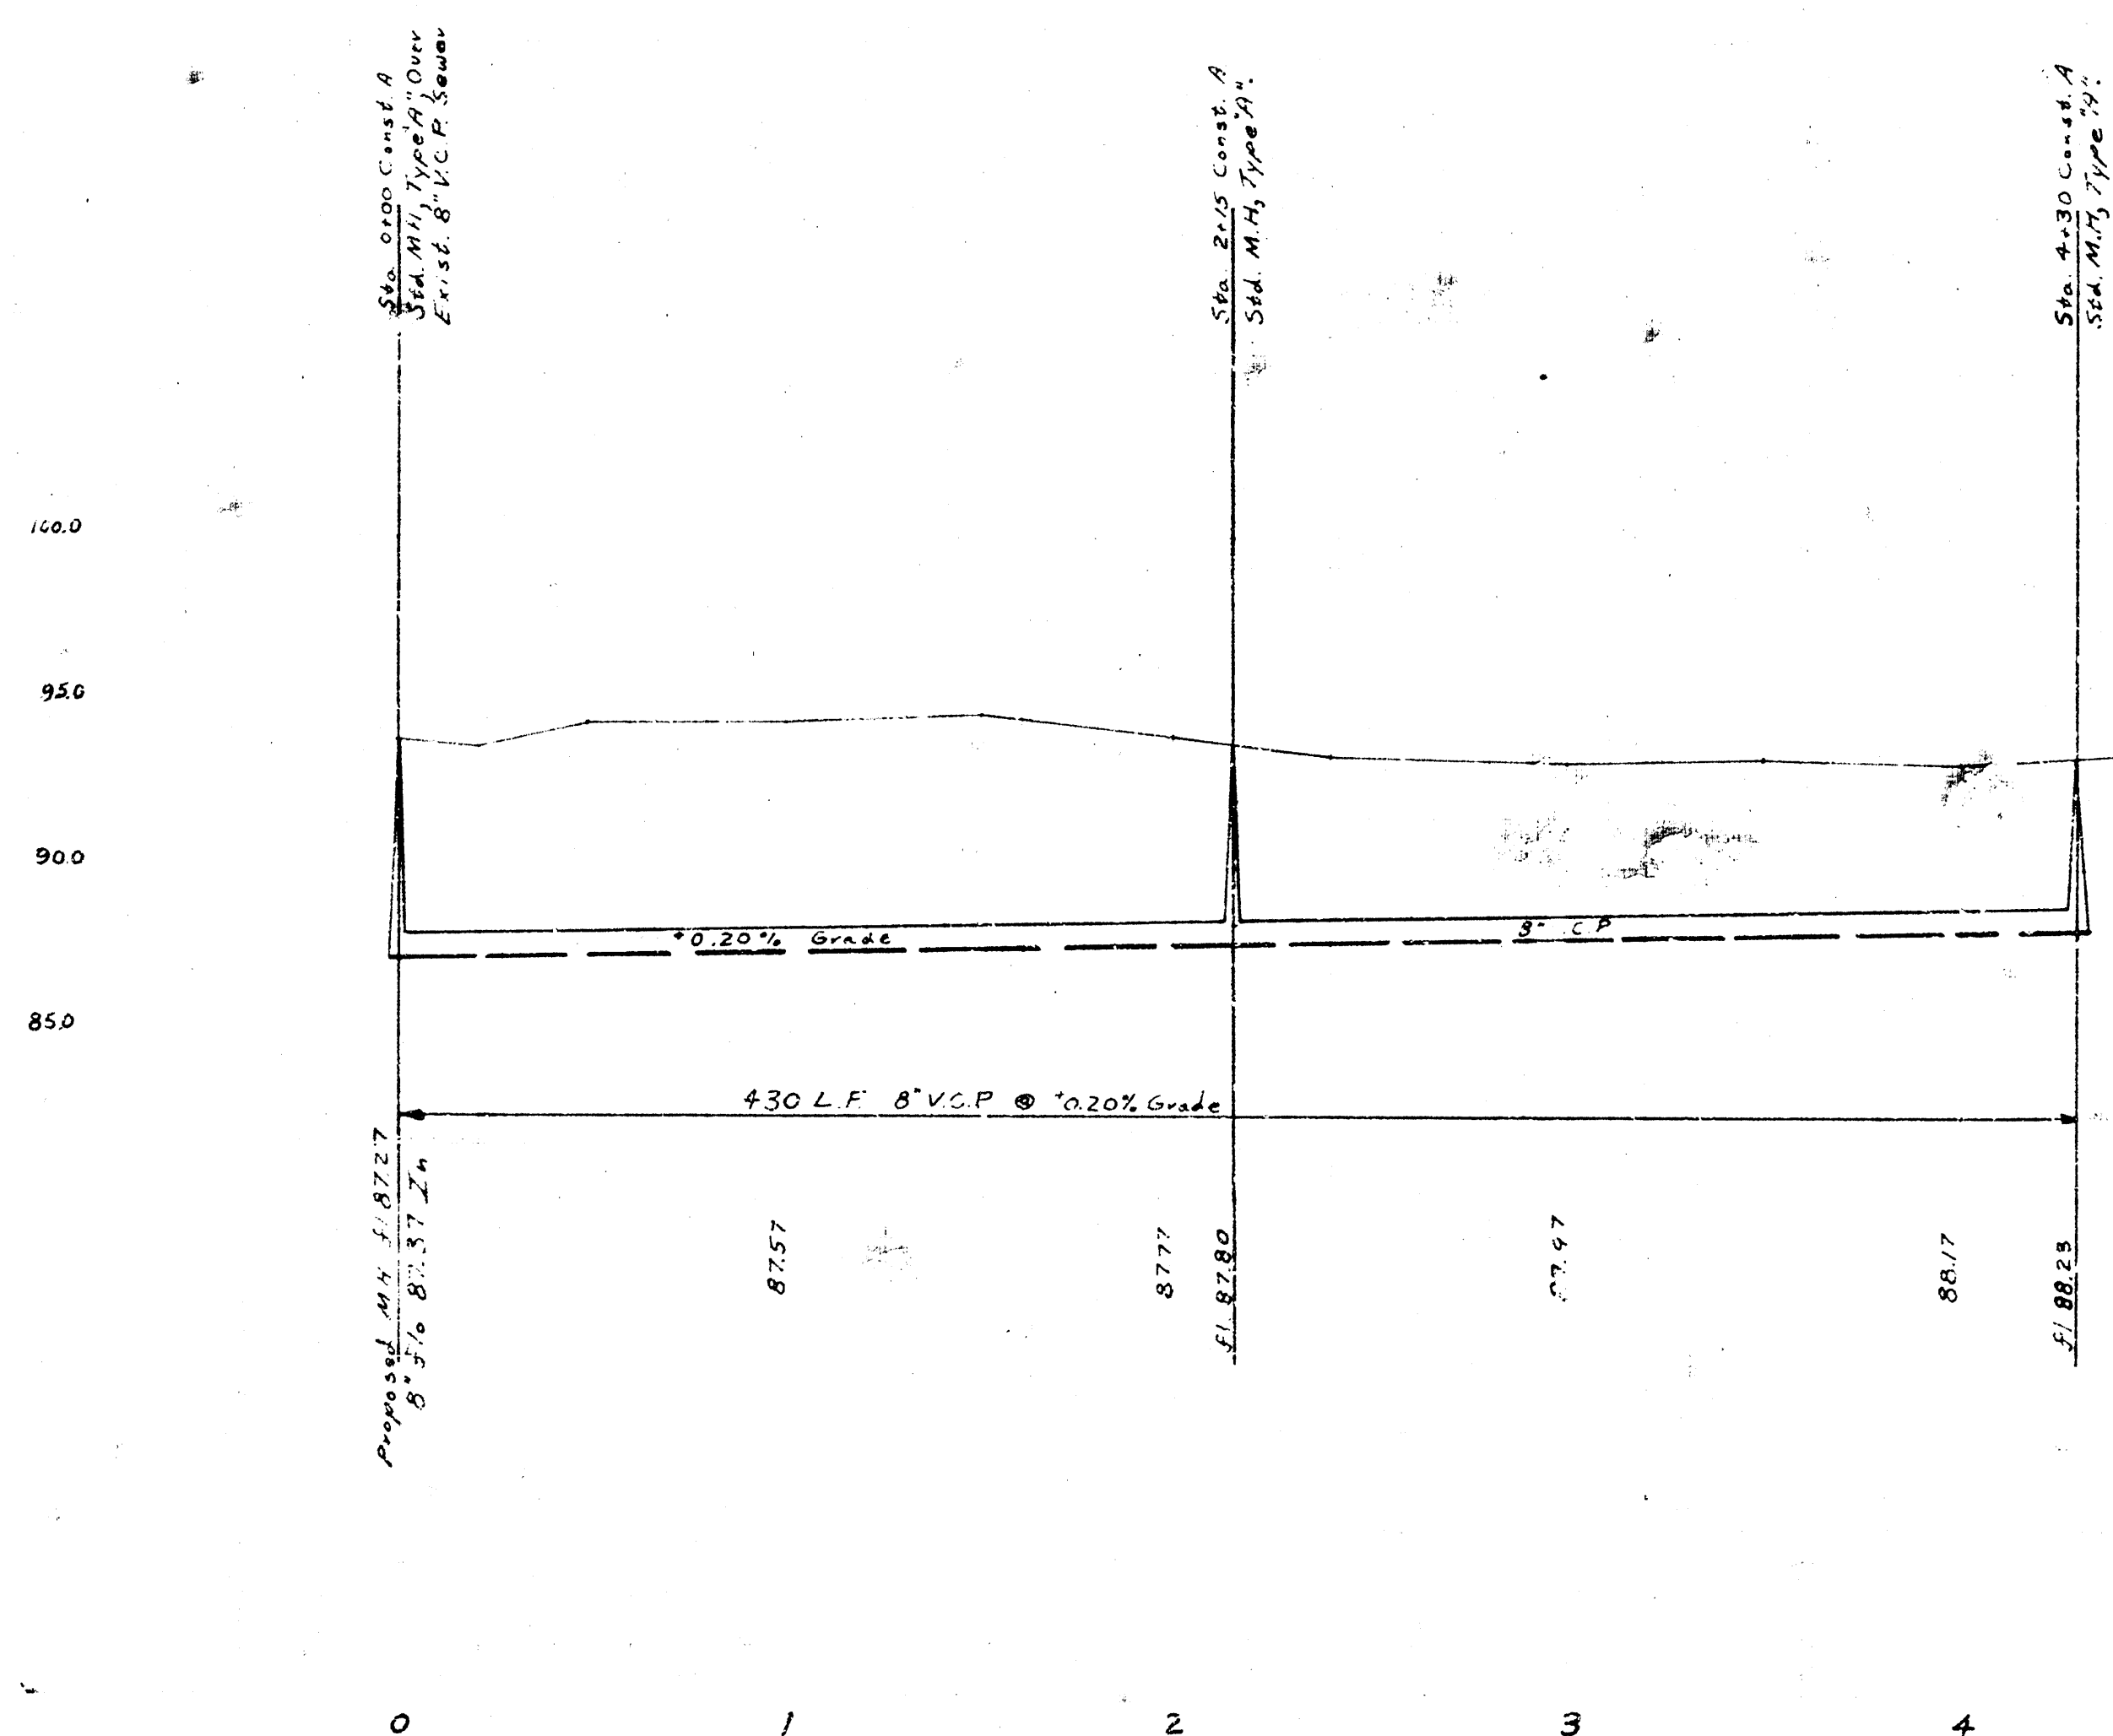

As Built Final Measmt. SS JK #9

LAT. 122	S.S. NO. 22
CITY OF WICHITA, KANSAS	
R.W. LINN CITY ENGINEER	
DATE: JULY 1973	
SHEET: 1 OF 1	
PROJECT NO. DBKL 573031	