



B. M. 115.54 "M" in Mueller F. P.
S.E. West & McCormick
B. M. 113.25 S.W. cor. wk S.E.
Kessler & McCormick.

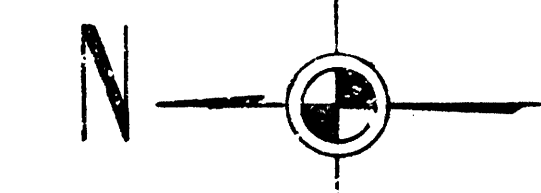

Plan Scale 1" = 40'
Profile Scale 1" = 5' Vert.

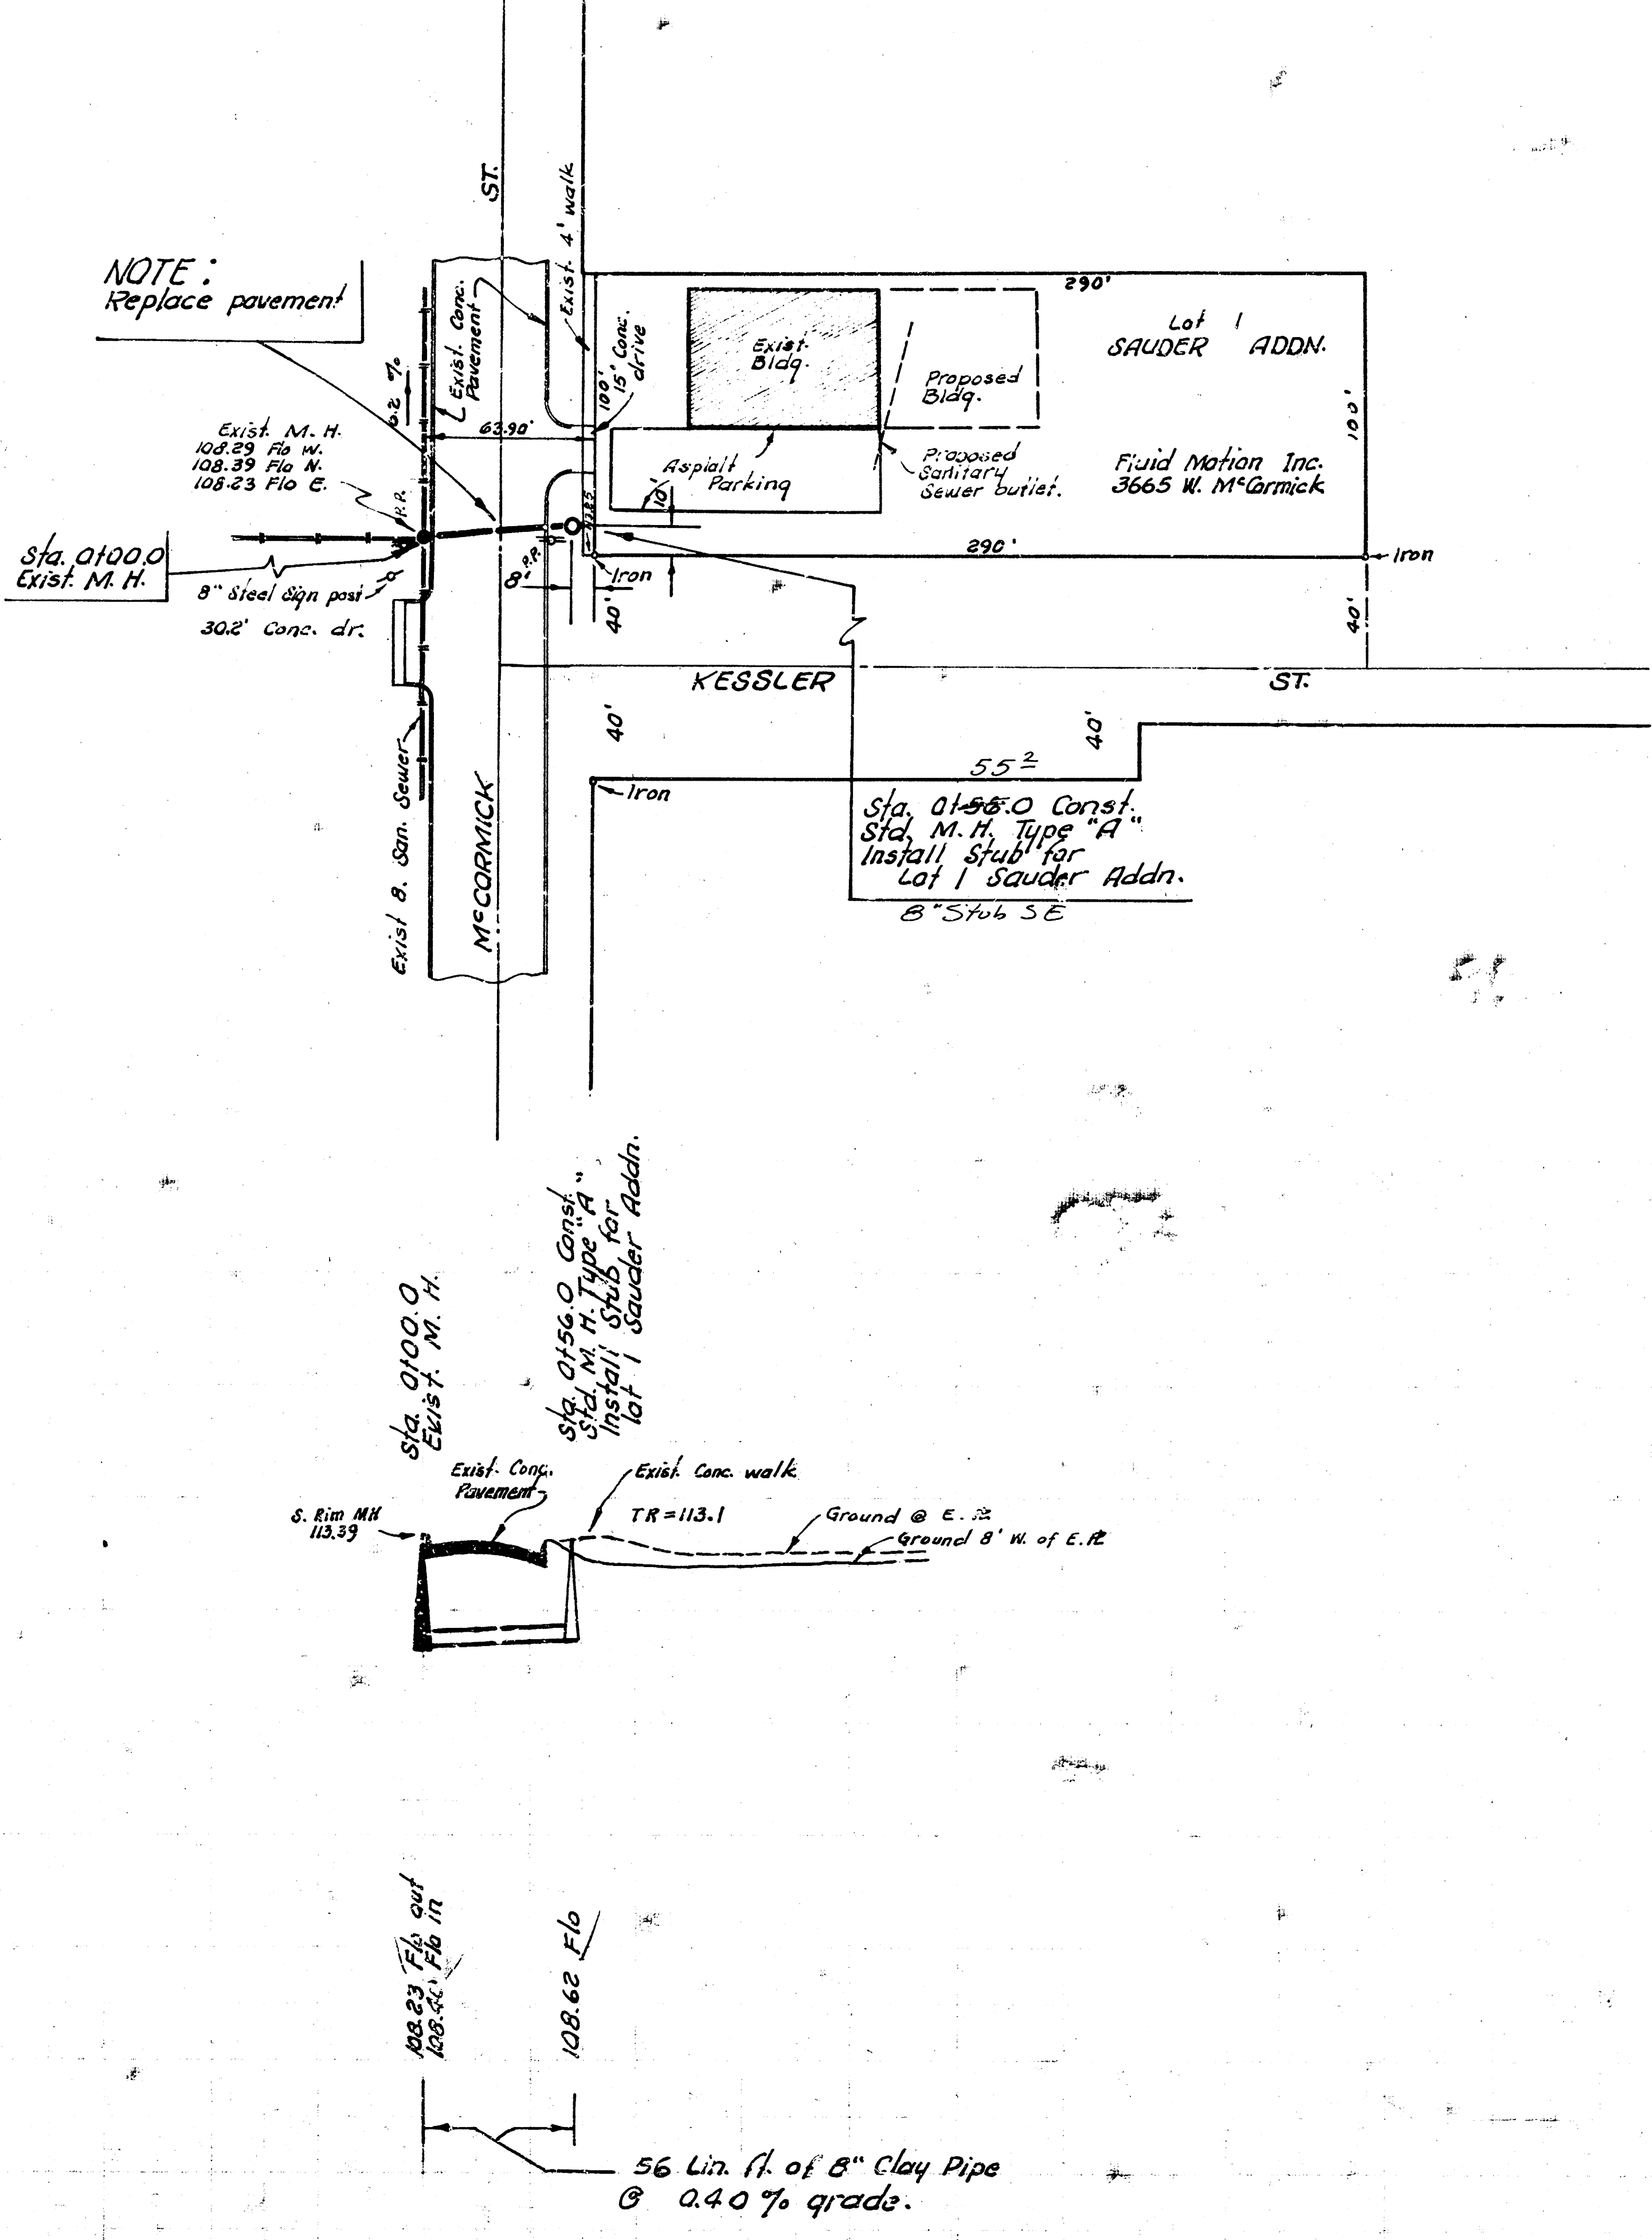

As Built Final Meas SS JK #6
LAT. 125, S. S. NO. 22
CITY OF WICHITA, KANSAS
R. W. LINN — CITY ENGINEER
MAR. 1974 PROJECT NO. DBKL574004