

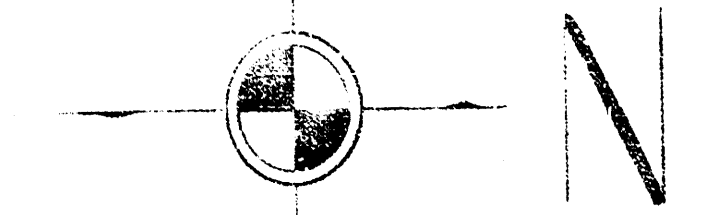


B.M. 100²⁶ 17" Top Curb - South Return S.W. Cor. Wildwood & St Paul
 B.M. 99²⁶ Spike West-face Power Pole S.E. Cor. Wildwood & Edwards
 B.M. 99²⁷ City Std. Dec. 6' N & 2' E. of S.E. 1/4 Cor. Sheridan & 31st St South

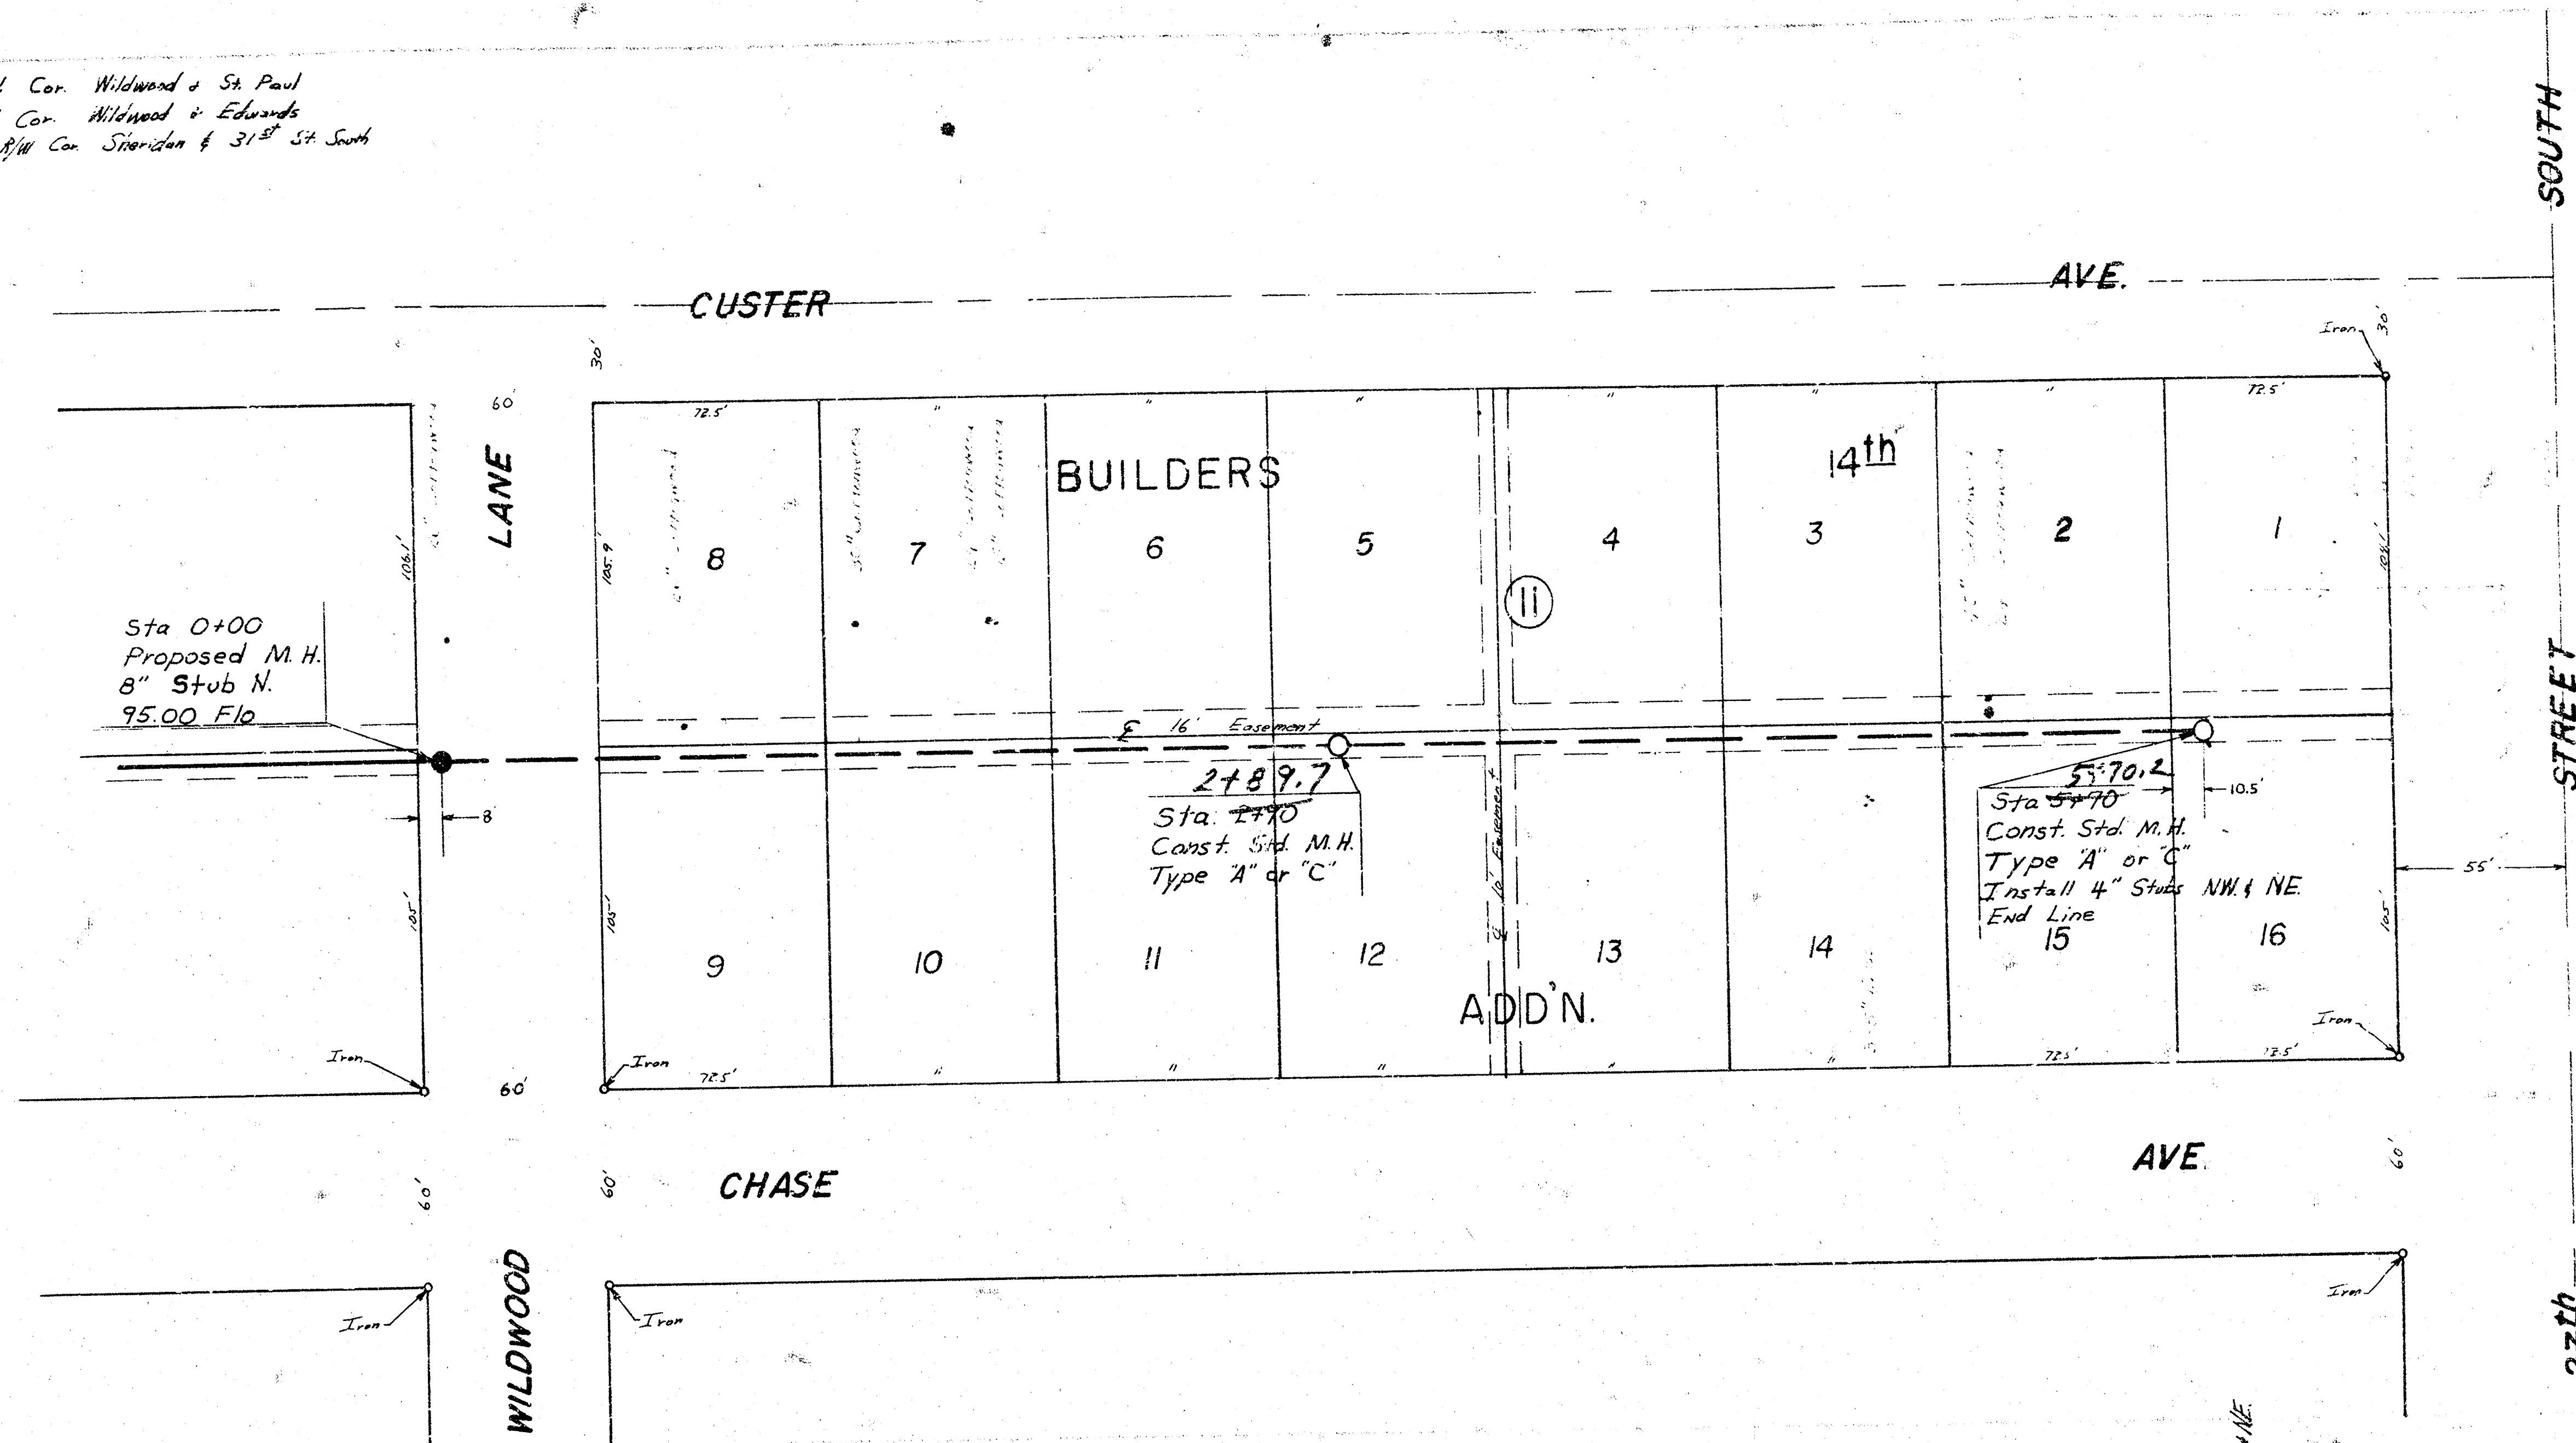

Plan Scale 1" = 40'
 Profile Scale 1" = 40' Horiz.
 1" = 5' Vert.

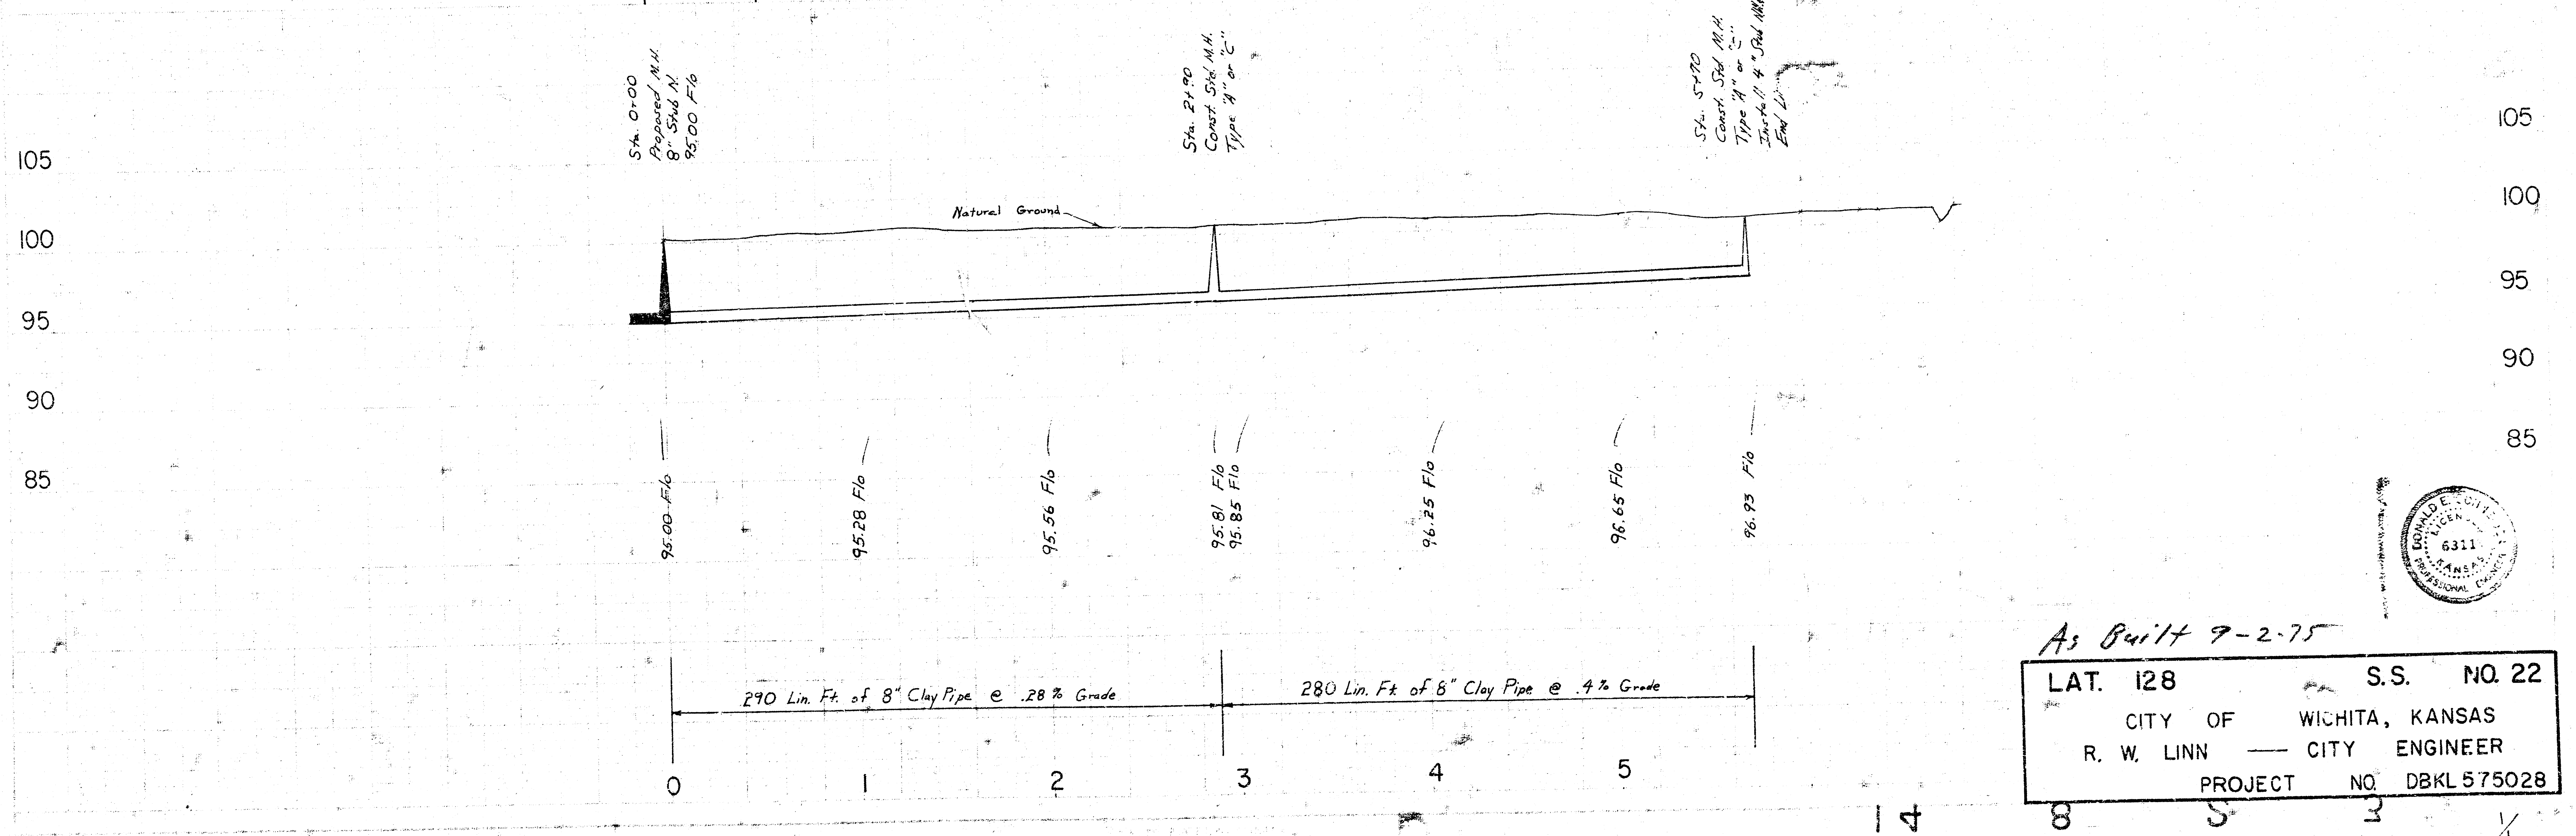

As Built 7-2-75
 LAT. 128 S.S. NO. 22
 CITY OF WICHITA, KANSAS
 R. W. LINN — CITY ENGINEER
 PROJECT NO. DBKL 575028

