

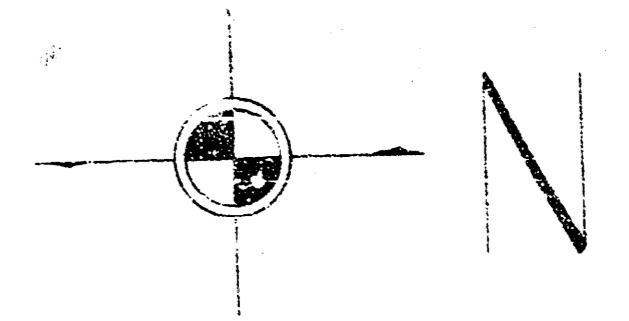
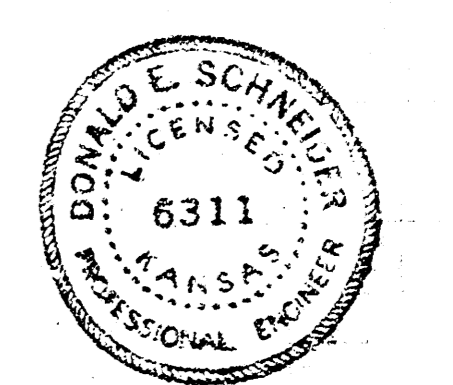


B.M. 100 7th "D" Top Curb South Return SW Corner Wildwood + St. Paul
 B.M. 99 8th "A" Top Curb South Return S.E. Corner Sunnybrook + St. Paul
 B.M. 99 9th City Std. Disc 6' N + 2' of S.E. R/W, Corner of Sheridan + 31st St. South

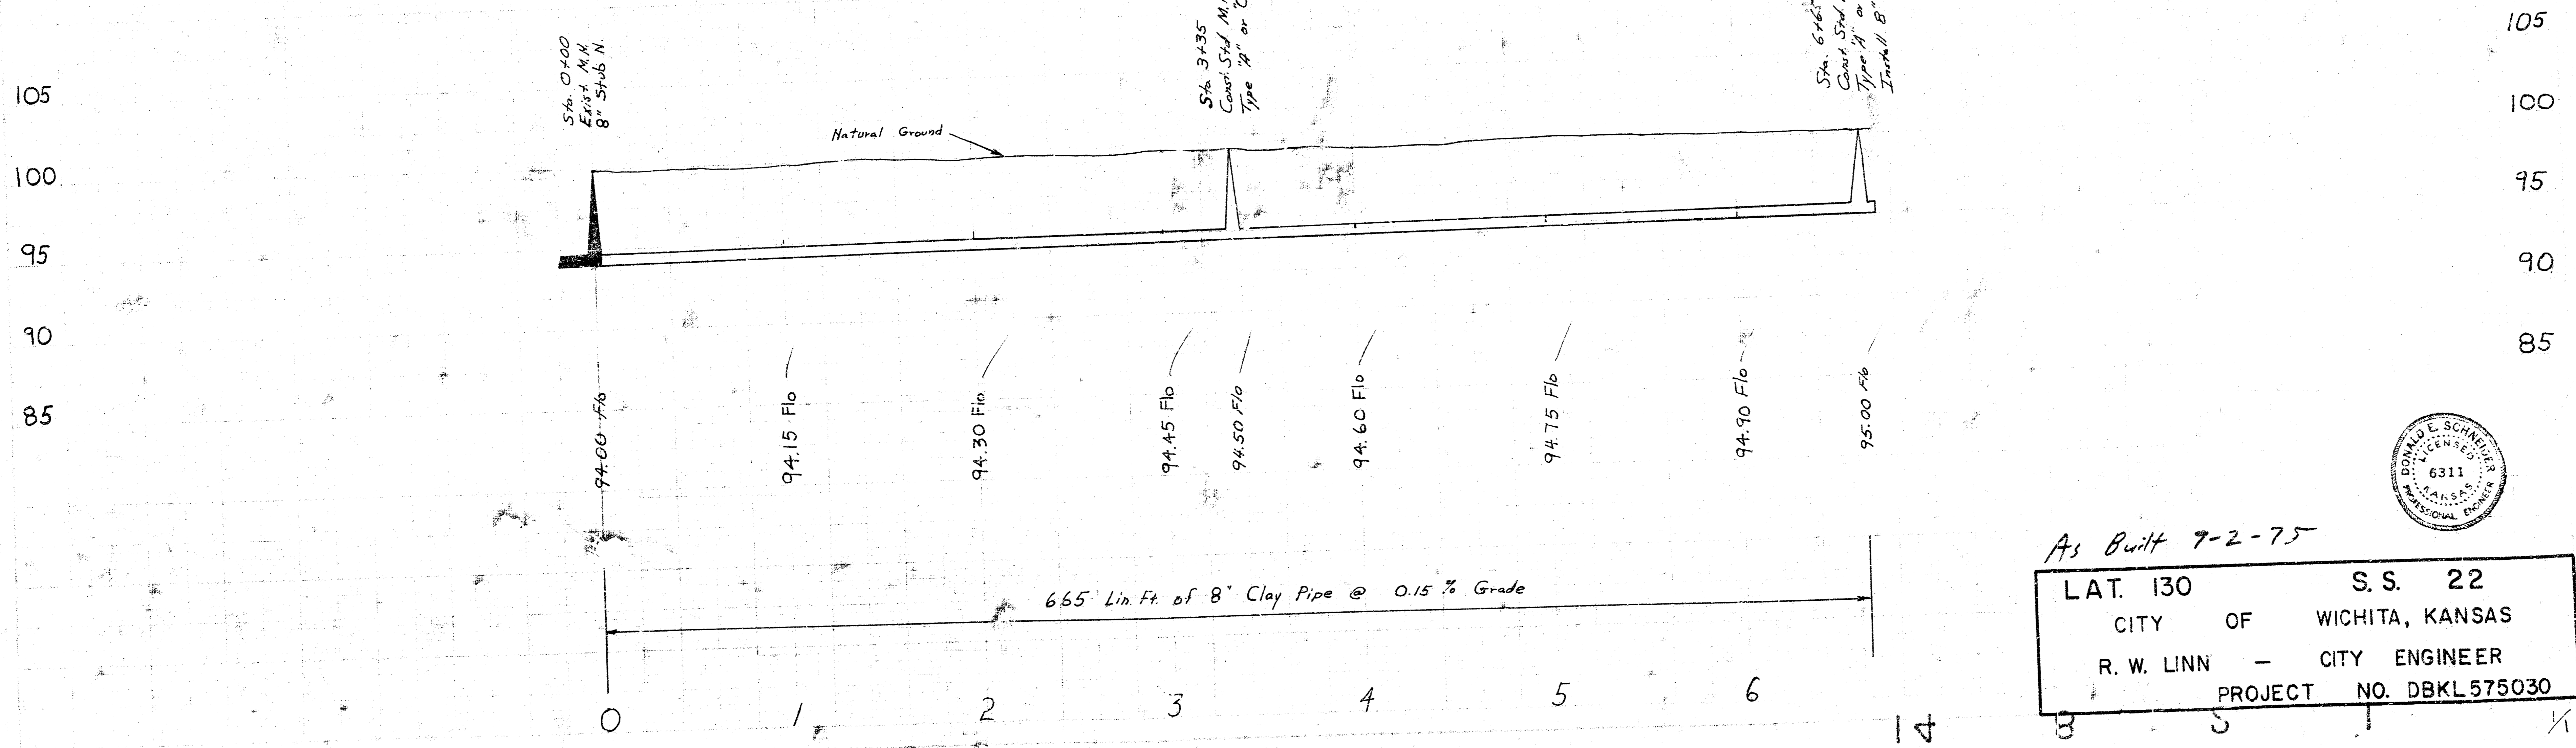

Plan Scale 1" = 40'
 Profile Scale 1" = 40' Horiz.
 1" = 5' Vert

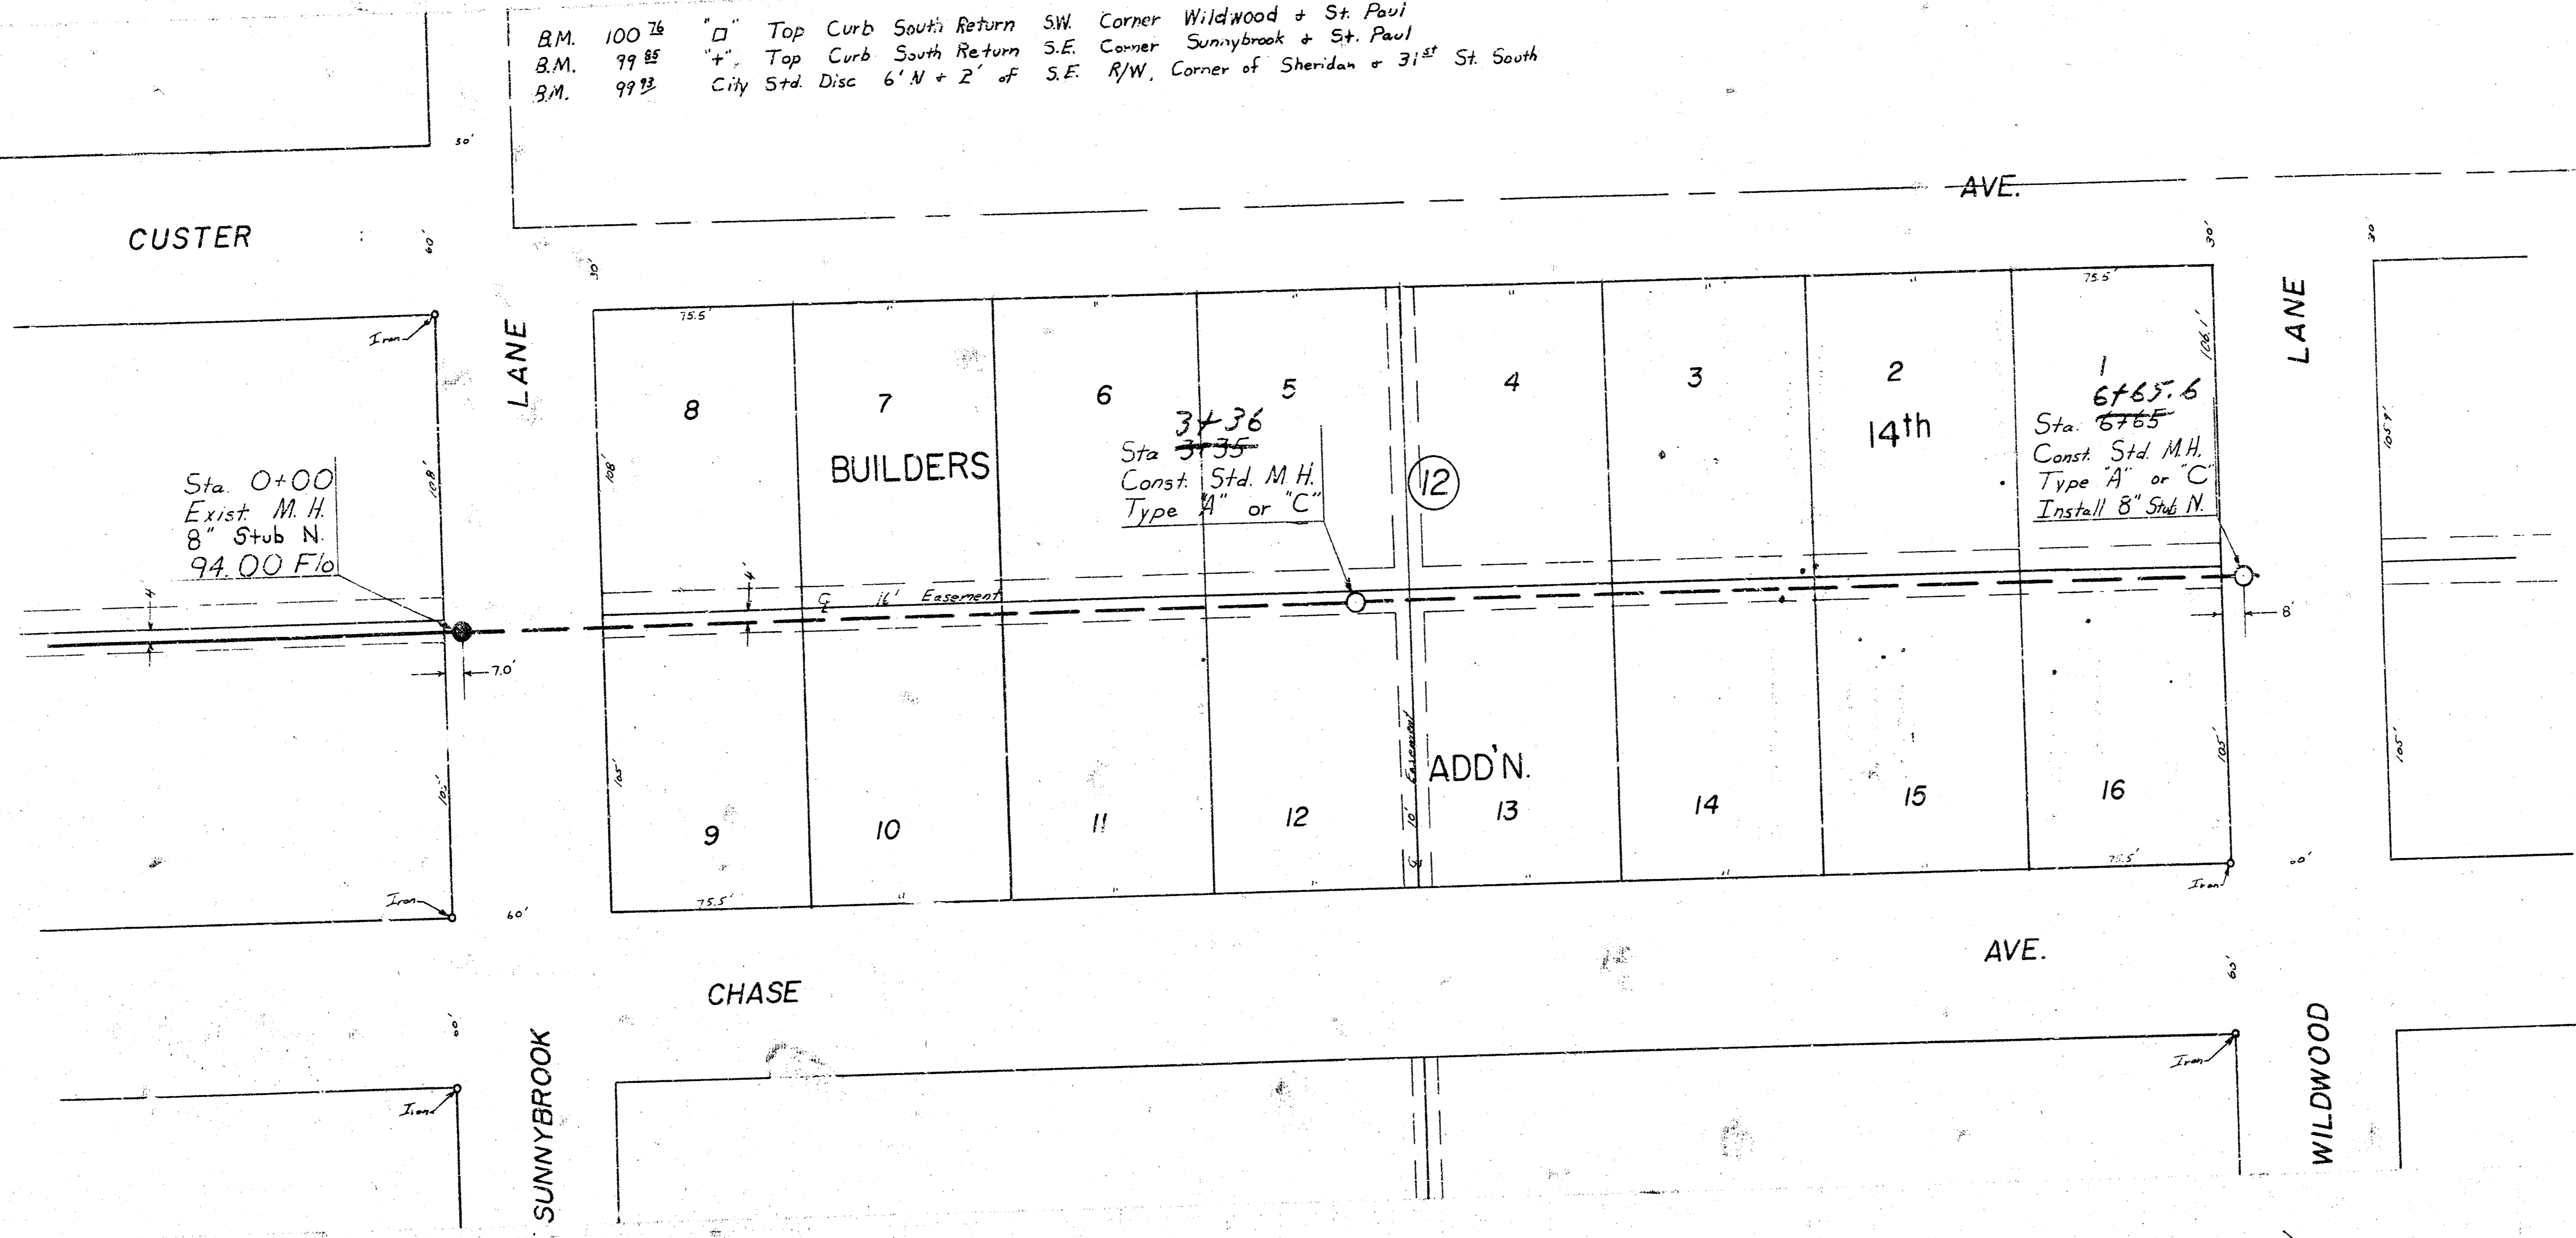

As Built 7-2-75

LAT. 130	S.S. 22
CITY OF WICHITA, KANSAS	
R. W. LINN	CITY ENGINEER
PROJECT NO. DBKL575030	