


B.M. 103.52 City B.M. Disc Top East End
South Handrail RCBC. Sheridan & 31st


B.M. 99.93 City Std. Disc. 6' N. & 2' E. of
SE R/W Corner of Sheridan & 31st

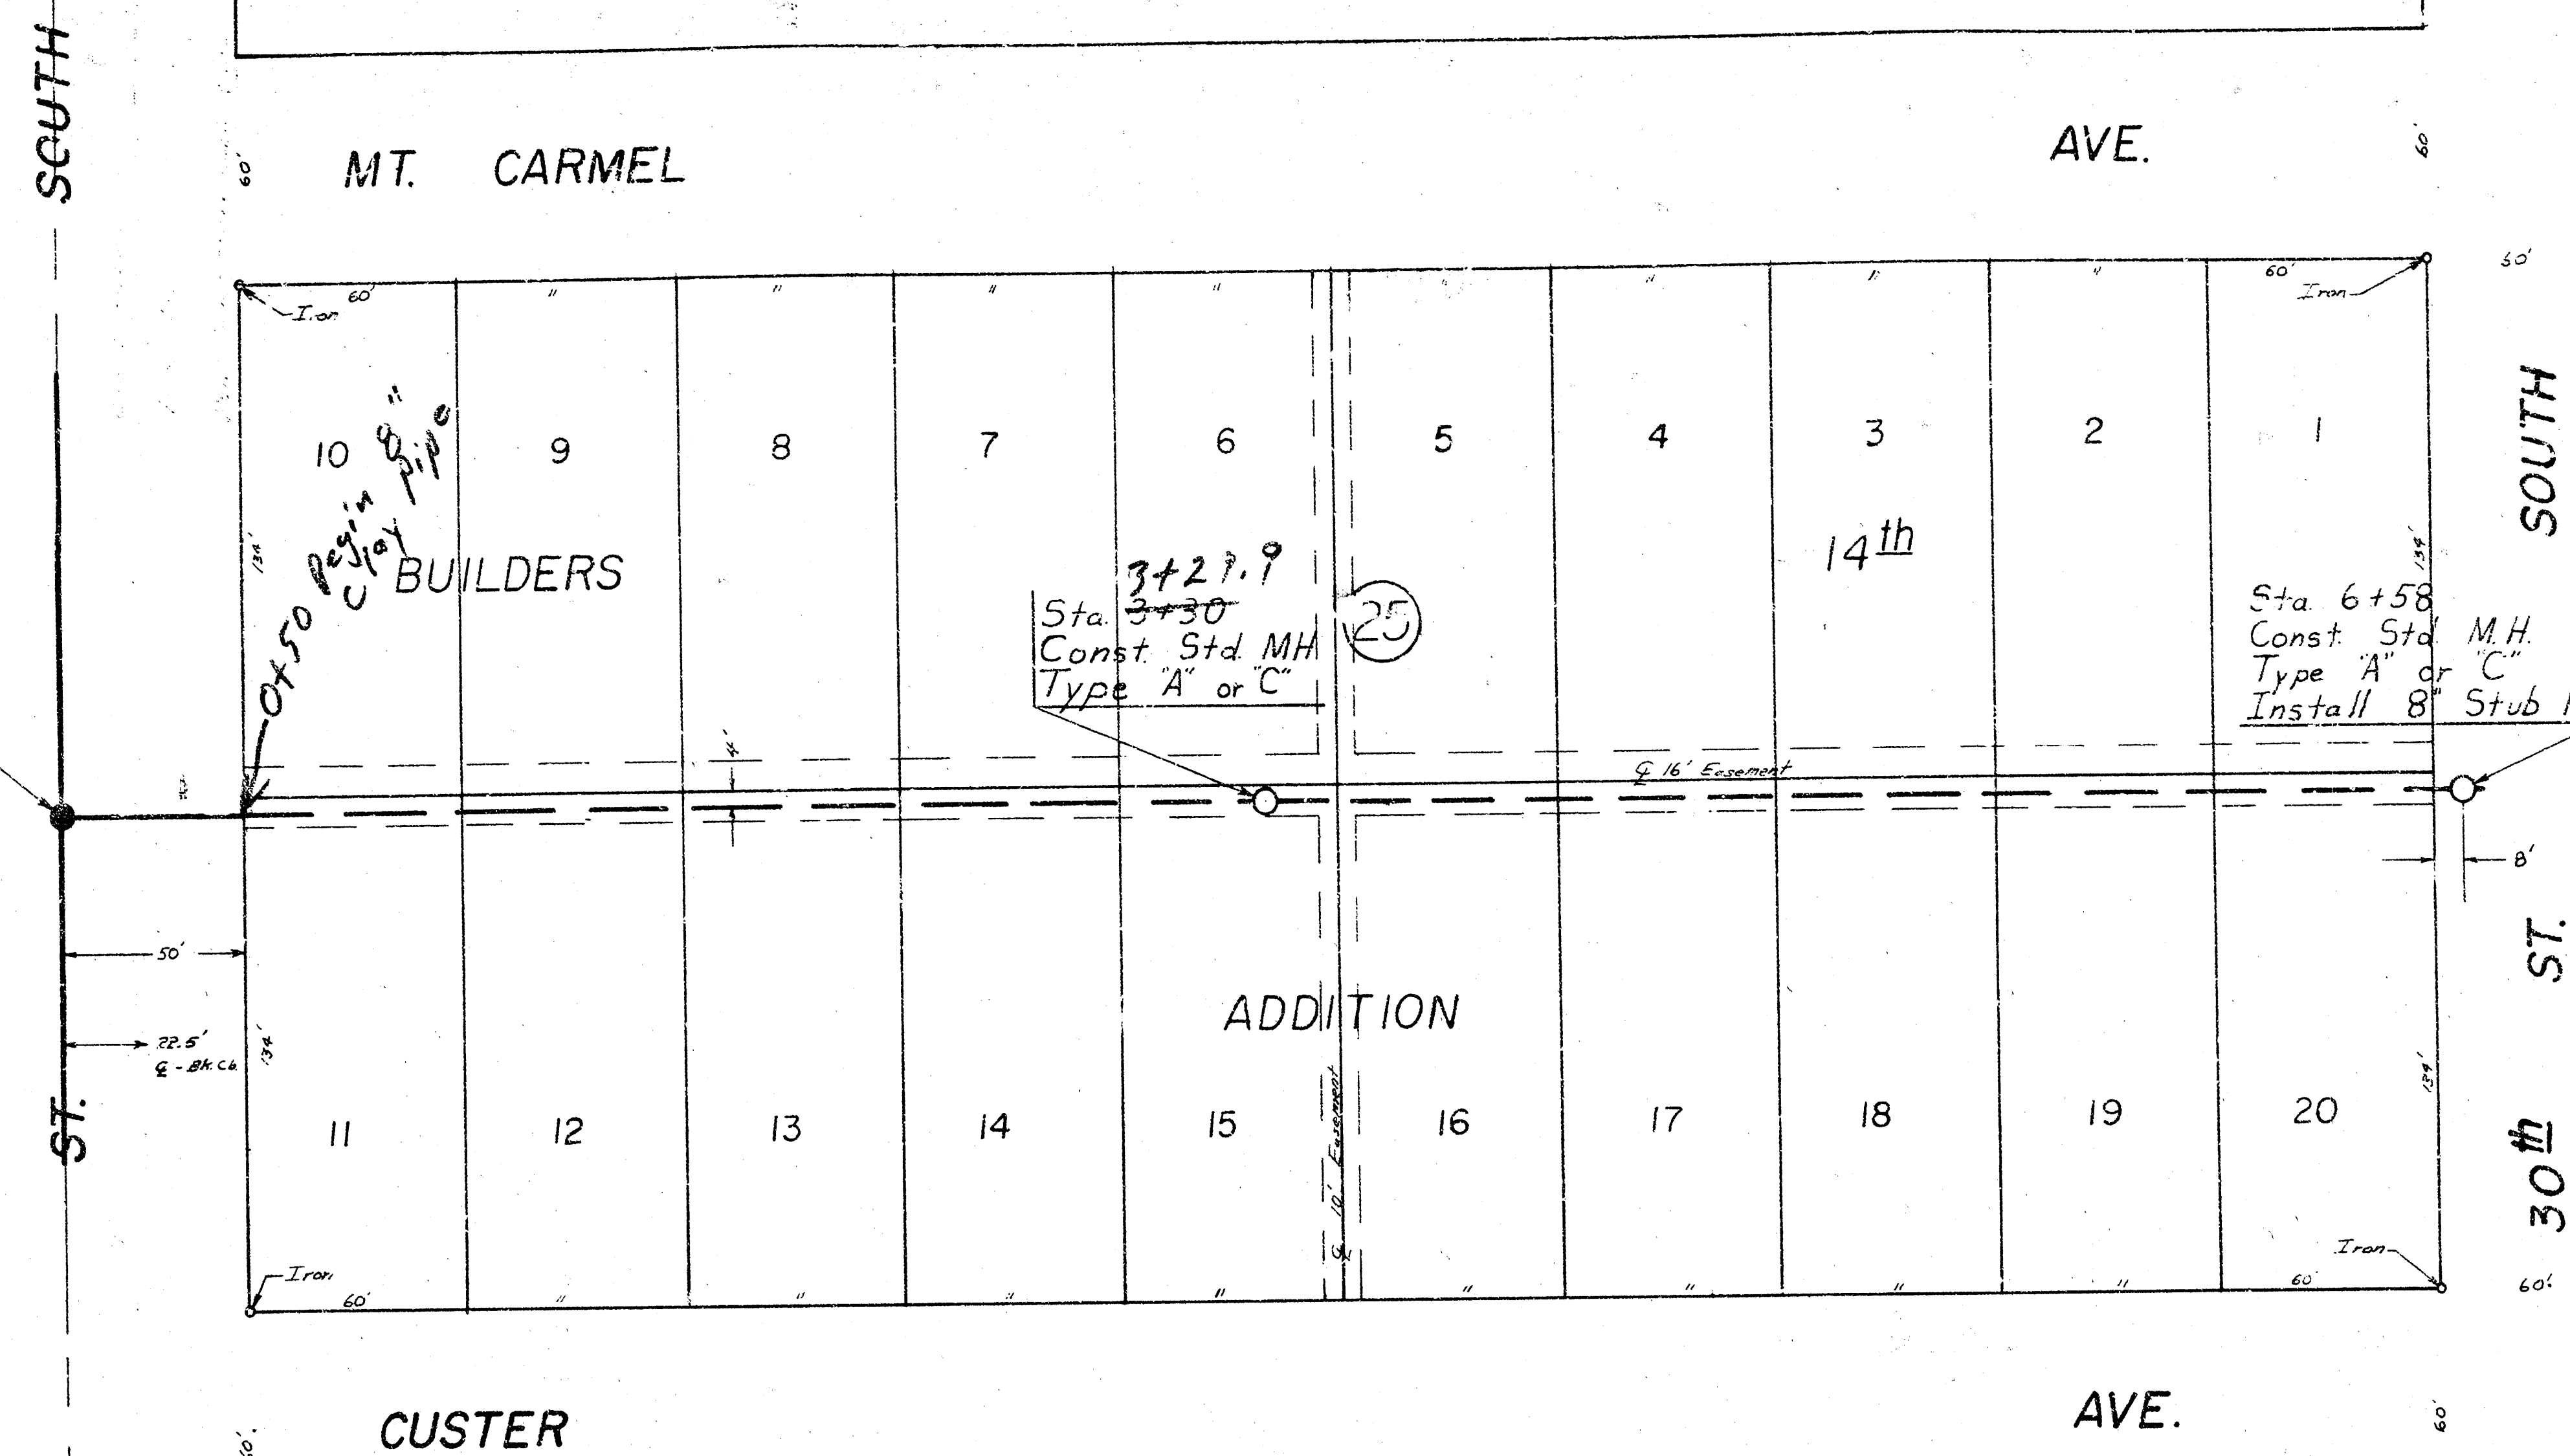

Plan Scale 1" = 40'

Profile Scale 1" = 40' Horz.
1" = 5' Vert.

105
100
95
90
85

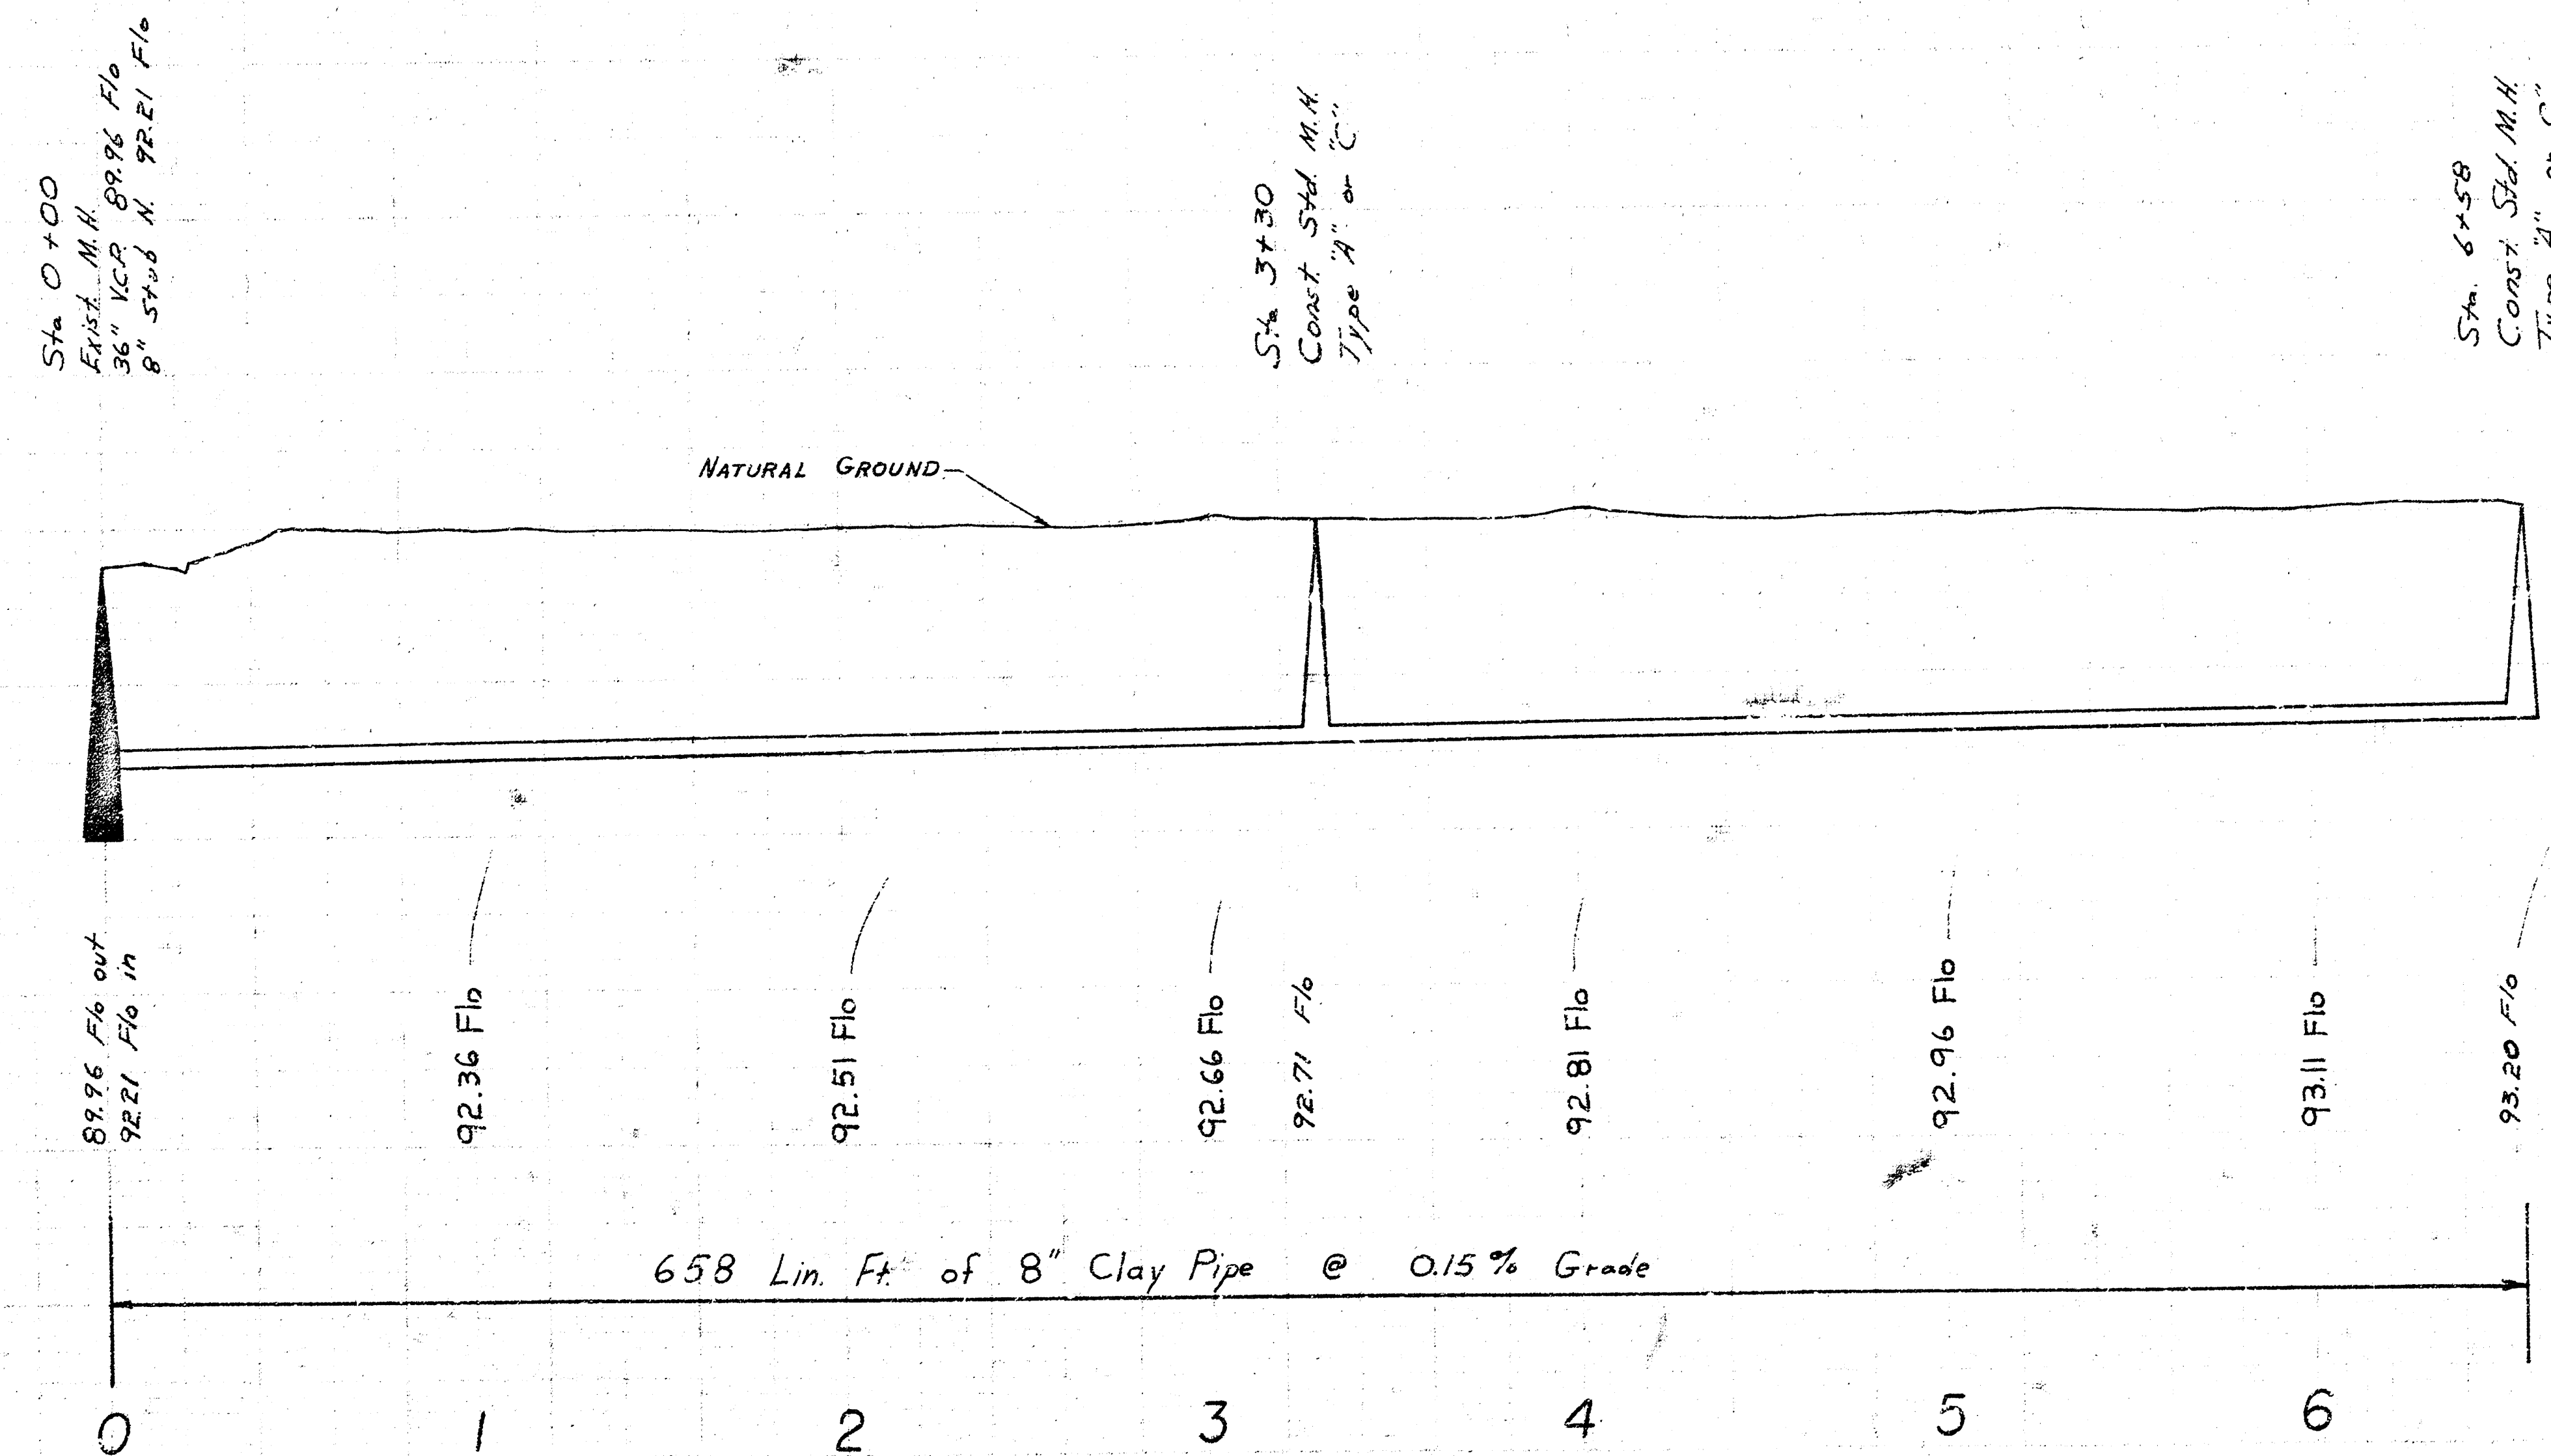

As built 8-29-75

LAT. 131 SS. NO. 22

CITY OF WICHITA, KANSAS

R. W. LINN — CITY ENGINEER

PROJECT NO. DBKL575031

