


SCALE
 Plan = 1" = 40'
 Profile: vertical = 1" = 5'
 horizontal = 1" = 40'

B.M. 129.63: N.W. cor. of concrete porch to house at 2614 Hyacinth
 B.M. 131.49: N.W. cor. of bottom step to House at 2700 Bullinger Drive

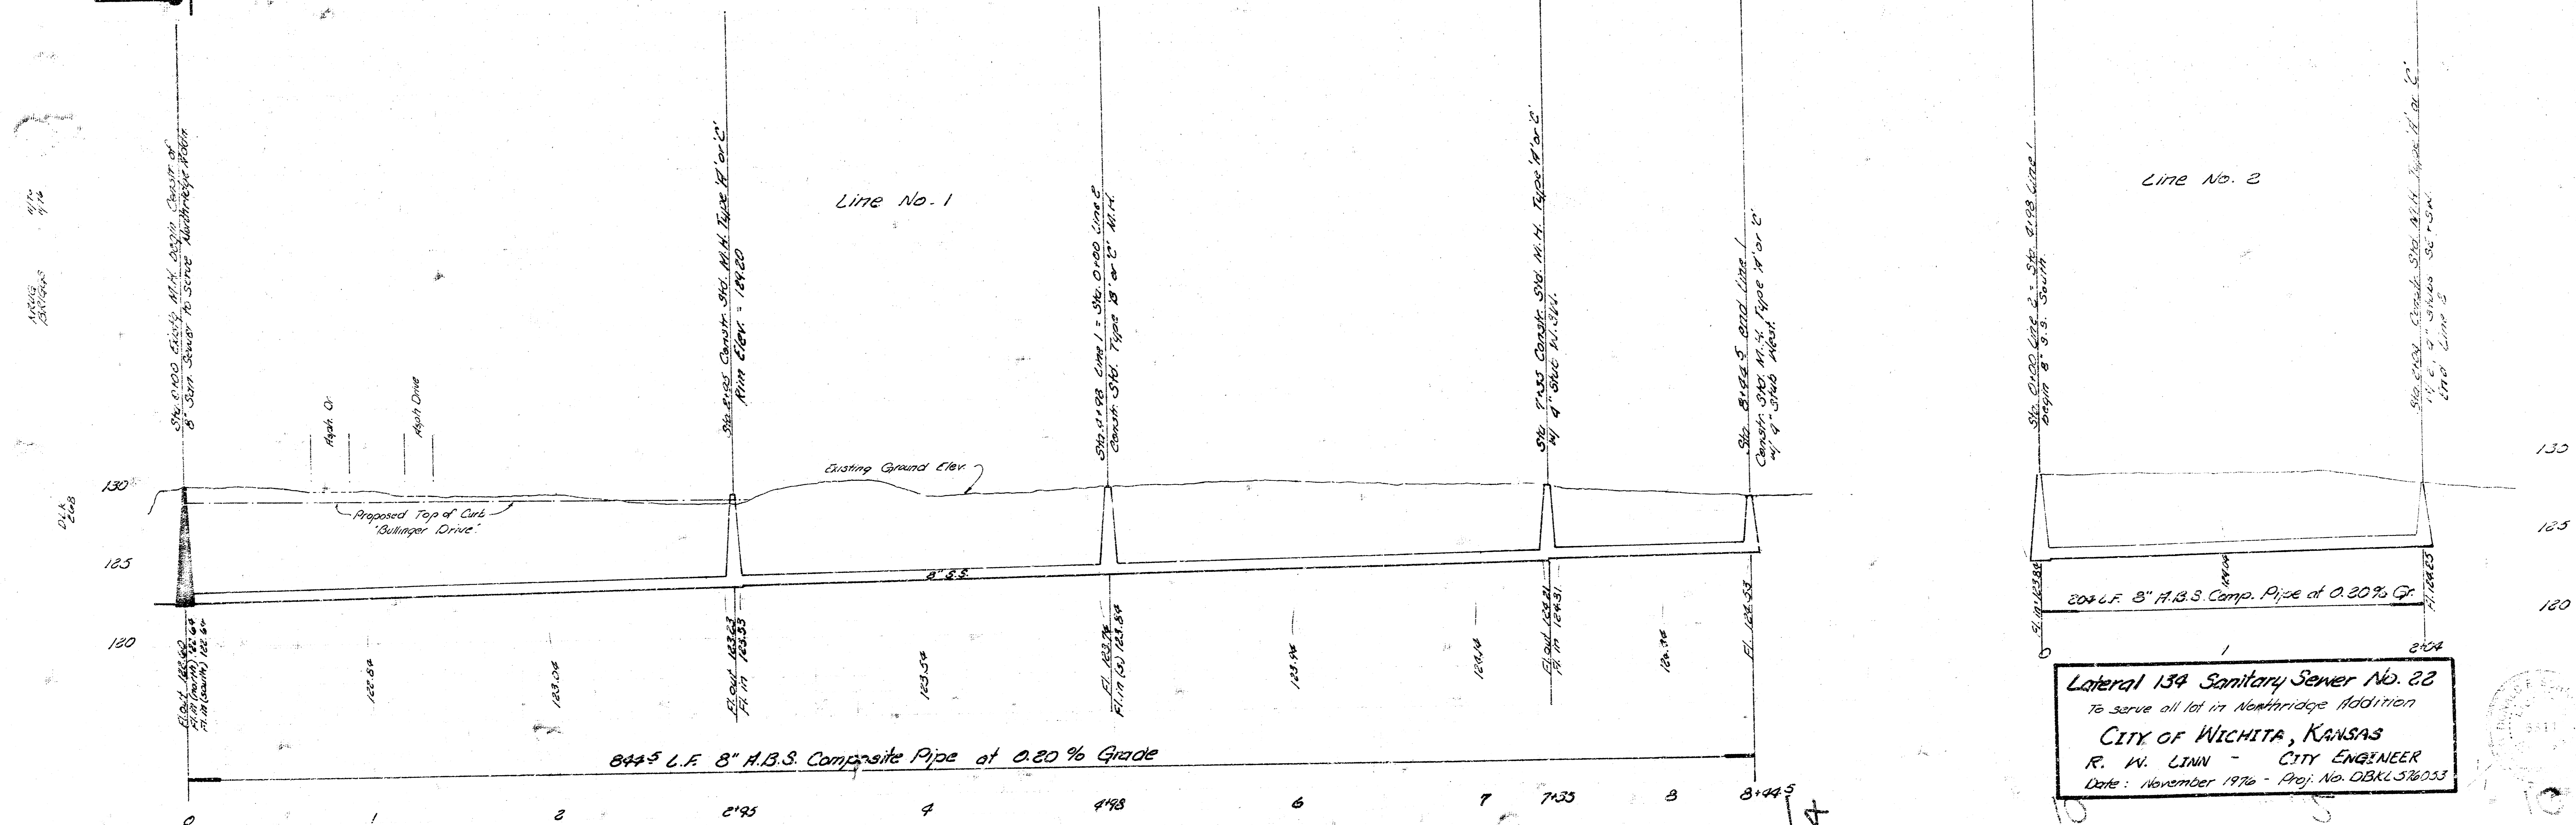

Lateral 134 Sanitary Sewer No. 22
 To serve all lot in Northridge Addition
 CITY OF WICHITA, KANSAS
 R. W. LINN - CITY ENGINEER
 Date: November 1976 - Proj. No. DBKL376033

As built 4-25-77