

PRIVATE SANITARY SEWER EXTENSION

TO SERVE

AIR CARGO FACILITY MID-CONTINENT AIRPORT

PRIVATE PROJECT NO. 1804 PPS (607861)


CITY OF WICHITA, KANSAS

JAMES L. ARMOUR, P.E. - CITY ENGINEER

Released 6/12/08
JDL 6/17/08

INDEX OF SHEETS

SHEET NO. C301	TITLE SHEET
SHEET NO. C302	KEY MAP AND GENERAL NOTES
SHEET NO. C303	PLAN/PROFILE
SHEET NO. C304	TYPE "P" MANHOLE DETAILS
SHEET NO. C305	FRAME & COVER DETAILS
SHEET NO. C601-C603	SOIL EROSION BMP DETAILS

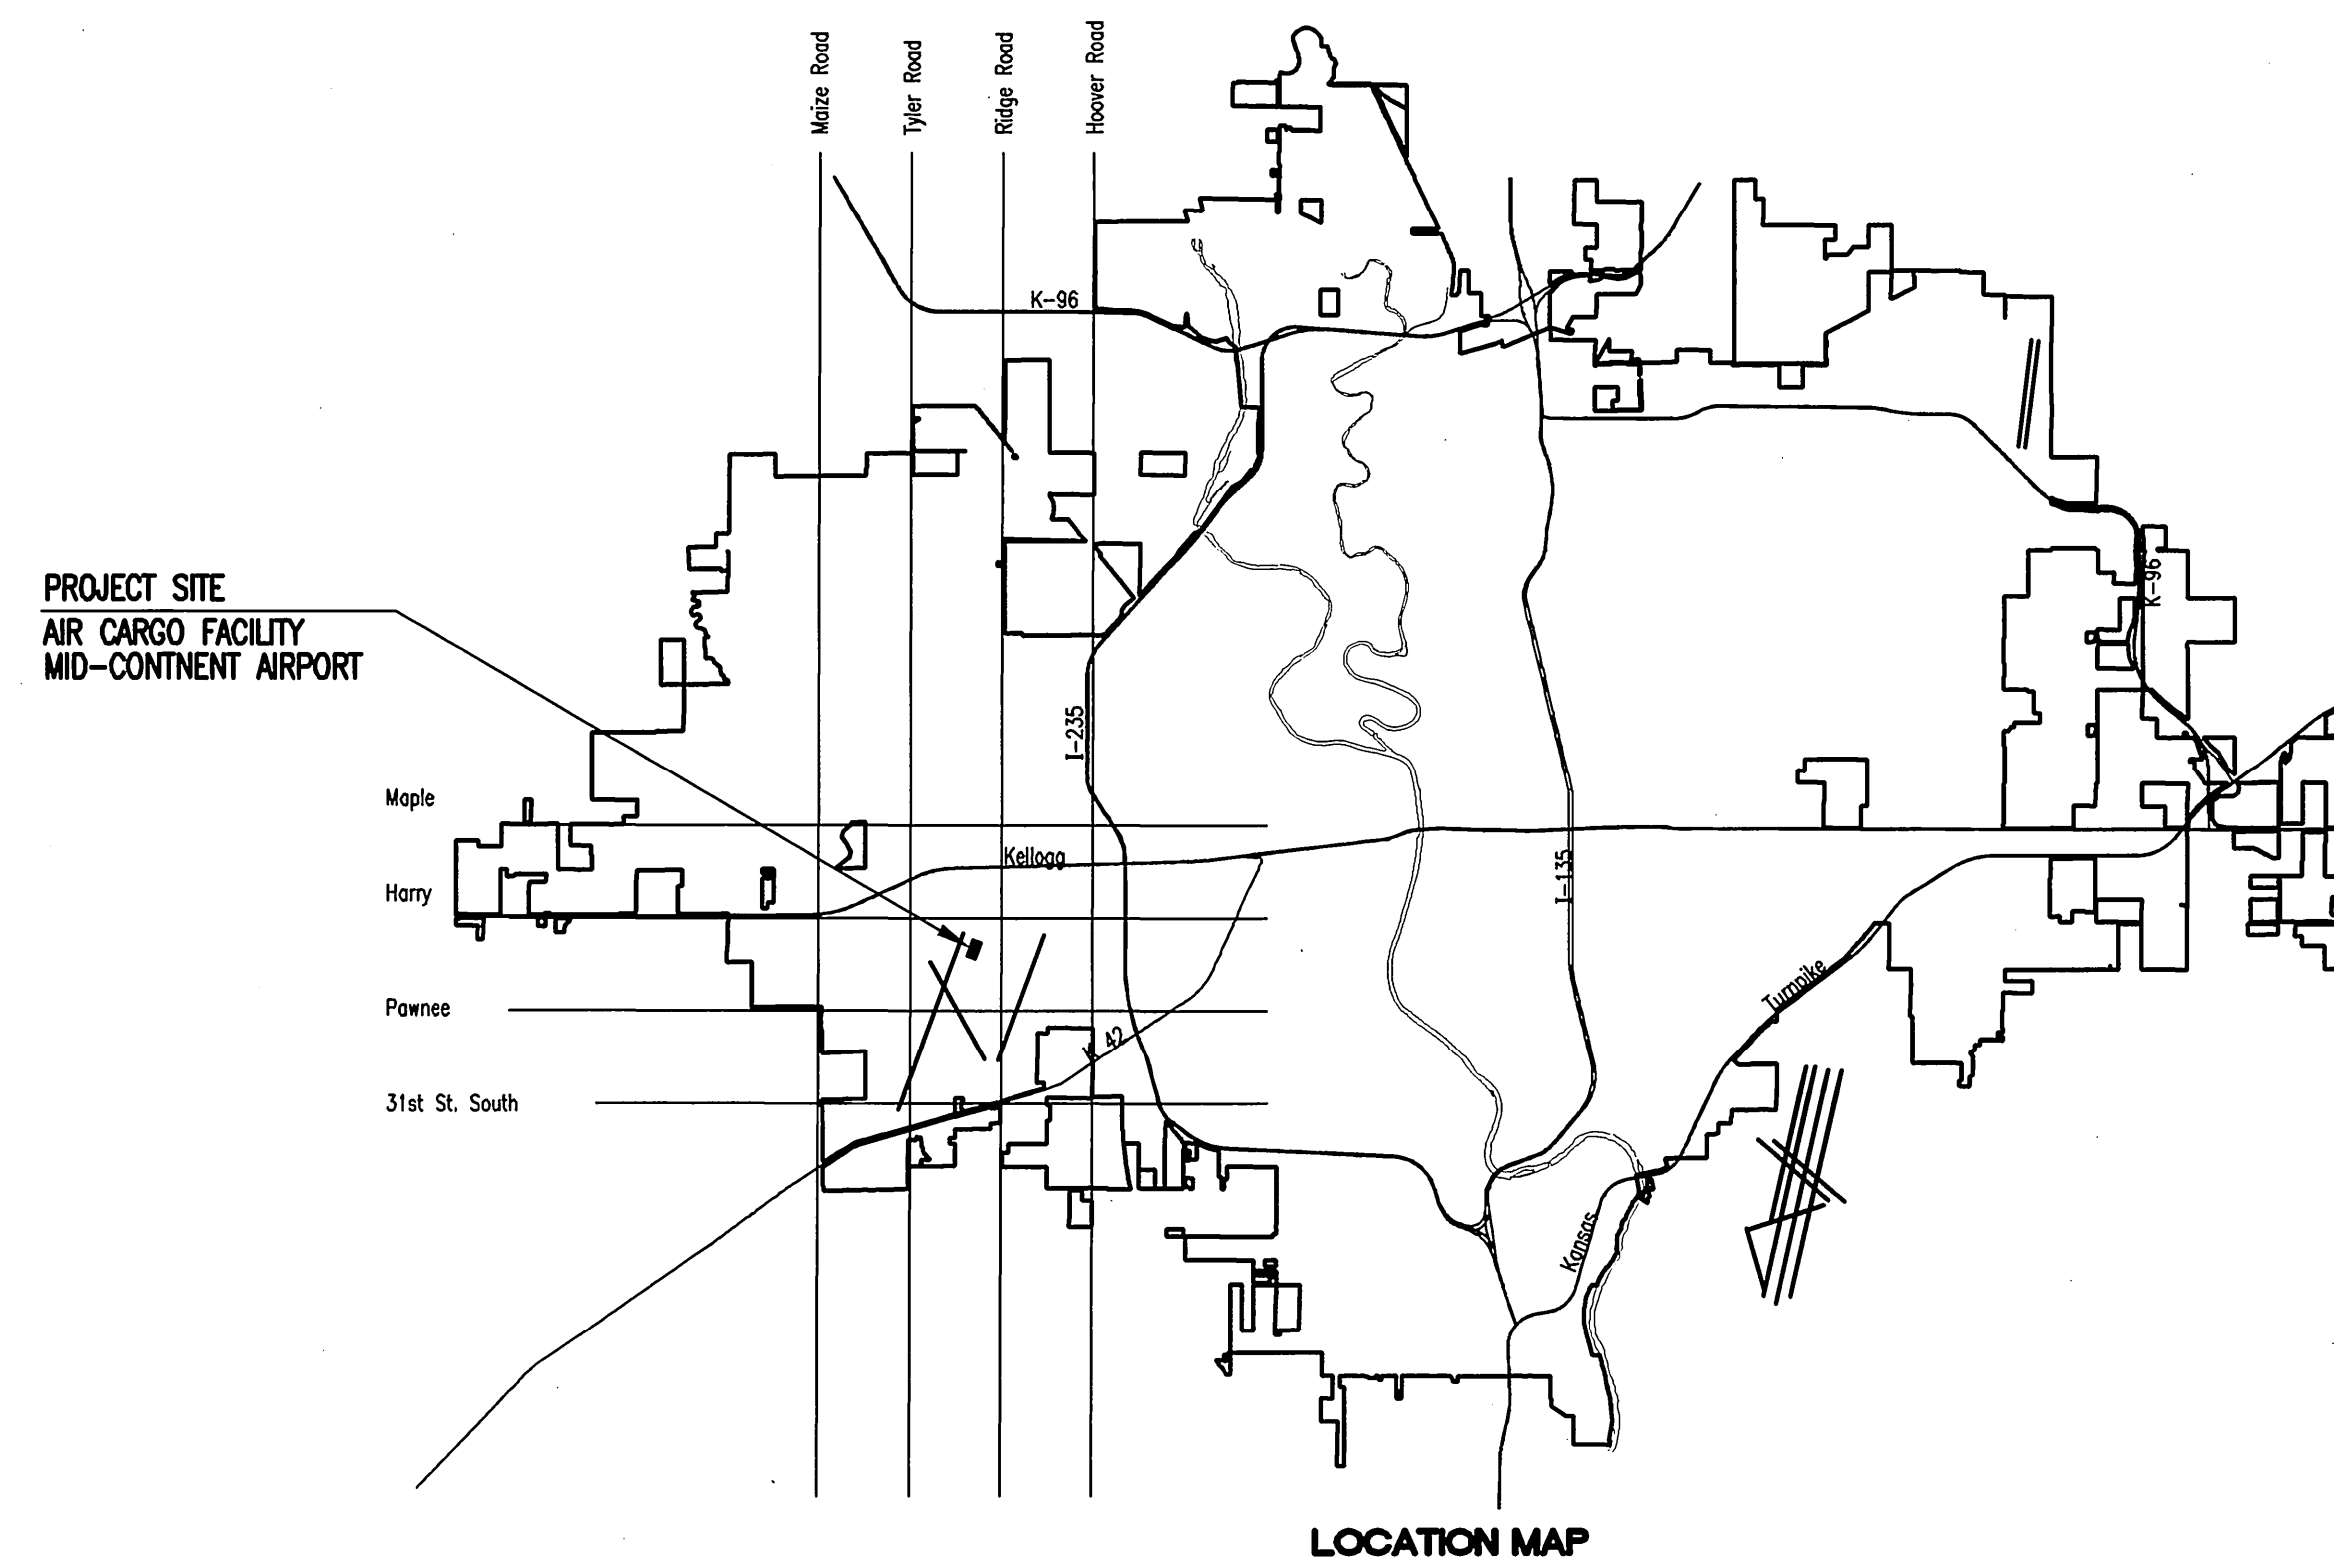

APPROVED AS NOTED
By CITY ENGINEER OF WICHITA

Sanitary Sewers [Signature] 2/12/08

Storm Sewers _____

Driveway Approaches _____


Paving _____

NOTE TO CONTRACTOR

INSPECTION AND TESTING FOR THIS PROJECT IS TO BE PROVIDED BY A LICENSED CONSULTING ENGINEERING FIRM CONTRACTED BY THE OWNER/DEVELOPER. SAID INSPECTION TO BE IN ACCORDANCE WITH THE CITY OF WICHITA STANDARD CONSTRUCTION ENGINEERING PRACTICES AND CERTIFIED BY A LICENSED PROFESSIONAL ENGINEER. NO WORK SHALL BE PERFORMED IN DEDICATED EASEMENTS OR PUBLIC RIGHT-OF-WAY BY THE CONTRACTOR UNTIL SUCH INSPECTION IS ARRANGED FOR AND REQUIRED BONDS HAVE BEEN SUBMITTED TO AND APPROVED BY THE CITY. NOR SHALL ANY WORK BE COMMENCED IN DEDICATED EASEMENTS OR PUBLIC RIGHT-OF-WAY WITHOUT WRITTEN AUTHORIZATION BY THE CITY ENGINEER. IMPROVEMENTS PERFORMED UNDER THIS PROJECT SHALL NOT BE ACCEPTED BY THE CITY UNTIL ALL APPLICABLE DOCUMENTATION HAS BEEN SUBMITTED TO THE CITY ENGINEER. THIS MAY INCLUDE: RECORD DRAWINGS, INSPECTION LOGS, TEST DOCUMENTATION, TV TAPES, AND A CERTIFICATE OF COMPLETION. THE ABOVE SHALL BE PERFORMED BY THE CONSULTING FIRM CONTRACTED TO INSPECT THIS PROJECT.

FEBRUARY 2008

PLANS PREPARED BY
PROFESSIONAL ENGINEERING CONSULTANTS, P.A.
ENGINEERS
WICHITA, KANSAS

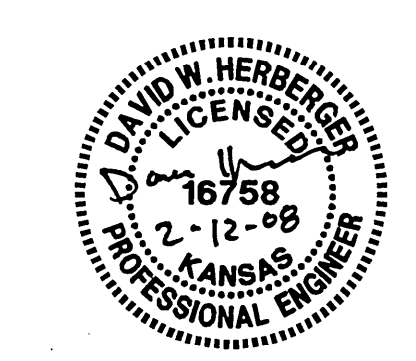

As Built Plans:
CONTRACTOR: Sodgrass Construction
INSPECTOR: Larry Gann, K E Miller Engineering
.PDF by: NWS, 06-09-08

Saved: 02-11-2008 11:46:37 AM by: MJC
 PLOT Scale: 1" = 10'-0" 02-11-2008 11:54:01 AM
 Q:\2008\06026\CONSTRUCTION DRAWINGS\PPS\06026-C301-PPS\Title Sheet