



Steve Larcen
 P.E.
 01/22/2013

B.M. 102.87 N.E. Cor. 1st Step on back porch of House S.E. Cor. Wildwood & St. Paul
 B.M. 98.40 4" E. and S.E. Curb Return S.E. Cor. 30th & Gordon

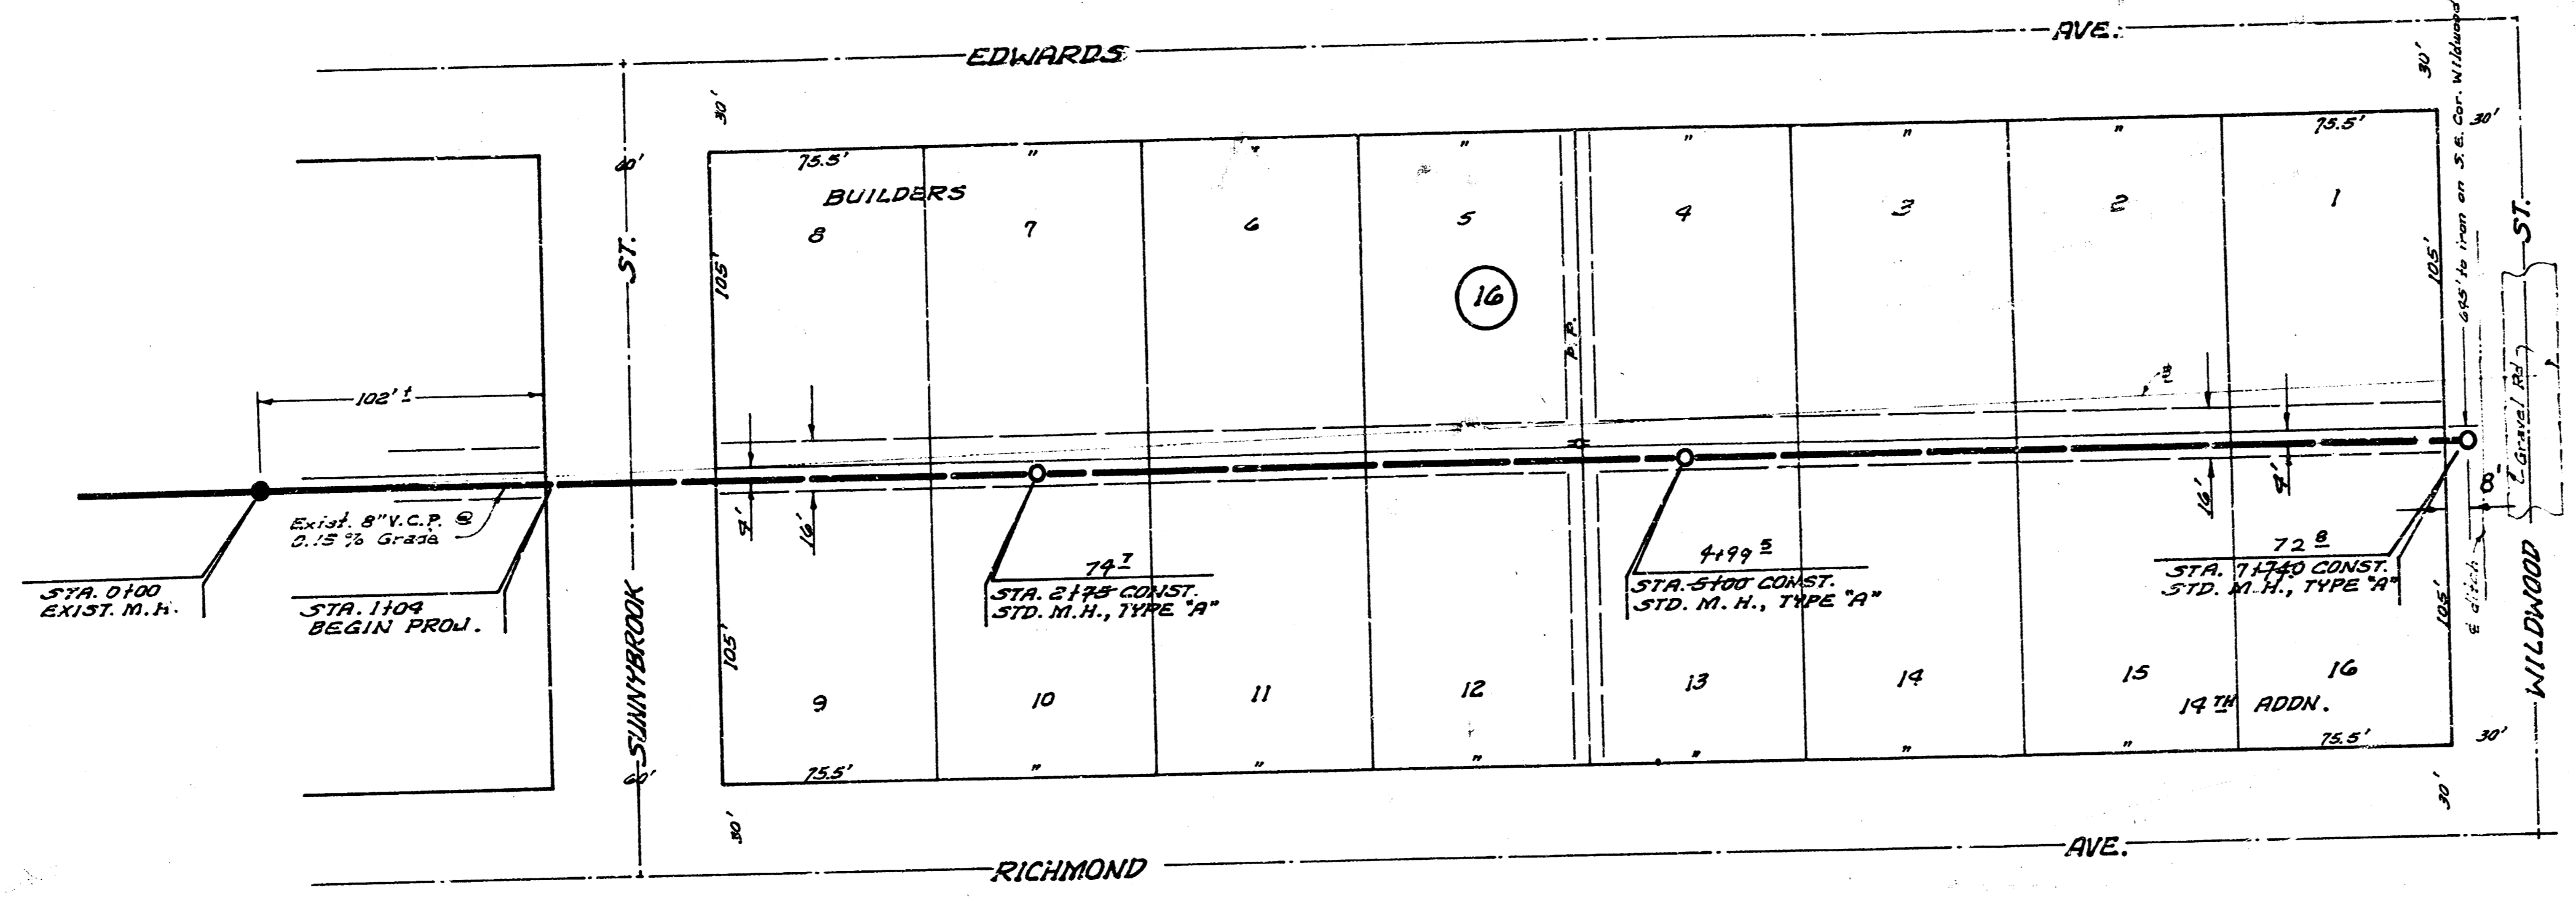

Plan Scale 1" = 40'
 Profile Scale 1" = 4.0' Vert.

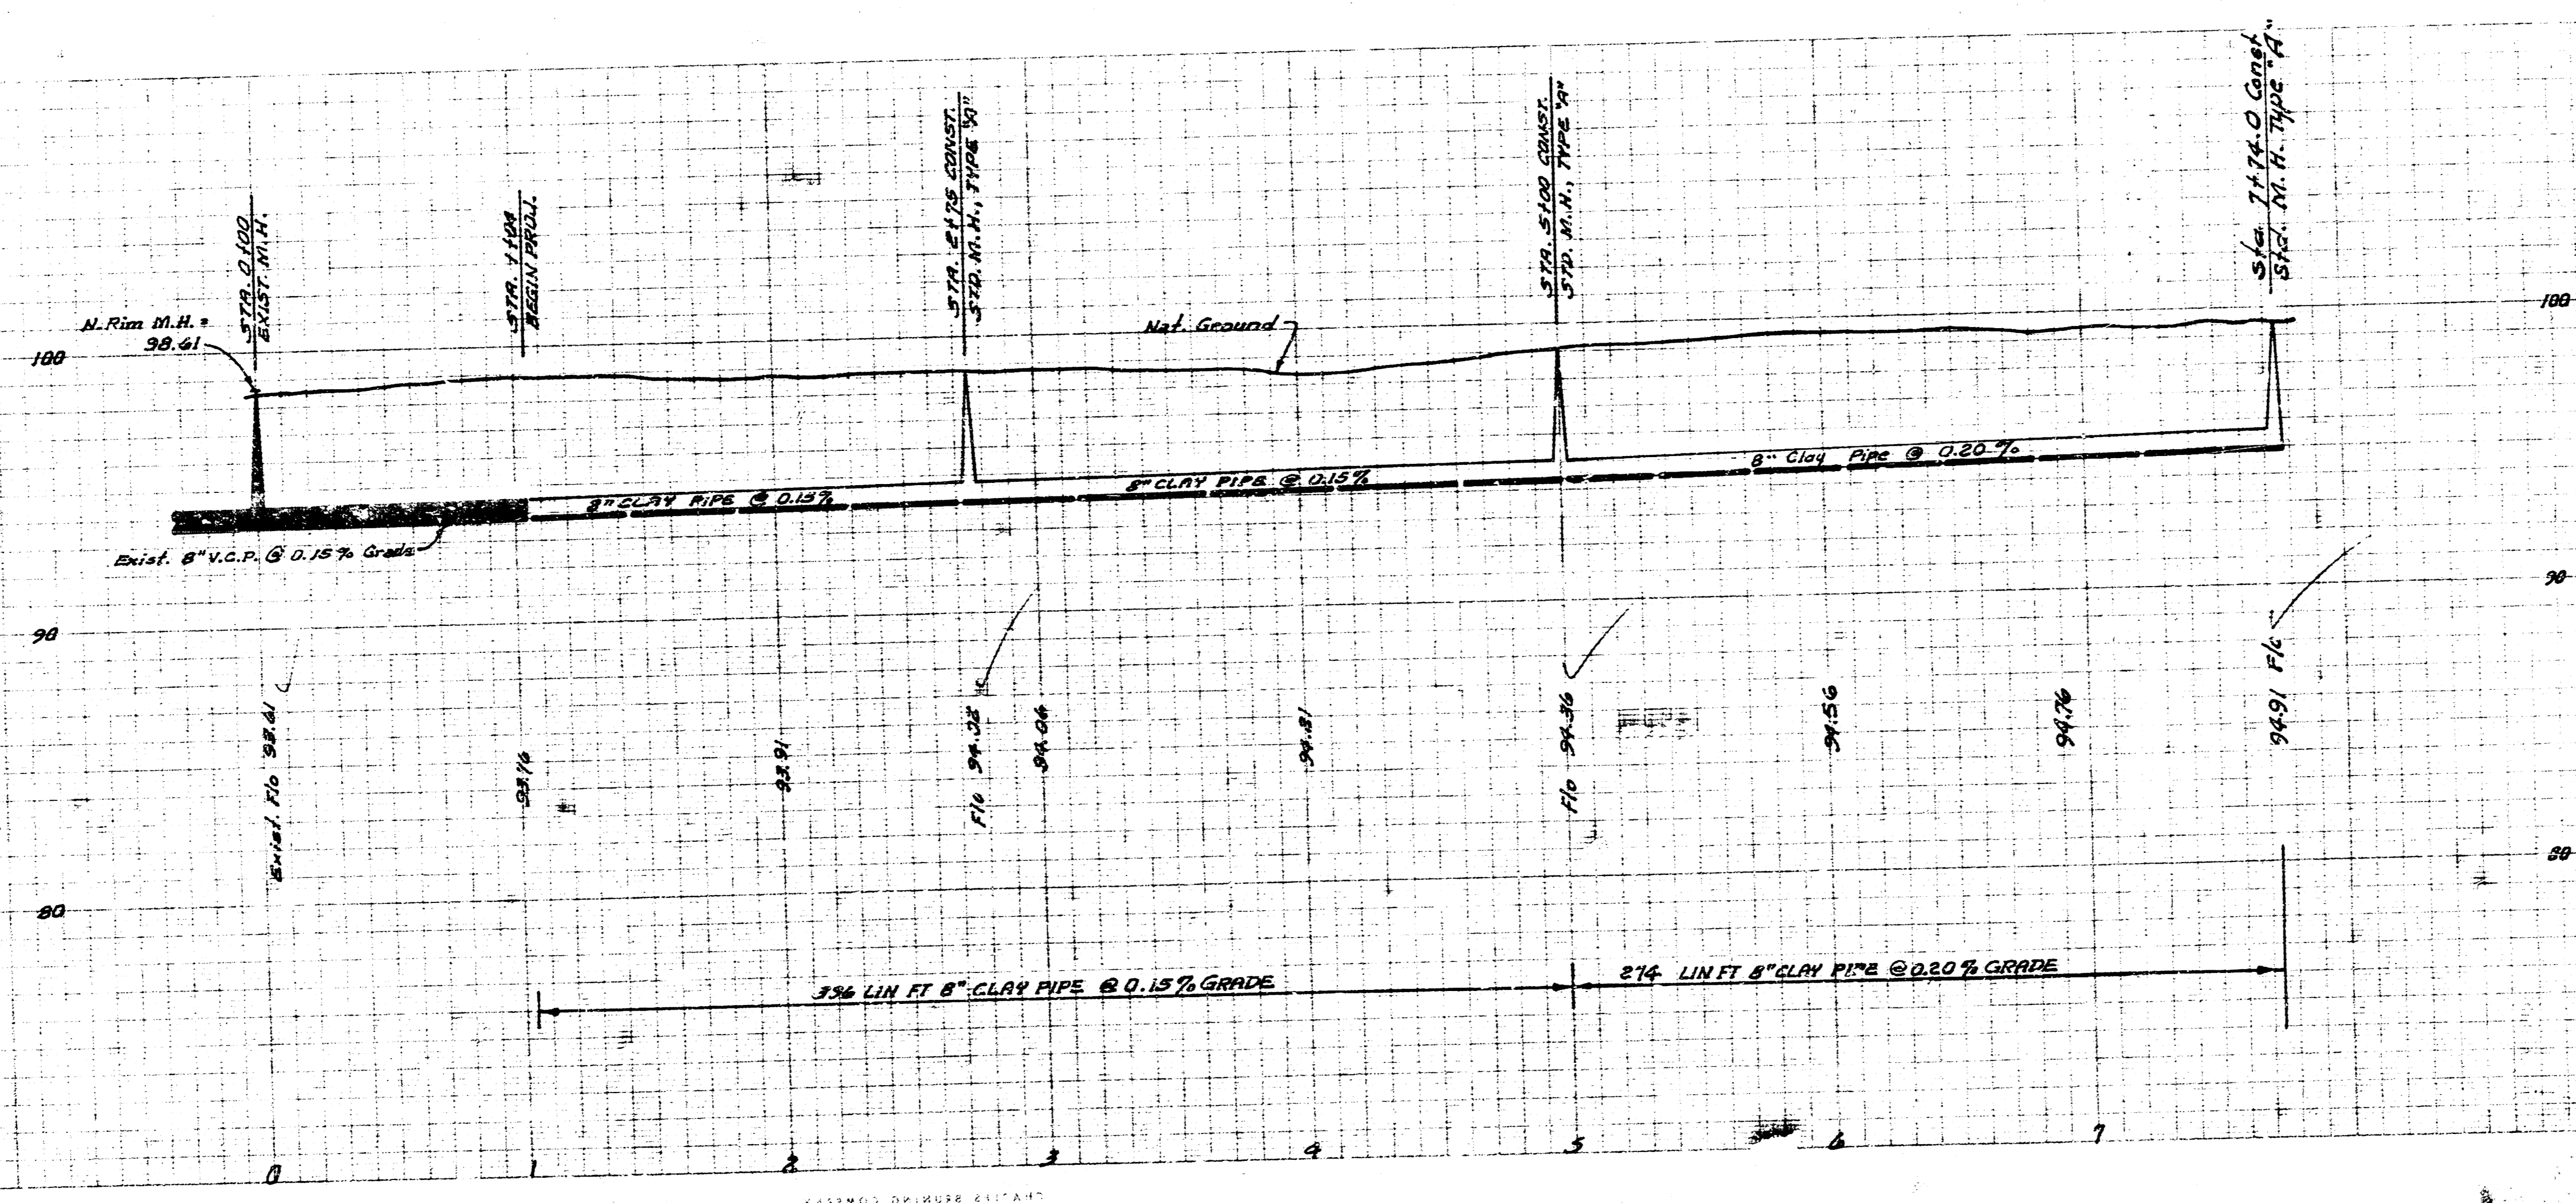

As Built Final Meas 55" 11 JAK

LAT. 105, SAN. SEWER 22
 CITY OF WICHITA, KANSAS
 R. W. LINN, CITY ENGINEER
 PROJ. NO. DBX1568005
 DATE: NOV. 1973

FILMED FROM THE BEST AVAILABLE COPY