

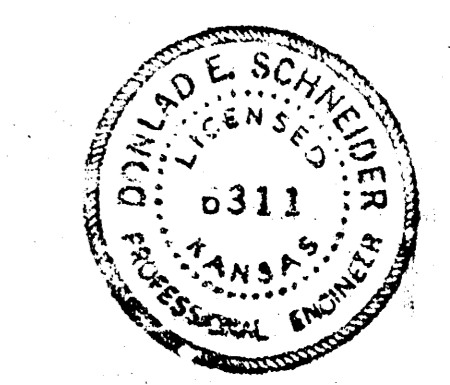


SCALE
VERTICAL - 1" = 5'
HORIZONTAL - 1" = 40'

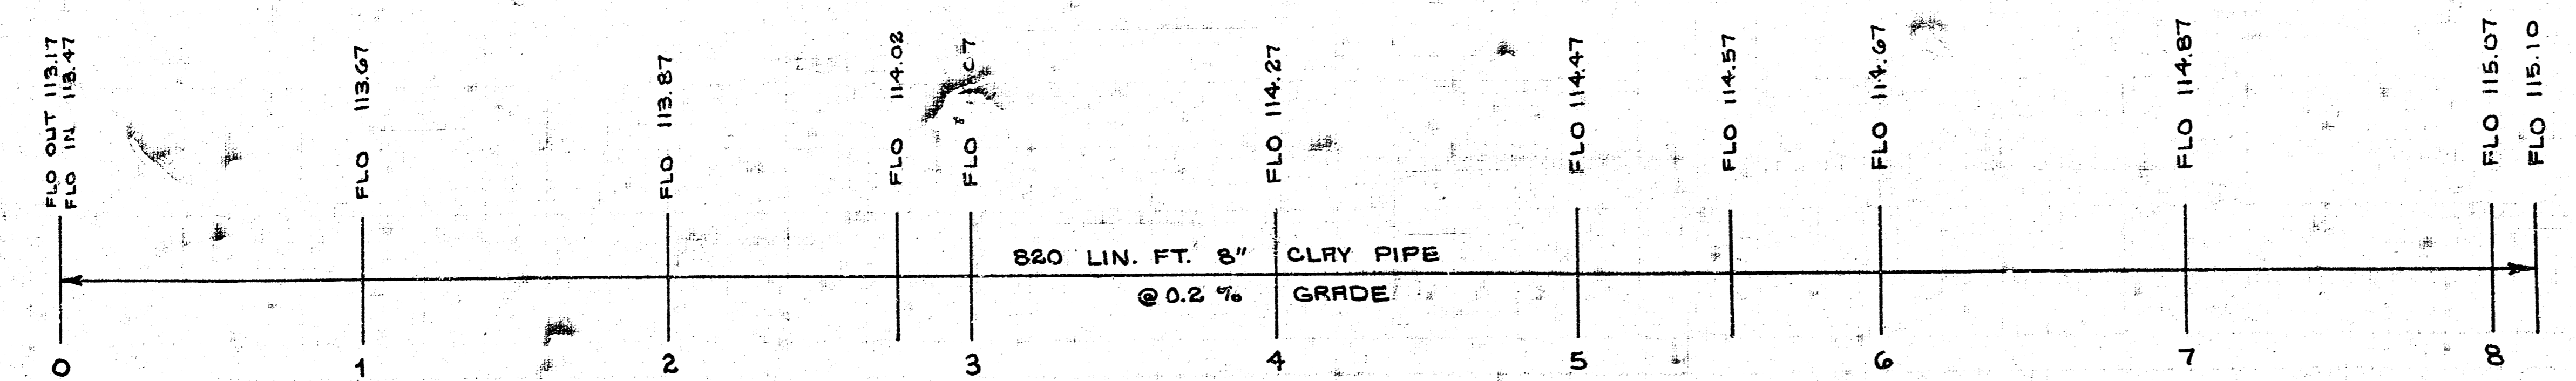


- BM*1 - 121.82 - RR SPIKE ON E-SIDE OF RR N.W. COR. HOOVER & 3RD ST.
- BM*2 - 121.00 - RR SPIKE N-FACE RR E.L. GILDR, N.L. 3RD ST.
- BM*3 - 123.36 - SW COR. CONC. PORCH 500 S. GILDR

NOTE TO CONTRACTOR:
CONTACT MRS. MARTIN, TEL. 943-1585 OR RD. FRANKNER, TEL. 522-3516 AT LEAST 3 DAYS BEFORE CONSTRUCTION BEGINS SO THAT GERMAN SHEPHERD DOGS MAY BE REMOVED FROM DOG PEN ON LOT 5.

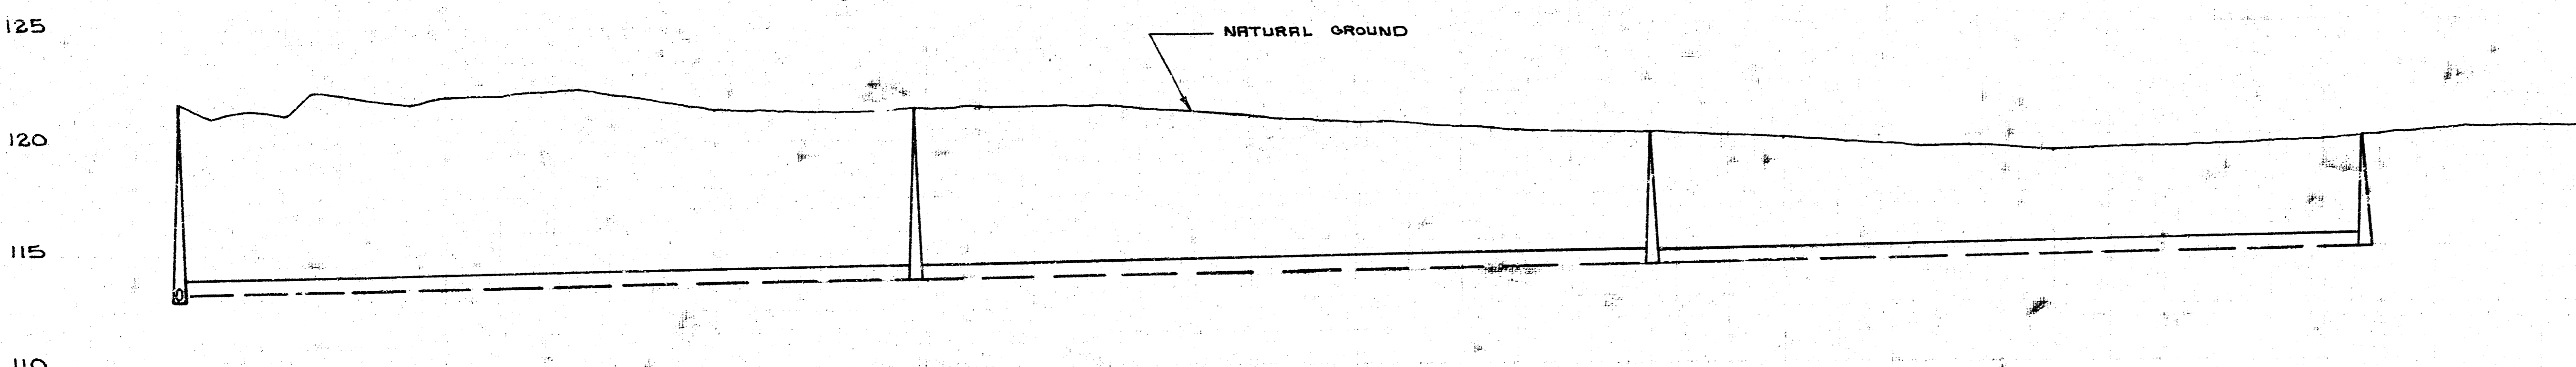

As Built Final Meas. K-105
LAT. 211 SUB. 5 S.S. *22
CITY OF WICHITA
R.W. LINN CITY ENGINEER
 DATE NOV. 1972 PROJECT NO. DBKL572024

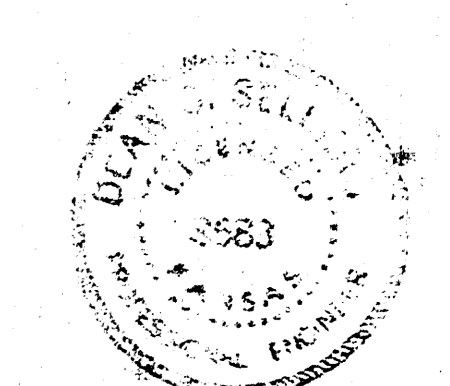

FILMED FROM THE BEST