

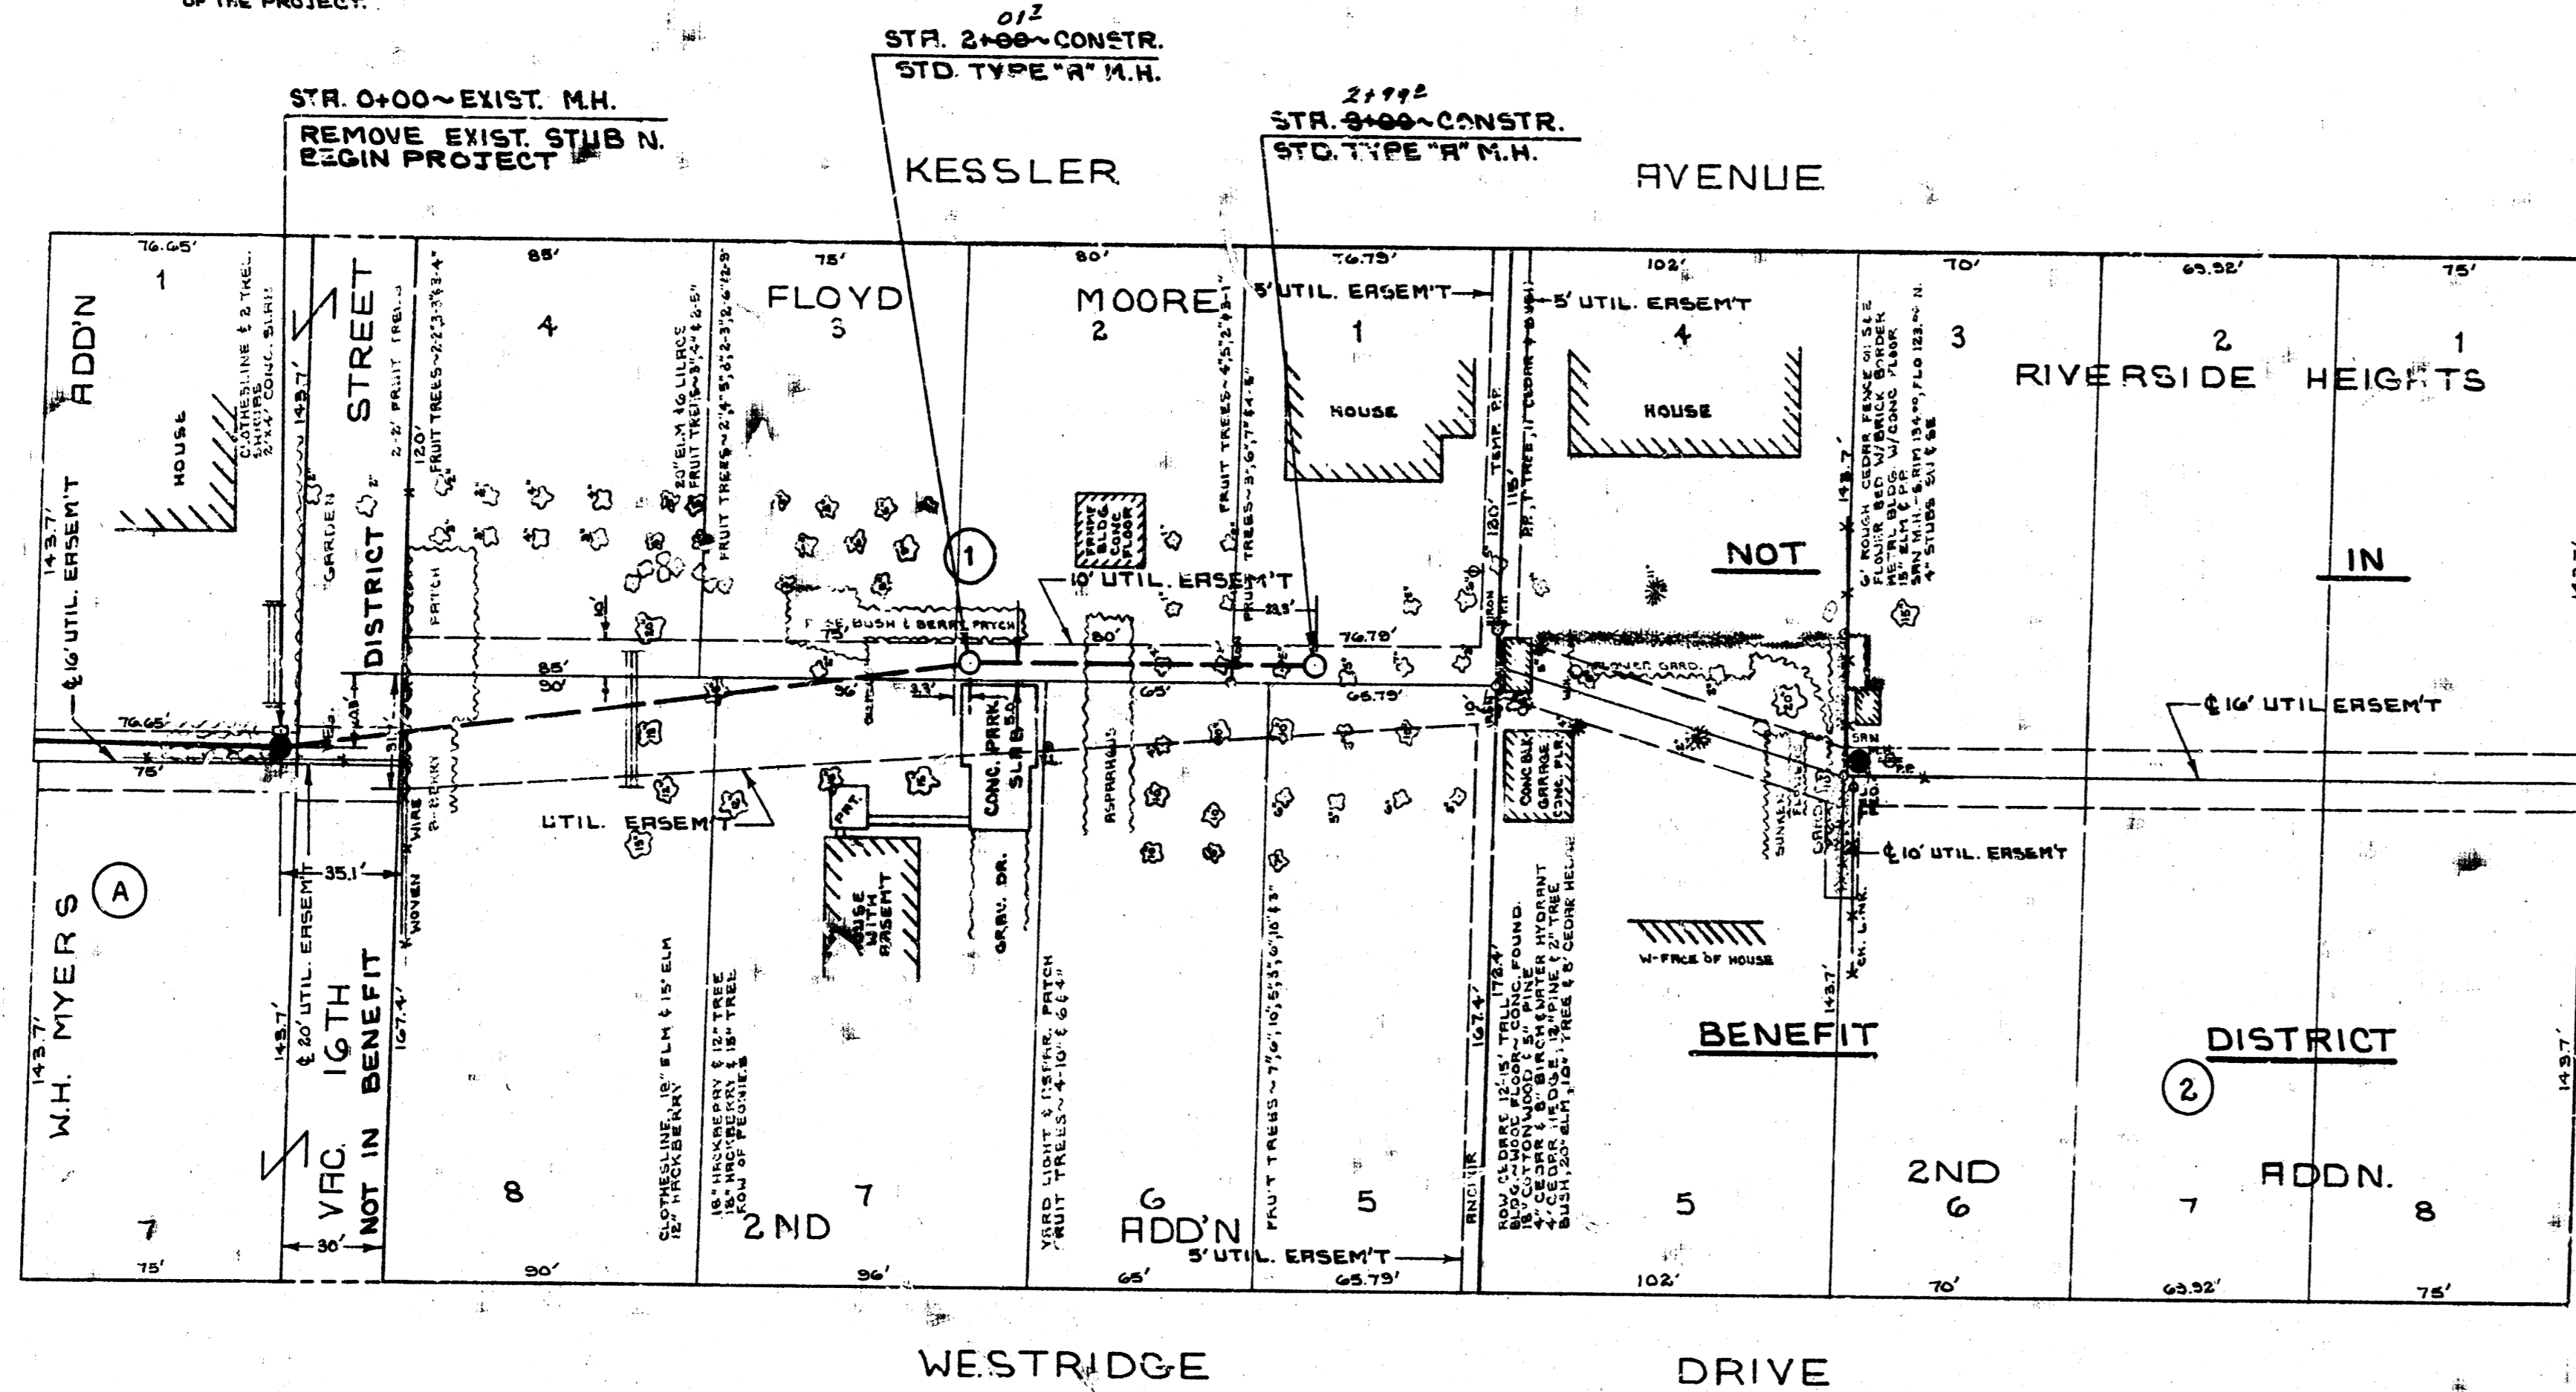


NOTE: REMOVAL OF EXIST. STUB N. SHALL NOT BE MADE DIRECTLY, BUT SHALL BE INCLUDED IN THE COST OF THE PROJECT.

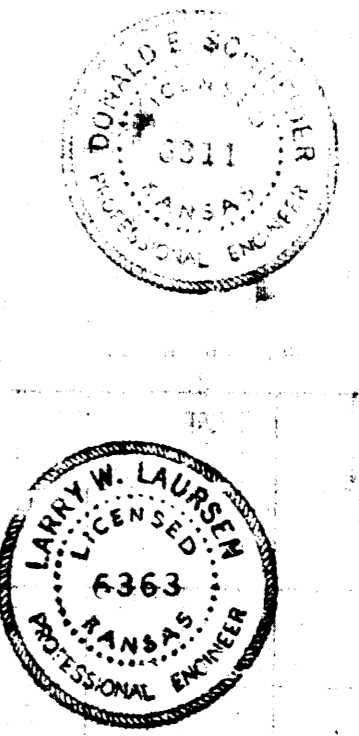

PLAN SCALE 1"=40'
 PROFILE SCALE 1"=8'
 HORIZONTAL
 VERTICAL

BM #1-123.423-NE COR. CONC. PORCH HOUSE
 #1649 N. KESSLER
 BM #2-130.95 ~ 4" IN RITCHIE TOP WEST CB. ON
 KESSLER AVE. 1 FT. N. OF N.L. 17TH ST.

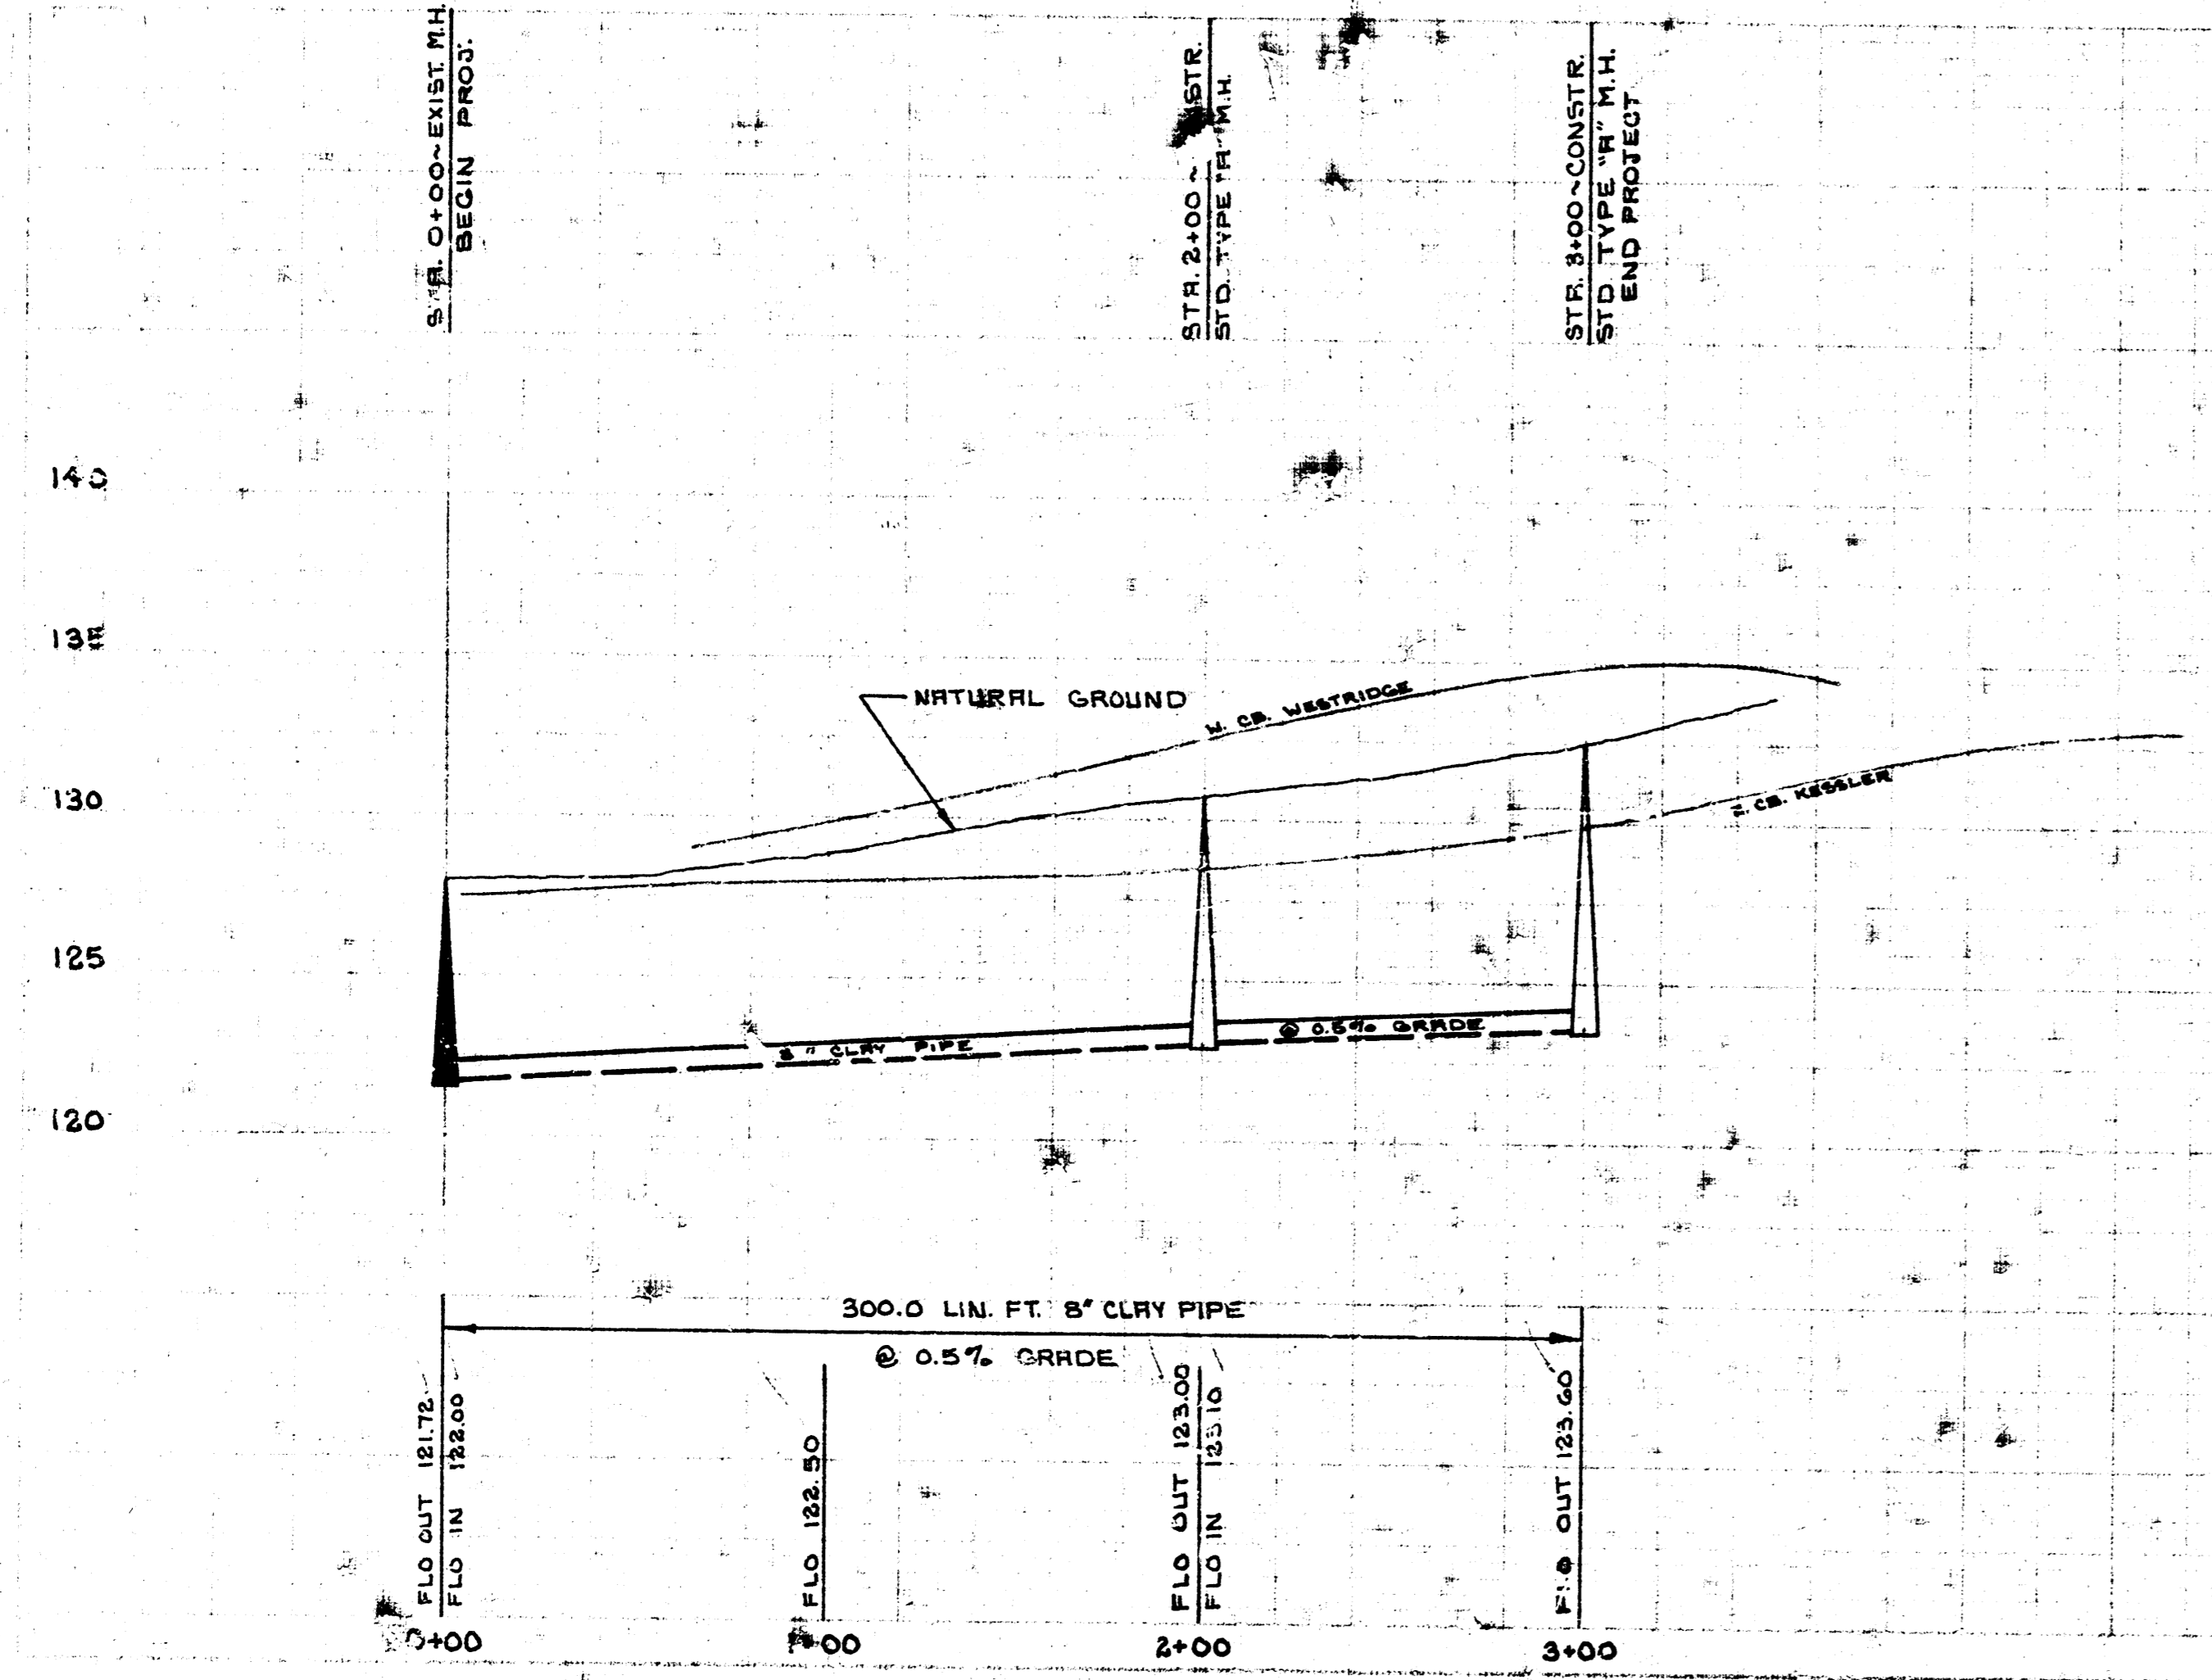

As Built Final Map R-111
LAT. 212-MAIN 5- S.S. 22
 CITY OF WICHITA
 R.W. LINN ~ CITY ENGINEER
 DATE FEB. 1978 PROJ. NO. DBKL 572028

14 2 1 3