


BM 126.15 West Side of P.P. at S.E. corner of Elder St. South & 9th St. North
 BM 126.98 Top of R.R. Spike in E. side of P.P. Approx. 350 ft. East of the
 Intersection of Curtis St. to the North & Robinson St.
 BM 124.64 City Std. Disc. 33' W. & 42' S. of Anna & 9th St.


N
 Plan Scale 1" = 40'
 Profile Scale 1" = 40' Horiz.
 1" = 5' Vert.

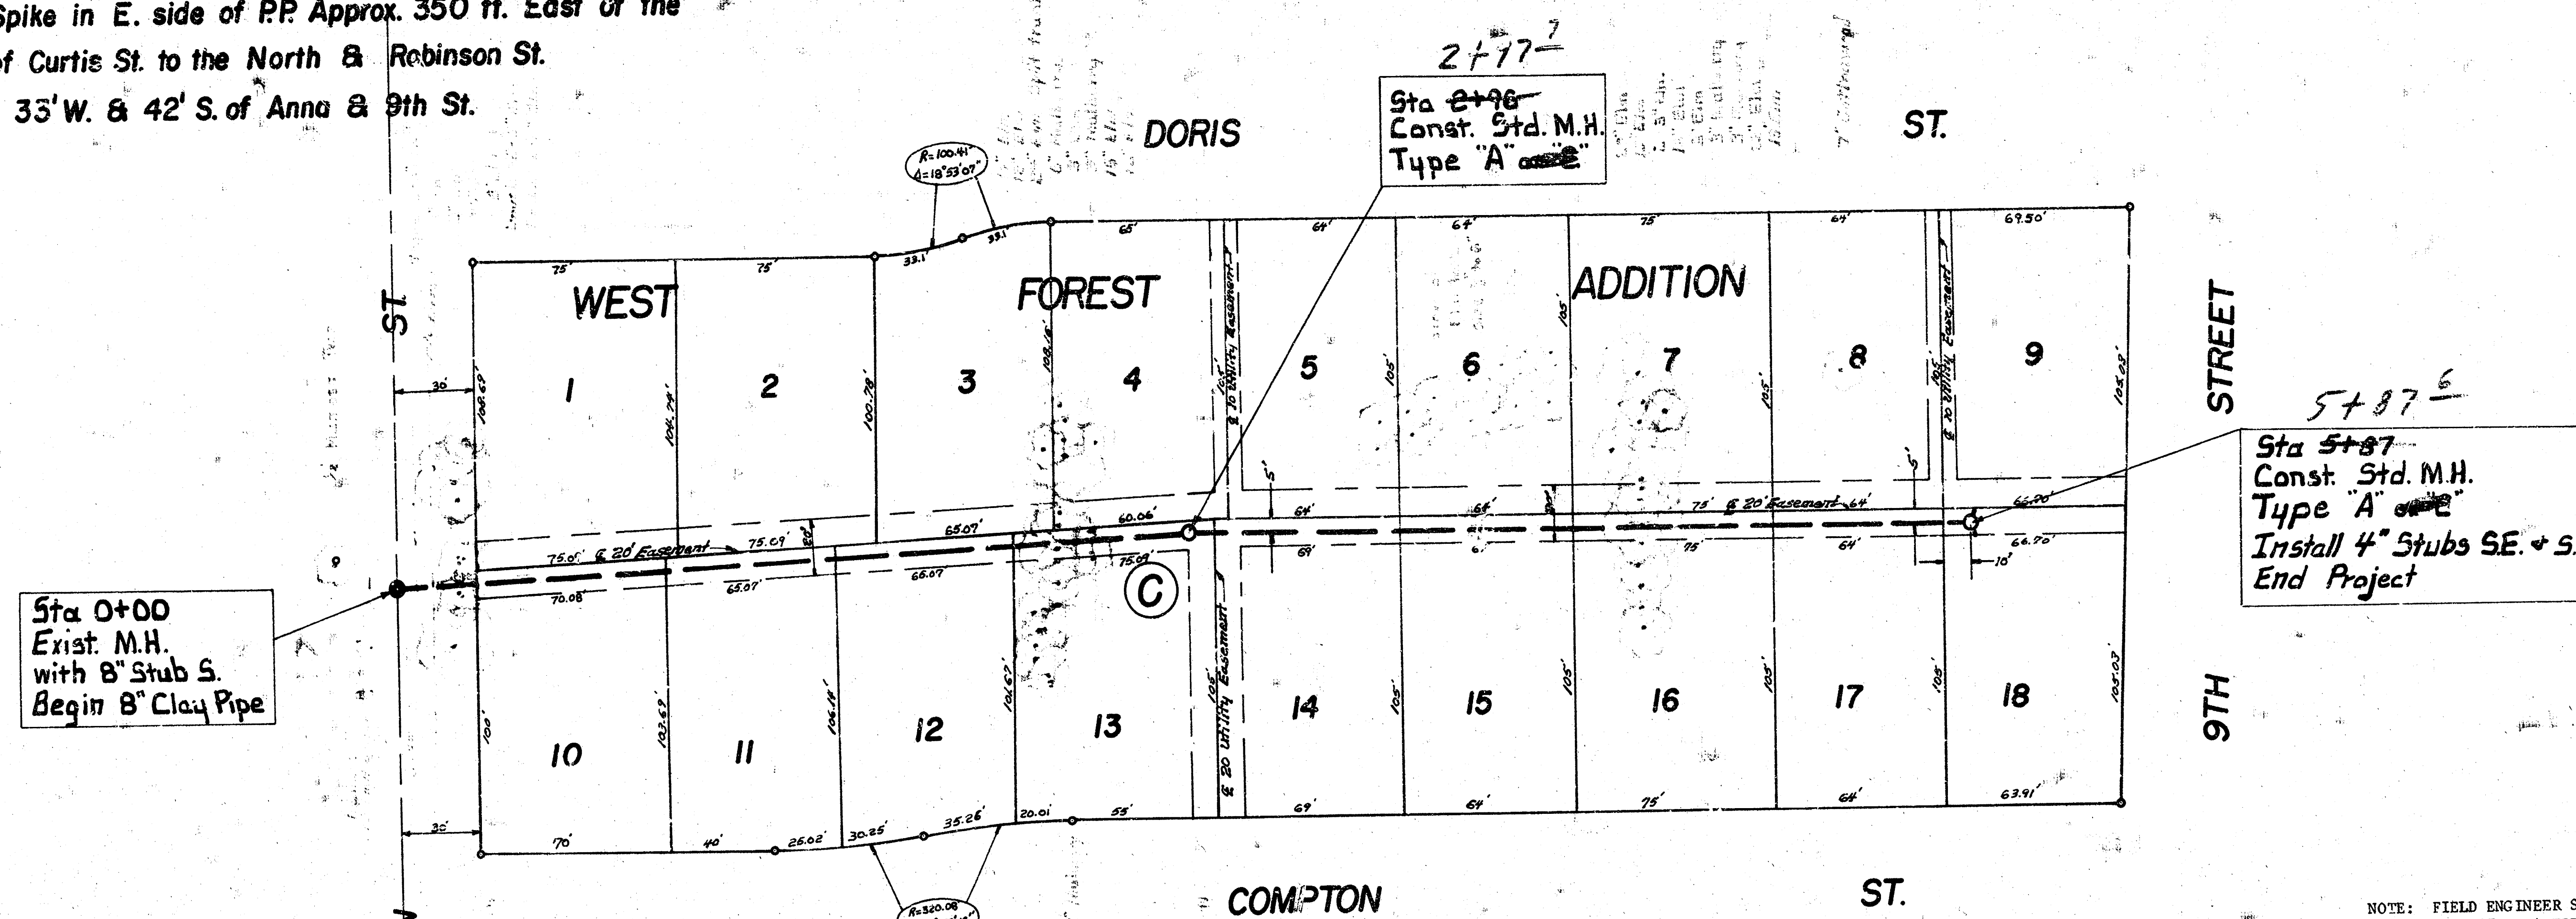

NOTE: FIELD ENGINEER SHALL SET TOP OF MANHOLE AT STATION 5 + 87 TO A ELEVATION WHICH WILL MATCH FINISHED GRADE.


130
125
120
115

130
125
120
115

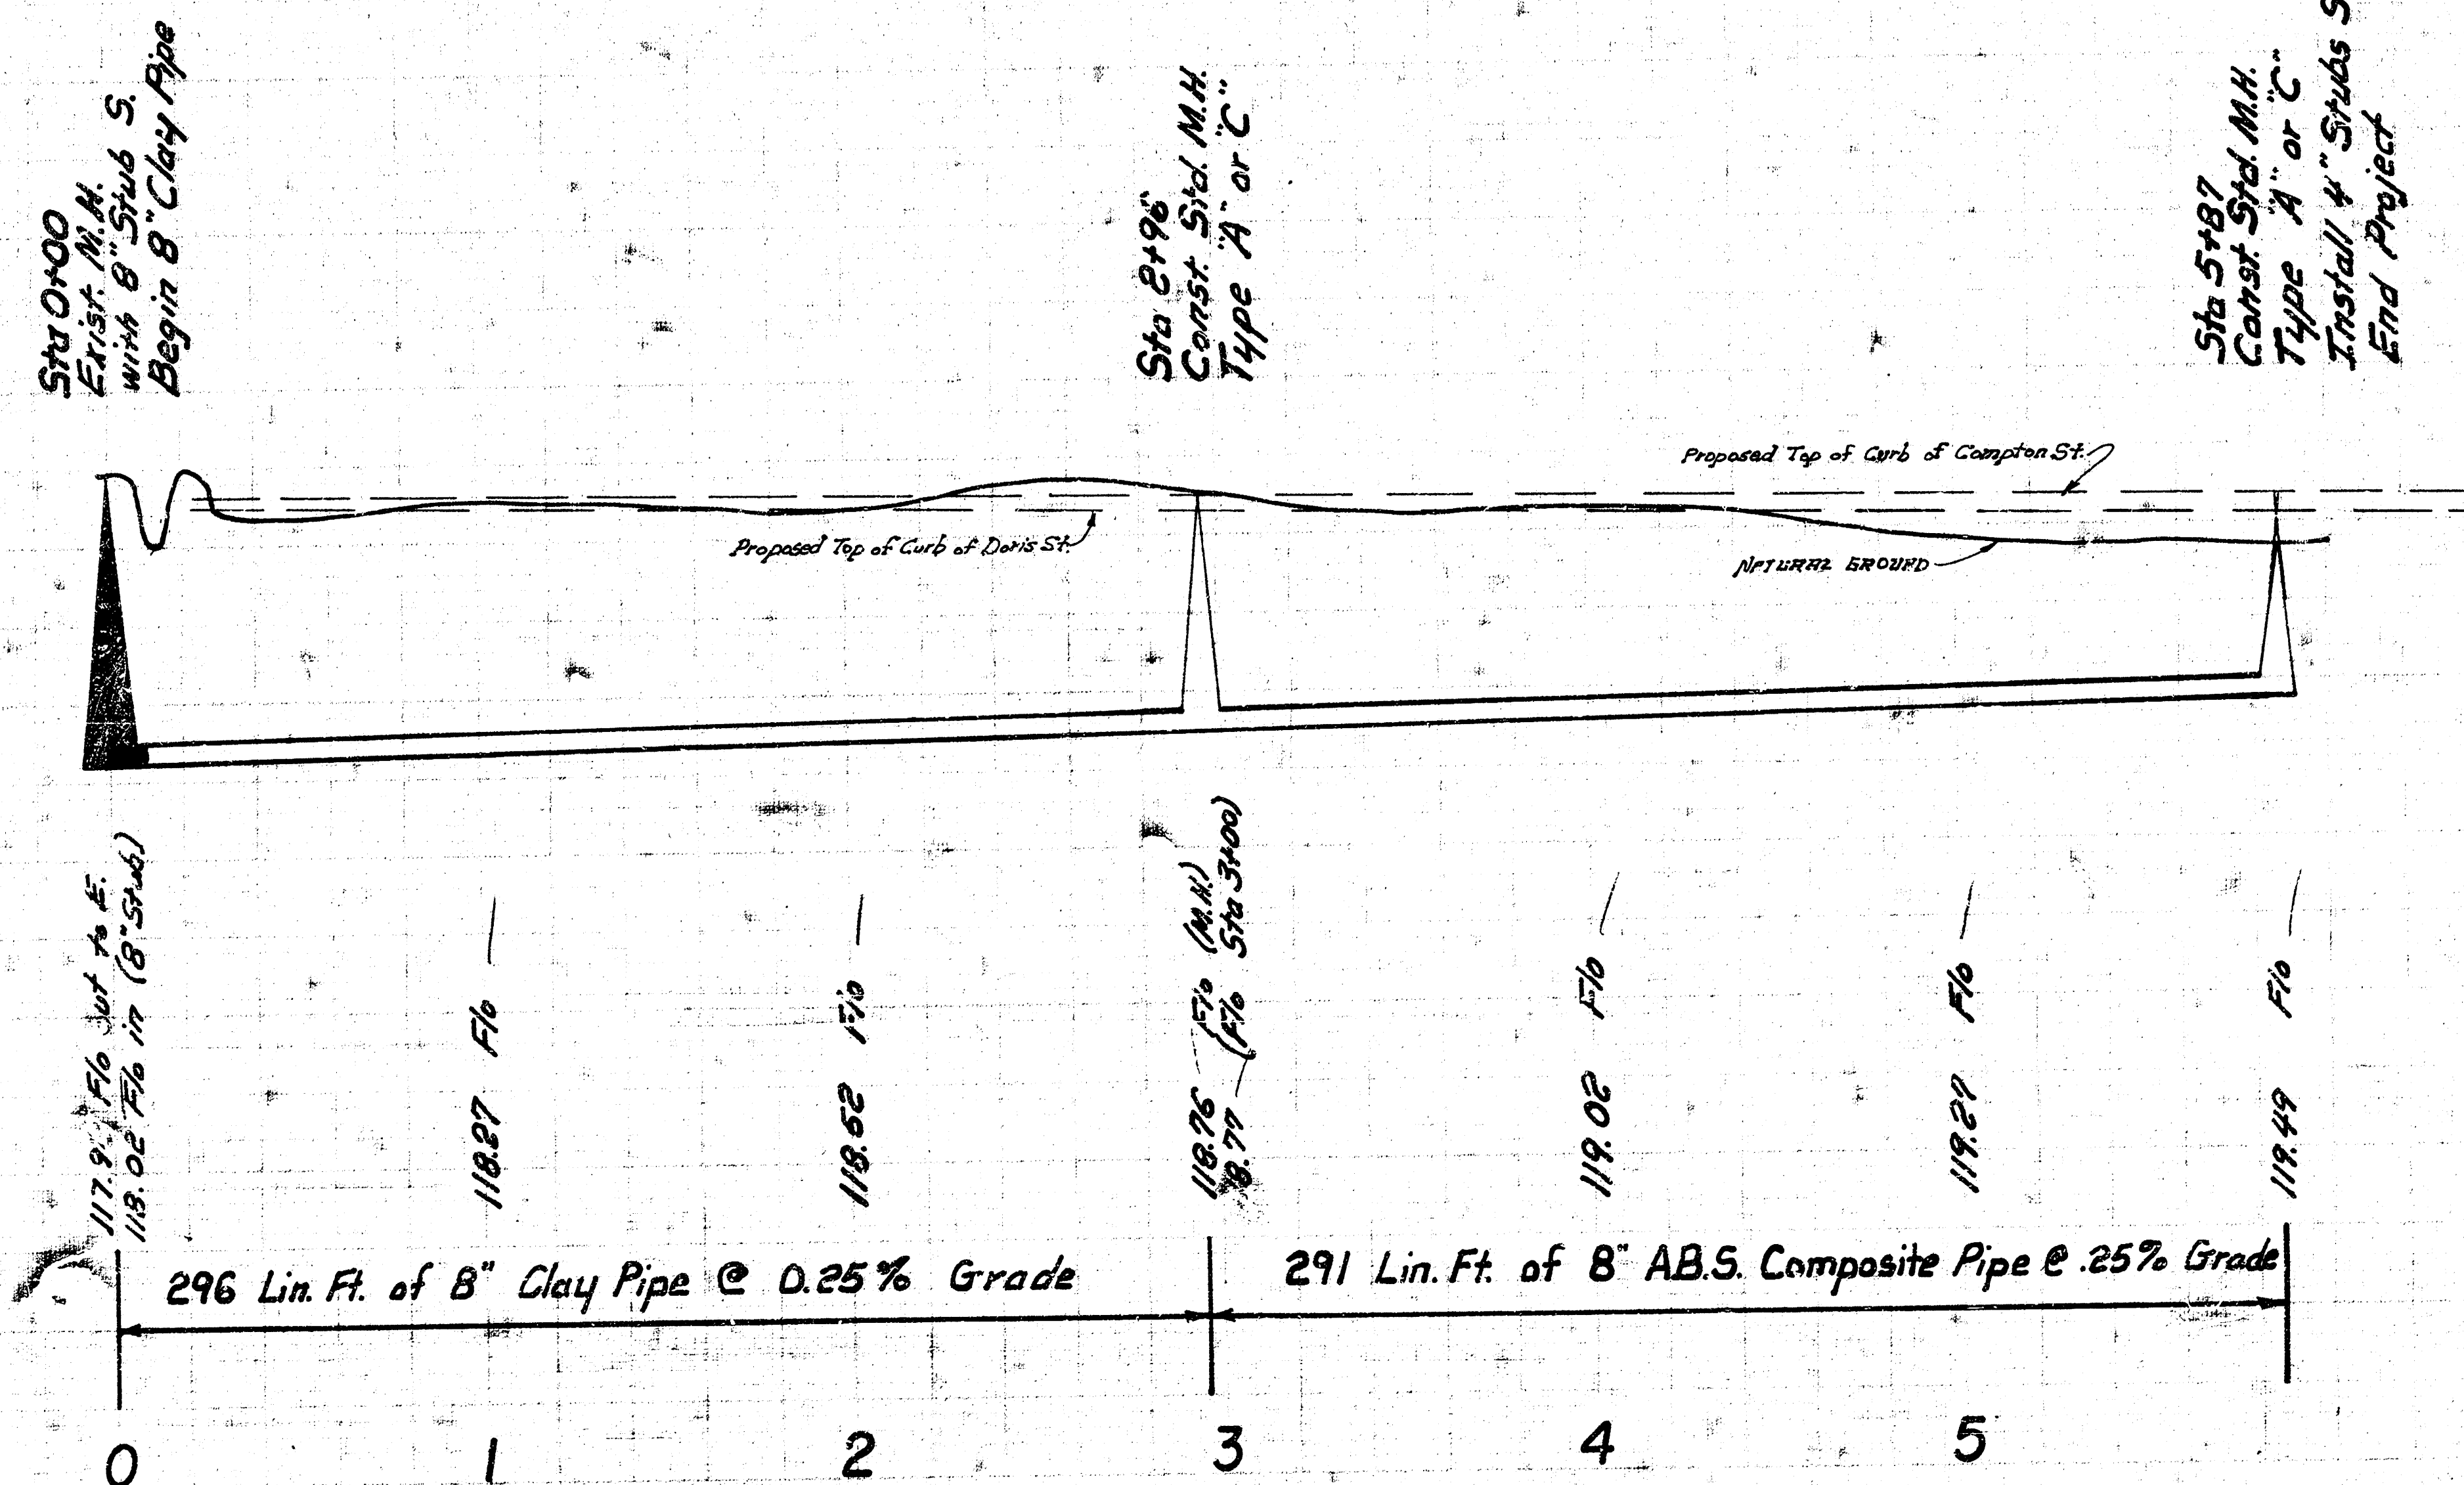

As built 11-30-77

LAT 224 MAIN 5 S.S. 22
 CITY OF WICHITA, KANSAS
 R.W. LINN CITY ENGINEER
 DATE: PROJECT NUMBER: DBKL577009

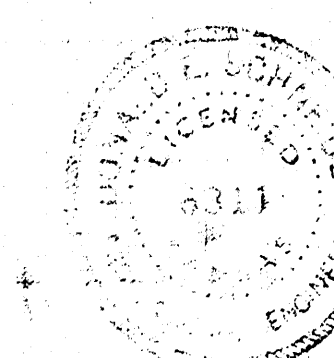

14 5 5 18