



Plan Scale 1" = 40'
 Profile Scale 1" = 40' Hor.
 1" = 5' Vert.

NOTE: CONTRACTOR SHALL GIVE OWNERS OF DEVELOPED PROPERTY A MINIMUM OF 24 HOURS ADVANCE NOTICE PRIOR TO STARTING CONSTRUCTION. SEPTIC TANK LATERALS ARE LOCATED IN THE TEMPORARY CONSTRUCTION EASEMENT AREA ON LOT 1, BLOCK D, WEST CENTRAL GARDENS. THIRD ADDITION CONTRACTOR WILL BE REQUIRED TO REPAIR ANY DAMAGE TO THESE SEPTIC TANK LATERALS.

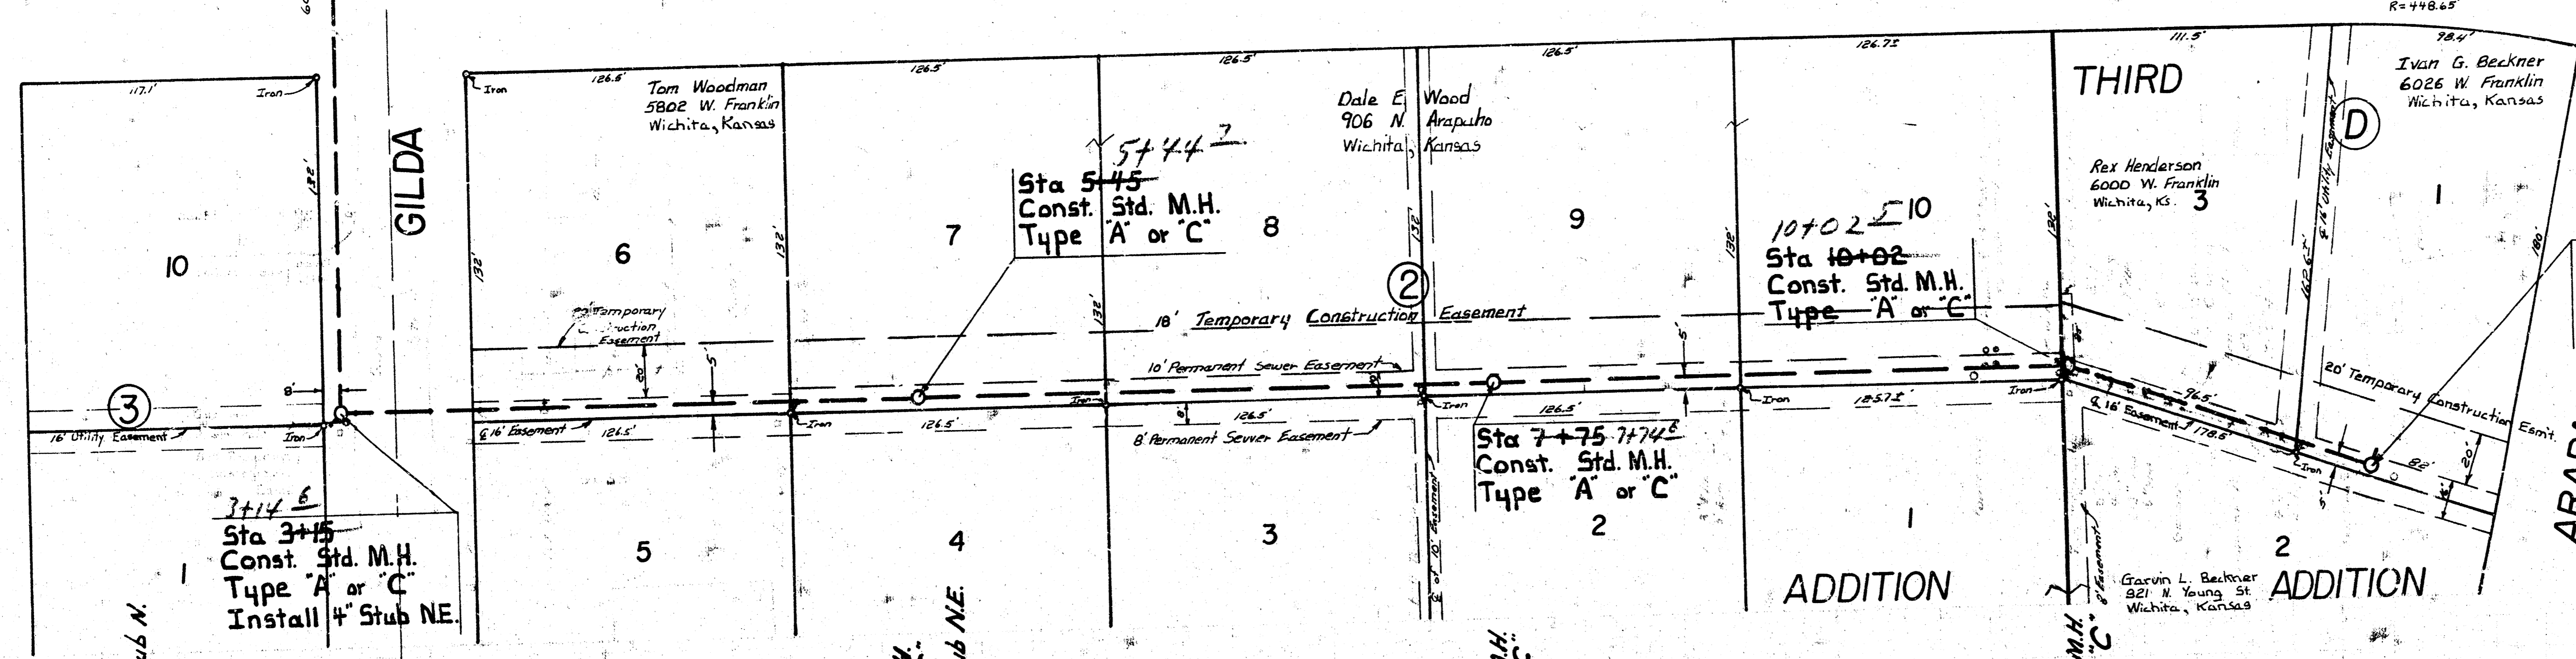

B.M. 12329 City Std. Disc 34' East & 42' N. of C. of Hoover & Central
 B.M. 12629 Hoover & 9th Street North Bench Mark Disc. 34' East and 42' South of C. Both.

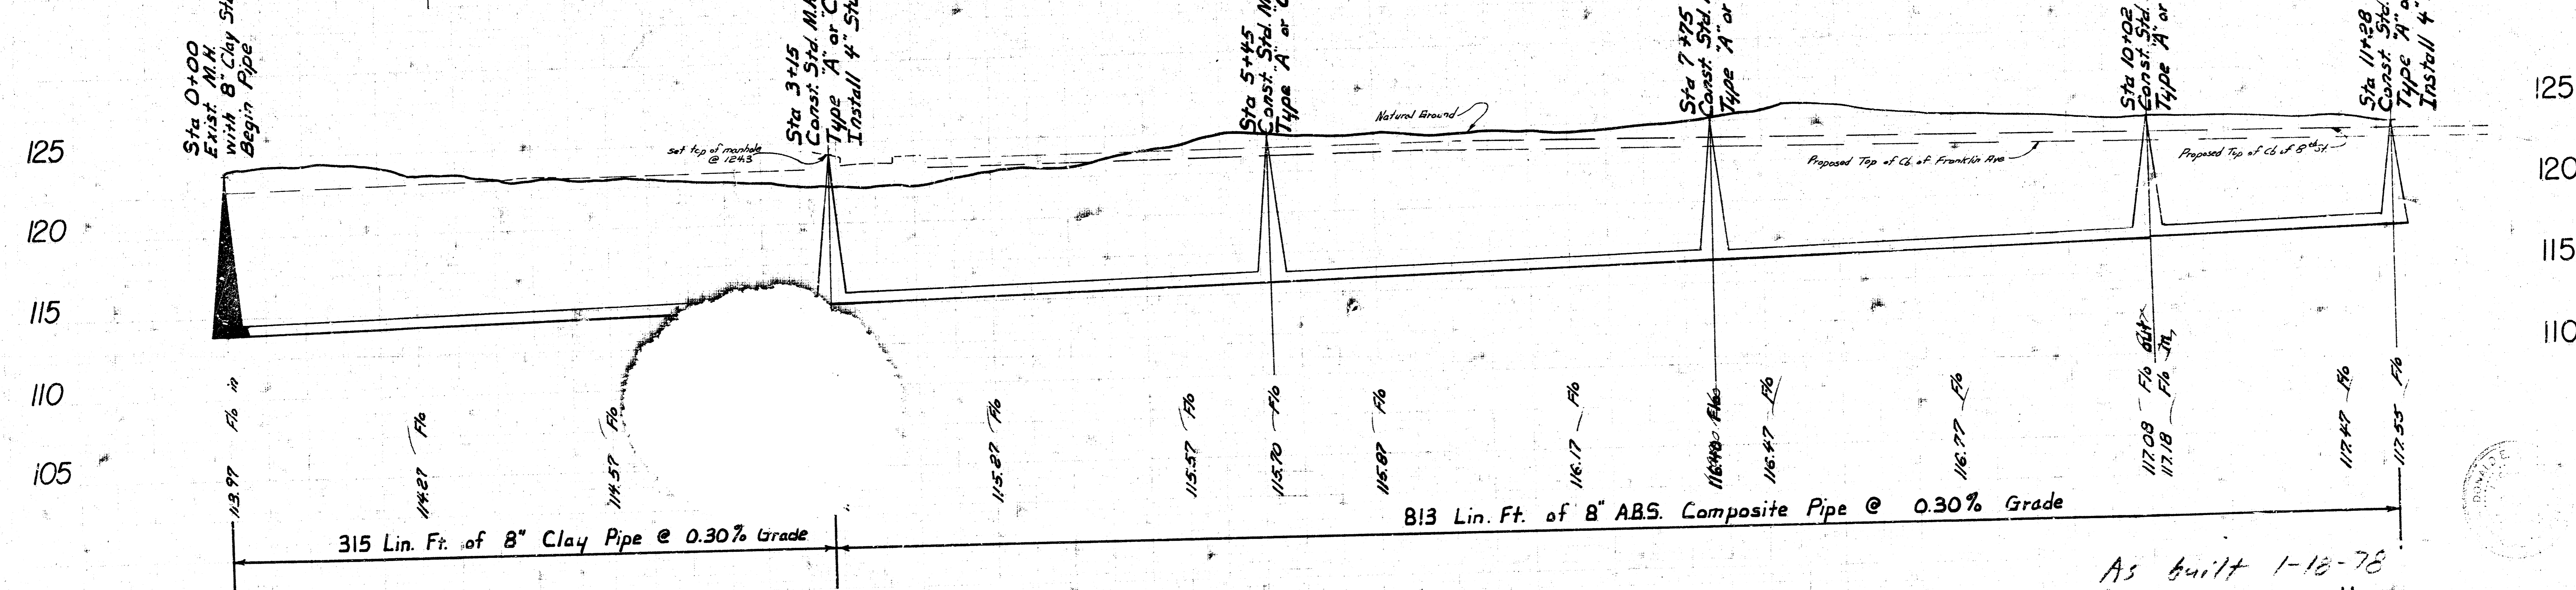

315 Lin. Ft. of 8" Clay Pipe @ 0.30% Grade

813 Lin. Ft. of 8" ABS Composite Pipe @ 0.30% Grade

As built 1-18-78
 LAT 226 MAIN 5 S.S. 22
 CITY OF WICHITA, KANSAS
 R.W. LINN CITY ENGINEER
 DATE: _____ PROJECT NUMBER: DBKL577023

Study Sheet
 Date: 1/18/78
 MTRP