


GENERAL NOTES

- 1- FIELD ENGINEER TO TAKE TIES TO ALL IRONS THAT MAY BE DISTURBED DURING CONSTRUCTION AND REPLACE ANY THAT ARE DESTROYED.
- 2- CONTRACTOR TO CONTACT UTILITY COMPANIES FOR LOCATION OF ANY UNDERGROUND LINES.
- 3- FIELD ENGINEER TO SET TOP OF MANHOLES TO FINISH GRADE AS DETERMINED BY DEVELOPER.


NOTE
 LOTS 1, 2 & 3 ARE BENEFIT DISTRICT.

Scale
 PLAN 1" = 40'
 PROFILE HORT 1" = 40'
 VERT 1" = 5'

B.M. = 126-93 City std. 26E. & 32 S of C's of Baker & 13th ST.

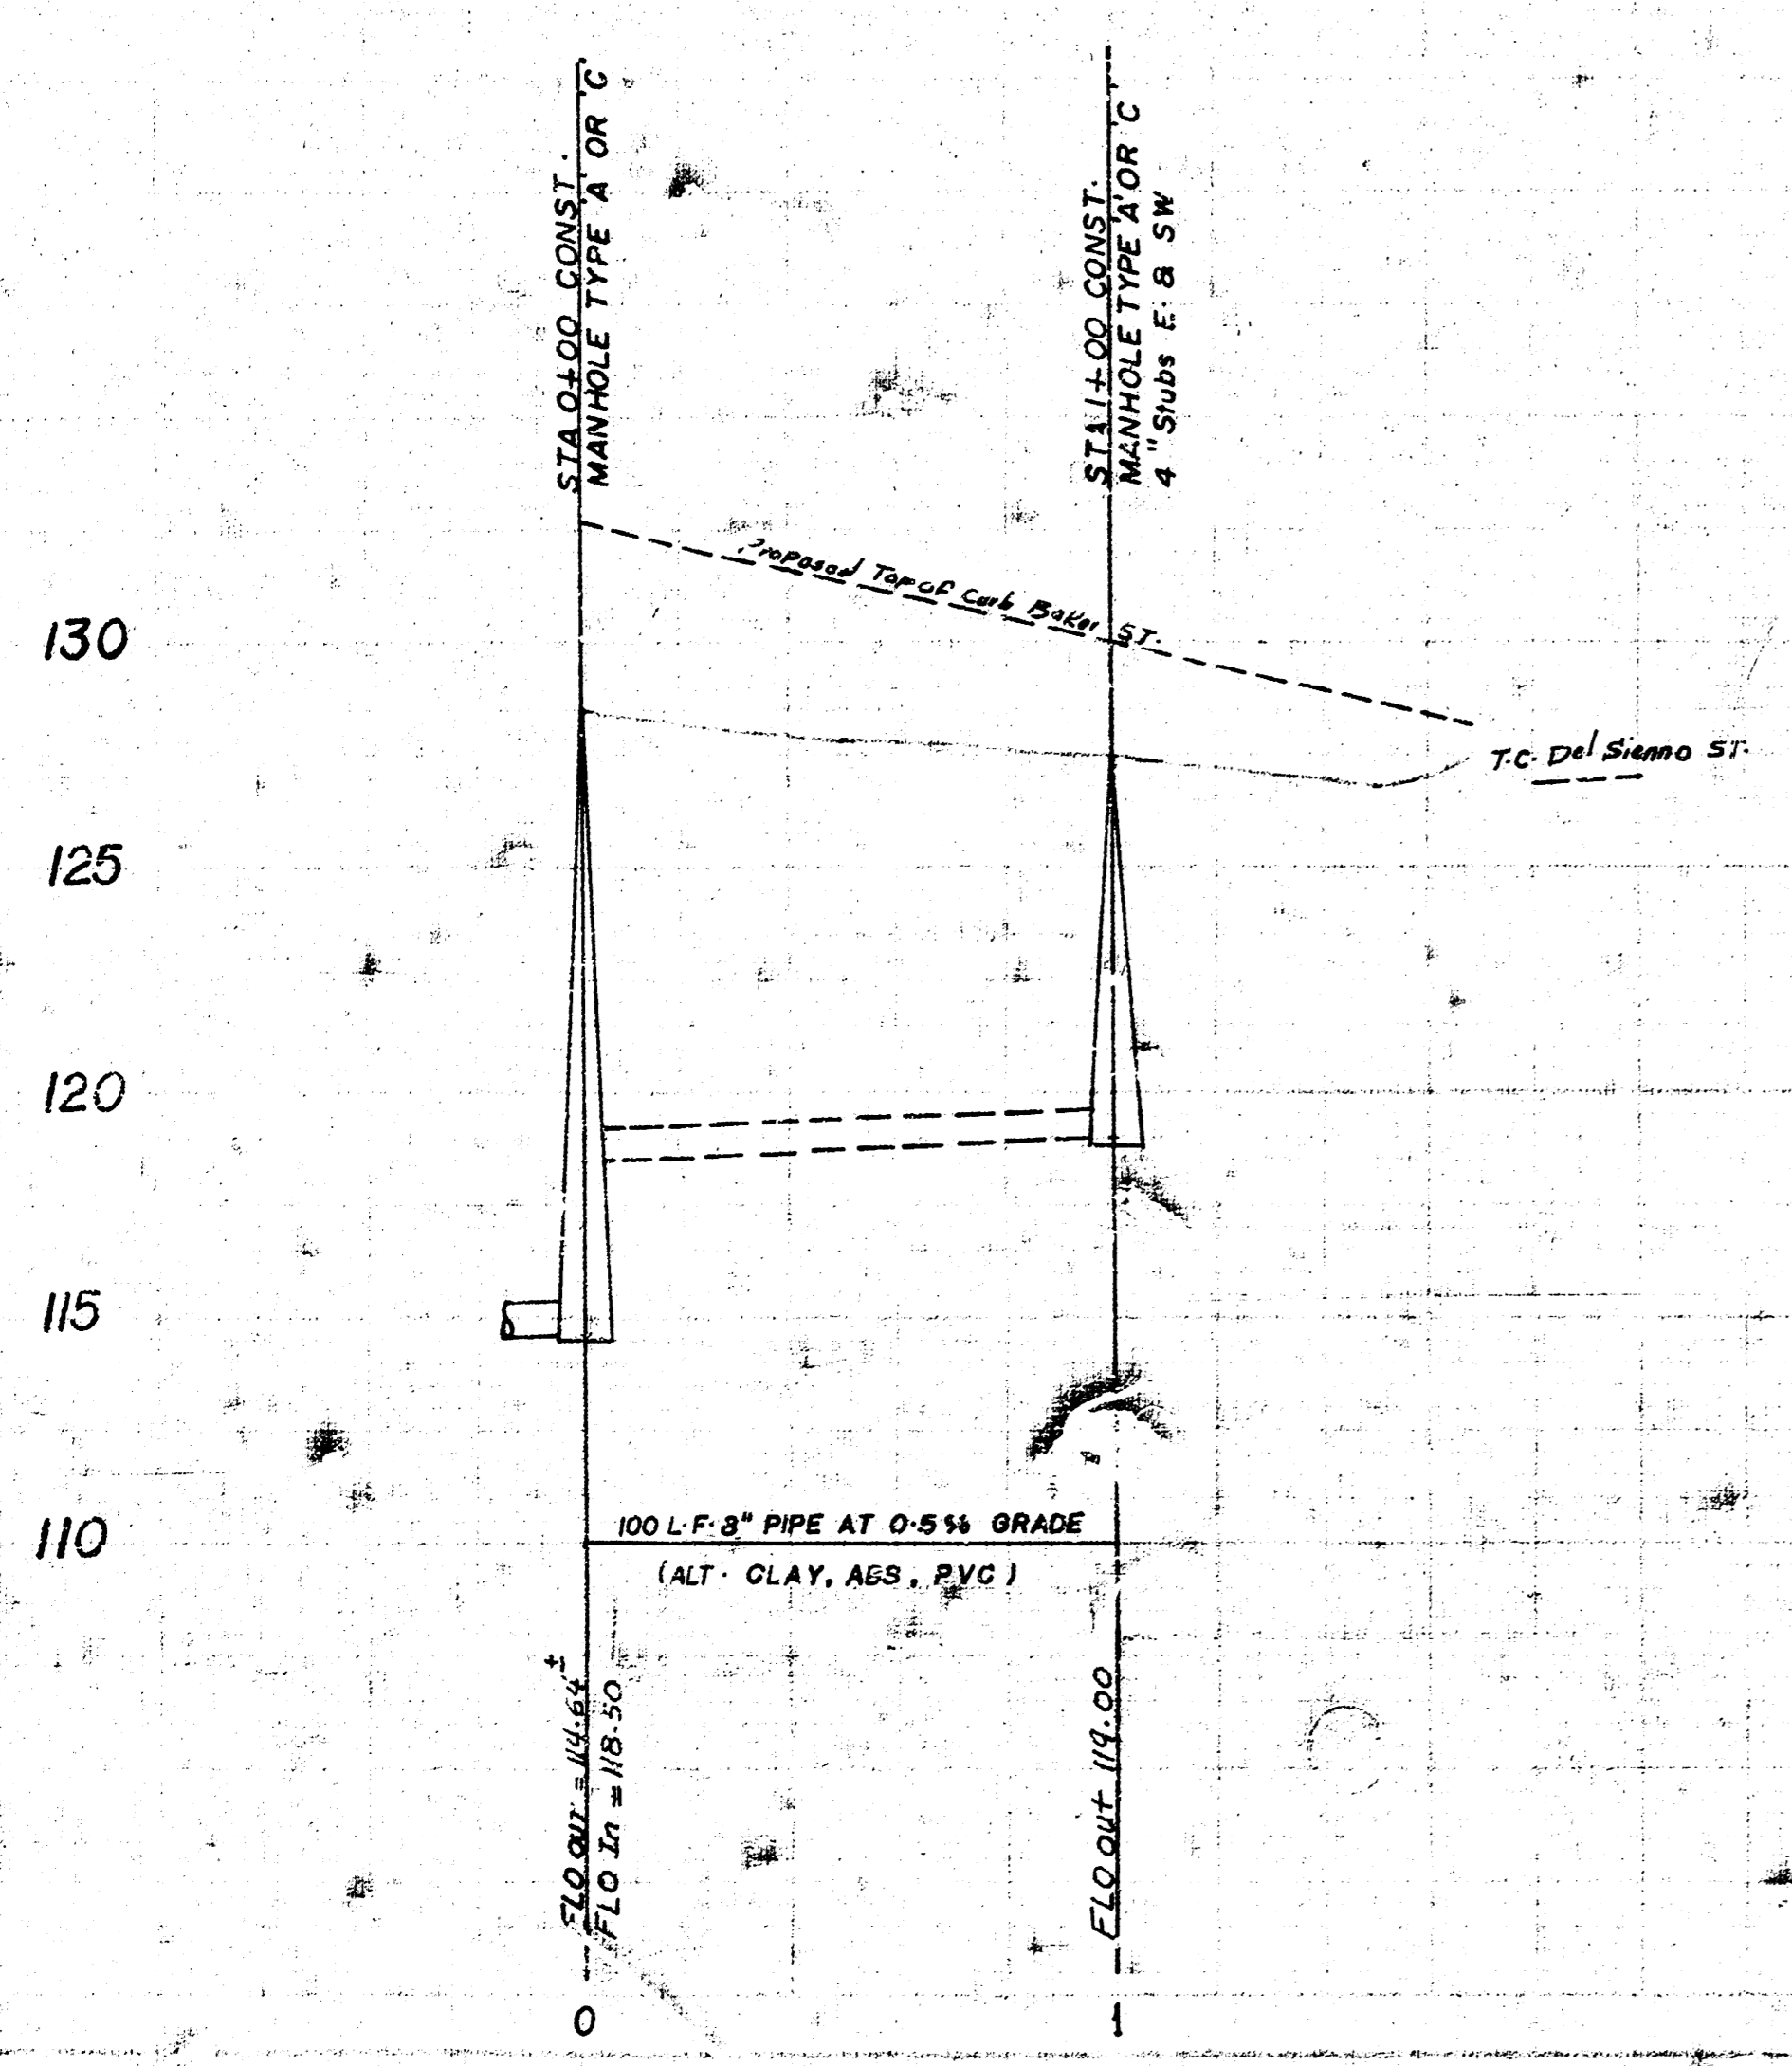

As Built
 4/8/11
JLL

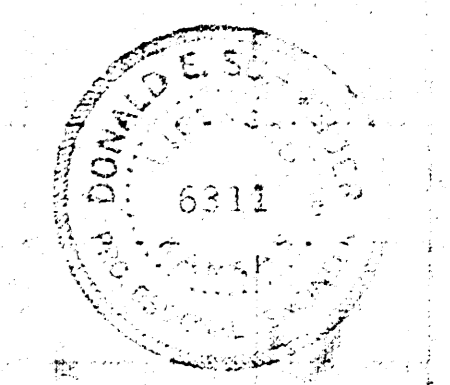

LAT 228 MAIN 5, SS#22
 468-76-245-80008-000-000-001
 City of Wichita, Kansas
 Dept of Public Work - Engineering Div
 Dean Sellers Acting City Engineer
 DATE

17 2 4 1