

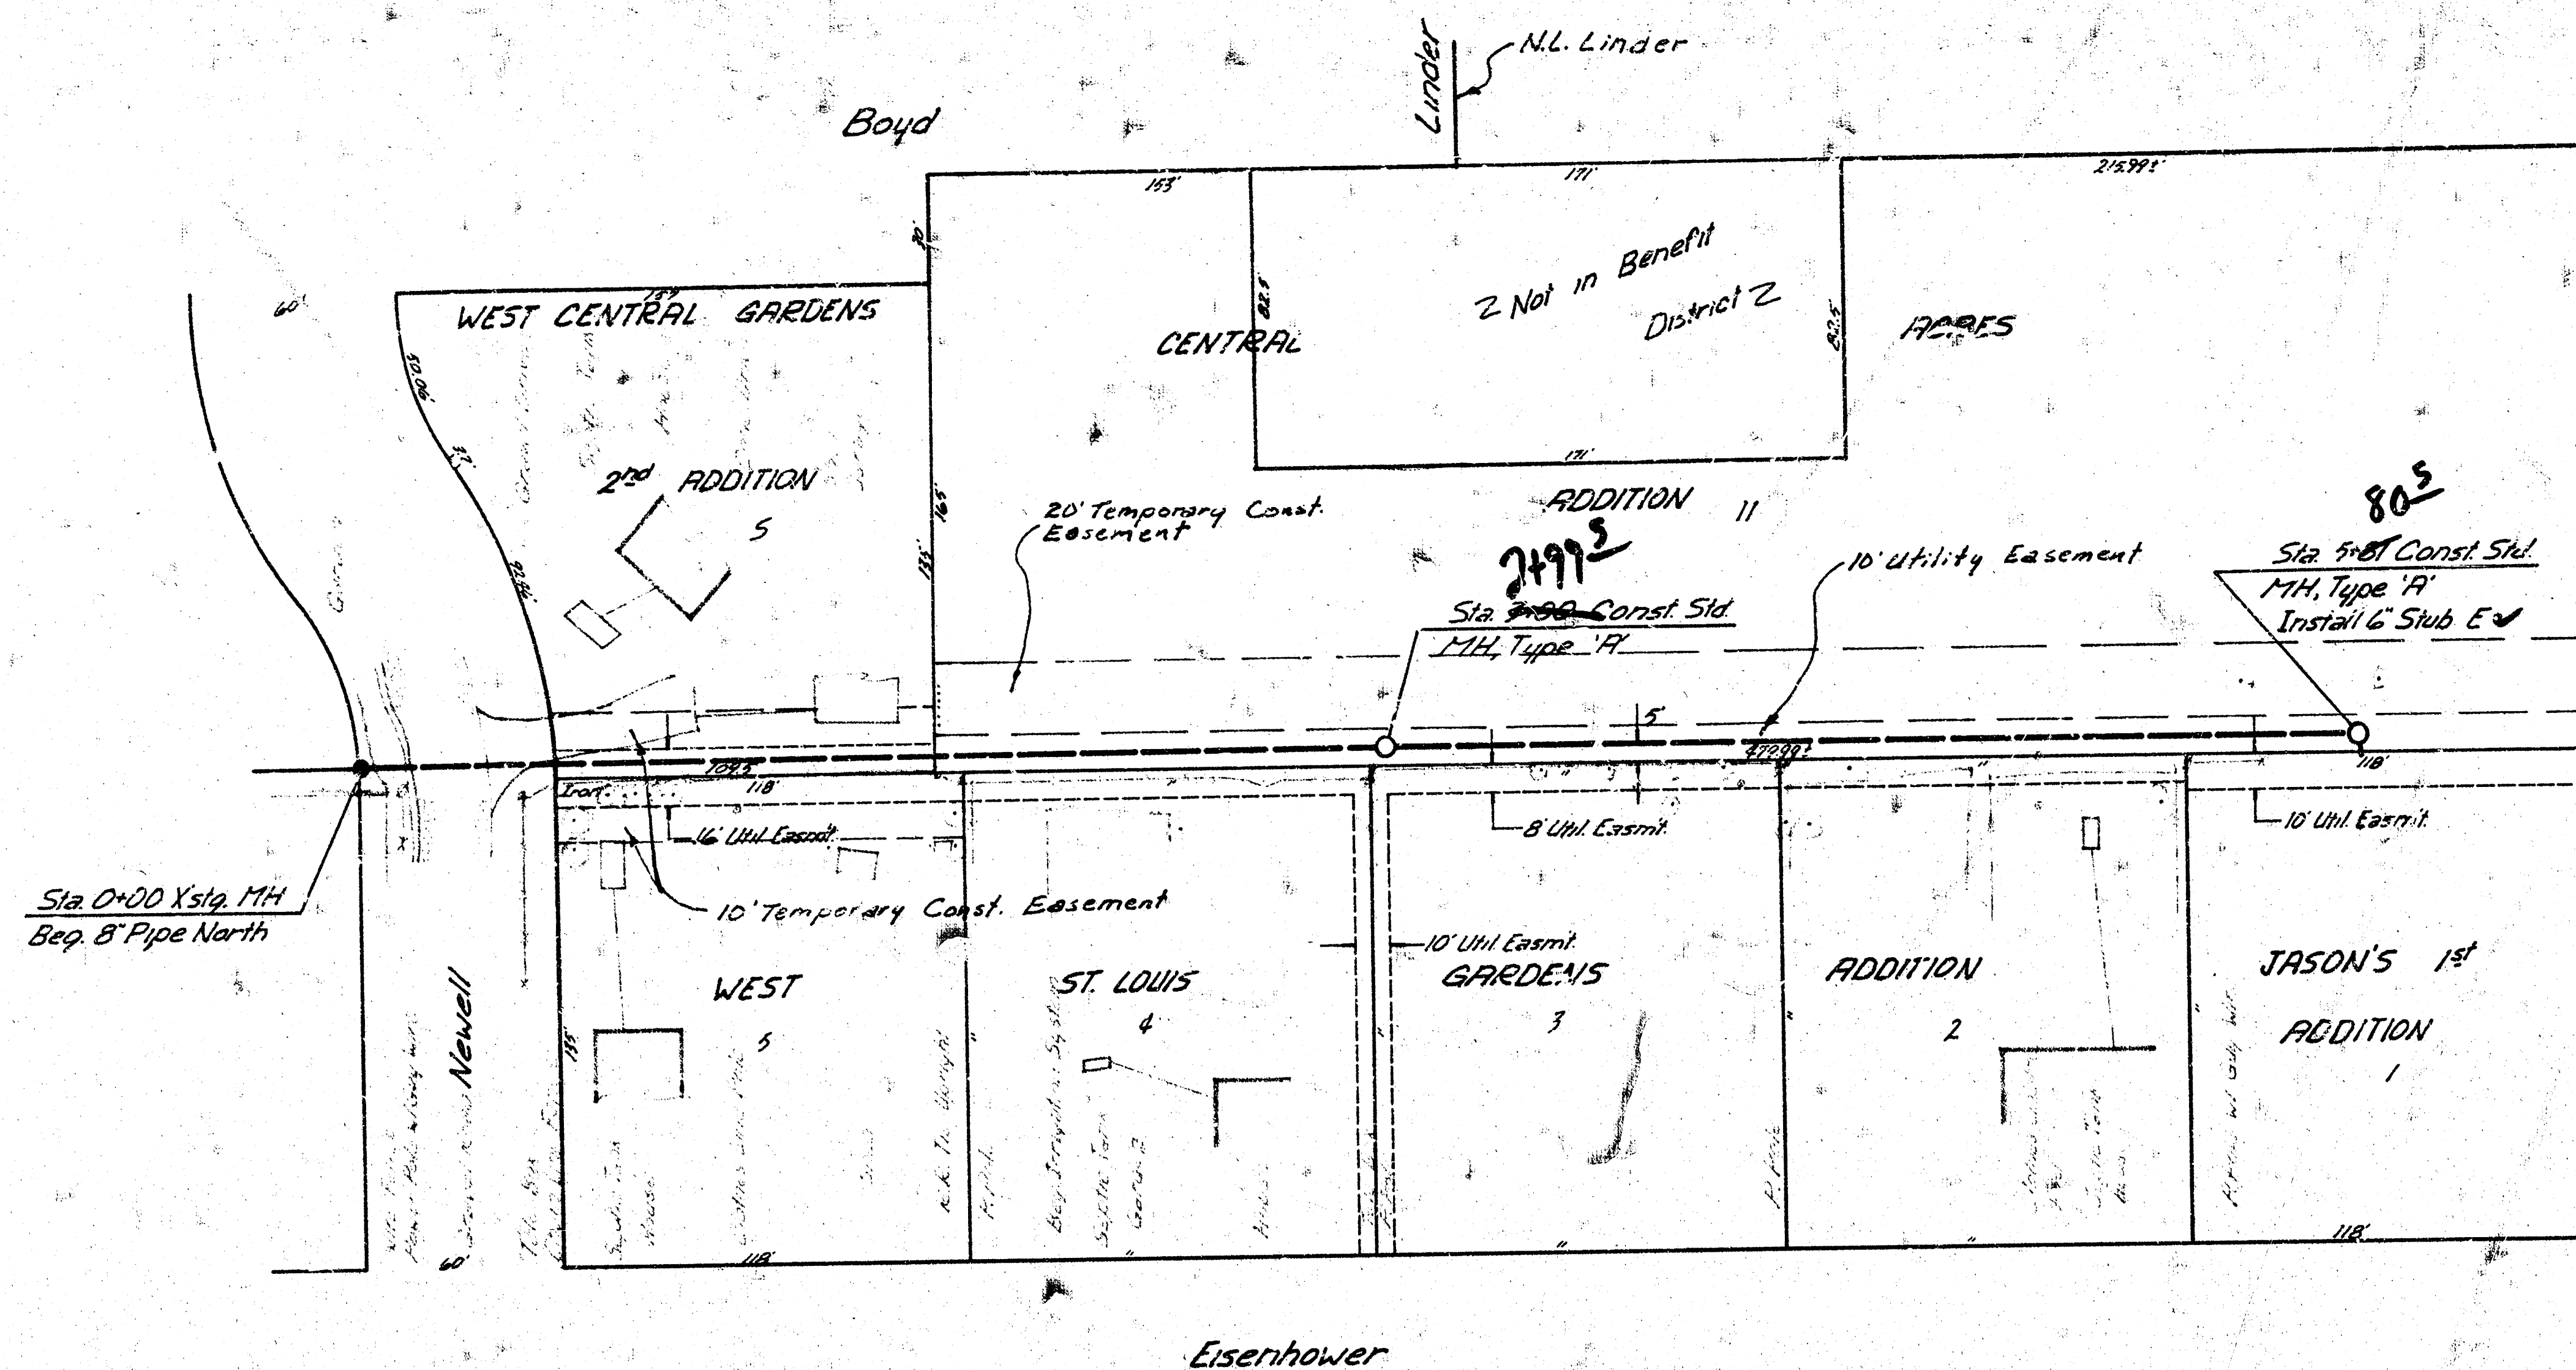


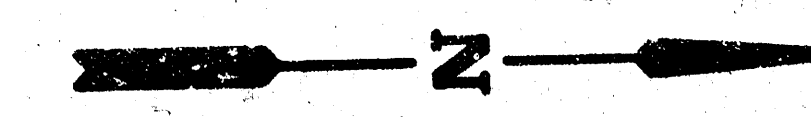



 SCALE
 Hor. 1"=40'
 Vert. 1"=5'

B.M. 172.55 City St. Top of Wing Wall N.E.
 Corner Bridge, Central & Big Ditch
 B.M. 125.04 NE Corner Concrete Porch to
 House @ 709 Eisenhower

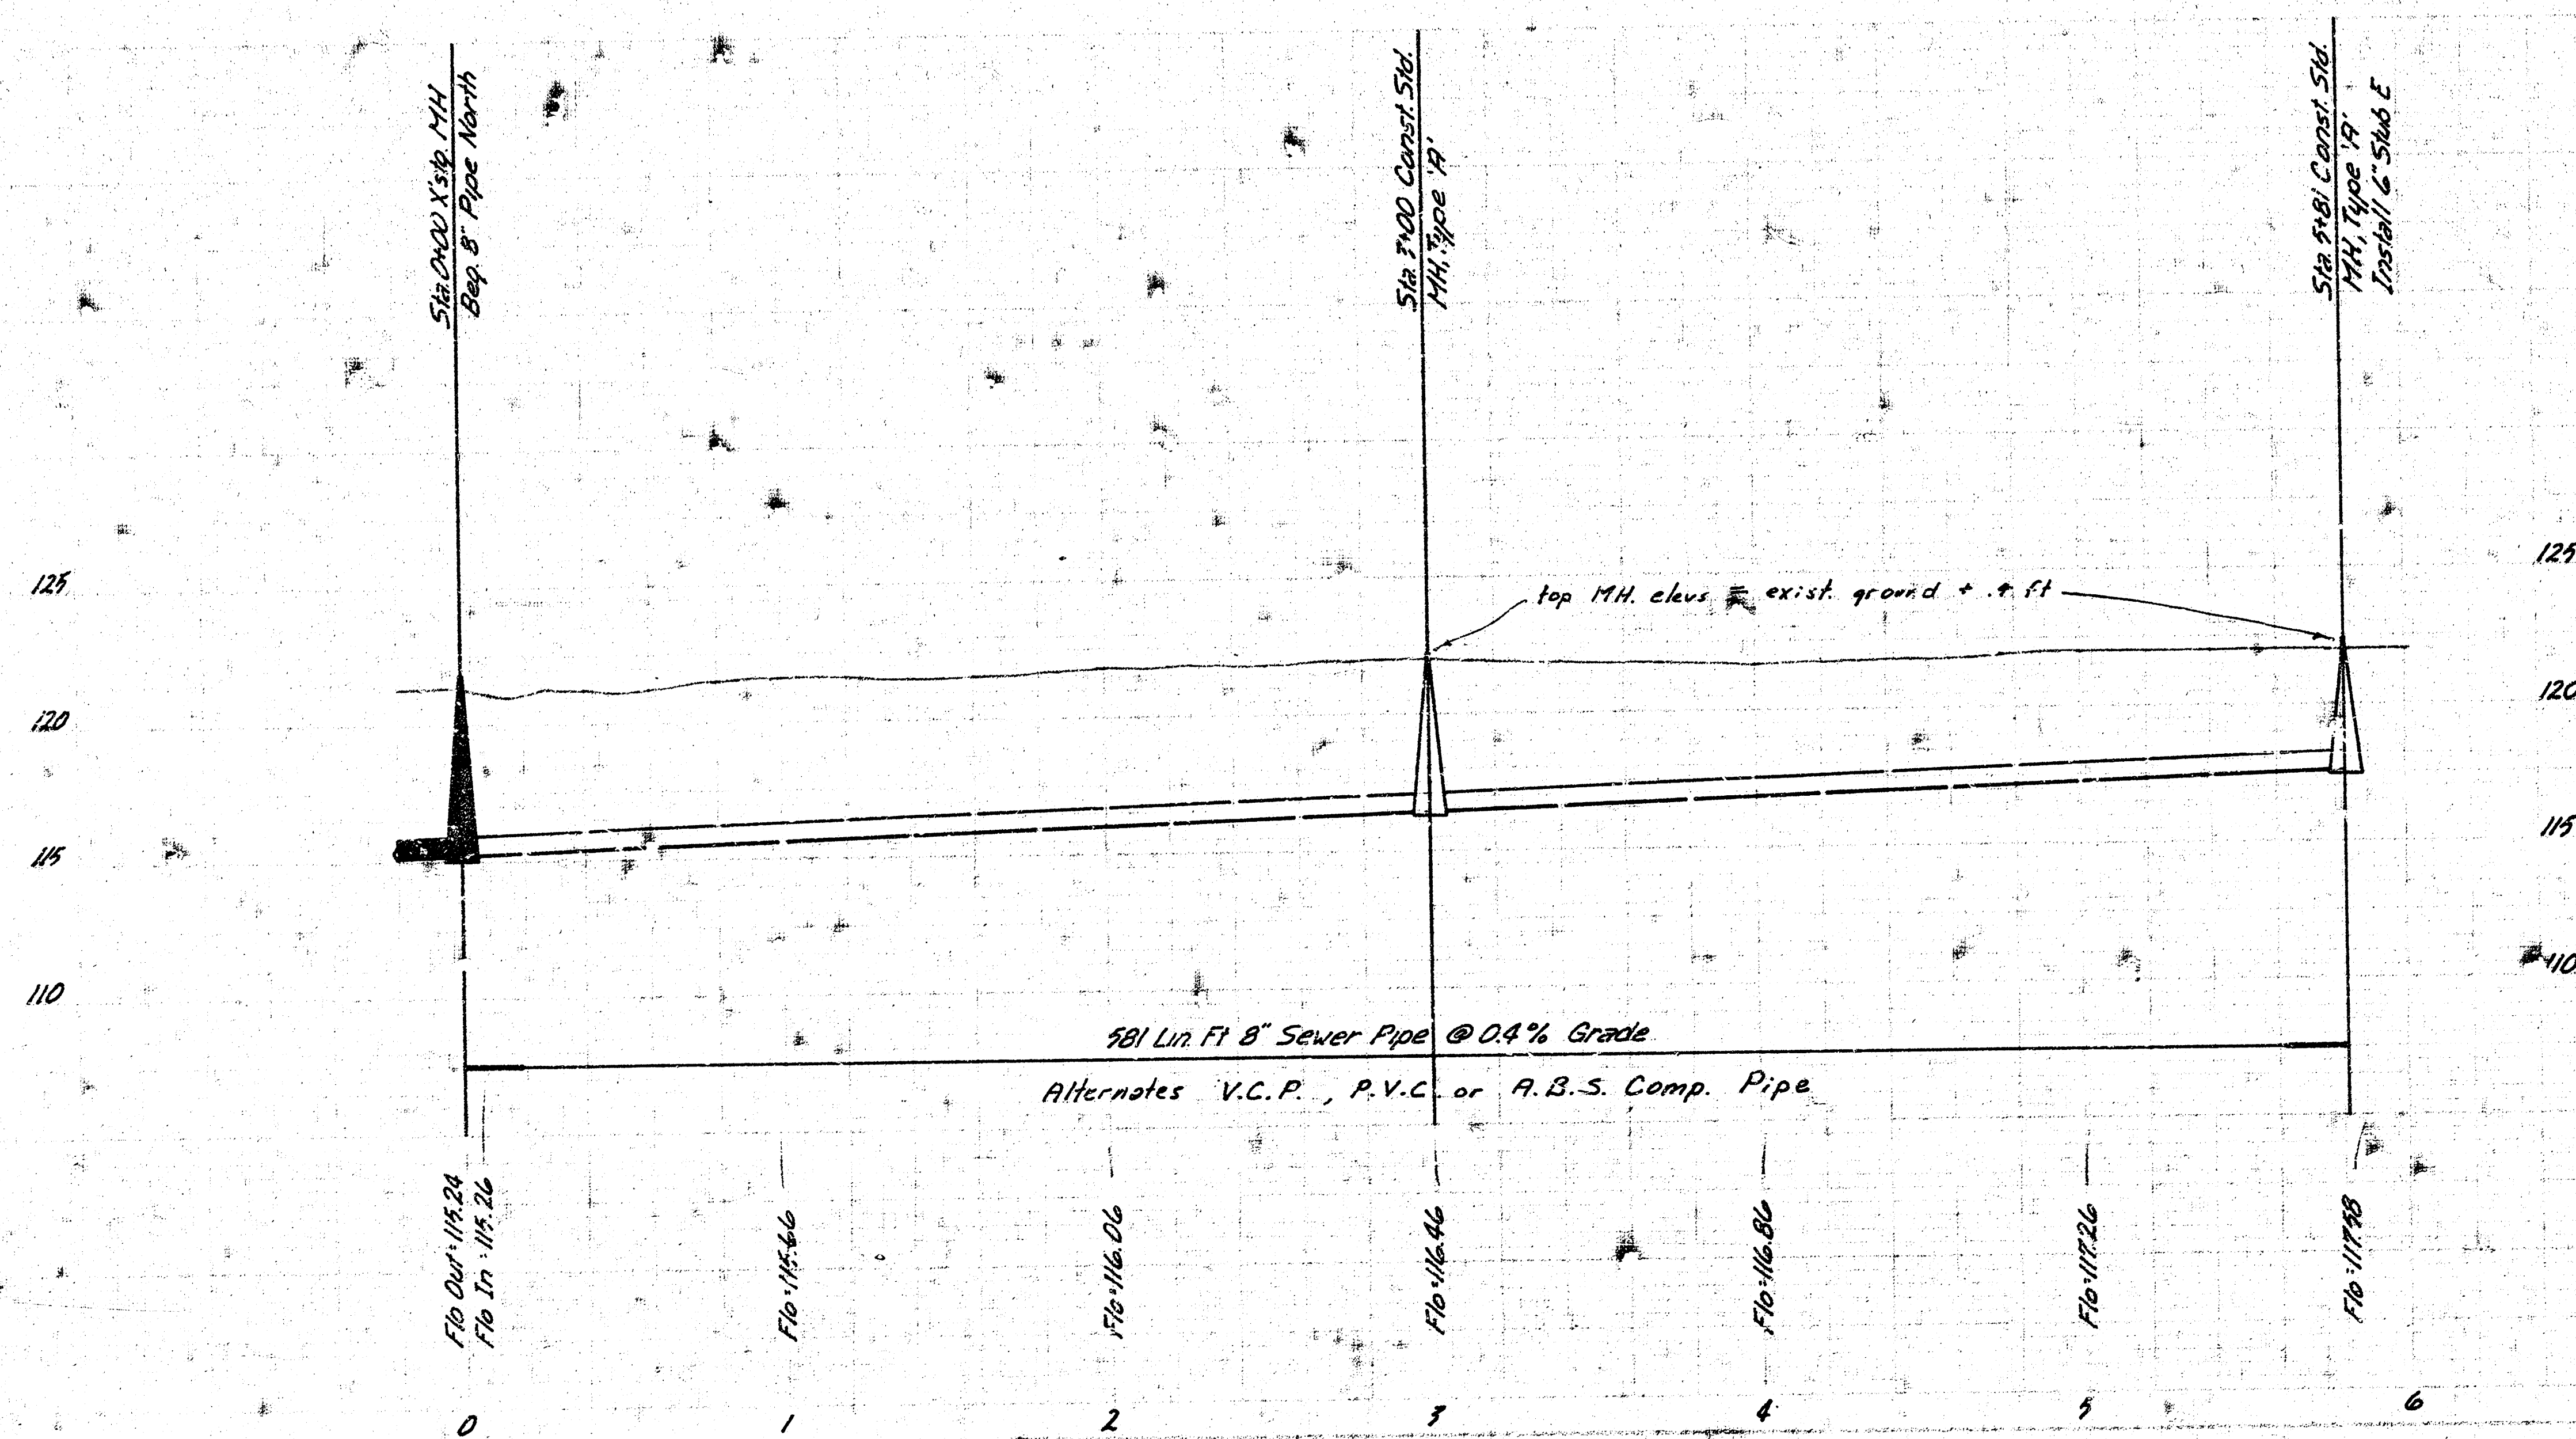

As Built
 JFS
 9/81

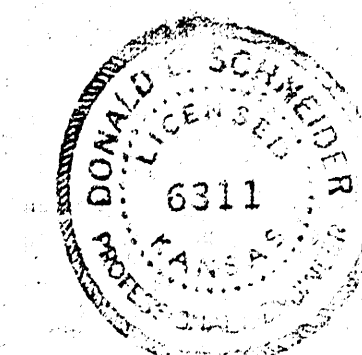

Lat. 231, Main 5, 55 #22
 468-76-245-80929-000-000-001
 City of Wichita, Kansas
 Dept. of Public Works-Eng. Div.
 R.W. Bruggeman - City Engineer