


Sheet
1 of 1





As Built
JLL
1-84

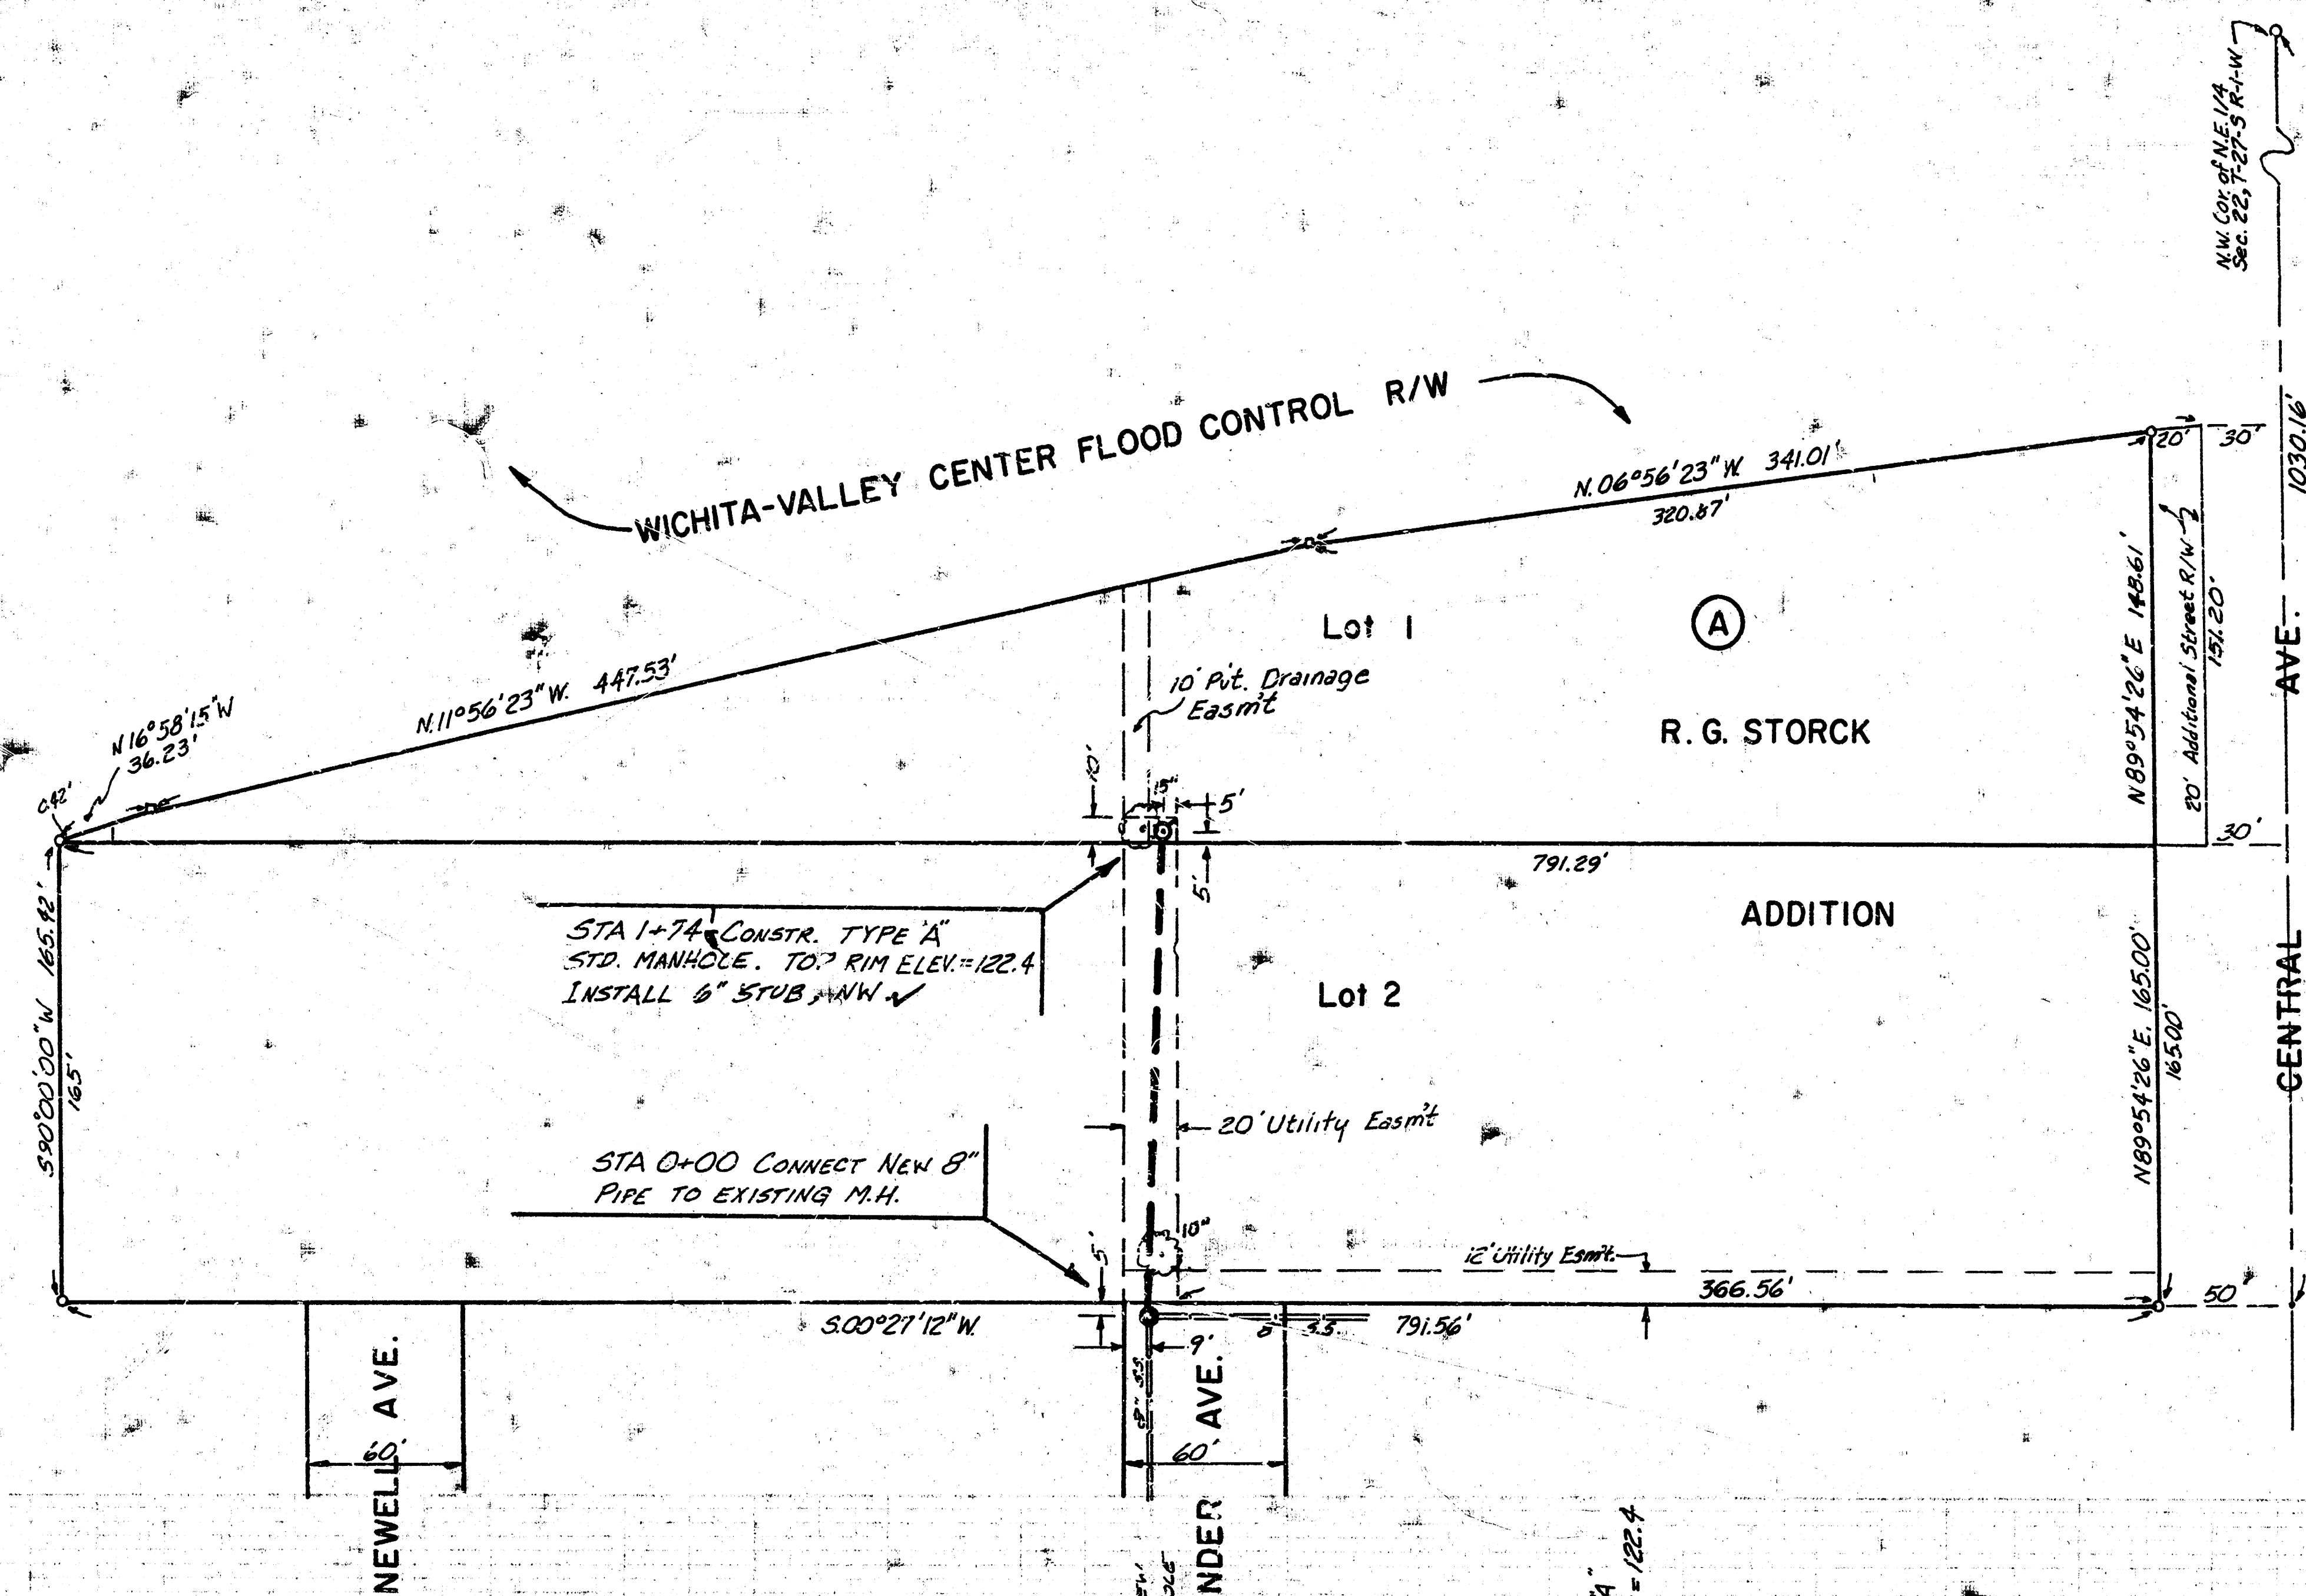

SCALE: Plan 1"=50'
Profile 1"=50' Horiz.
1"=5' Vert.

BENCH MARK: 132.548 - City Std. Disc., NE Corner of Bridge
over Big Ditch Floodway on West Central.

THE CONTRACTOR SHALL BE RESPONSIBLE
FOR PRESERVING PROPERTY IRONS. THE
CONTRACTOR SHALL BE REQUIRED TO RE-
ESTABLISH ANY PROPERTY IRONS WHICH
ARE DAMAGED OR DESTROYED BY HIS CON-
STRUCTION OPERATIONS. SUCH IRONS SHALL
BE RE-ESTABLISHED BY A LICENSED LAND
SURVEYOR OR A LICENSED PROFESSIONAL
ENGINEER IN ACCORDANCE WITH STATE LAWS.

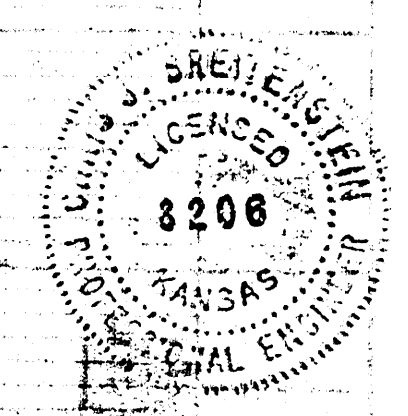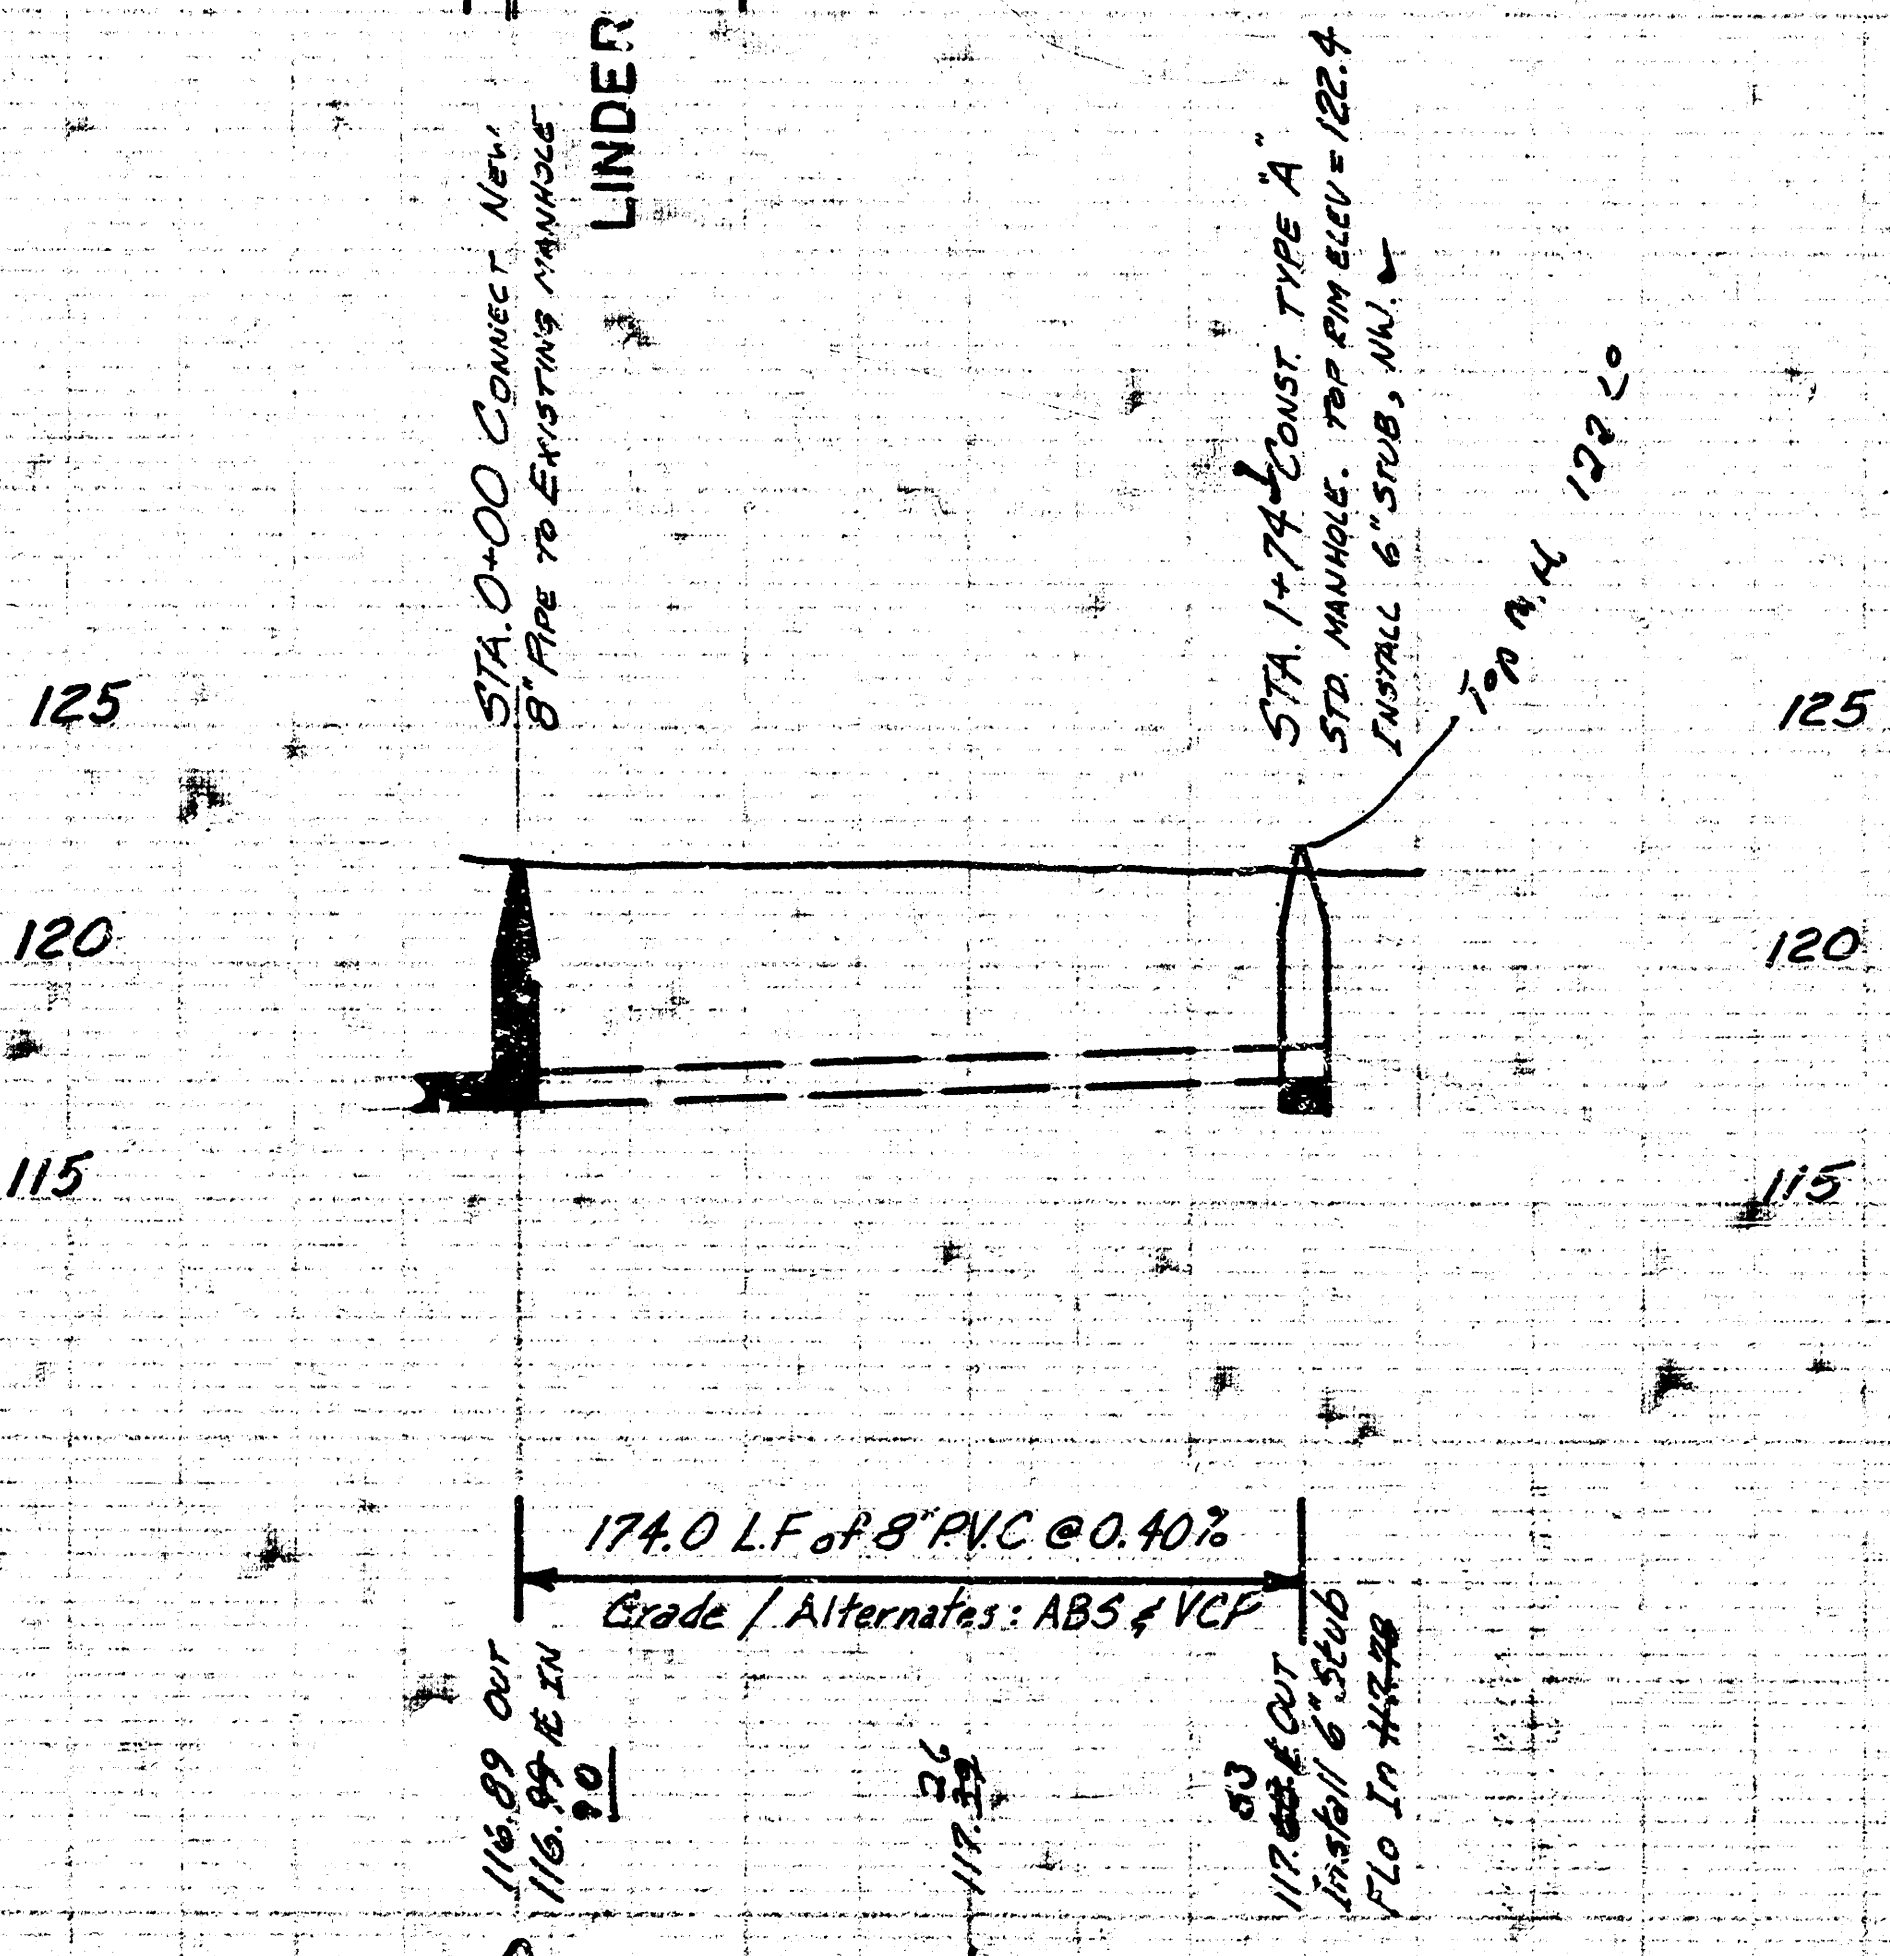

PROJECT DESCRIPTION	
LAT. 239, MAIN 5, S.S. NO. 22	
PROJECT NUMBER	
468-78-245-81298-000-000-00	
BOOK NO.	APPROVED BY
DRAWN BY JNL	DATE 10/1/83
CITY OF WICHITA	
DEPARTMENT OF ENGINEERING	
R.E. LINDBERGH, CITY ENGINEER	
SCALE	

14 1 3 14