



B.M. 121.66 City Std. 10' N and 2' E of S.E. Cor. (30' S. and 92' E. of 6 SHERIDAN and CENTRAL)

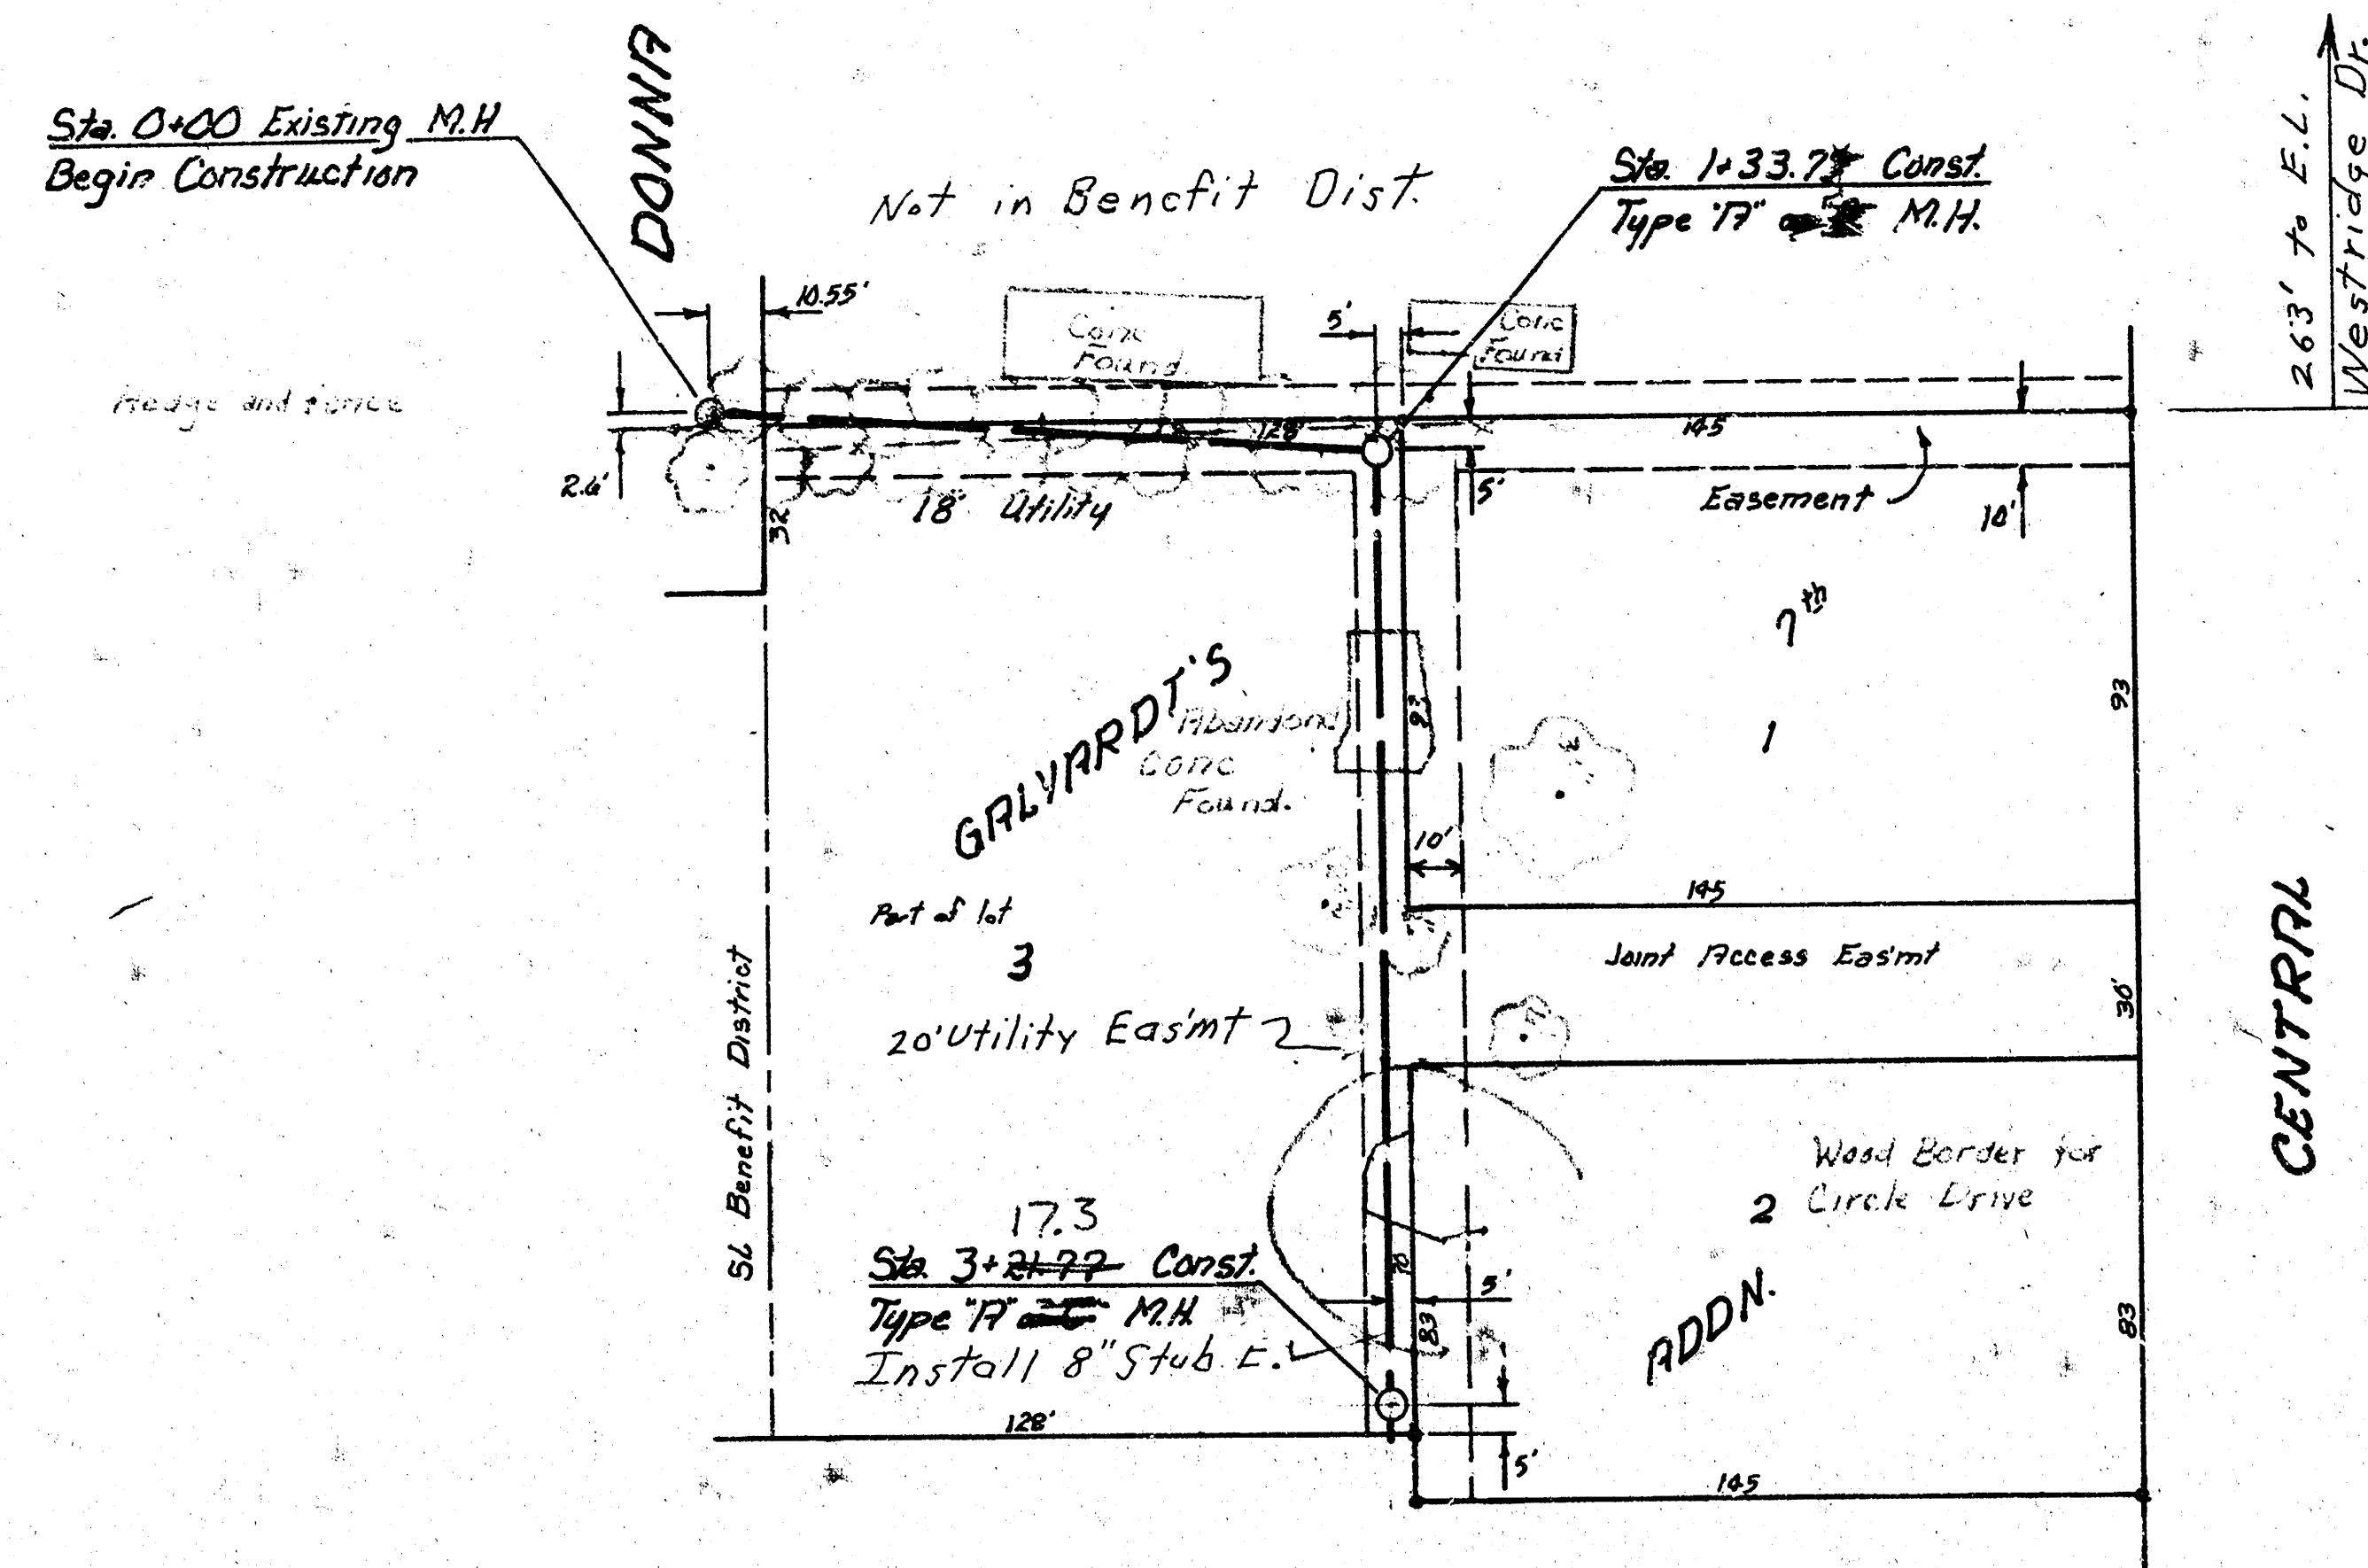


SCALE
 PLAN 1" = 40'
 PROFILE 1" = 40'
 Horiz. 1" = 5'

NOTE: CONTRACTOR SHALL REPLACE WOOD BORDER FOR CIRCLE DRIVE. THIS WORK WILL NOT BE PAID FOR DIRECTLY AND SHALL BE CONSIDERED AS SUBSIDIARY TO THE OTHER ITEMS OF WORK.

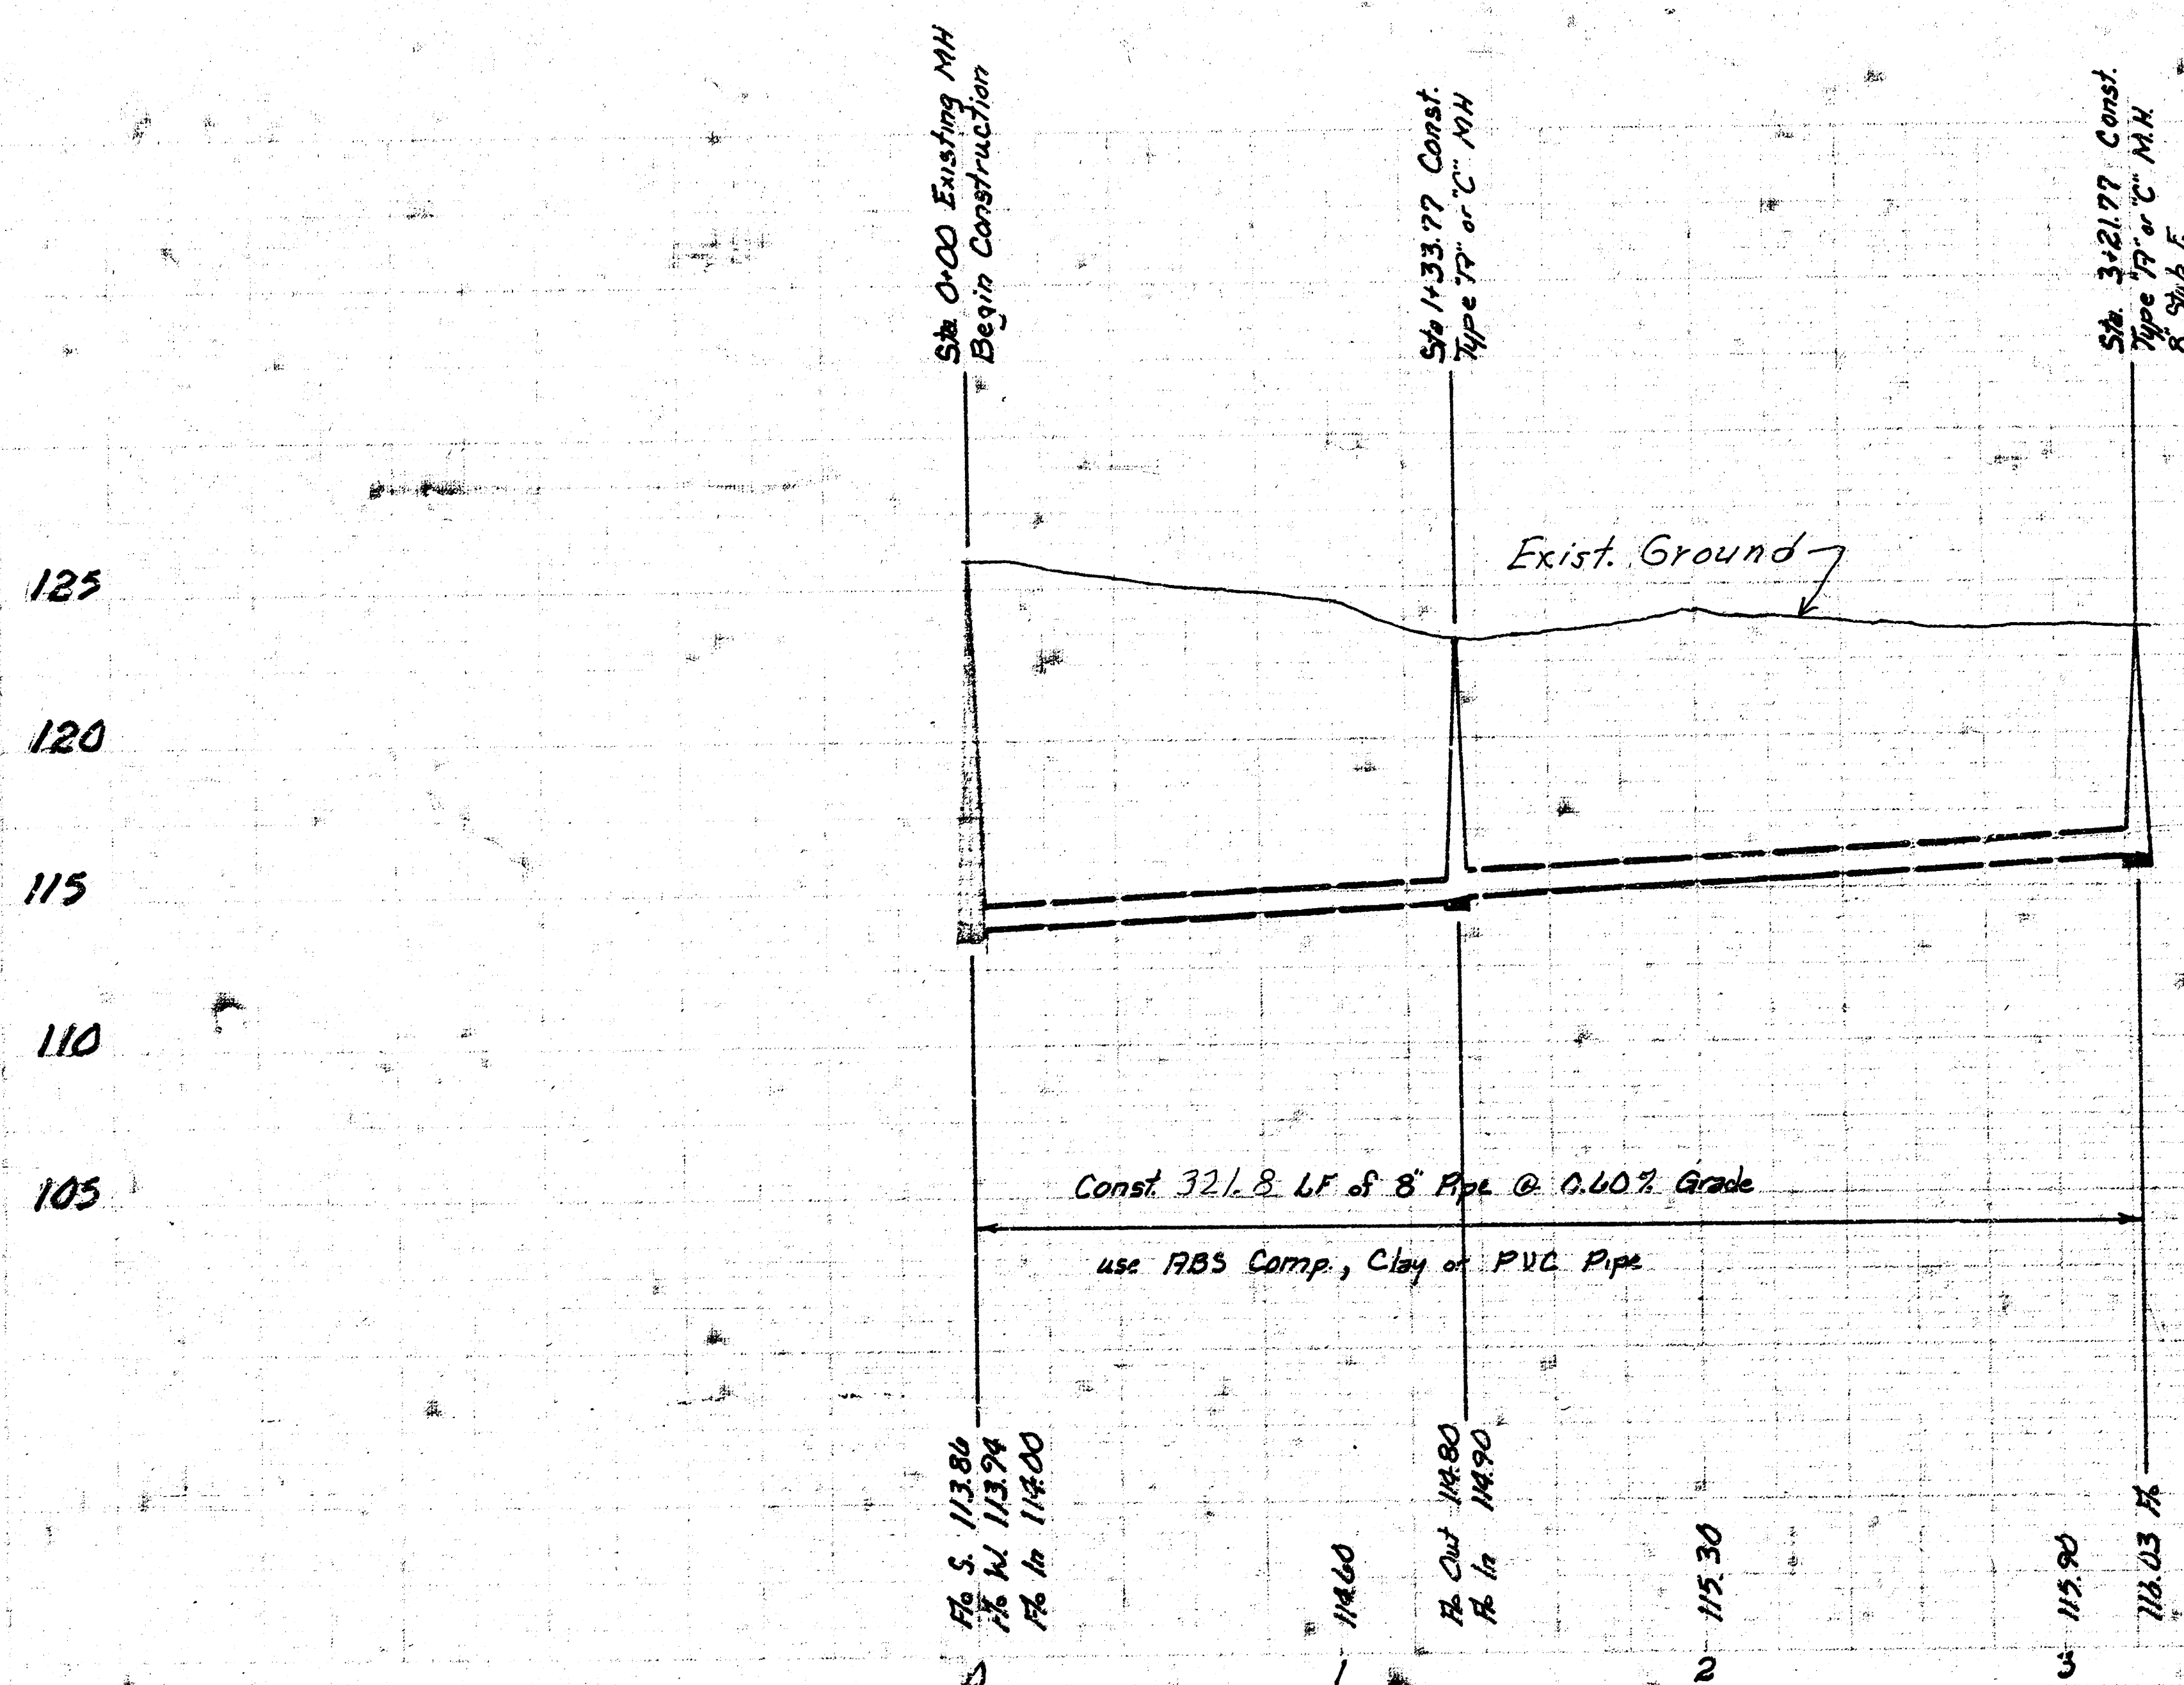

As Built
 1/81
 JLL

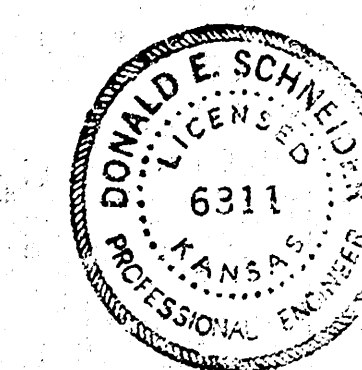

ATERIAL II, MAIN 8, SANITARY SEWER No. 22
 Project No. 448-74-245-80878-000-000-001
 DERN SELLERS ~ Acting City ENGINEER
 WICHITA, KANSAS
 Date: _____