


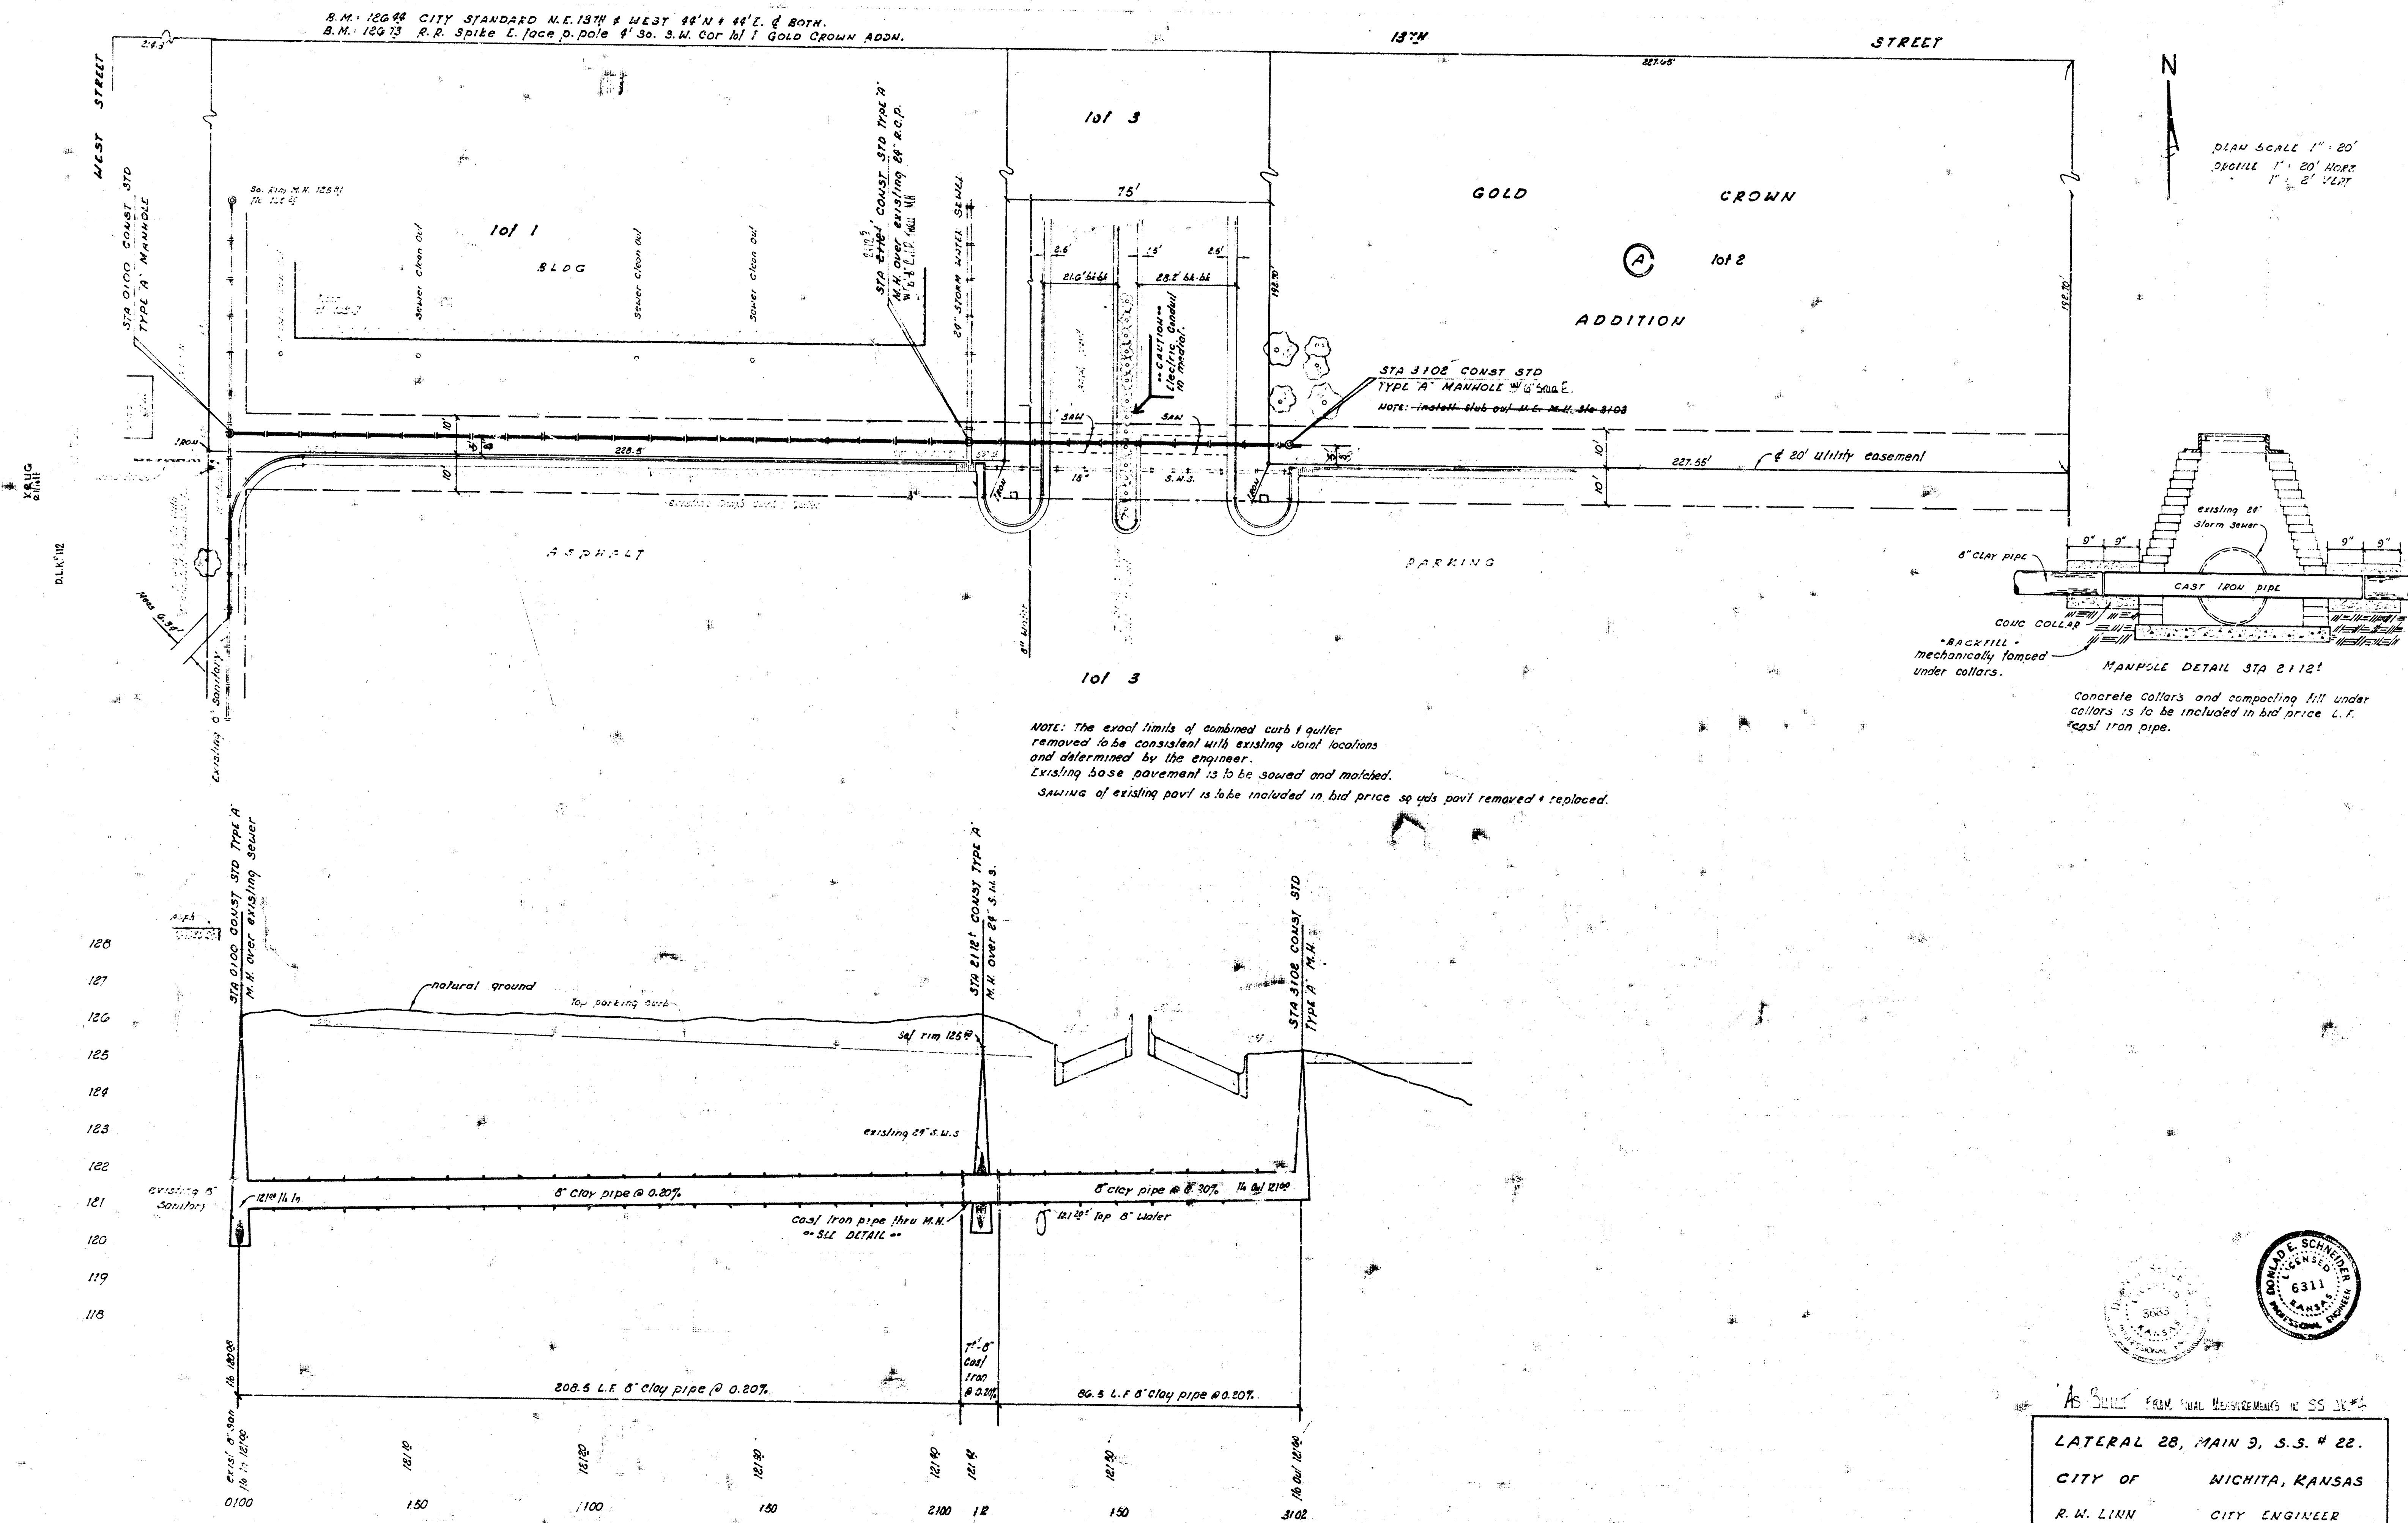

AS BUILT FROM FINAL MEASUREMENTS TO SS 10' 4"

LATERAL 28, MAIN 3, S.S. # 22.

CITY OF NICHITA, KANSAS

R. W. LINN CITY ENGINEER

DATE Sept. 1922 PROJ. NO. DBKL 572043