



BM 135.05 R.R. Spike on West Side of PP on N.E. corner of 39th St. N. & Charles St.  
 BM 137.49 R.R. Spike on West Side of PP Approx. 5' North & 5' East of the SW.  
 corner of Lot 6, Block 2, Womers Sherwood Glen Addition

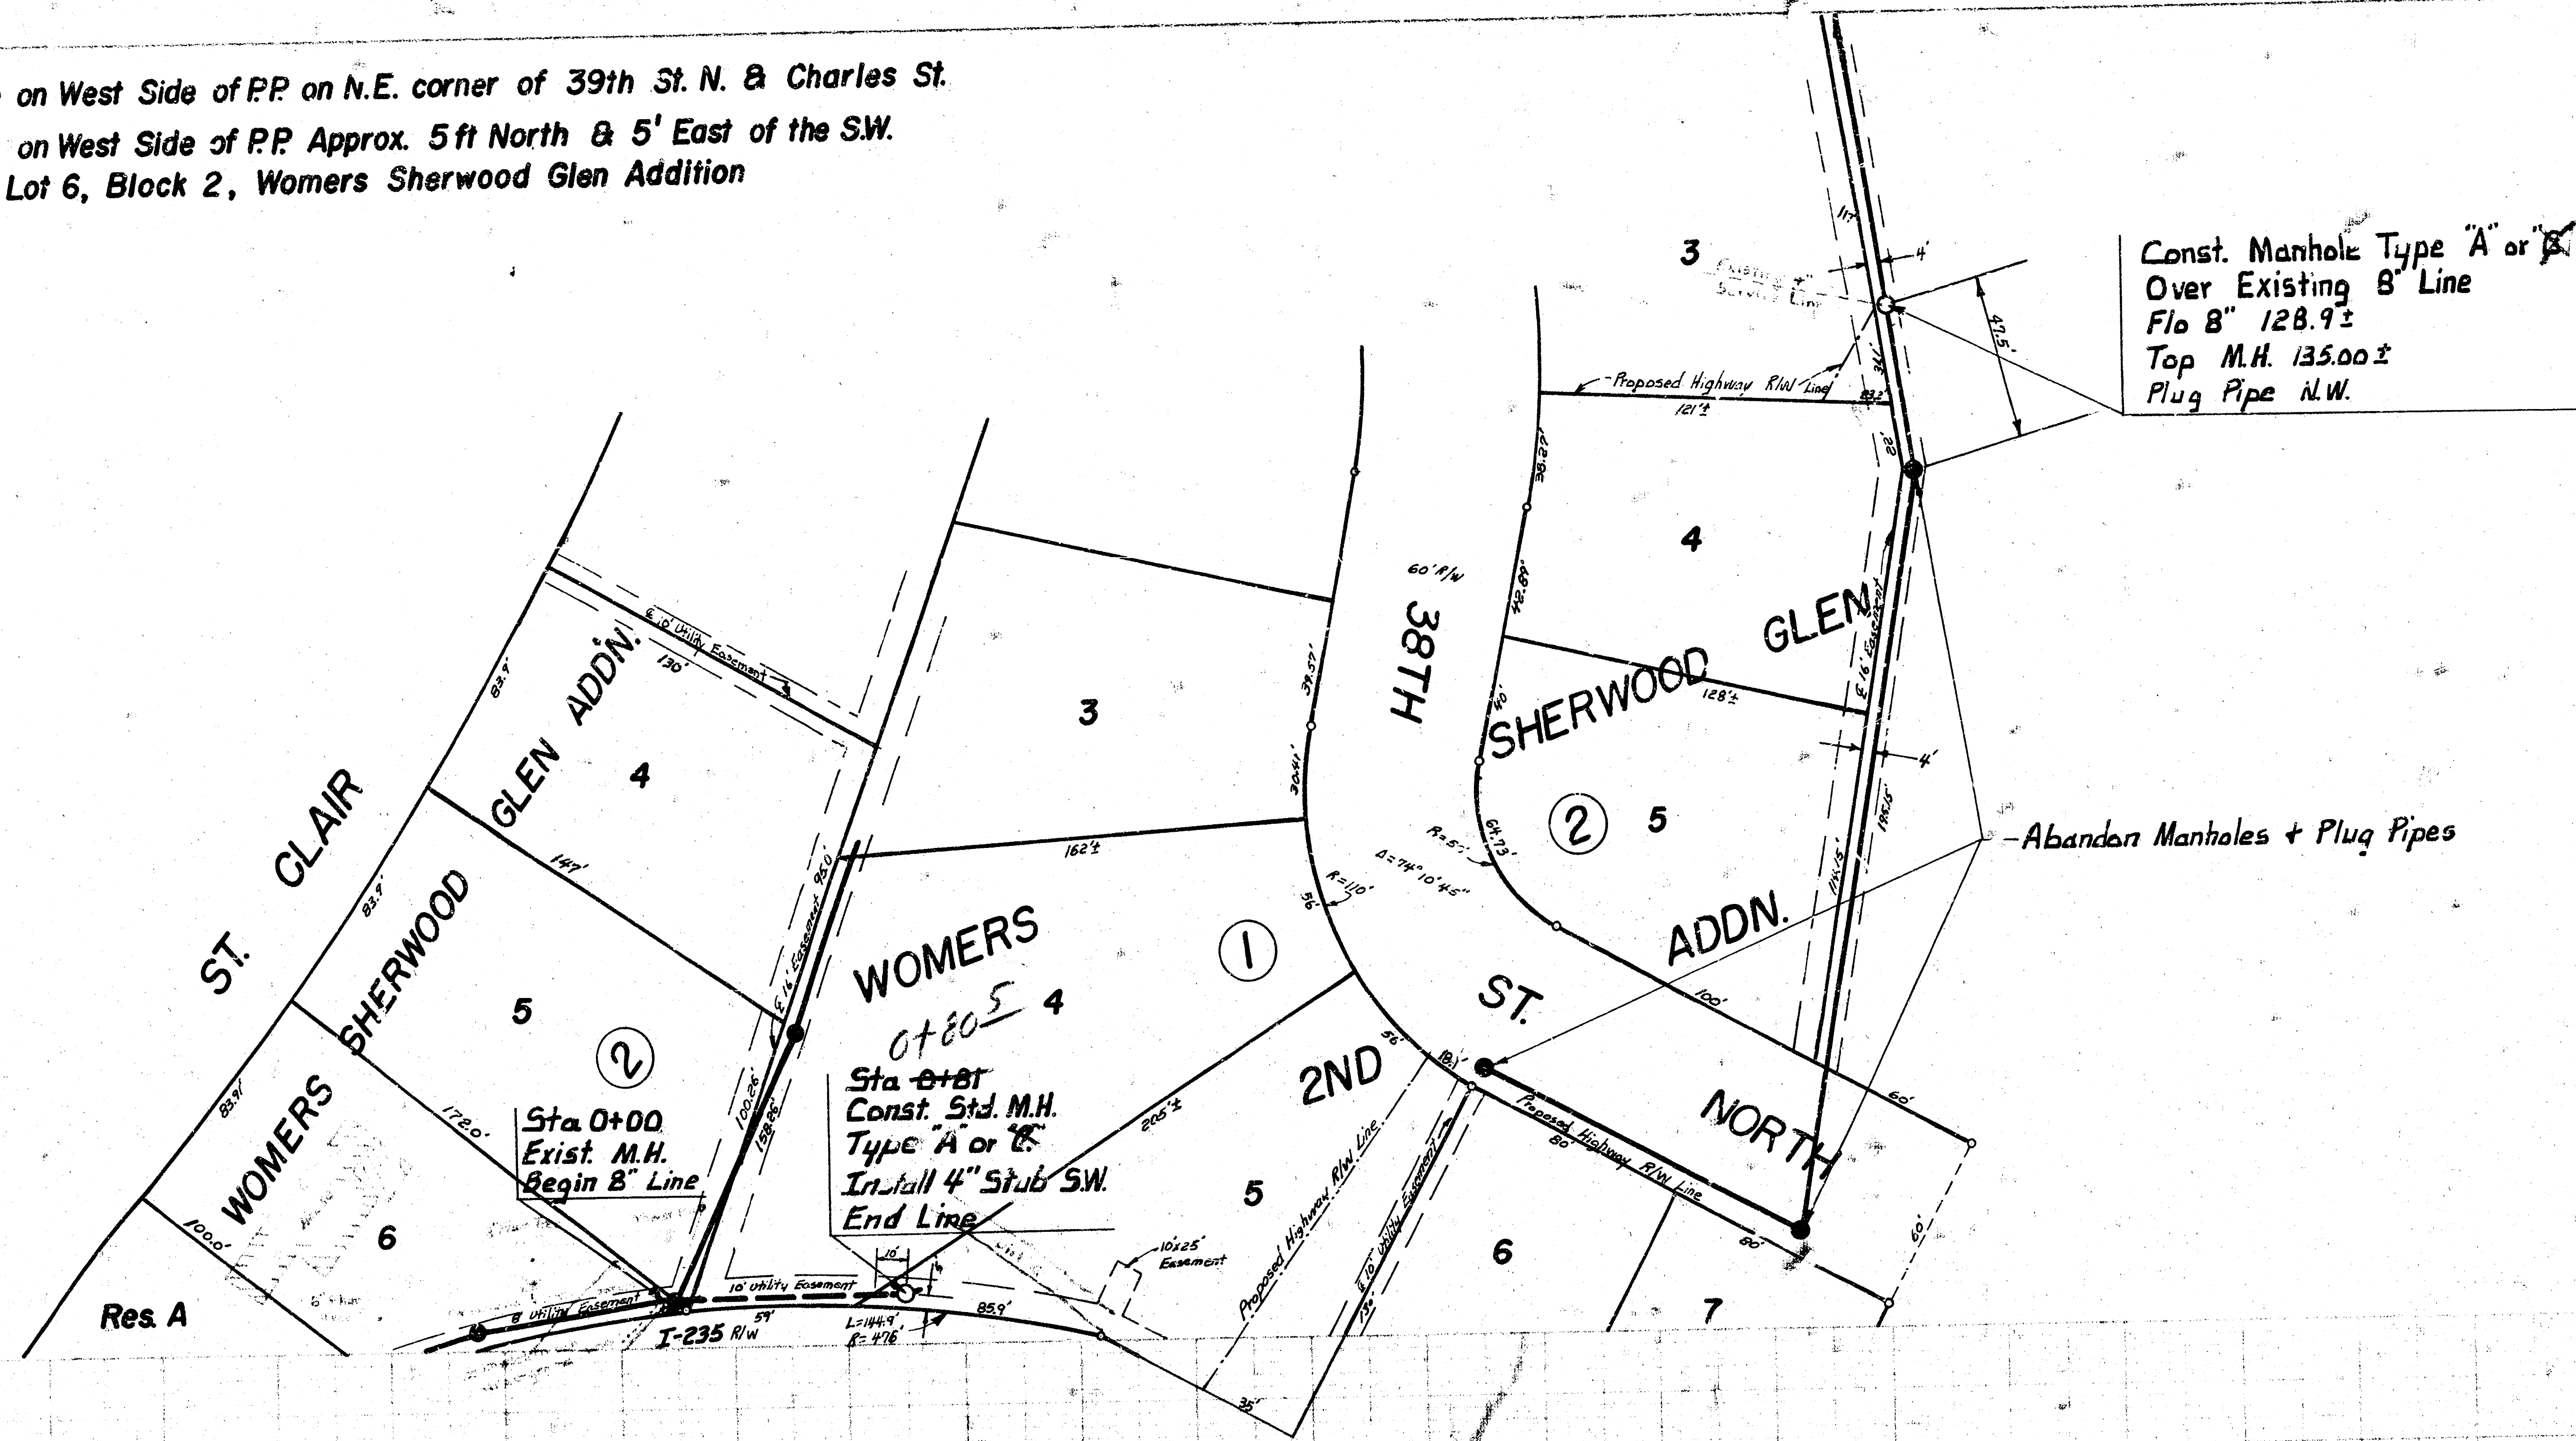

Plan Scale 1" = 40'  
 Profile Scale 1" = 40' Horz.  
 1" = 5' Vert.

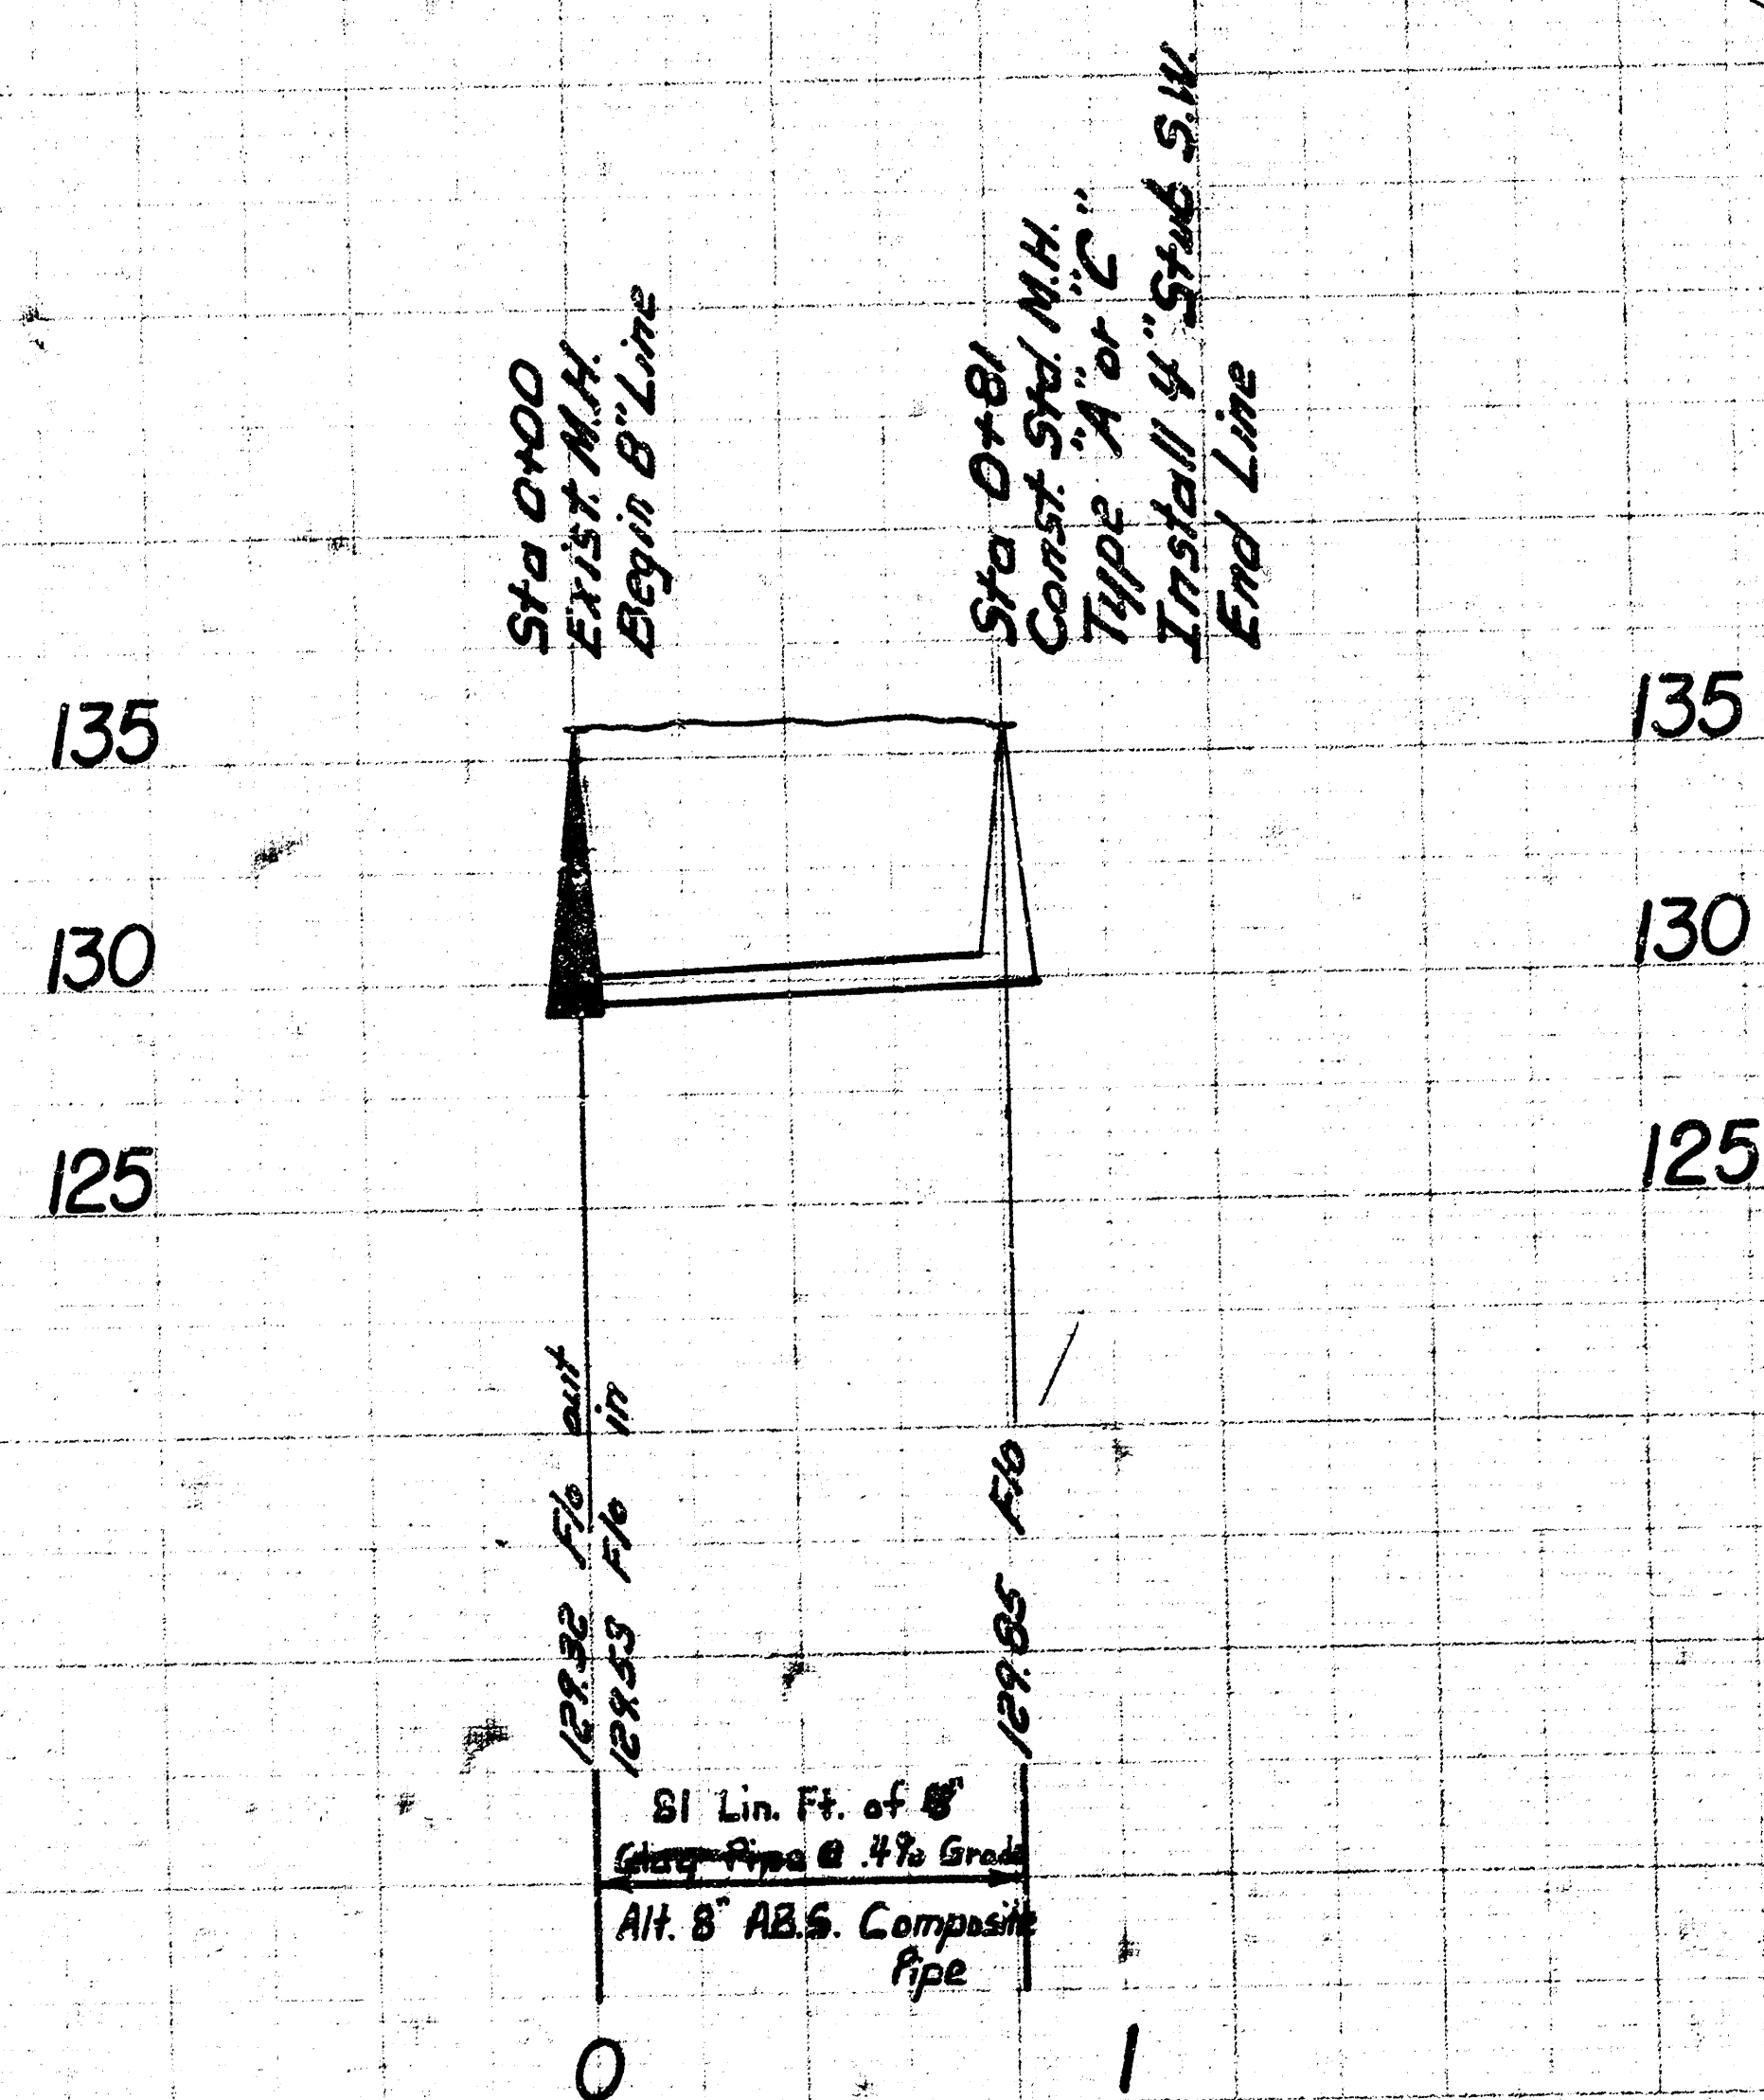

As built 4-21-78

Relocation of a portion of Lat. 29 Main 10 S.S. 22  
 CITY OF WICHITA, KANSAS  
 R.W. LINN CITY ENGINEER  
 DATE: PROJECT NO. DAKR500580