
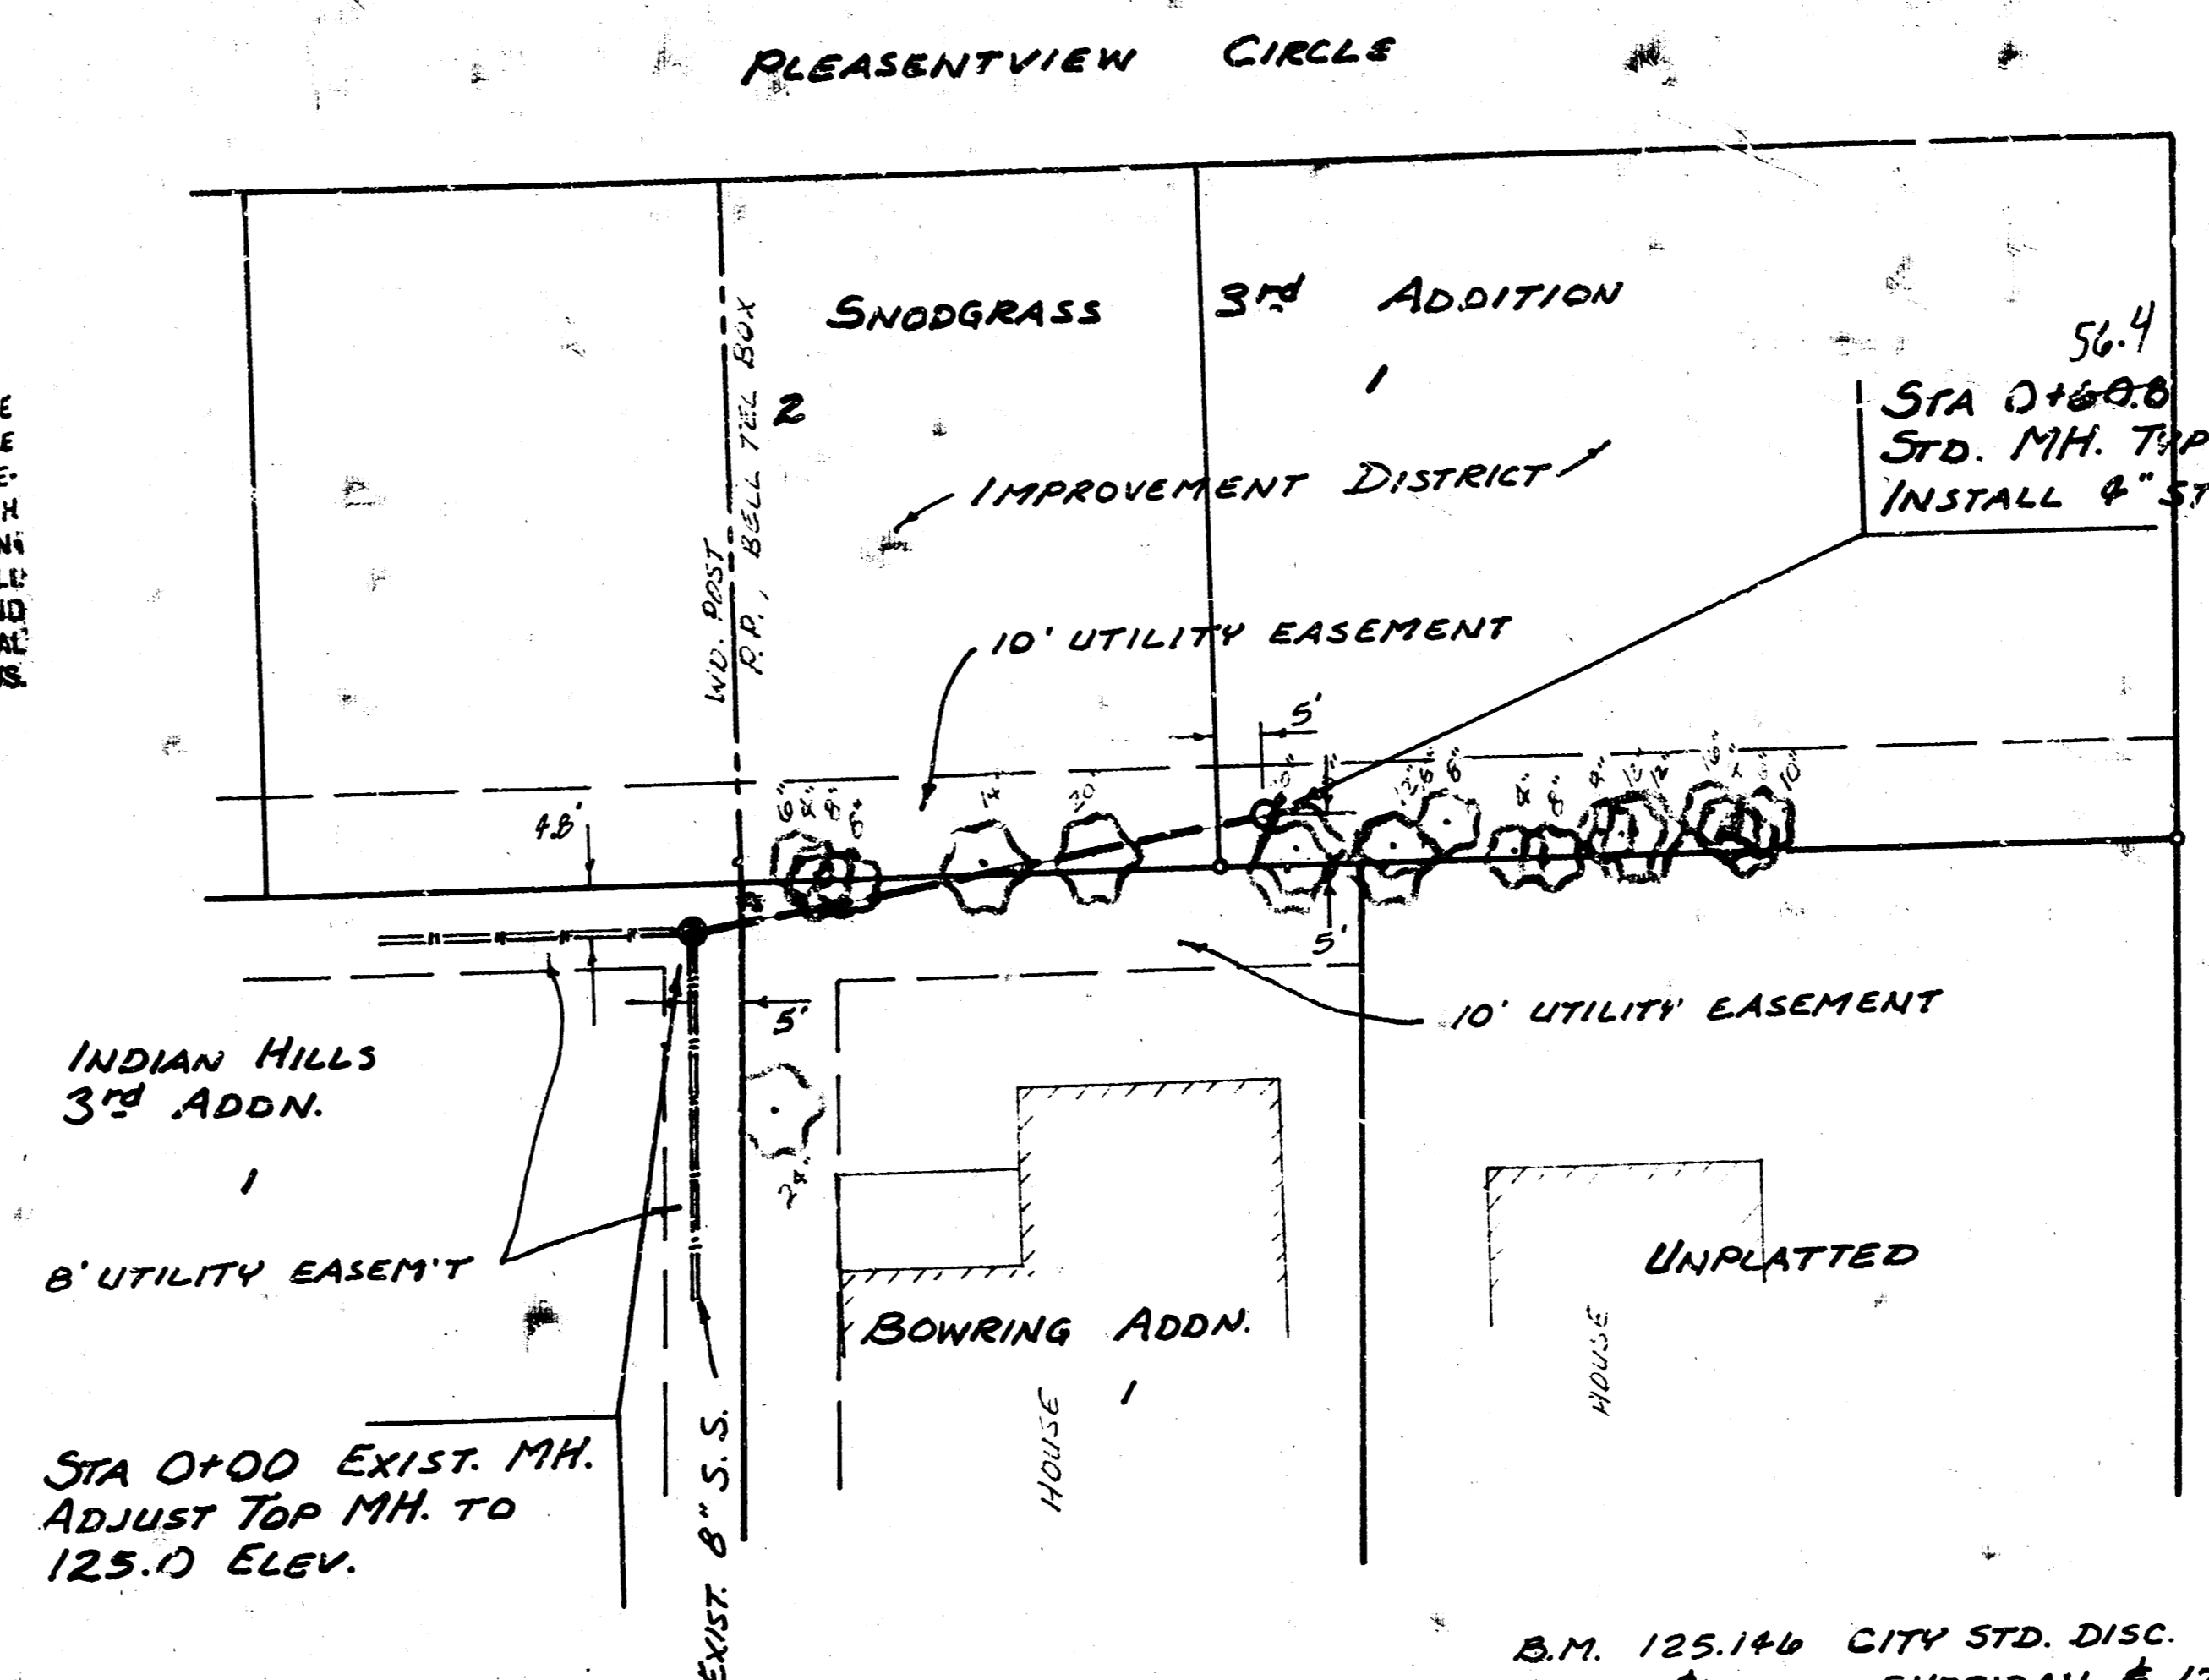


SCALE PLAN 1" = 20'  
 PROFILE 1" = 20' HORIZ  
 1" = 5' VERT.

**CAUTION  
 UNDERGROUND  
 UTILITIES**  
 Please check with K & K or  
 Southwestern Bell  
 Telephone Co. for Location



THE CONTRACTOR SHALL BE RESPONSIBLE  
 FOR PRESERVING PROPERTY IRONS. THE  
 CONTRACTOR SHALL BE REQUIRED TO RE-  
 ESTABLISH ANY PROPERTY IRONS WHICH  
 ARE DAMAGED OR DESTROYED BY HIS CON-  
 STRUCTION OPERATIONS SUCH IRONS SHALL  
 BE RE-ESTABLISHED BY A LICENSED LAND  
 SURVEYOR OR A LICENSED PROFESSIONAL  
 ENGINEER IN ACCORDANCE WITH STATE LAWS.

NOTE: Field Engineer shall approval removal  
 any tree on this Project. Contractor  
 shall coordinate removal of trees with  
 the property owners and Field Engineer.

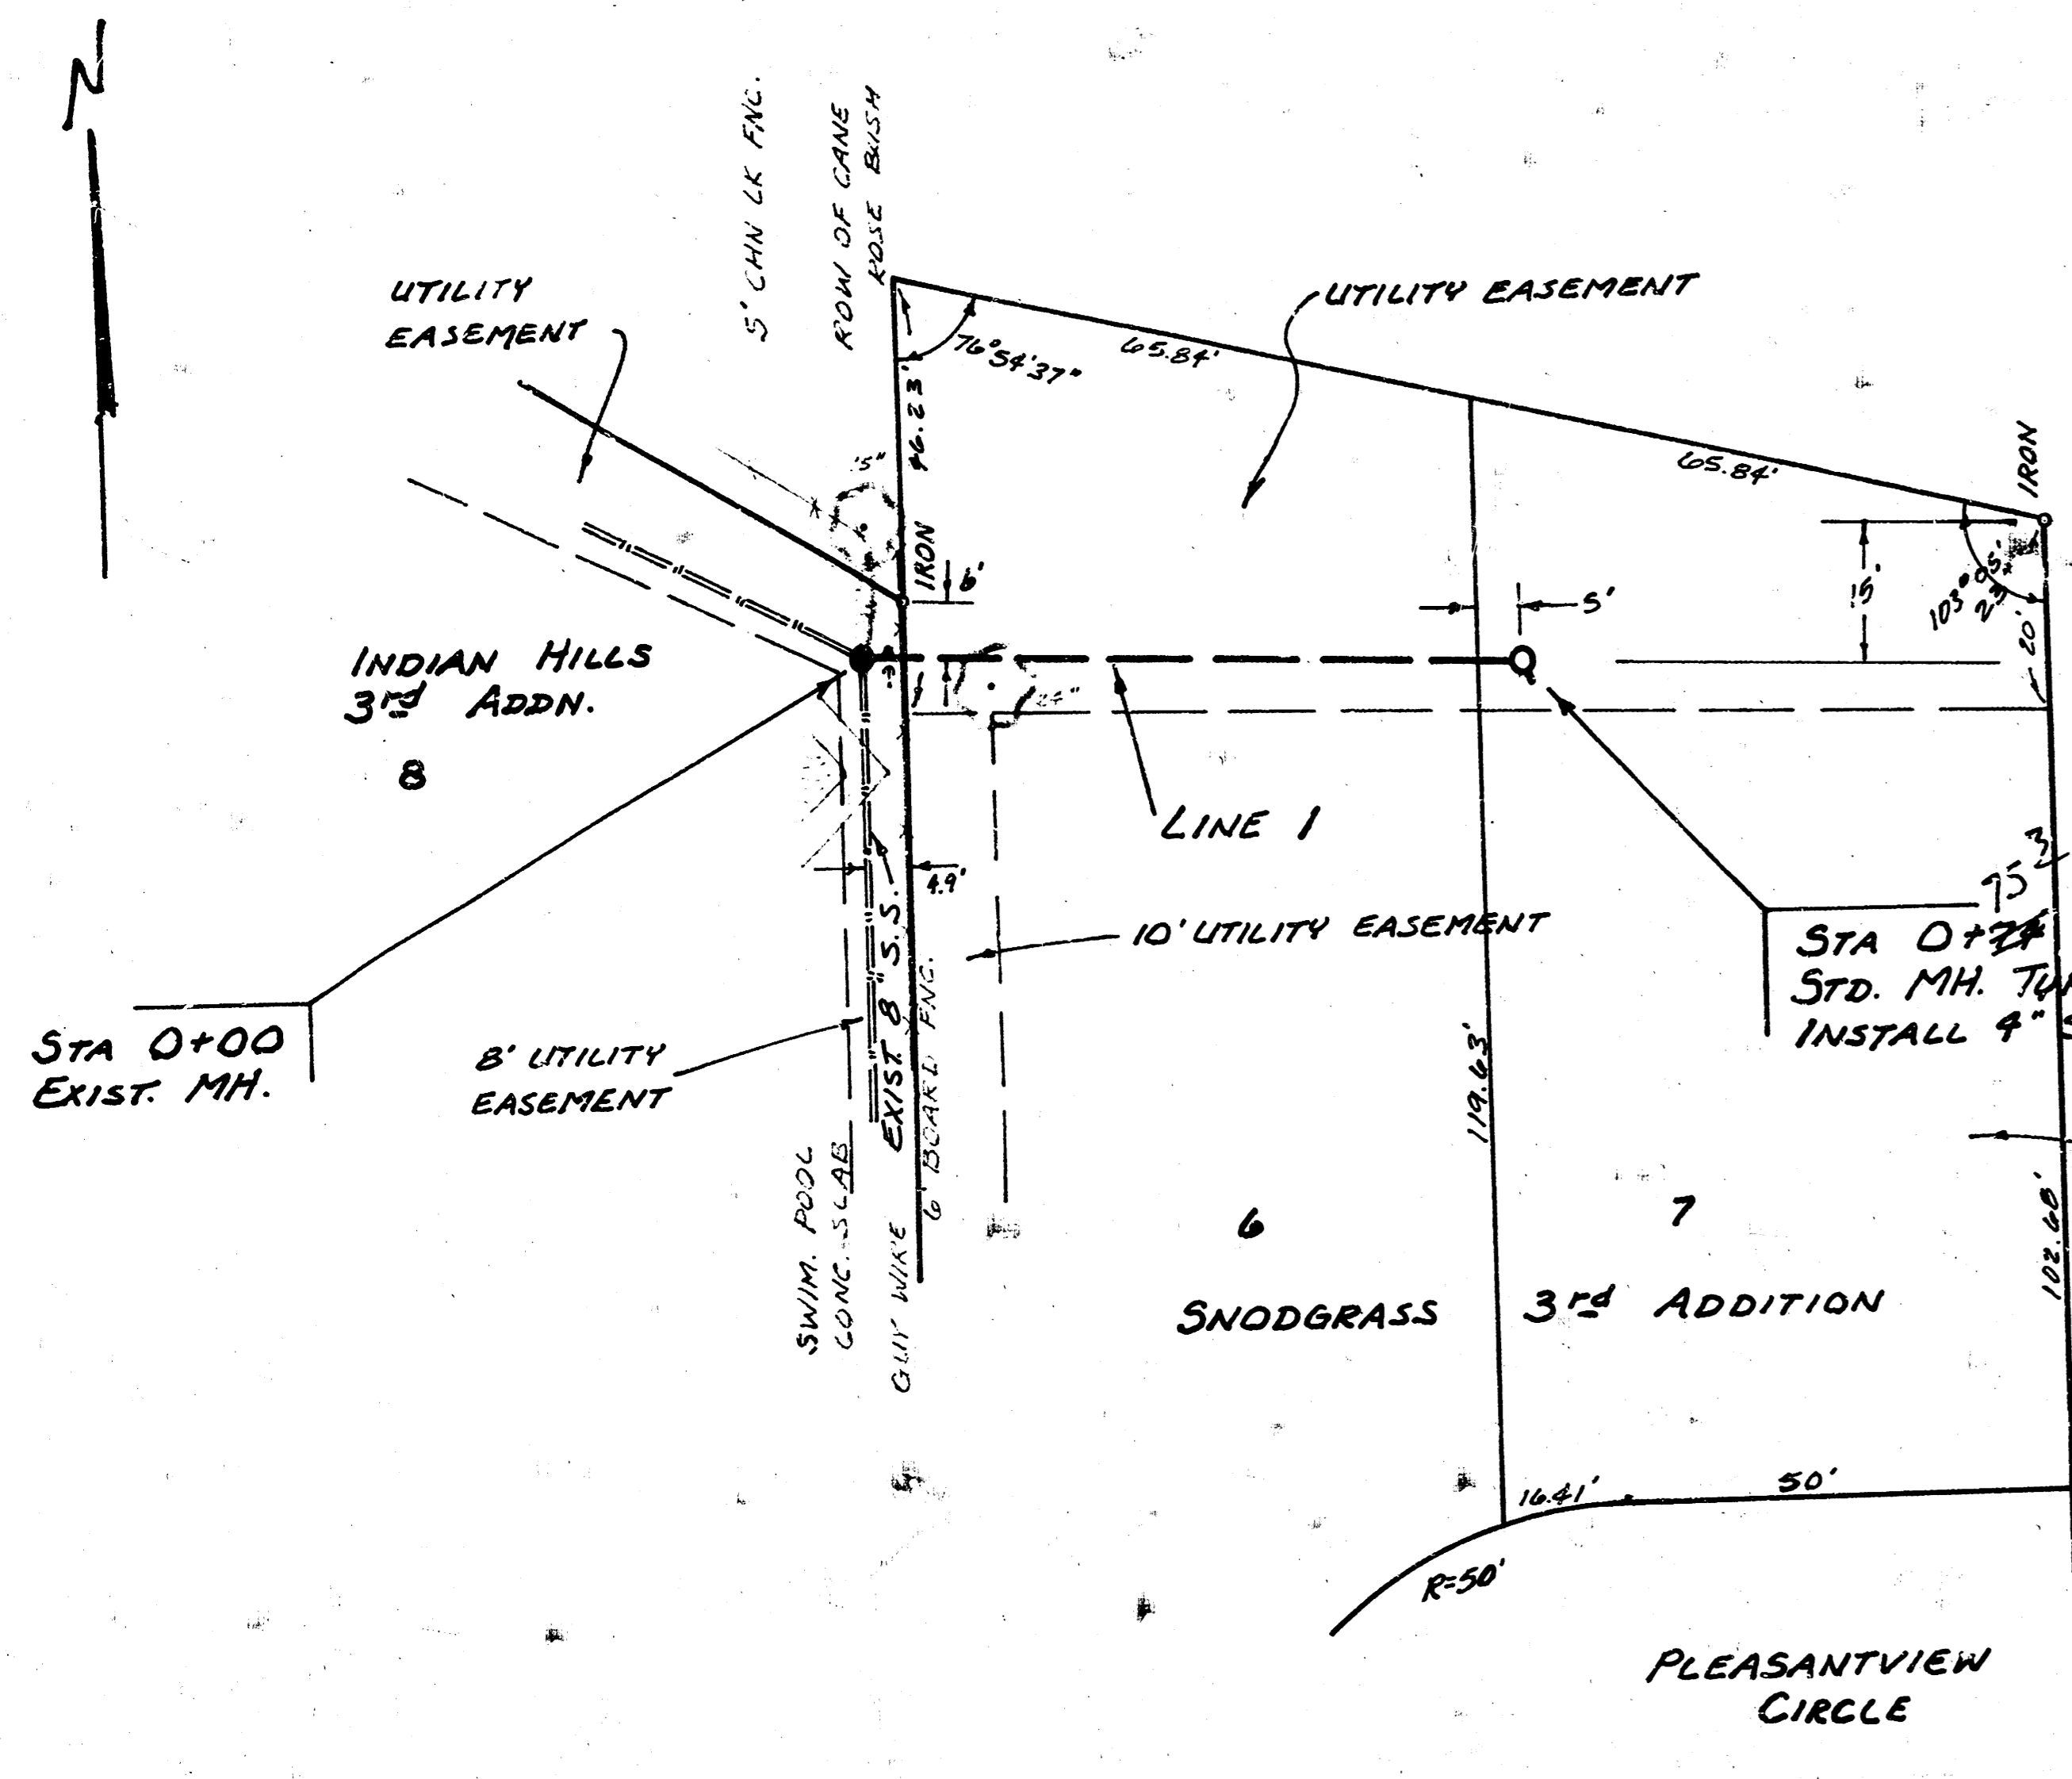

B.M. 125.146 CITY STD. DISC. 32 FT. E. & 23.5 FT. S.  
 OF E. BOTH SHERIDAN & 17TH ST.  
 B.M. 124.79 R.R. SPIKE W. FACE TRANSFORMER PP.  
 AT NW CORNER 18TH ST. AND PLEASANTVIEW.

As Built  
 1-13-83  
 JSS

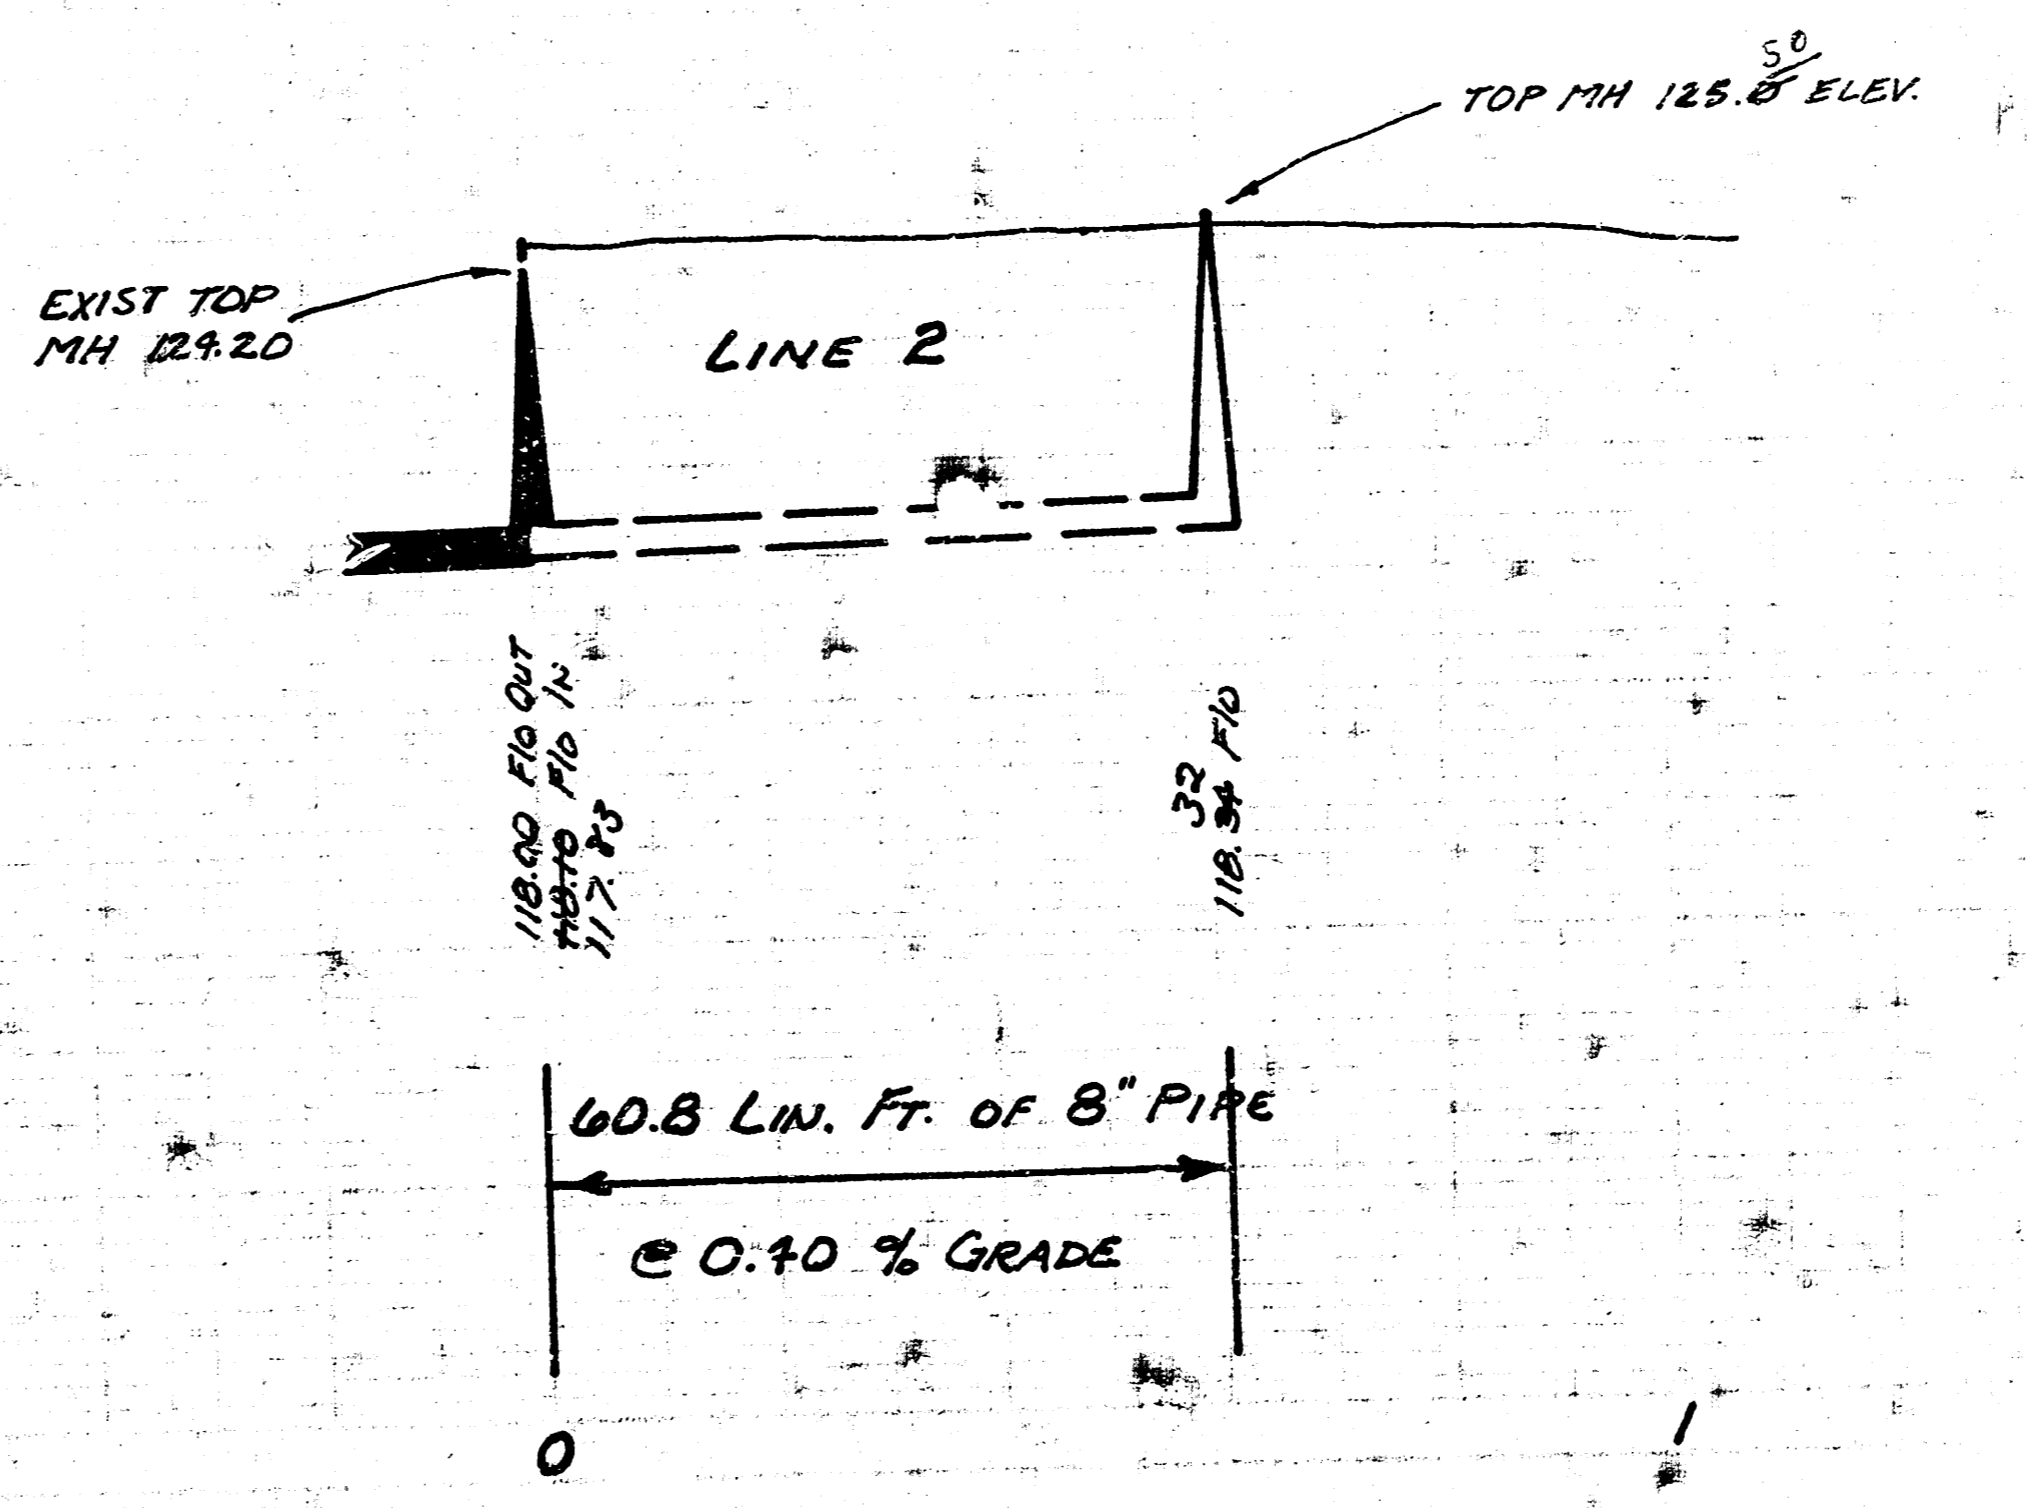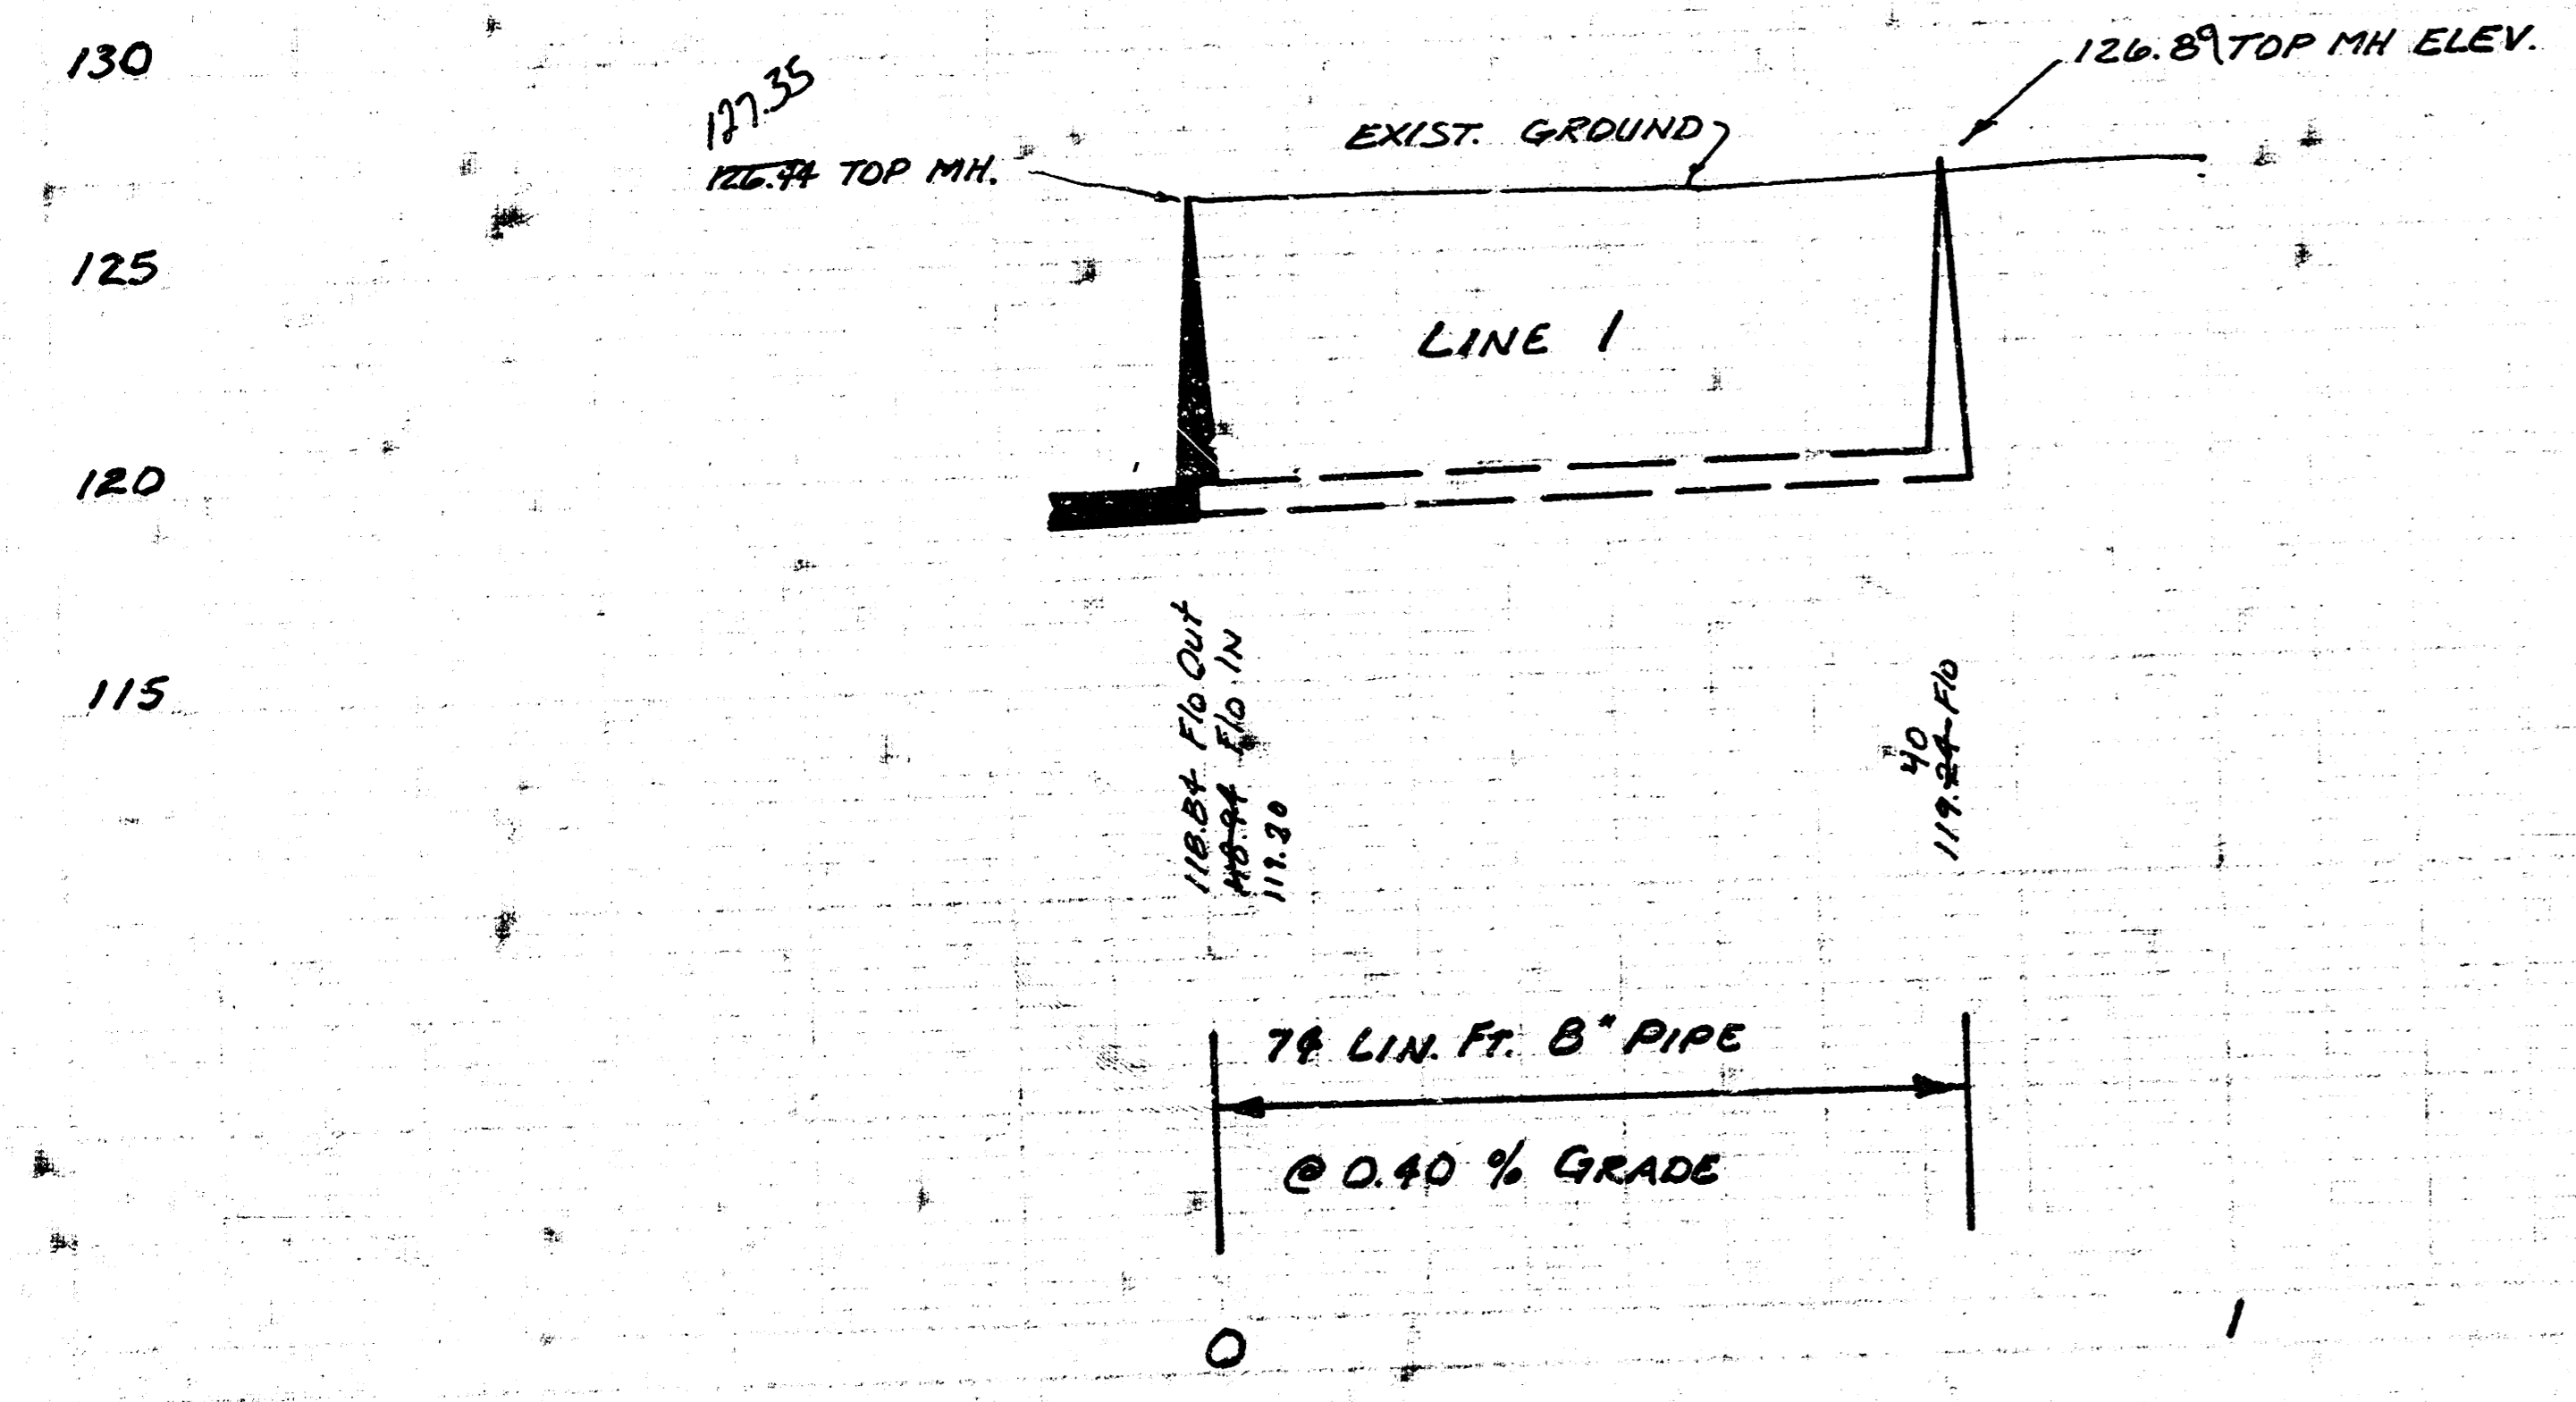

PROJECT DESCRIPTION	
LAT 38, MAIN 10, S.S. NO. 22	
PROJECT NUMBER 468-76-245-80858-000-000-001	
BOOK NO. DCD-MB	APPROVED BY
DRAWN BY LDOMIS	DATE
CITY OF WICHITA DEPARTMENT OF ENGINEERING	
DIRECTOR OF ENCLTY ENGINEER R. W. BRUGGEMAN	SCALE 1/4"

10 2 3 12