
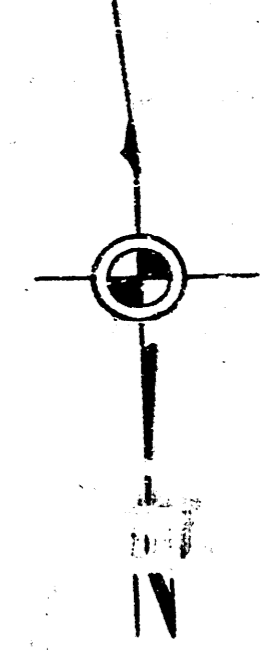


\*4  
 B. M. 110.27 R. R. Spk. N. face R.R.  
 30'± E. of EL Kessler 30'±  
 S. of South Line West Warehouse  
 Addition.

P.L. K.  
 C. H. W.  
 Plan Checked Date

113


No Gas Service

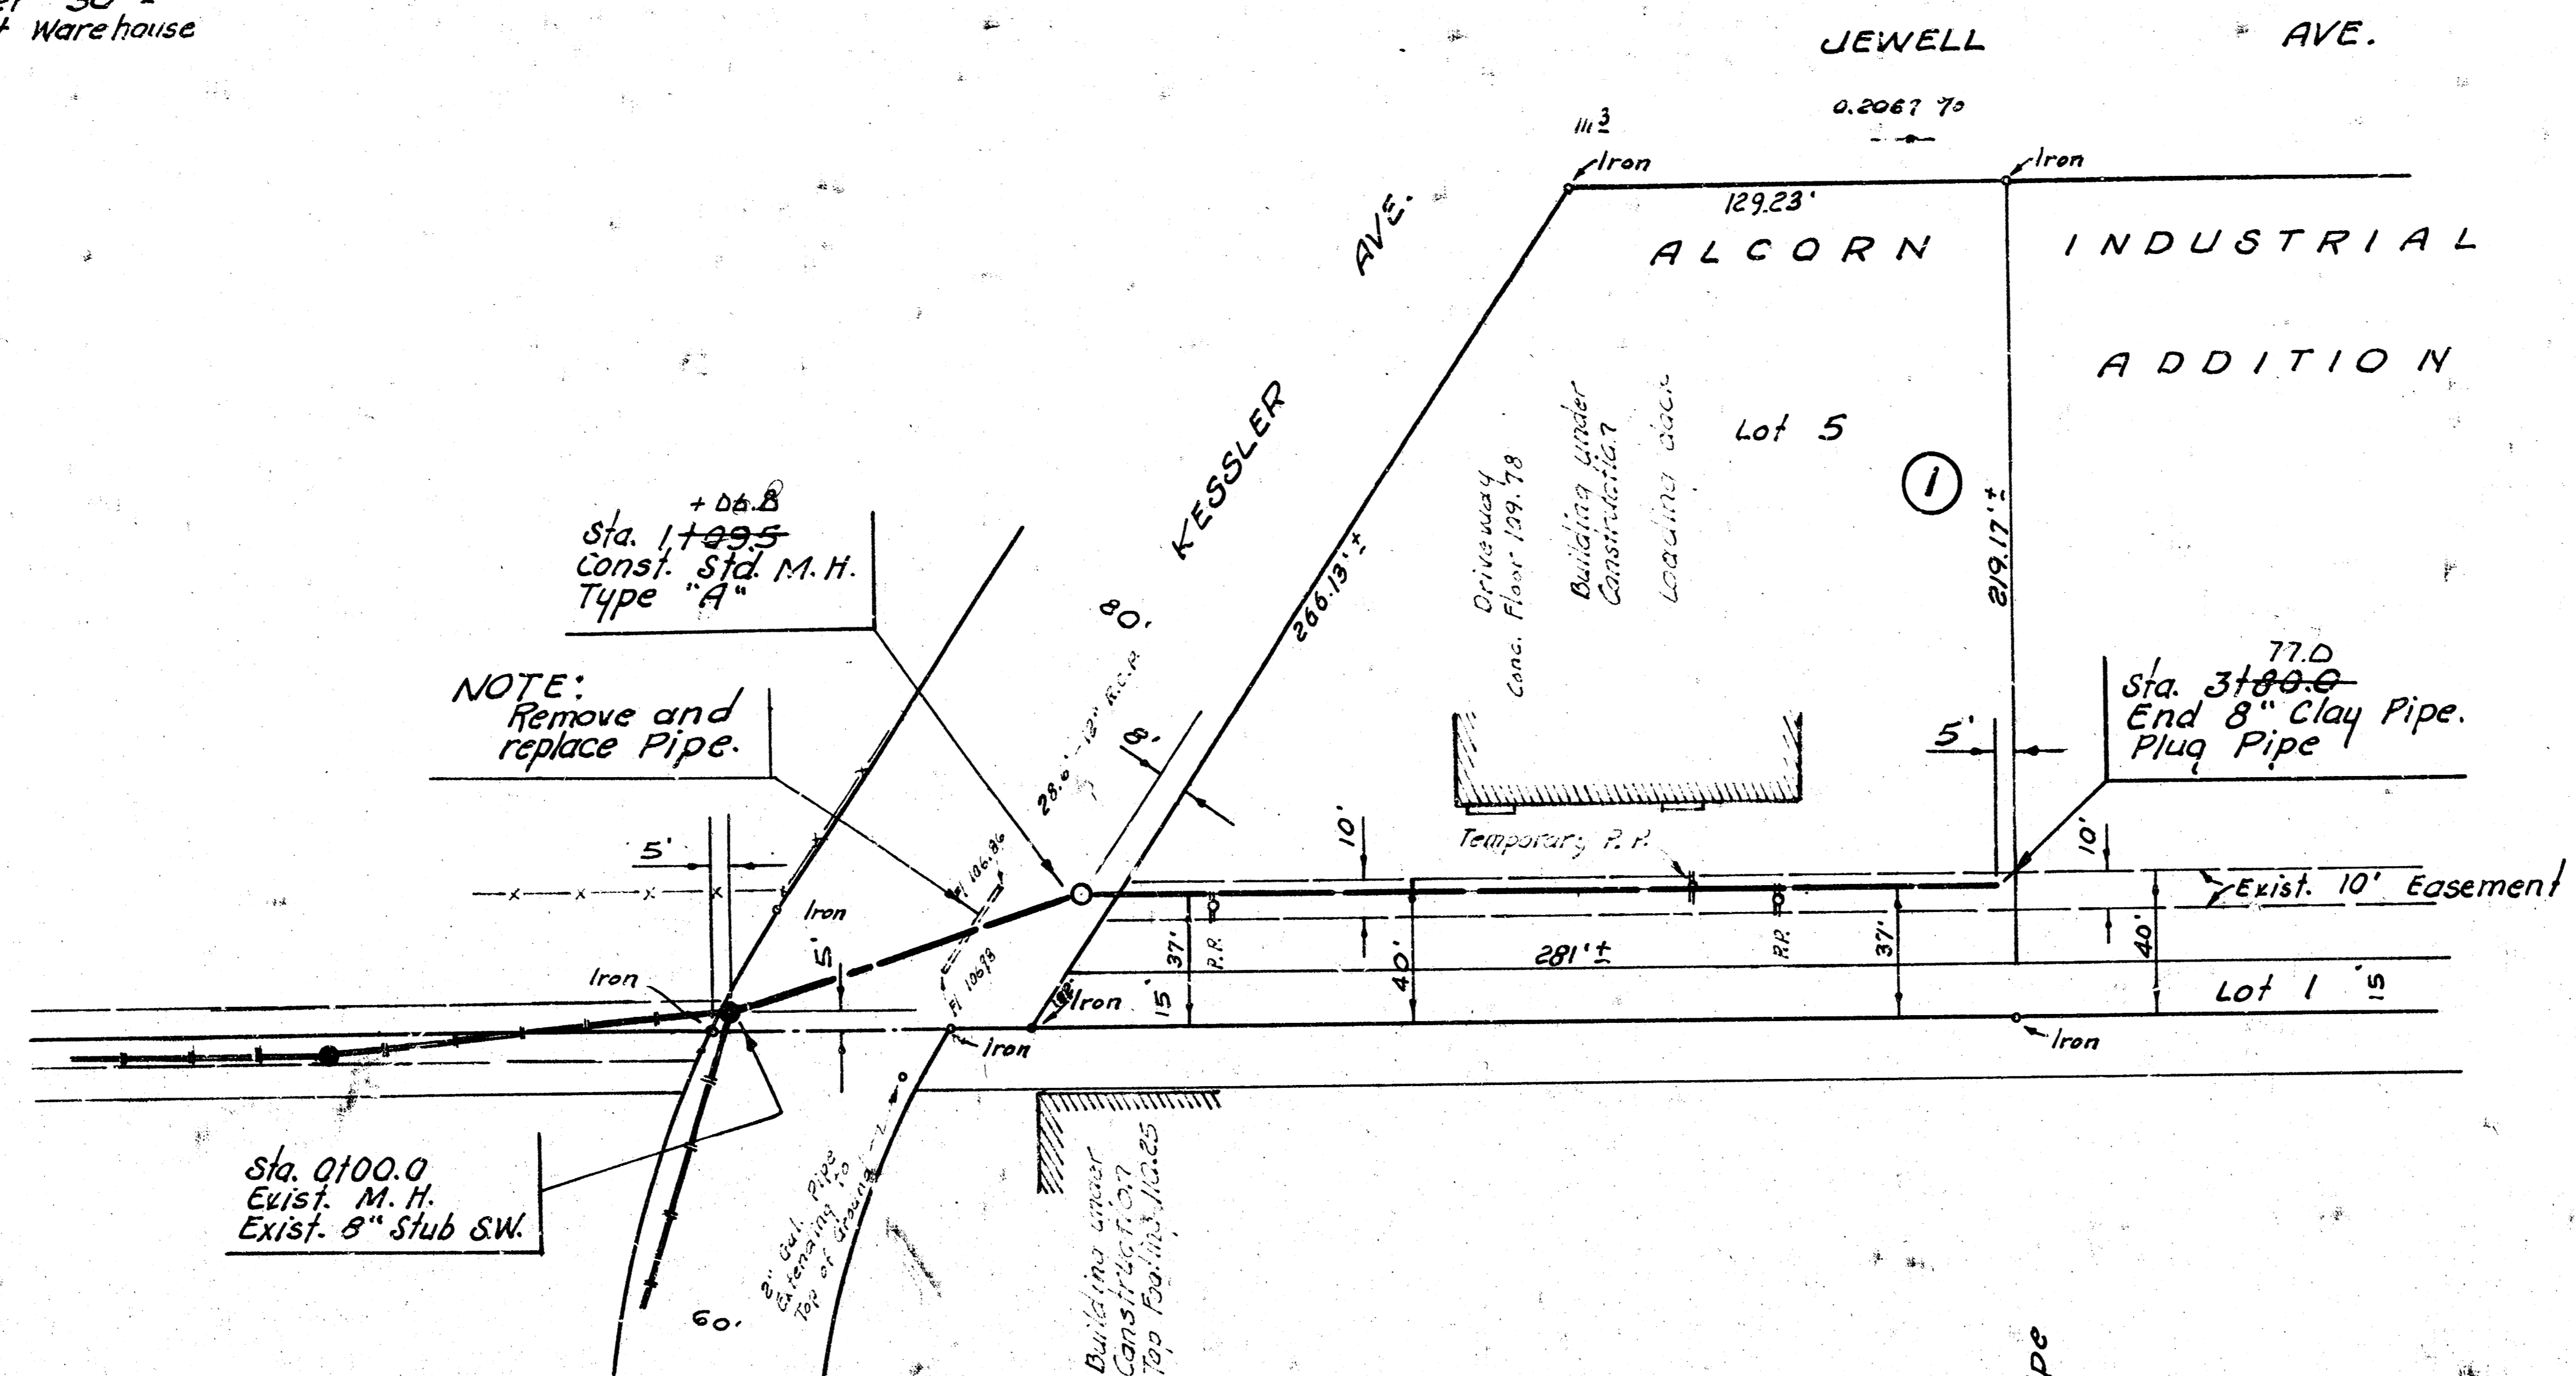

Plan Scale 1" = 40'  
 Profile Scale 1" = 40' Horiz.  
 1" = 5' Vert.

110  
 105  
 100  
 95

110  
 105  
 100  
 95

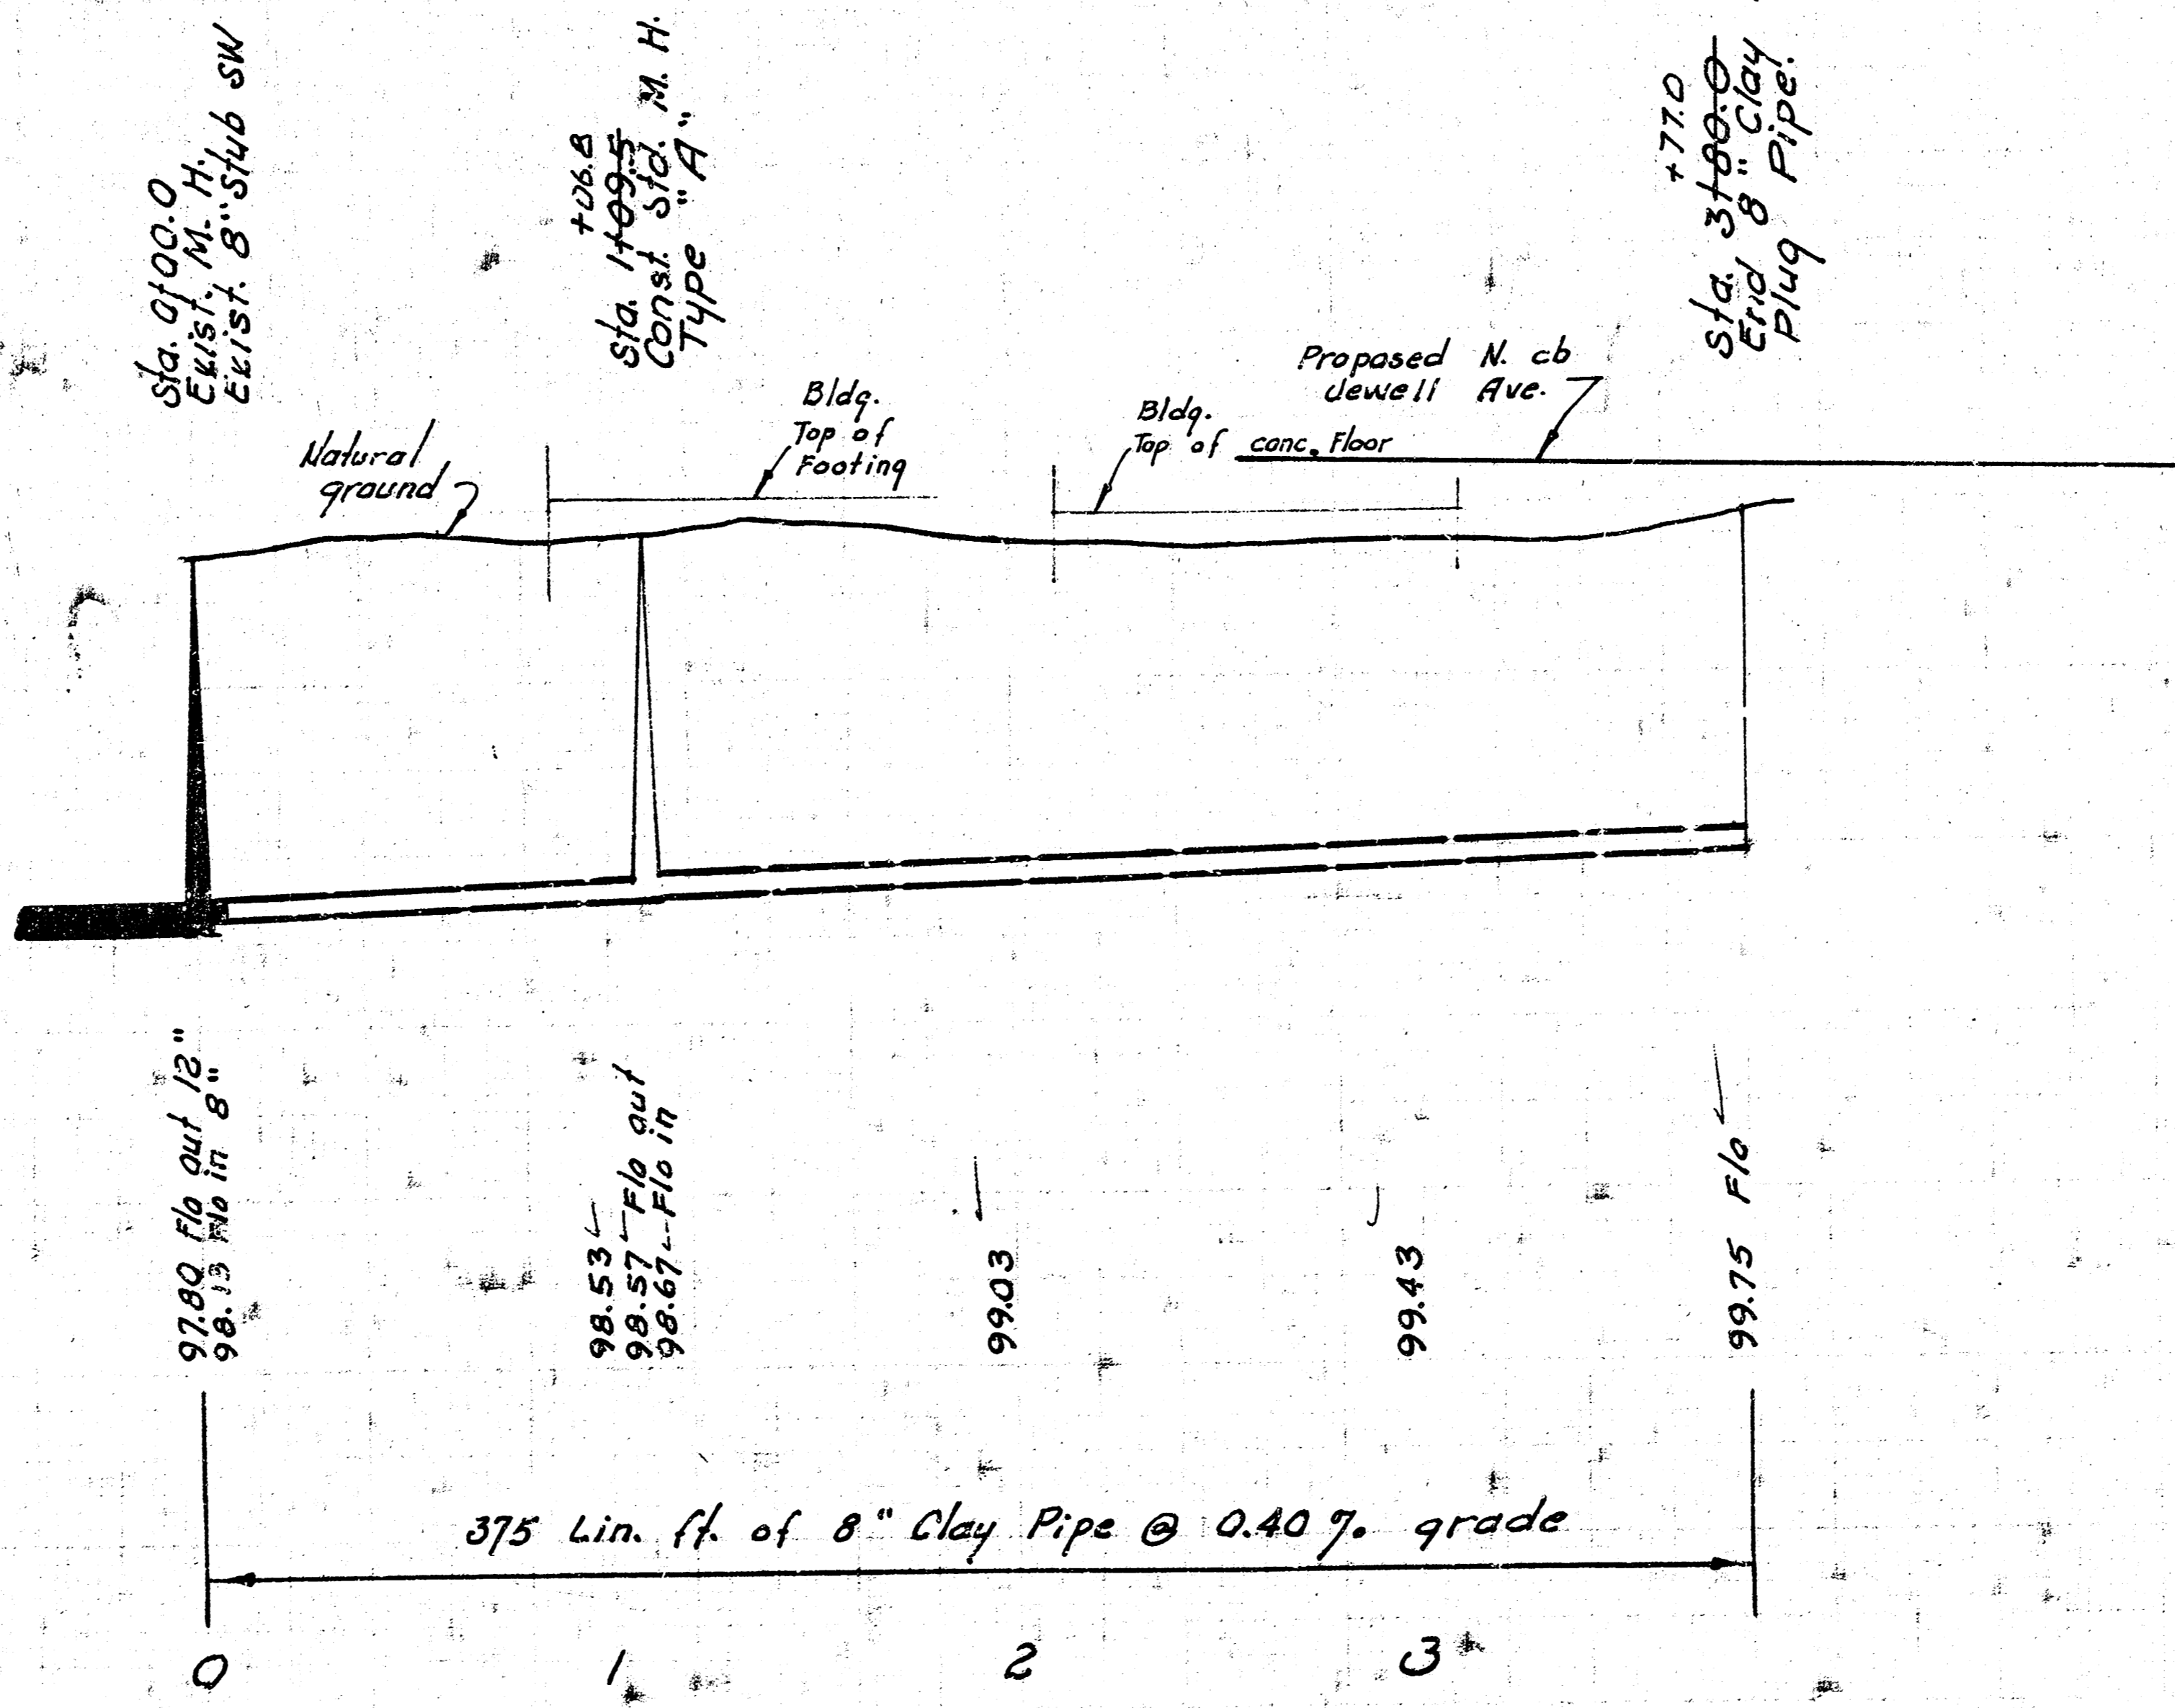

"As Built" Final Measurements L.H-7B

LAT. 6 MAIN 14, S.S. NO. 26  
 CITY OF WICHITA, KANSAS  
 R. W. LINN — CITY ENGINEER  
 NOV. 1972 PROJECT NO. DBKLS72060

FILMED FROM THE BEST