
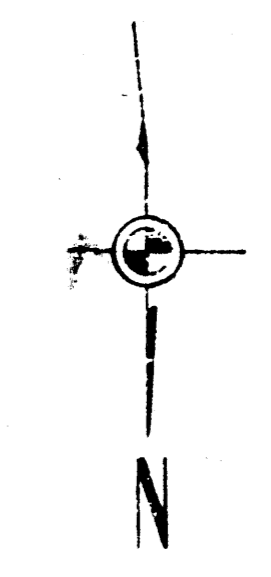


\*4  
 B. M. 110.27 R.R. Spk. N. face R.F.  
 30'± E. of CL Kessler 30'±  
 S. of South Line West Warehouse  
 Addition.

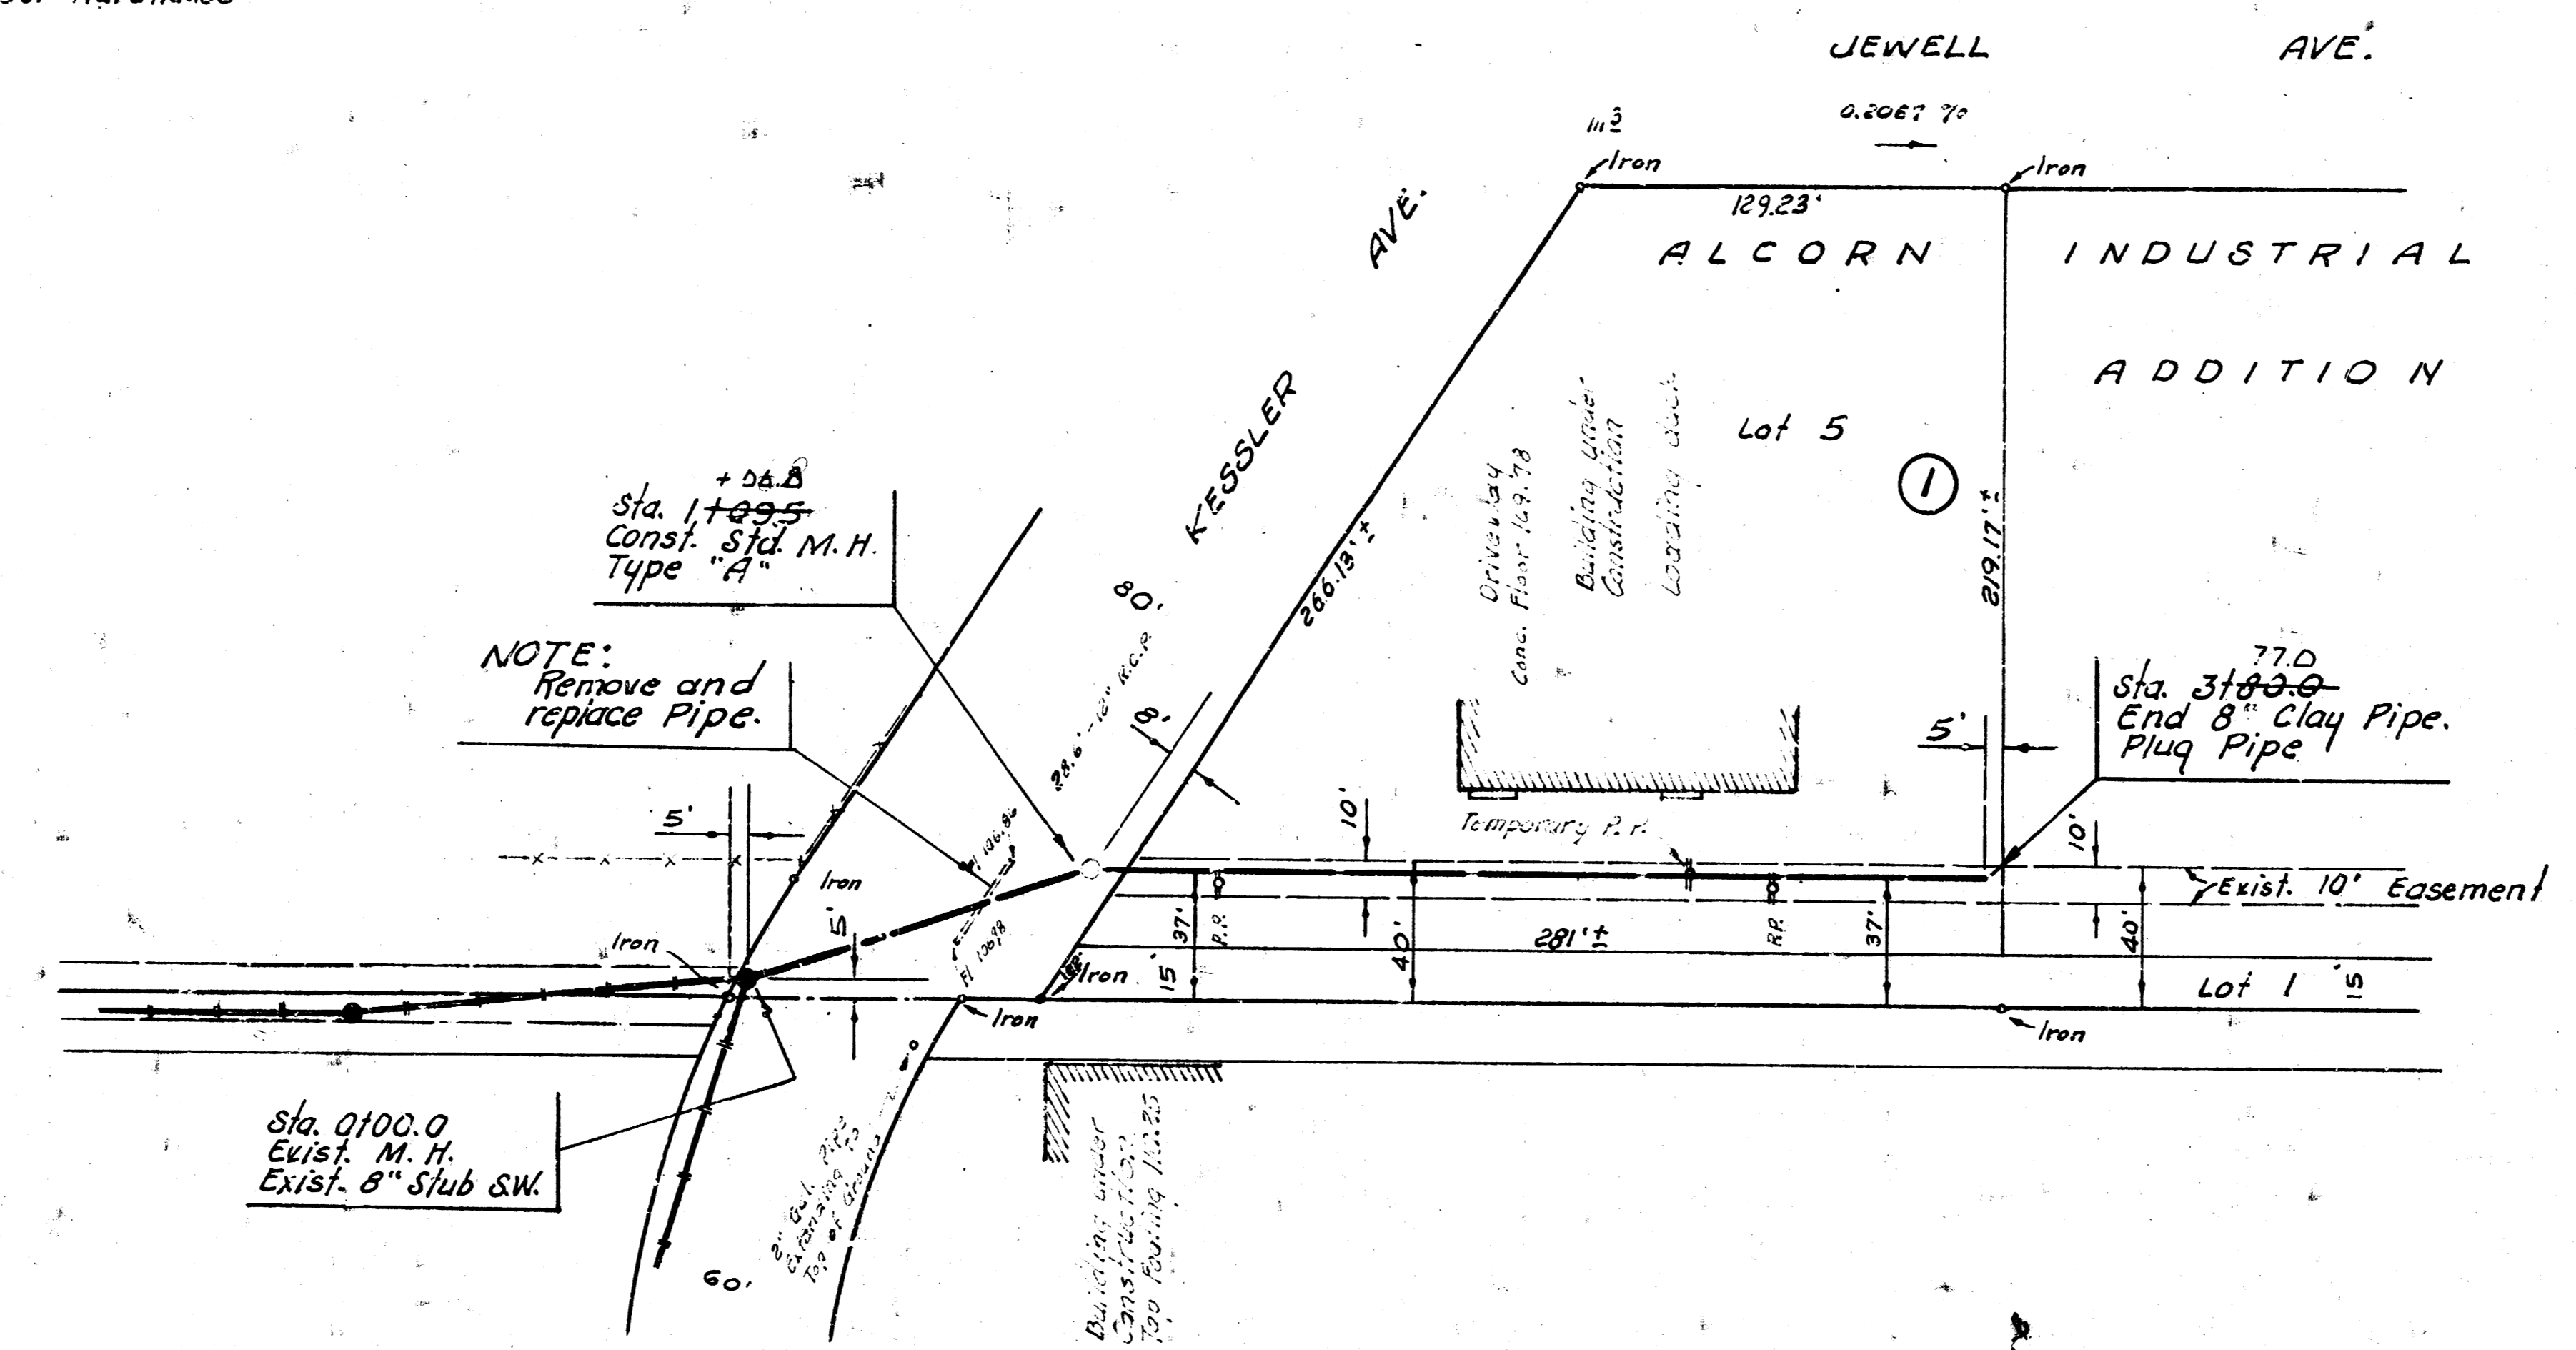

Plan Scale 1" = 40'  
 Profile Scale 1" = 40' Horiz.  
 1" = 5' Vert.

119  
 From Checked 1/24/72  
 P.L. Linn  
 C.E. 11/72

Sta. 0100.0  
 Exist. M.H.  
 Exist. 8" Slab S.W.

NOTE:  
 Remove and  
 replace pipe.


Sta. 1100.0  
 Const. Sta. M.H.  
 Type 'A'

Sta. 770  
 End 8" Clay Pipe  
 Plug Pipe

Sta. 0100.0  
 Exist. M.H.  
 Exist. 8" Slab S.W.

Sta. 1100.0  
 Const. Sta. M.H.  
 Type 'A'

Sta. 770  
 End 8" Clay Pipe  
 Plug Pipe

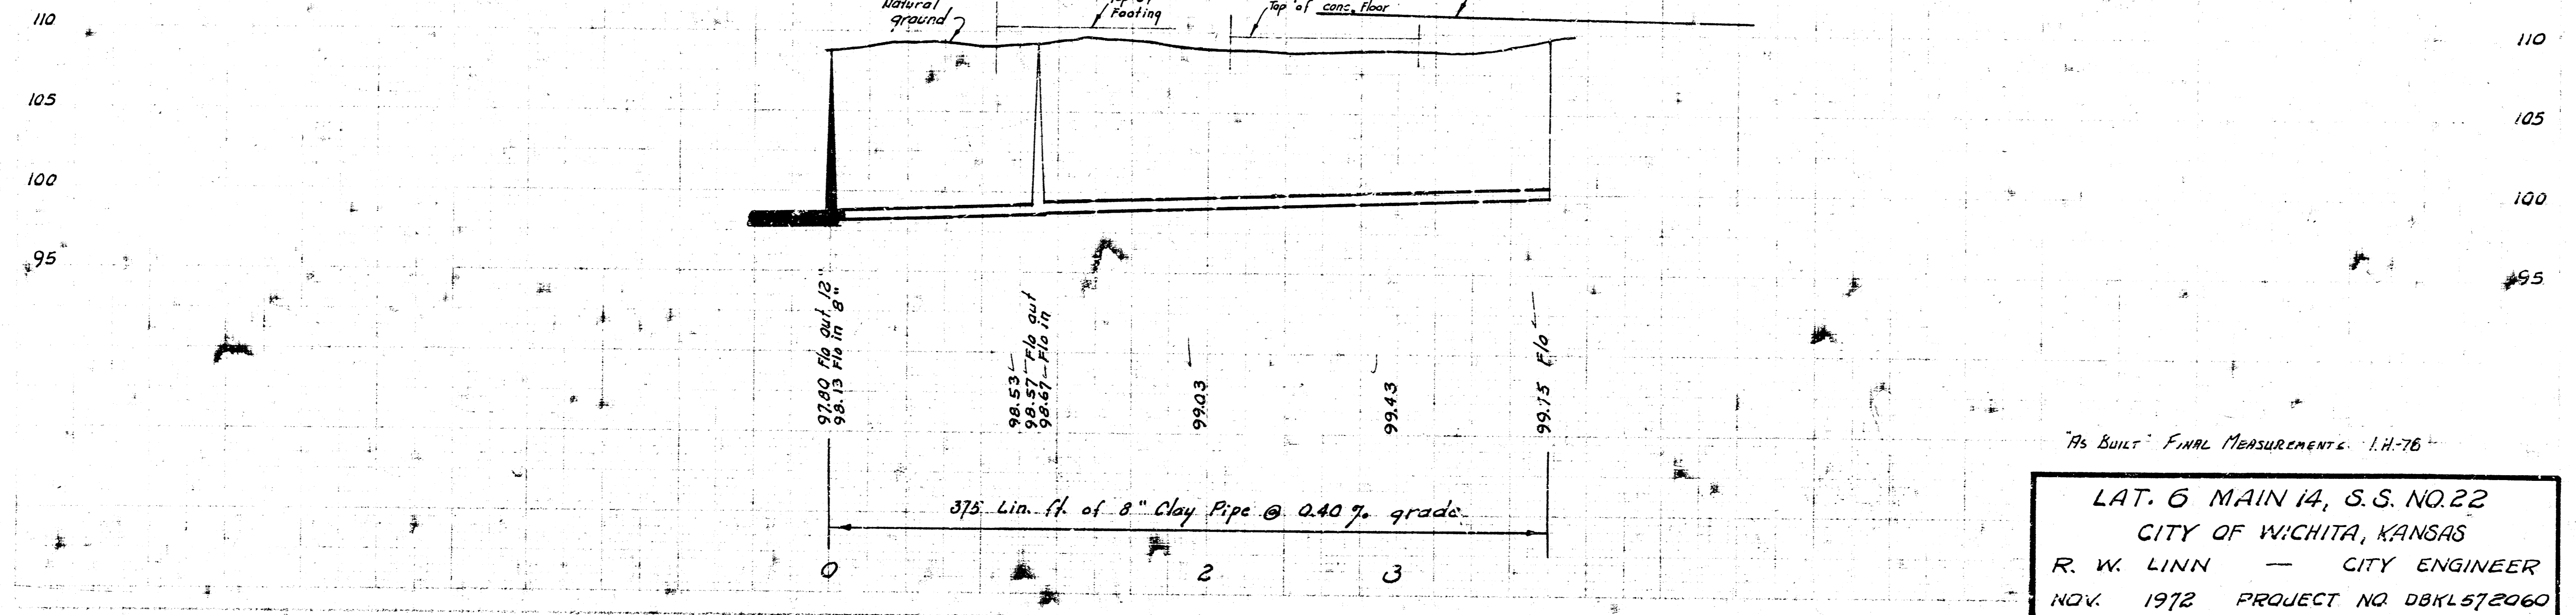

As Built Final Measurements 11-76  
 LAT. 6 MAIN 14, S.S. NO. 22  
 CITY OF WICHITA, KANSAS  
 R. W. LINN — CITY ENGINEER  
 NOV. 1972 PROJECT NO. DBKLS72060