
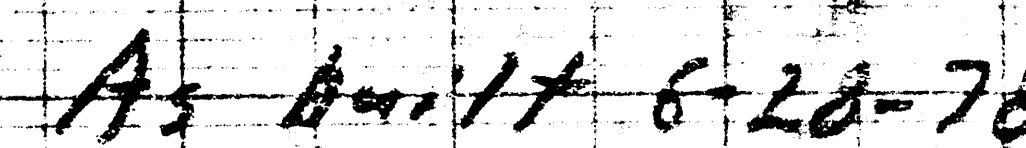


- 09.43 Top of bolt in the Southwest corner of the sign base at 3600 West
Esthner Ave. in front of Construction Machinery Inc. building.

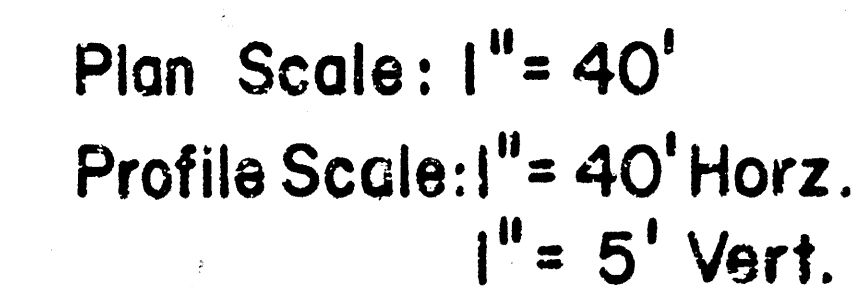

R.W. LINN CITY ENGINEER
DATE: _____ PROJECT NUMBER: DBKL577097