



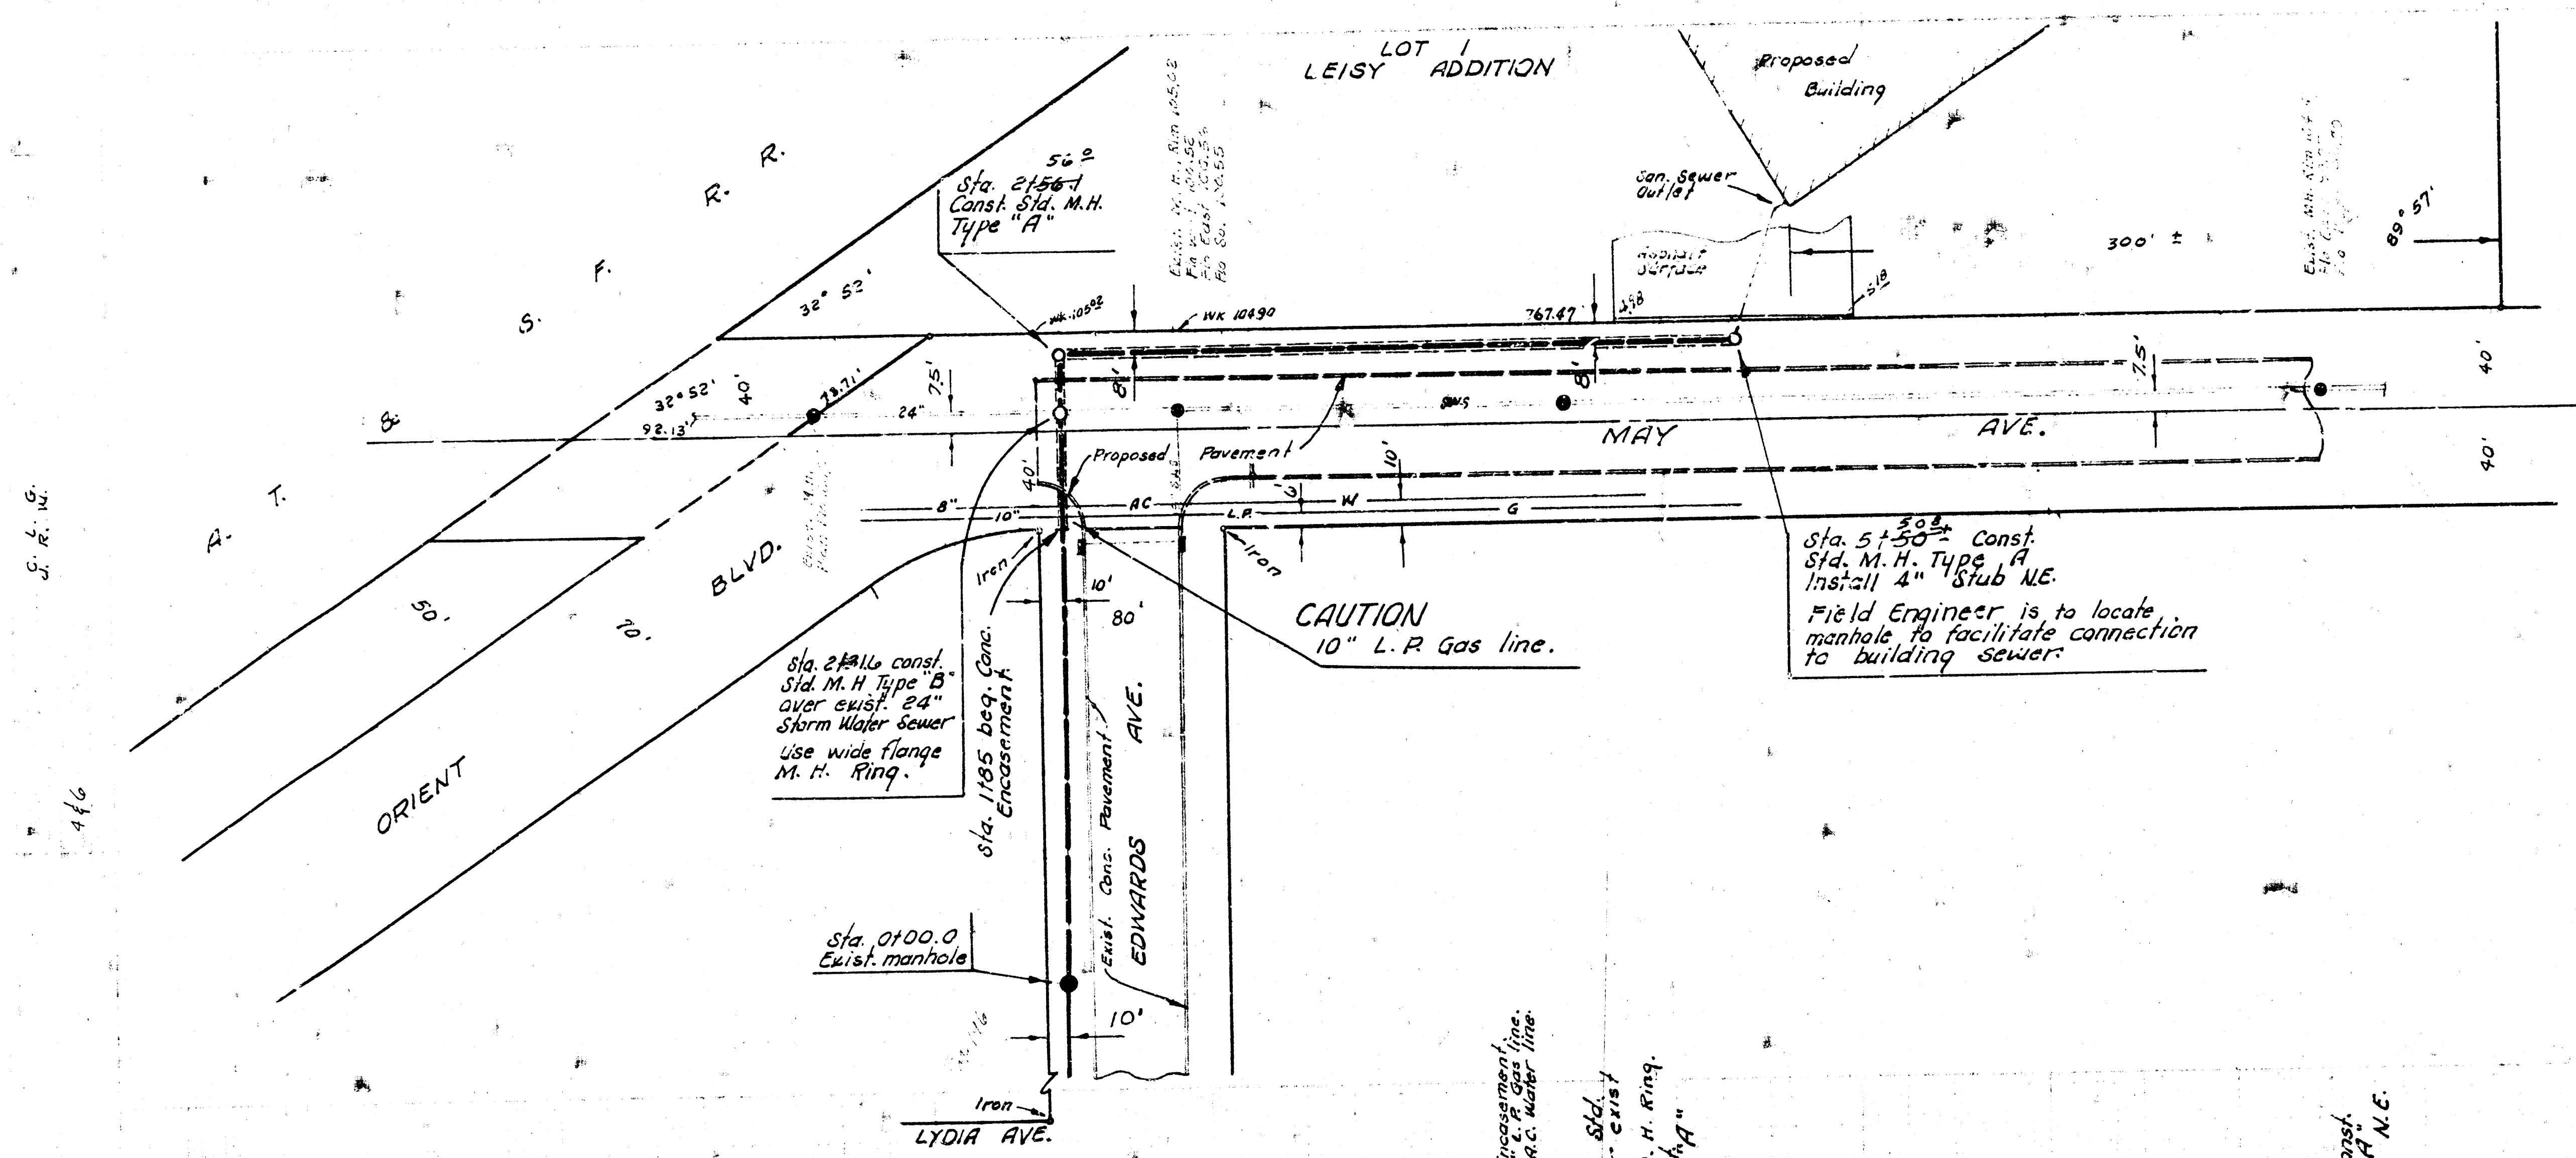

Plan Scale 1" = 40' Horiz.
Profile Scale 1" = 5' Vert.

B. M. 104.49' ± on east curb of Edwards St. south of St. May

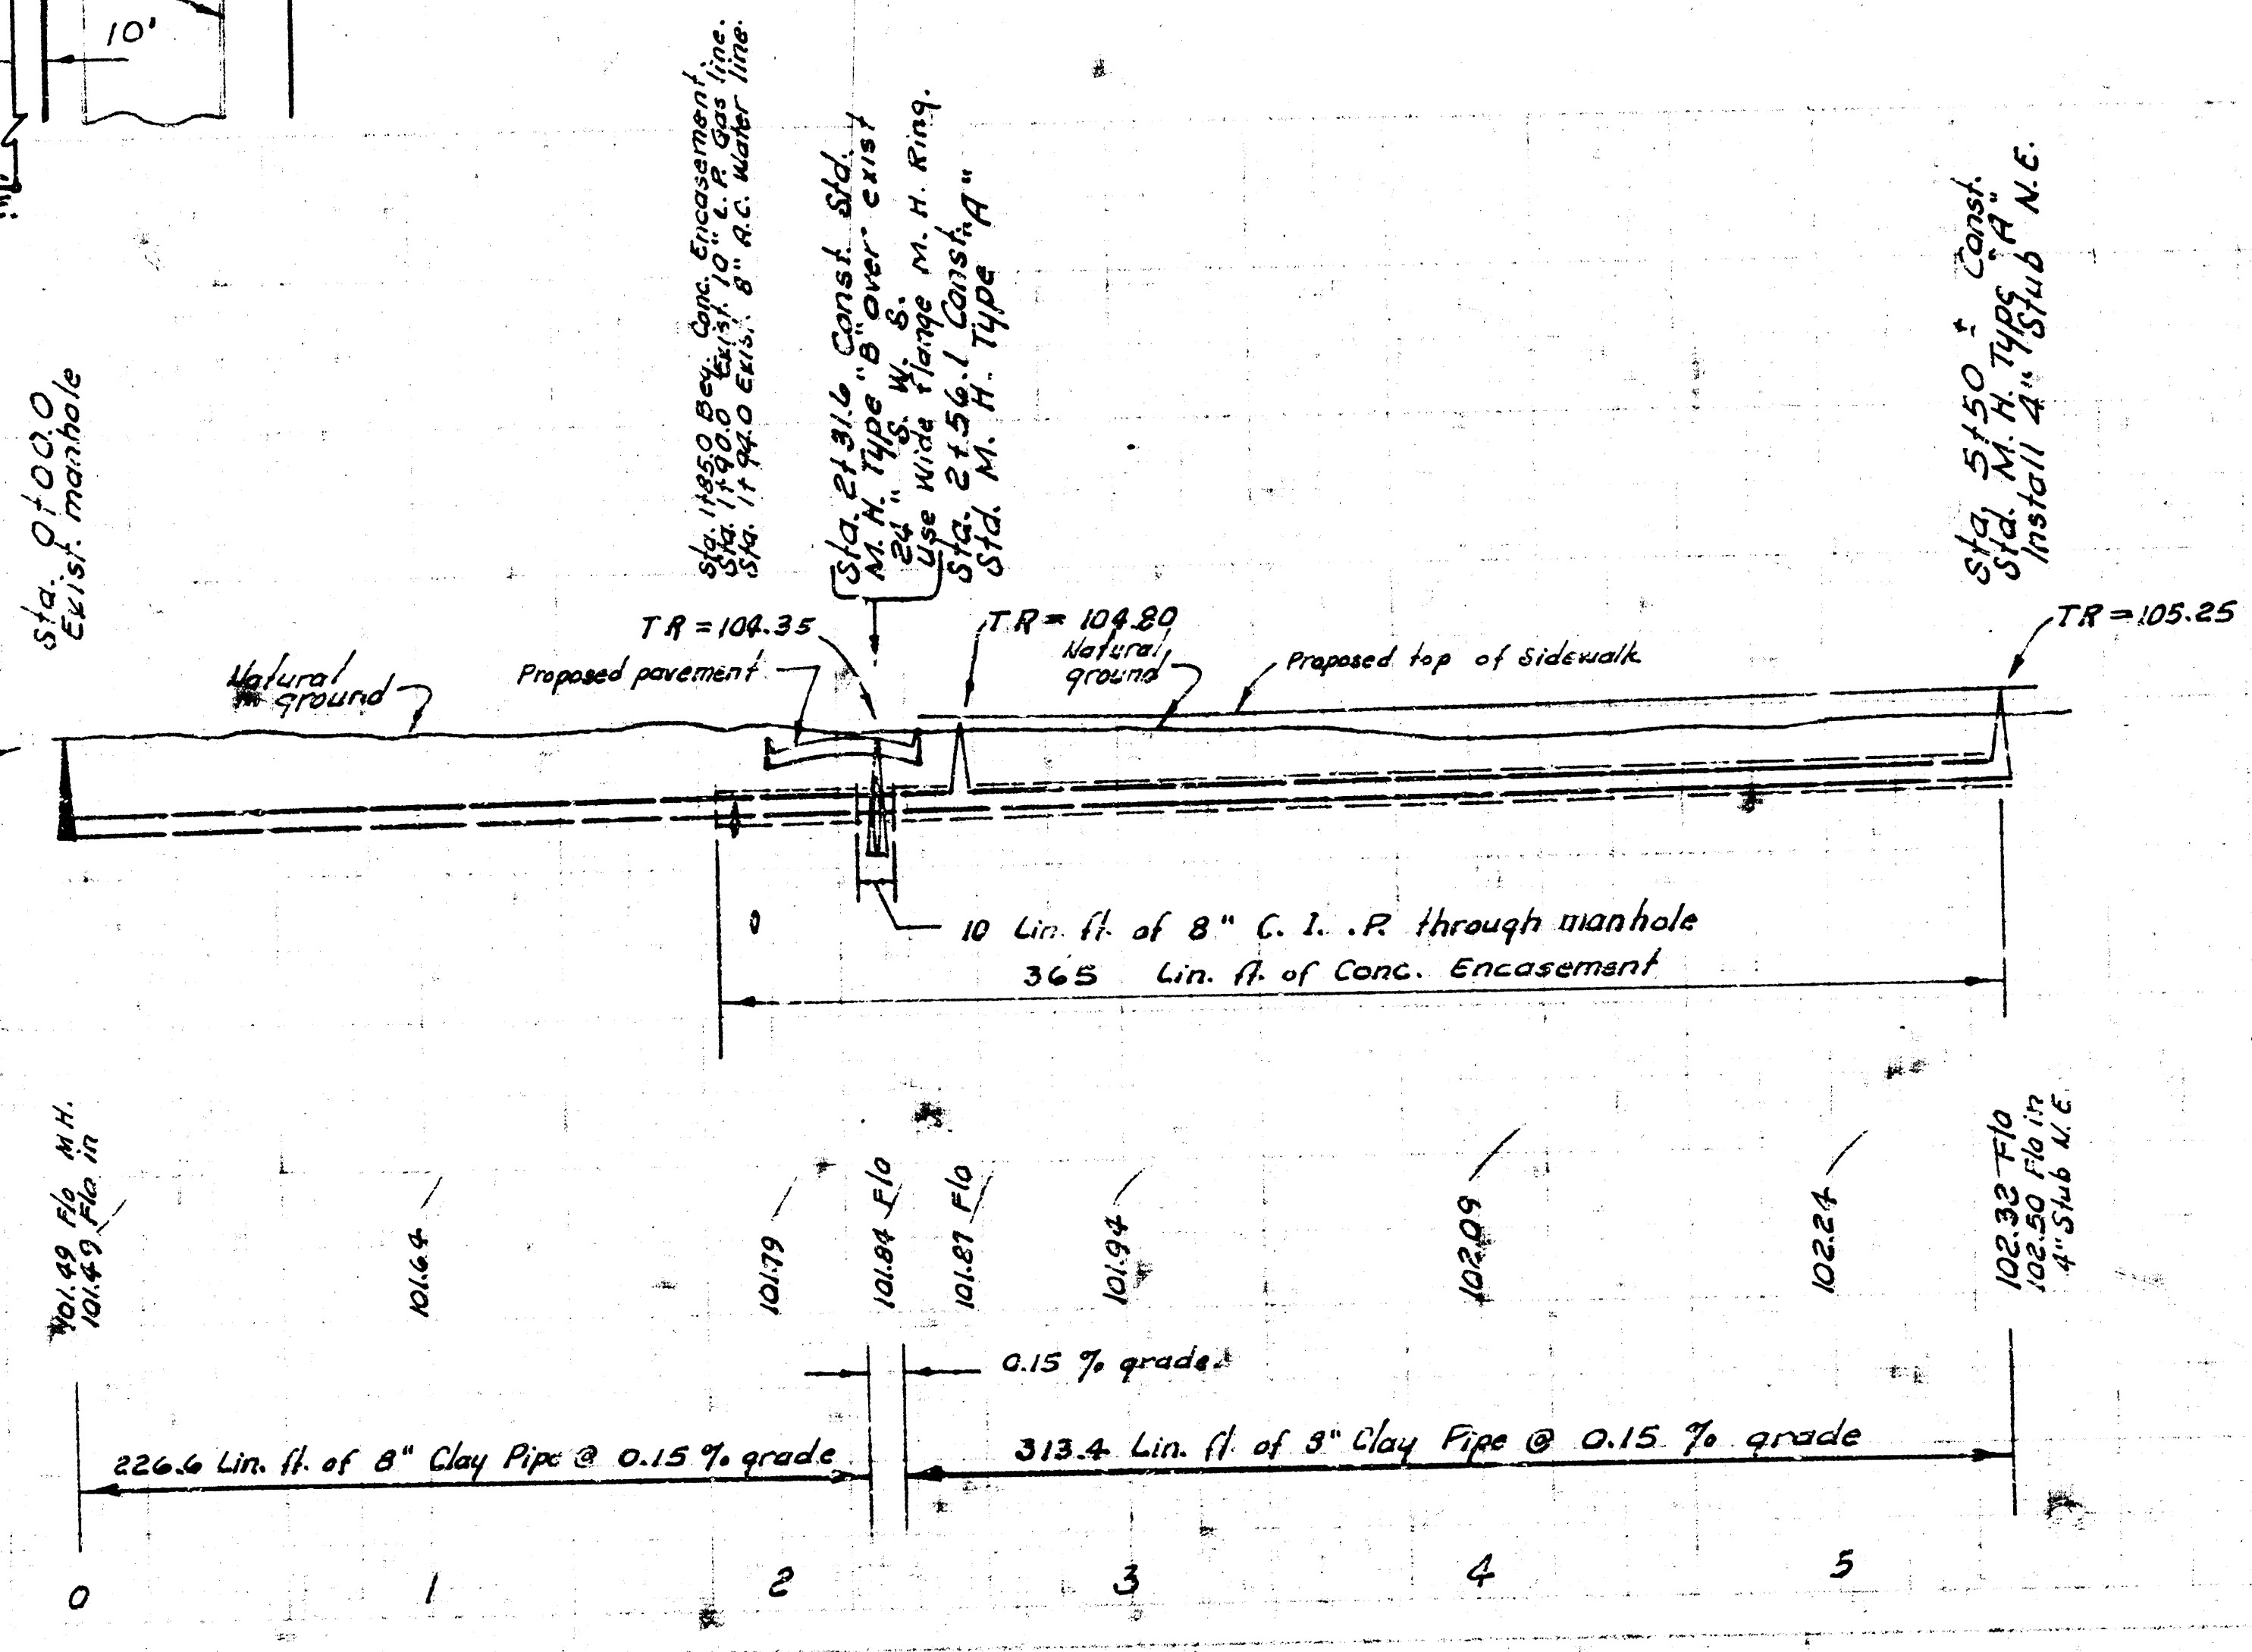

As Built Final Map S.S. 16 & 22
LAT. 6, MAIN 16, S. S. NO. 22
CITY OF WICHITA, KANSAS
R. W. LINN — CITY ENGINEER
DEC. 1973 PROJECT NO. DBKL 573053

