

LATERAL 8, MAIN 16 SANITARY SEWER NO. 22


To Serve Lots 1 and 2, LaCount Addition

PROJECT NO.


468-76-245-81744-000-000-001

CITY OF WICHITA, KANSAS

Michael E. Lindebak - City Engineer

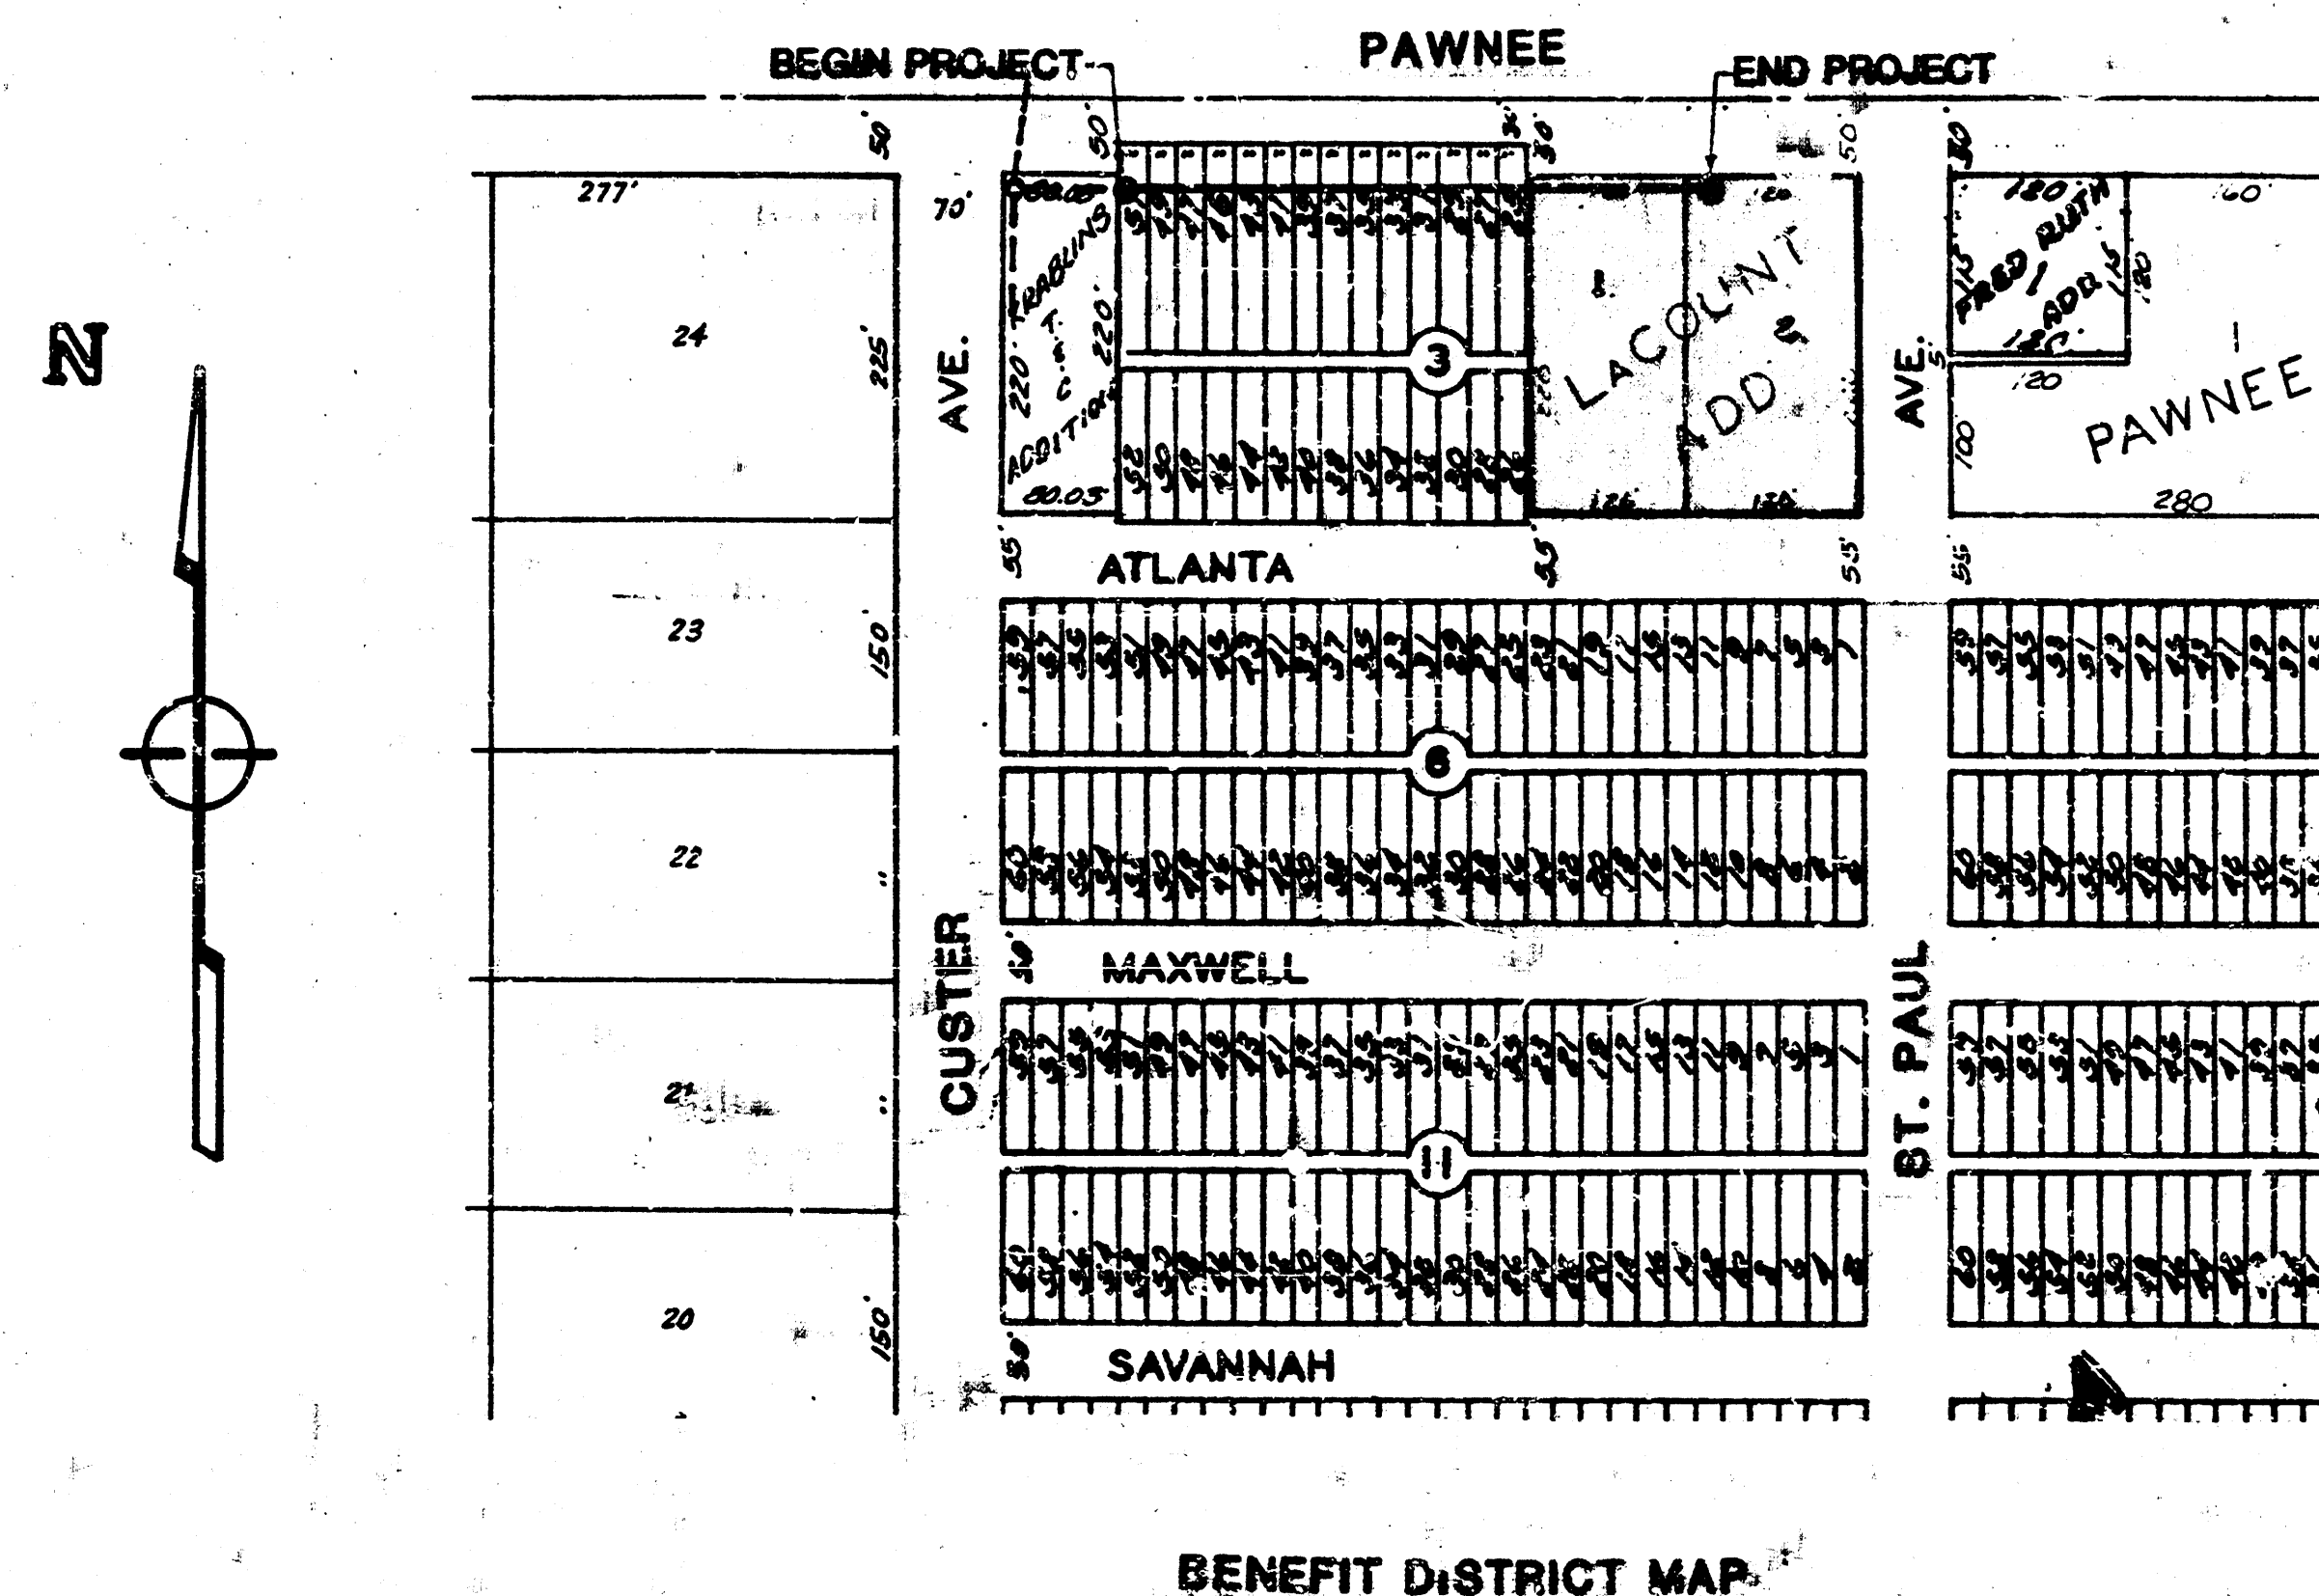

AS BUILT
RD
3-88

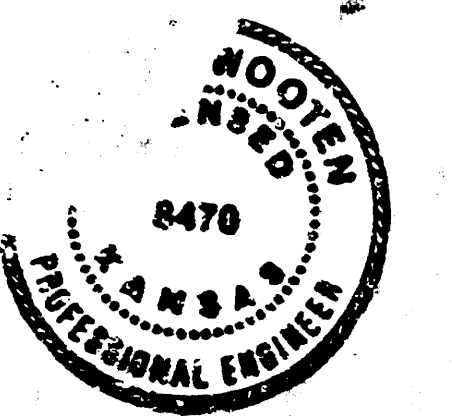

Bench Mark: 'A' Cut in Top of Cb.
On the East Return of the
Intersection of Custer and Pawnee
Elevation = 101.39 City Datum

Bench Mark: 'A' Cut in Top of Cb.
on the West Return of the
Intersection of St. Paul and
Pawnee, Elevation = 101.32 City Datum

Station 0+00 Existing
Manhole, 4.3 South
40 East of 17th.

Station 0+75 Remove
Plug and Connect to
existing 8" V.C.R.
Pipe.

Do not Disturb
Concrete Parking
Lot

Station 0+82.7
Station 0+85 Construct
Standard Type 'P'
Manhole, Top Elevation
= 103.00

Remove and Replace
Driveway as Necessary
For Sewer Const.

Station 5+01.5
Station 5+01.5 Const.
Std. Type 'P' Shallow
Manhole, Top Elevation
= 103.50; 4" stub S.


Bench Mark 'A' on
T.C. Elev = 101.39

Bench Mark 'A' on
T.C. Elev = 101.32

Scale: 1" = 40' Plan
1" = 5' Profile

GENERAL NOTES

- Underground utility service lines and overhead utility pole lines are to be adjusted as necessary by others prior to construction unless the plans specifically call for their adjustment by the Contractor or unless the plans specifically identify a utility to be adjusted by its owner during construction. Existing utilities and their location, as shown on the plans, represent the best information obtainable for design. The Contractor will be required to work around existing utilities within the right-of-way which do not conflict with proposed construction.
- The Contractor shall give all property owners and/or tenants of developed property abutting the construction of this project a minimum of ten (10) days advance notice prior to start of construction.
- The Contractor shall be responsible for preserving property irons. The Contractor will be required to re-establish any property irons which are damaged or destroyed by his construction operations. Such irons shall be re-established by a licensed land surveyor or a licensed professional engineer in accordance with state laws.
- The Contractor shall verify the location and elevation of the existing sanitary sewer stub prior to any construction of the sewer extension.

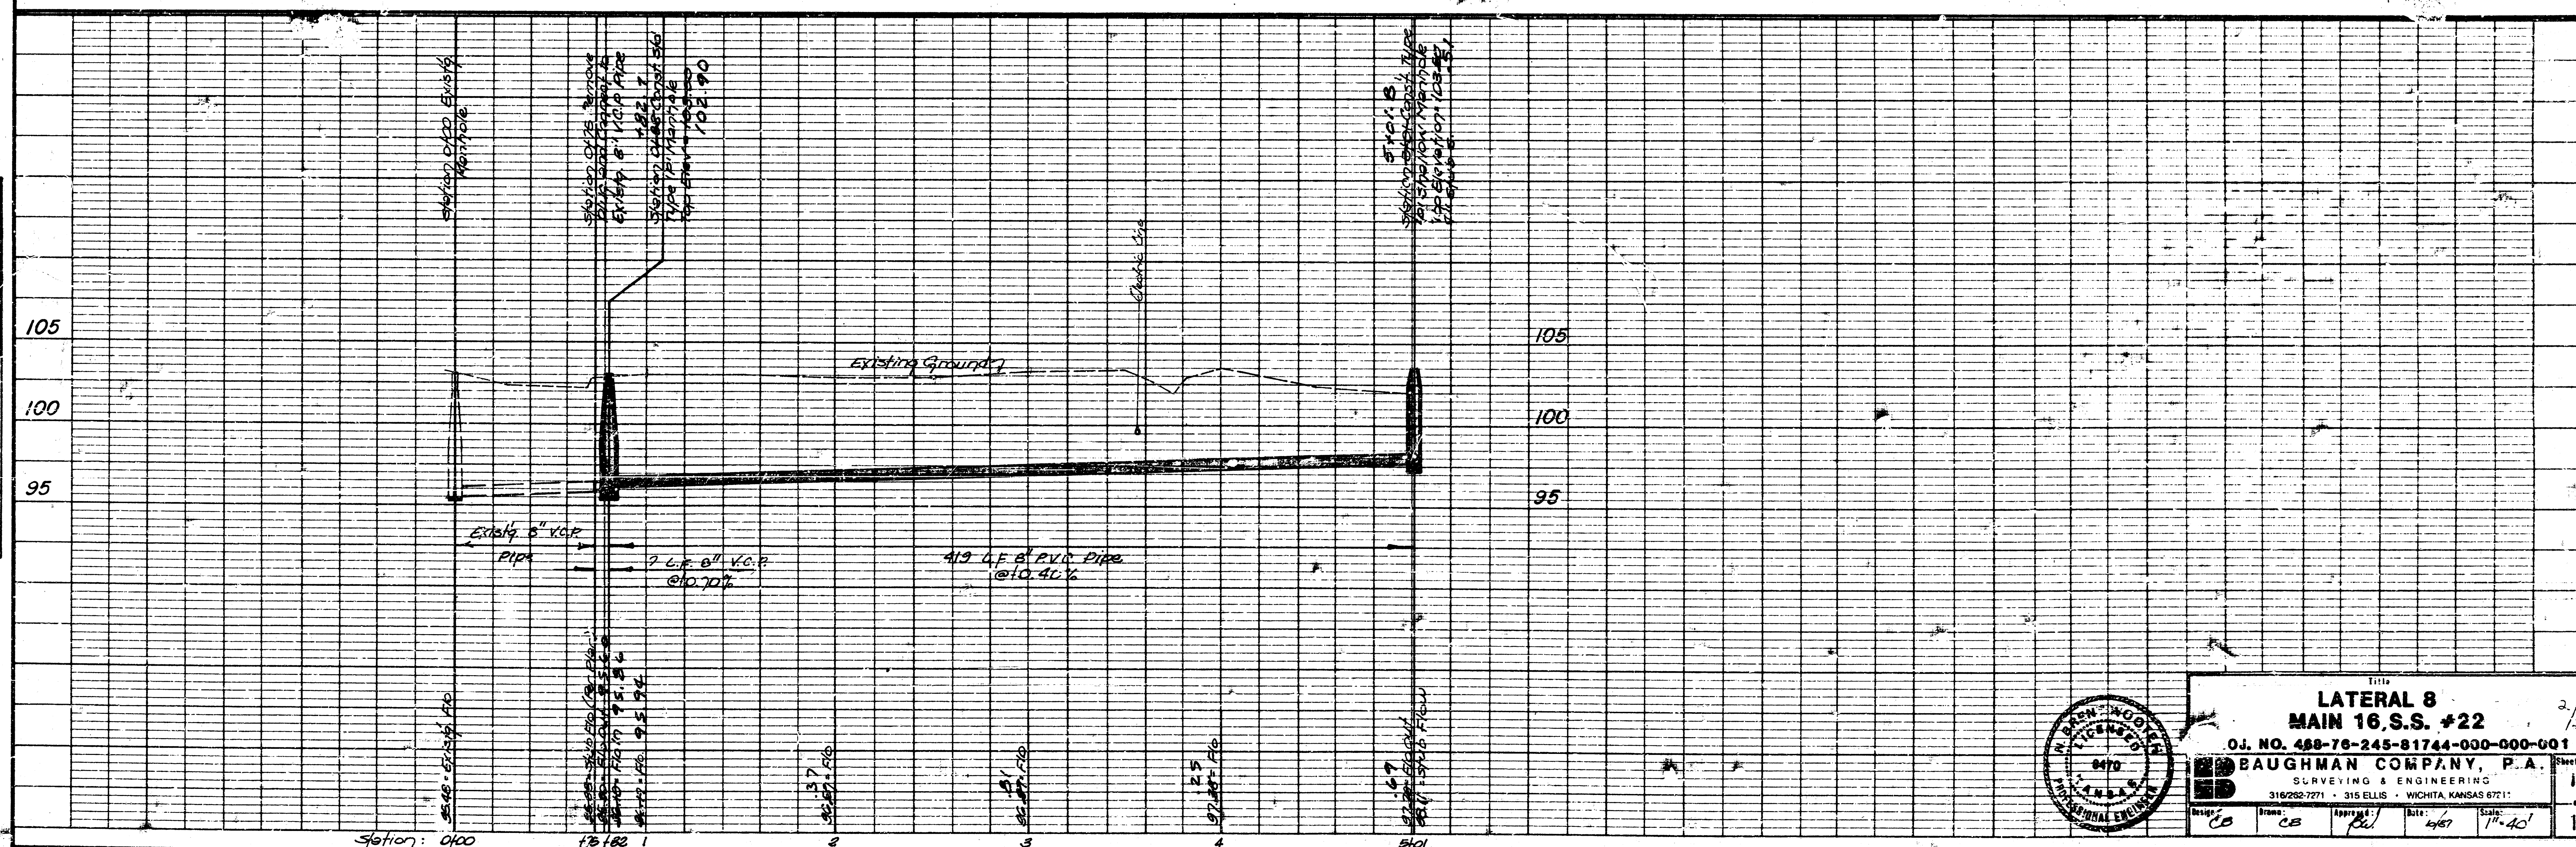

LATERAL 8
MAIN 16 S.S. #22
O.J. NO. 458-76-245-81744-000-001
R. B. BAUGHMAN COMPANY, P.A.
SURVEYING & ENGINEERING
316/262-7271 • 315 ELLIS • WICHITA, KANSAS 67211
Date: 4/97 Scale: 1" = 40'