


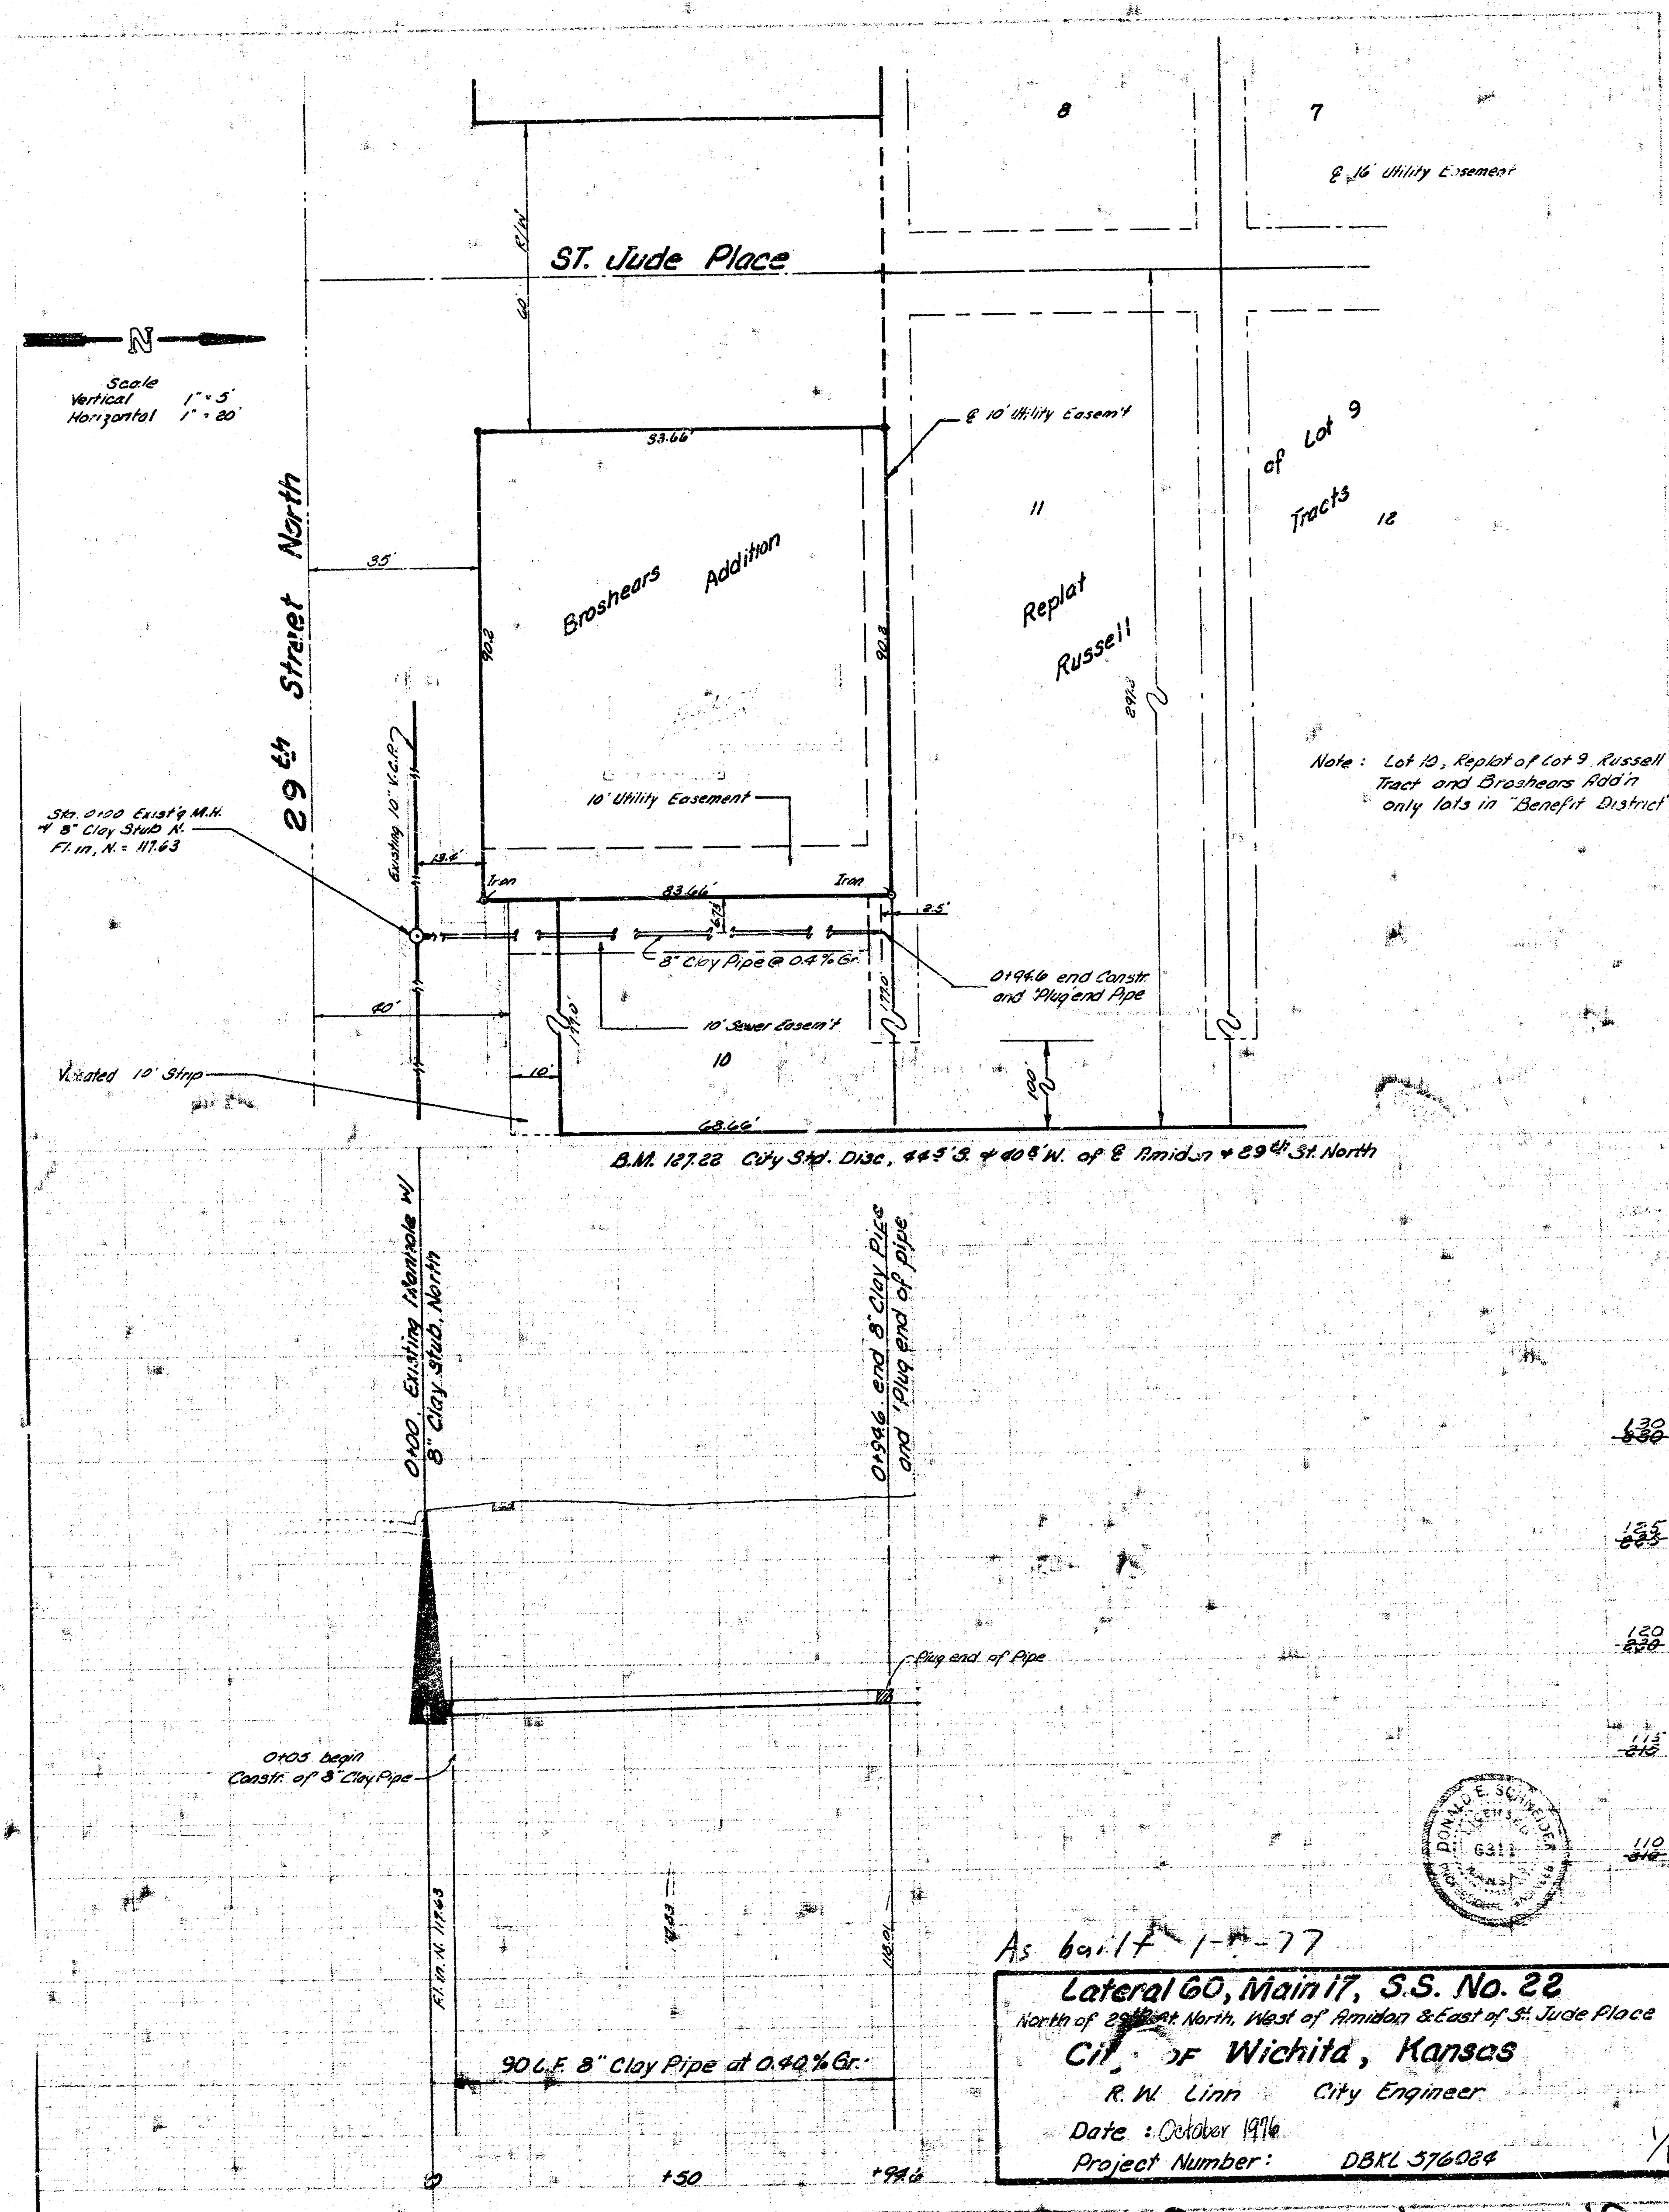

As built 1-7-77

Lateral 60, Main 17, S.S. No. 22
 North of 29th Street North, West of Amidon & East of St. Jude Place
City of Wichita, Kansas
 R. W. Linn City Engineer
 Date: October 1976
 Project Number: DBKL 576024

