




PLANS
 NORTH BOOK
 156 241
 2000

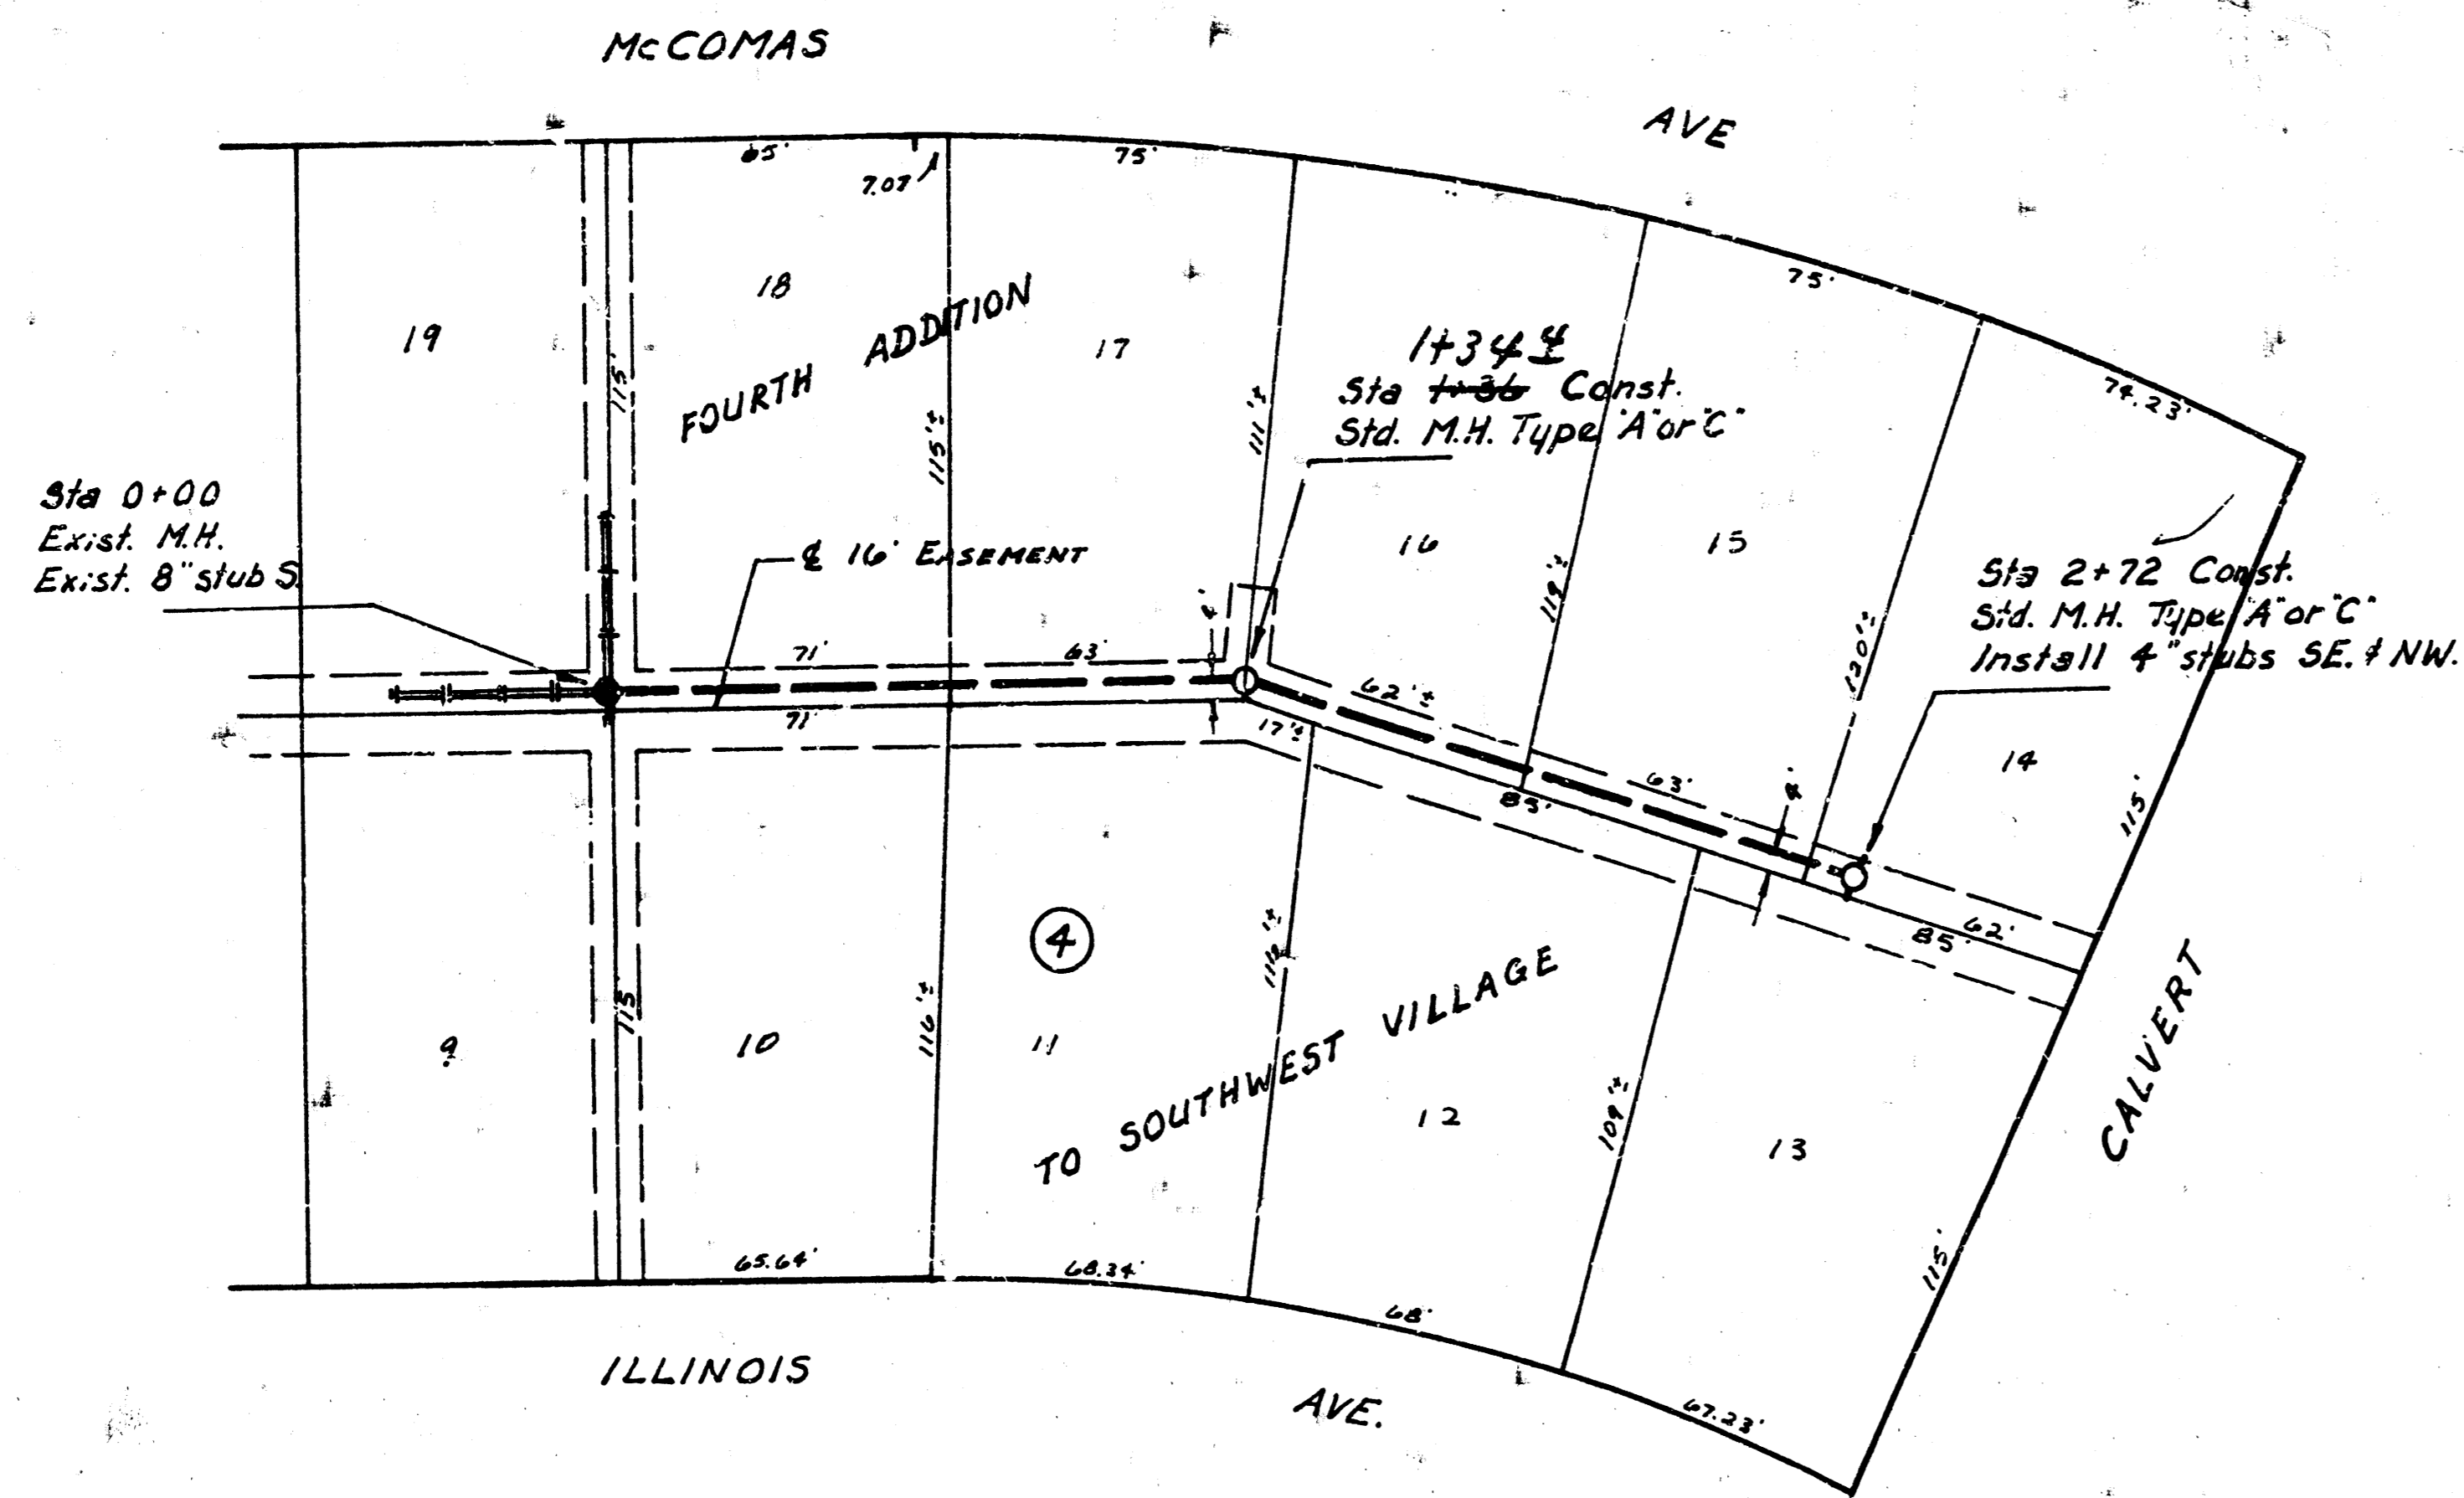

PLAN SCALE 1" = 40'
 PROFILE SCALE 1" = 40' HORIZ.
 1" = 5' VERT.

B.M. 103.47 City Sid. 53' E. & 44' S. of W. West St. & 31st St. So.
 B.M. 100.80 "a" cut on NW corner of East Headwall to R.C.B. just N. of 81st St. - Pass S. of 31st St. So. on West St.

PROFILE
 NORTH BOOK
 156 241
 2000

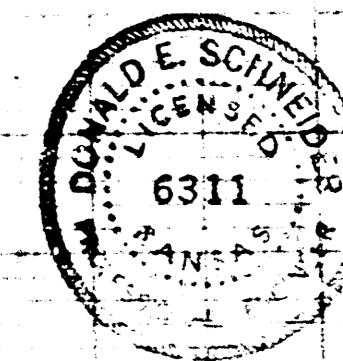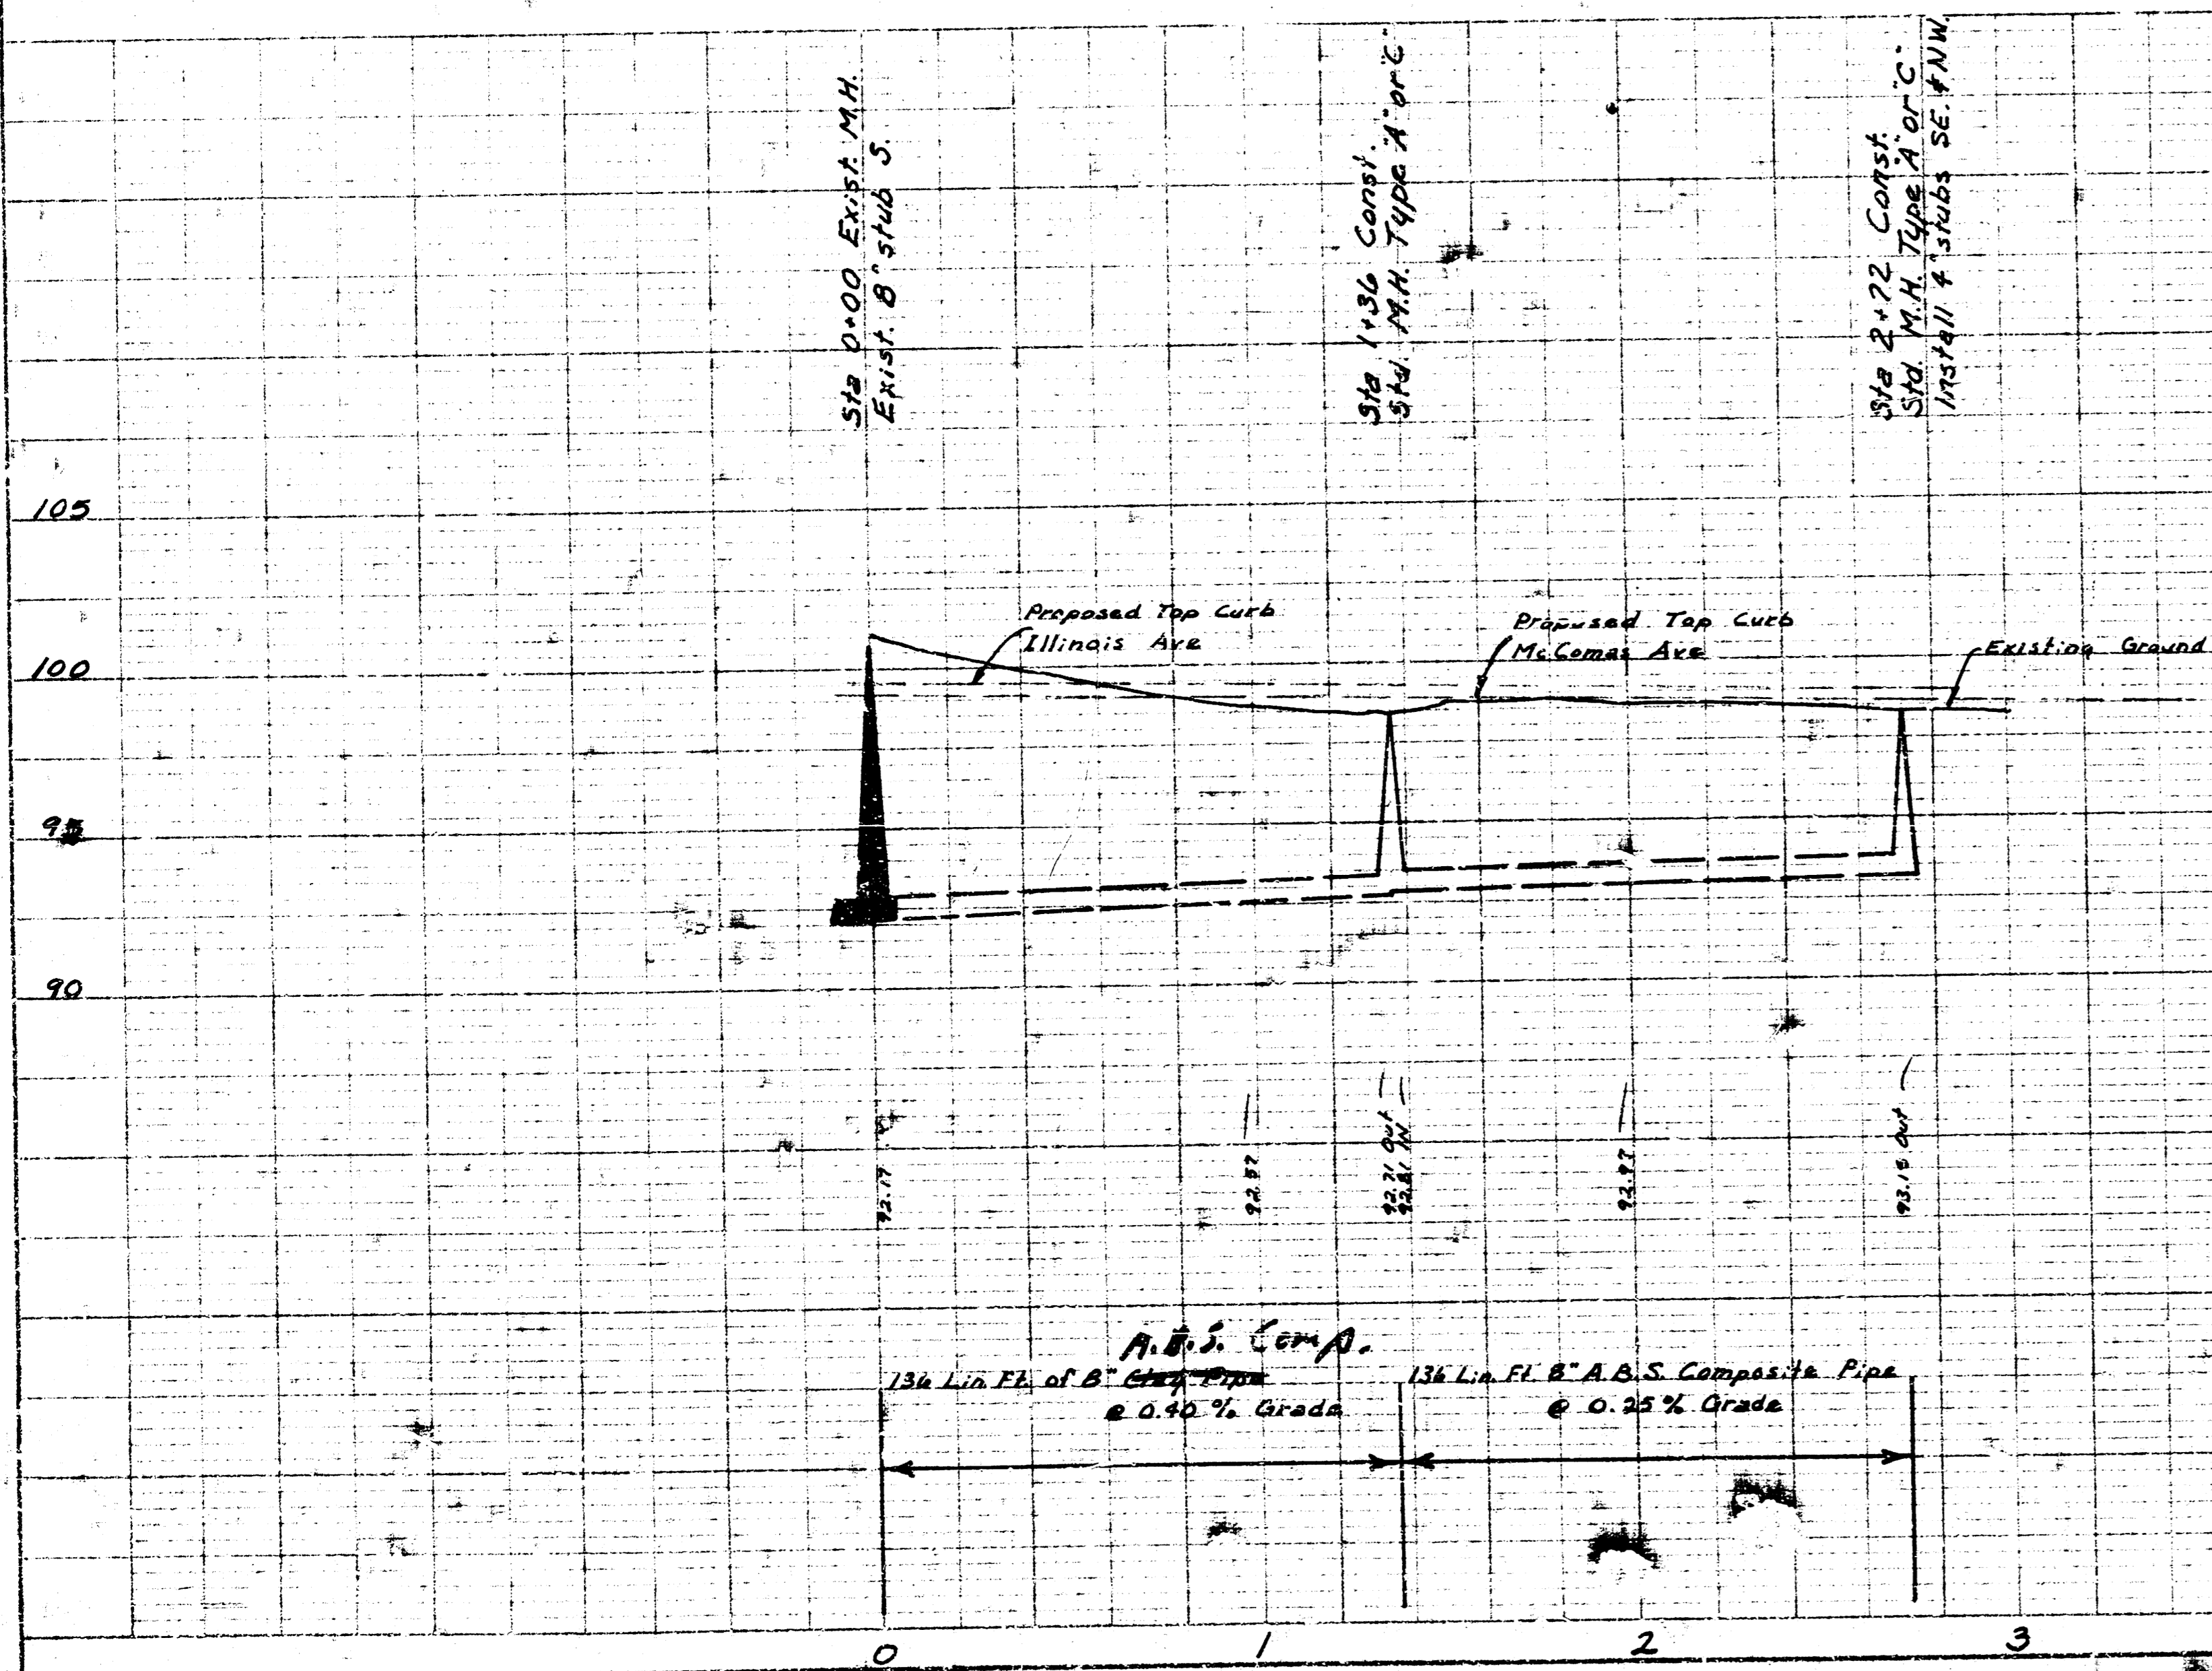

As built 7-5-77

LAT 4, MAIN 23, S.S. # 22
 CITY OF WICHITA, KANSAS
 R. W. LINN — CITY ENGINEER
 PROJECT NO. DBKL575011
 Feb. 1977

14 10 3 12 1/2