


Plan Scale: 1" = 40'
Profile Scale: 1" = 40' Horz.
1" = 5' Vert.

BM 100.68 "+" on top of curb at the east end of return SE corner of Kessler Ave. and 31st St. South

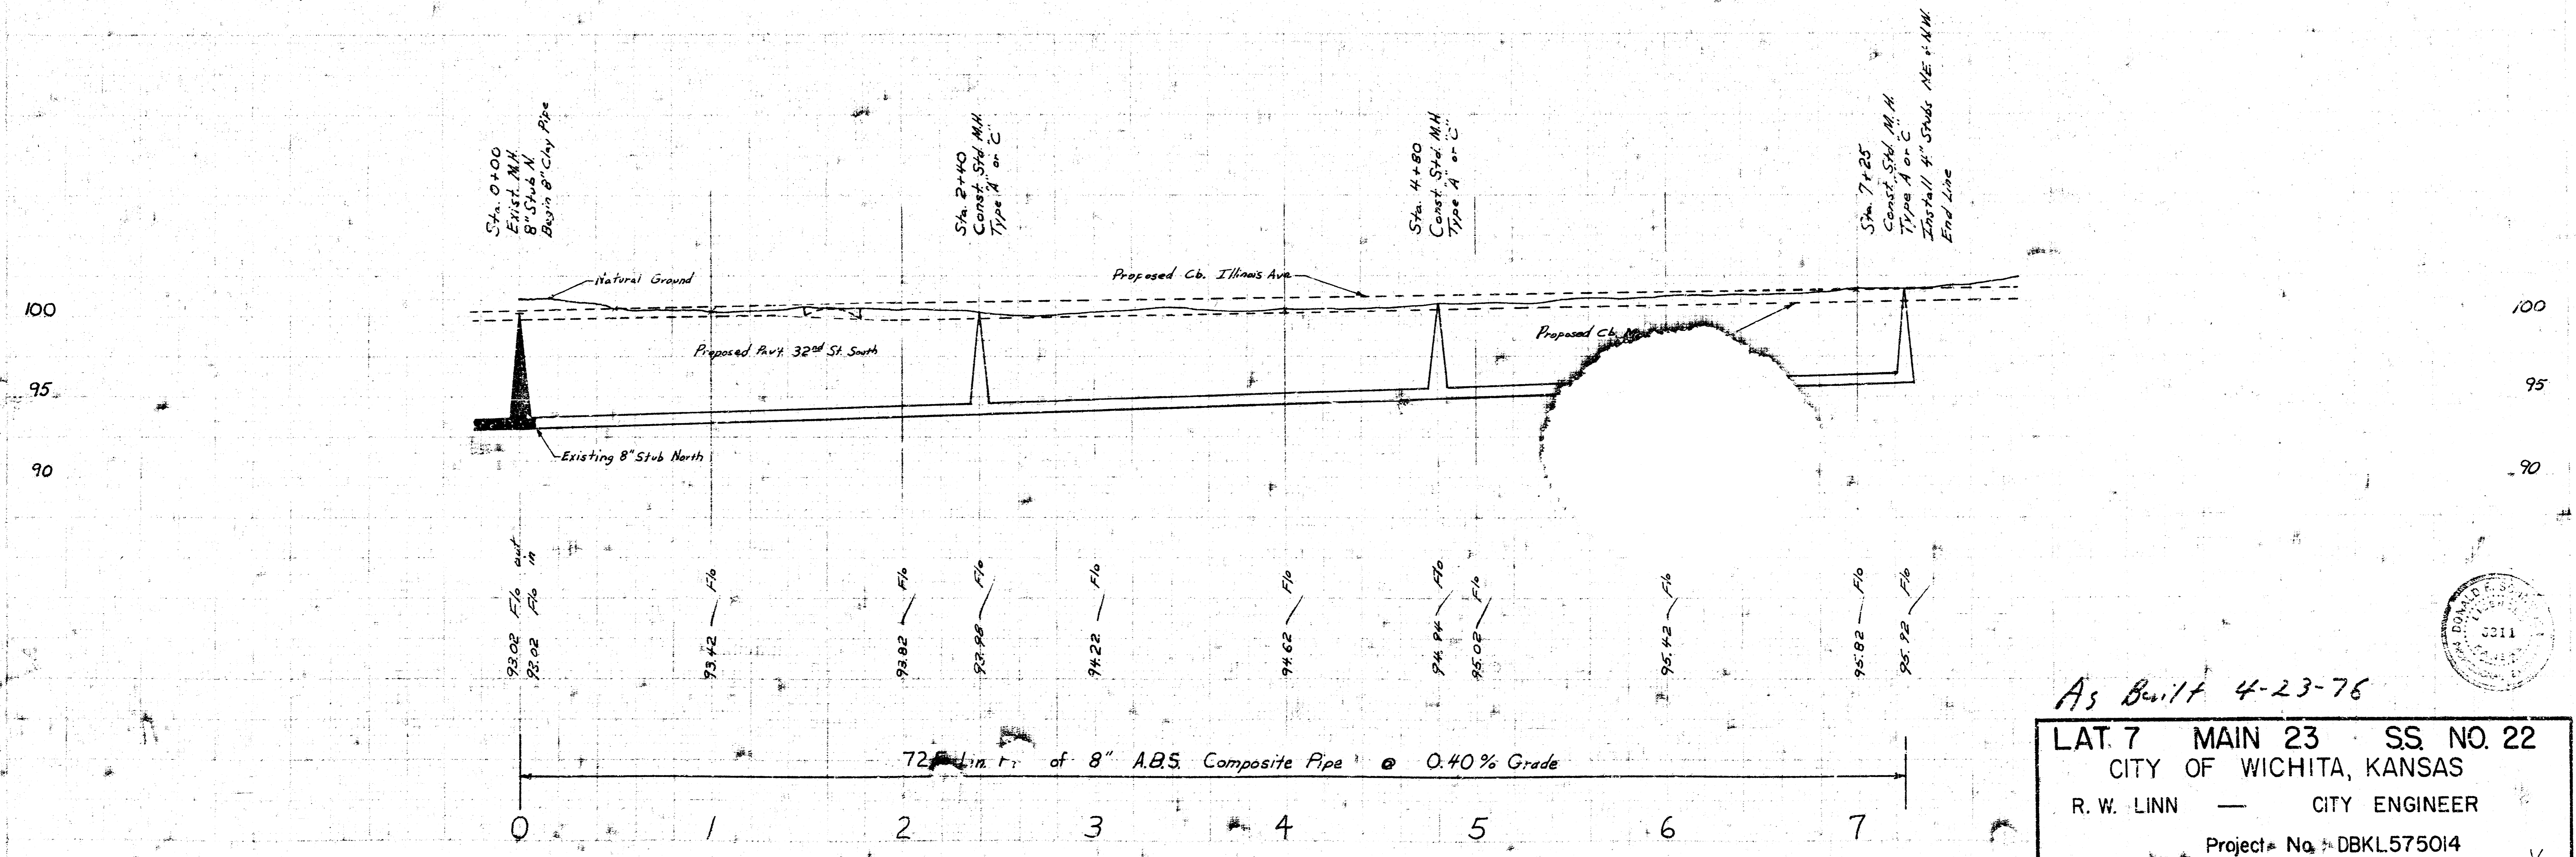

As Built 4-23-76

LAT. 7 MAIN 23 SS NO. 22
CITY OF WICHITA, KANSAS
R. W. LINN — CITY ENGINEER
Project# No. DBKL575014