

N
 Plan Scale 1" = 40'
 Profile Scale 1" = 40' Horz.
 1" = 5' Vert.


Sta. 0+00
 Exist. MH
 8" Stub S
 Begin 8" Clay Pipe

1+43.5
 Sta. 1+43.5
 Const. Std. MH
 Type "A" or "C"

3+92.5
 Sta. 3+92
 Const. Std. MH
 Type "A" or "C"

4+65.0
 Sta. 4+65
 Const. Std. MH
 Type "A" or "C"
 Install 4" Stubs SE & SW
 End Line

BM 100.68 "+" on top of curb at the east end of return SE corner of Kessler Ave. and 3rd St. South

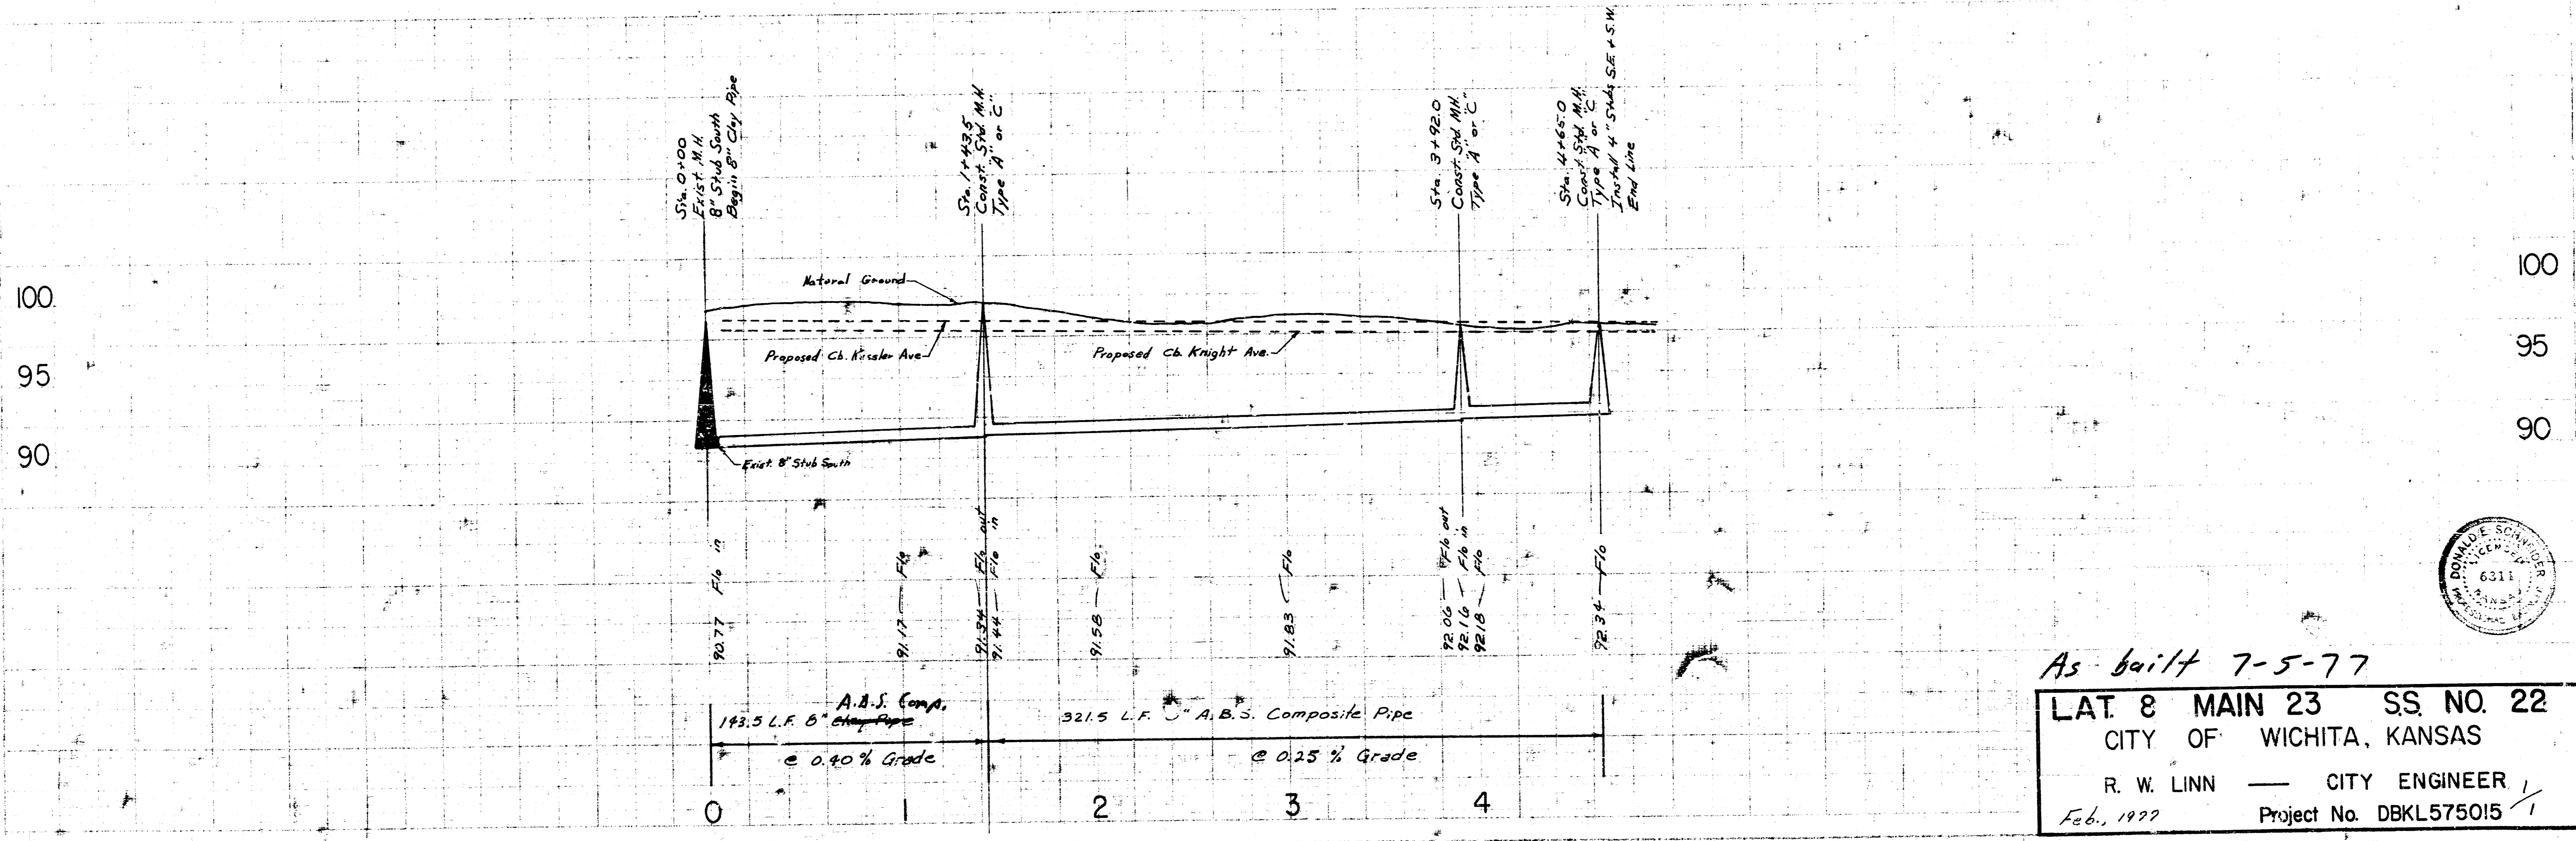

As built 7-5-77
LAT. 8 MAIN 23 SS. NO. 22
 CITY OF WICHITA, KANSAS
 R. W. LINN — CITY ENGINEER
 Feb. 1977 Project No. DBKL575015/1

14 10 3 1e