

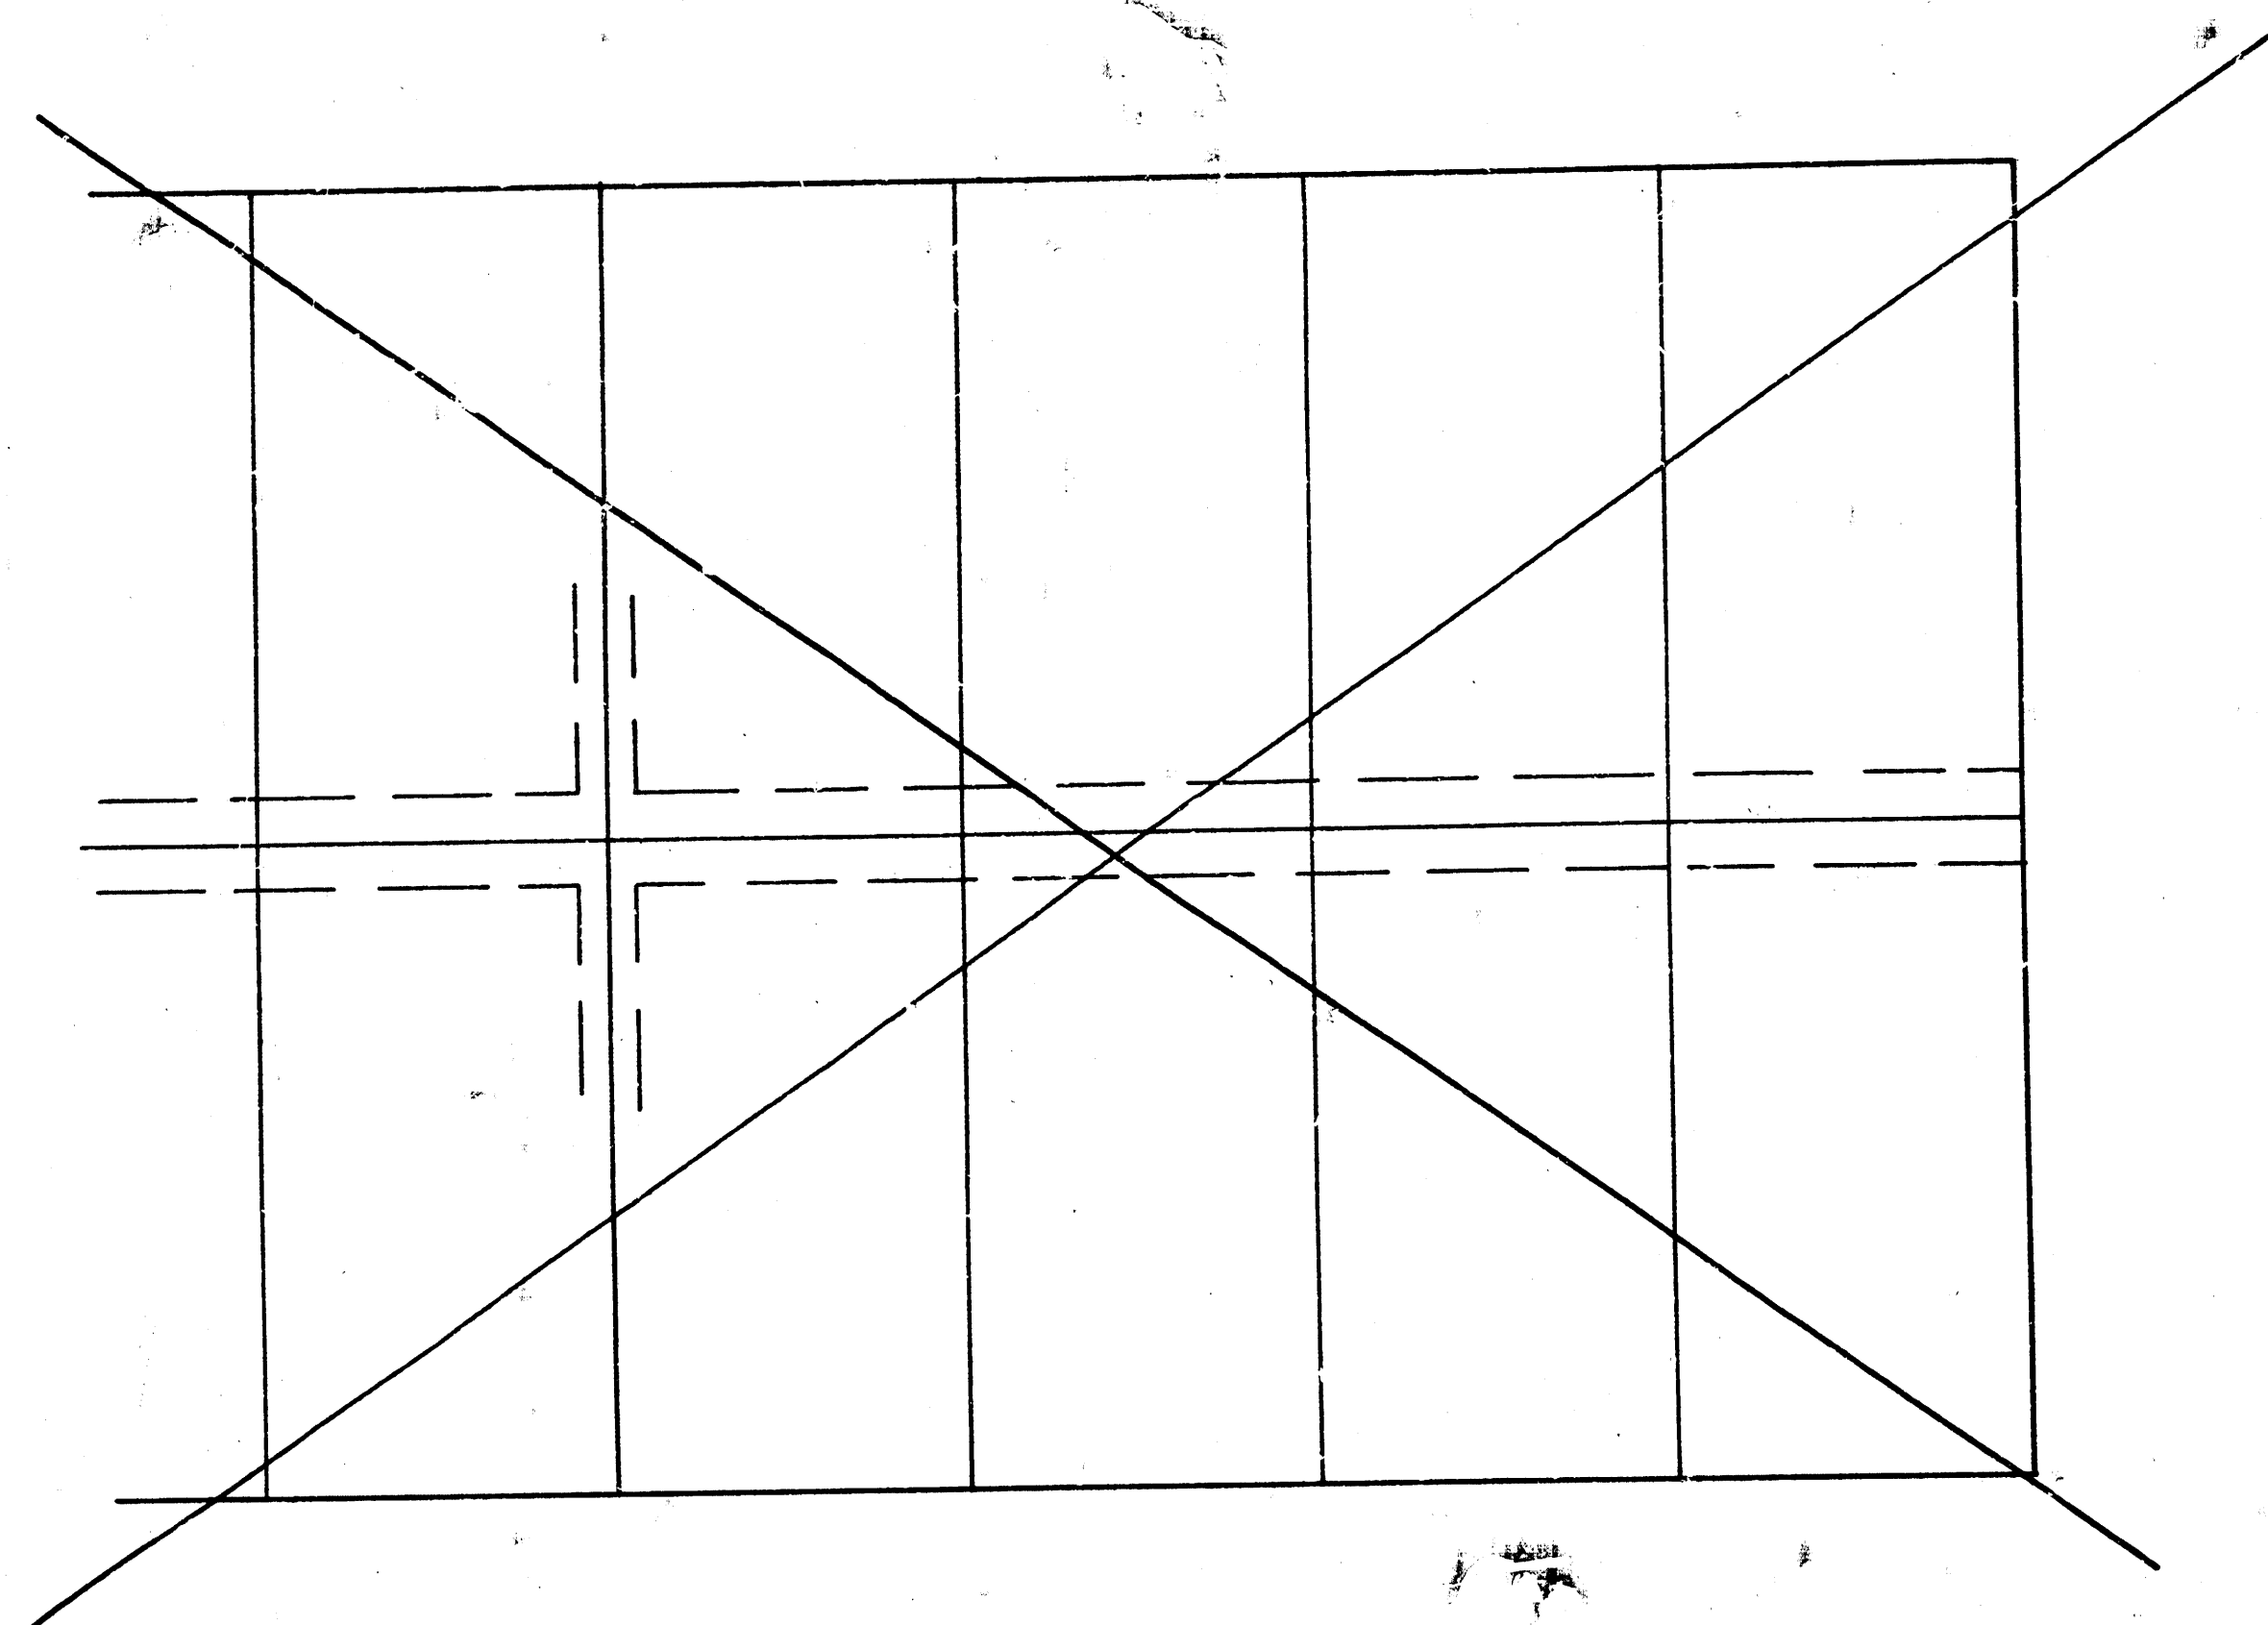
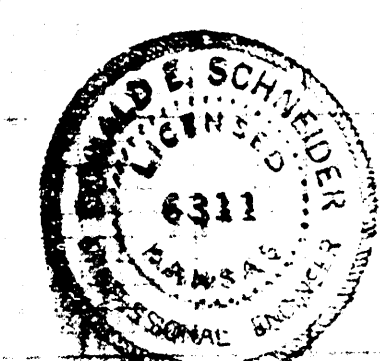


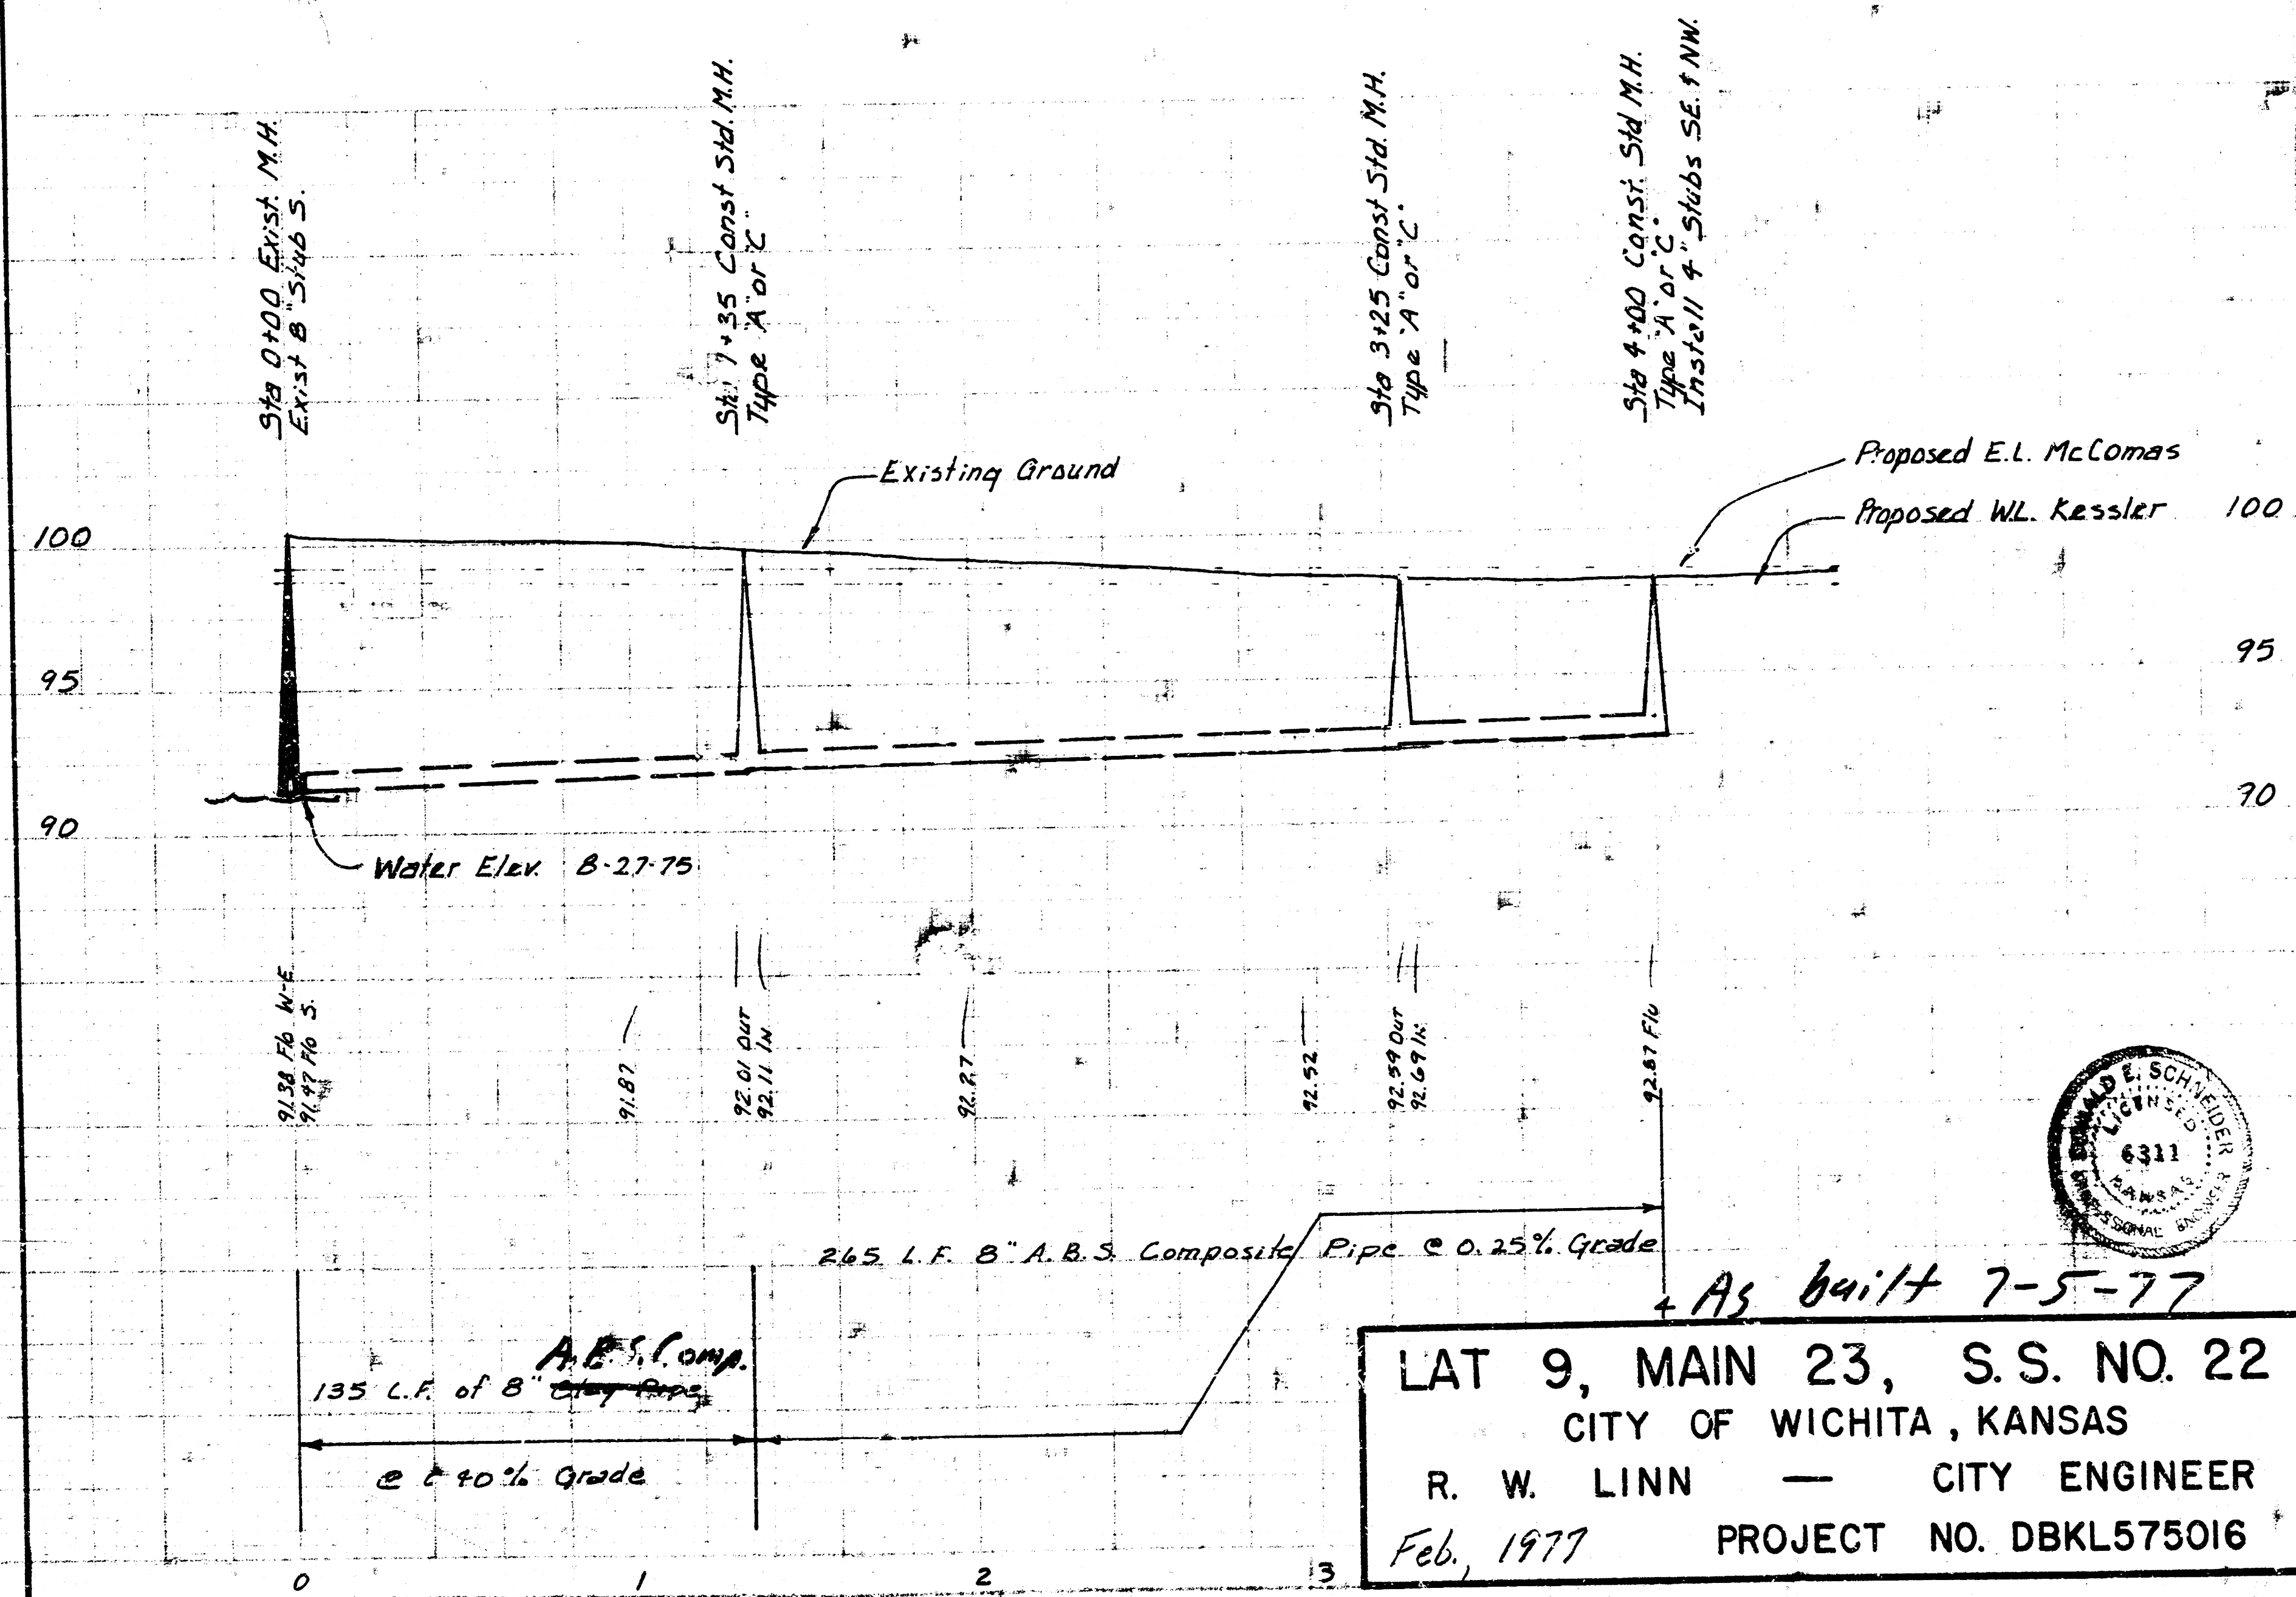

Since APR 29 1977  
 Plan R. Linn  
 Ex.  
 Checked

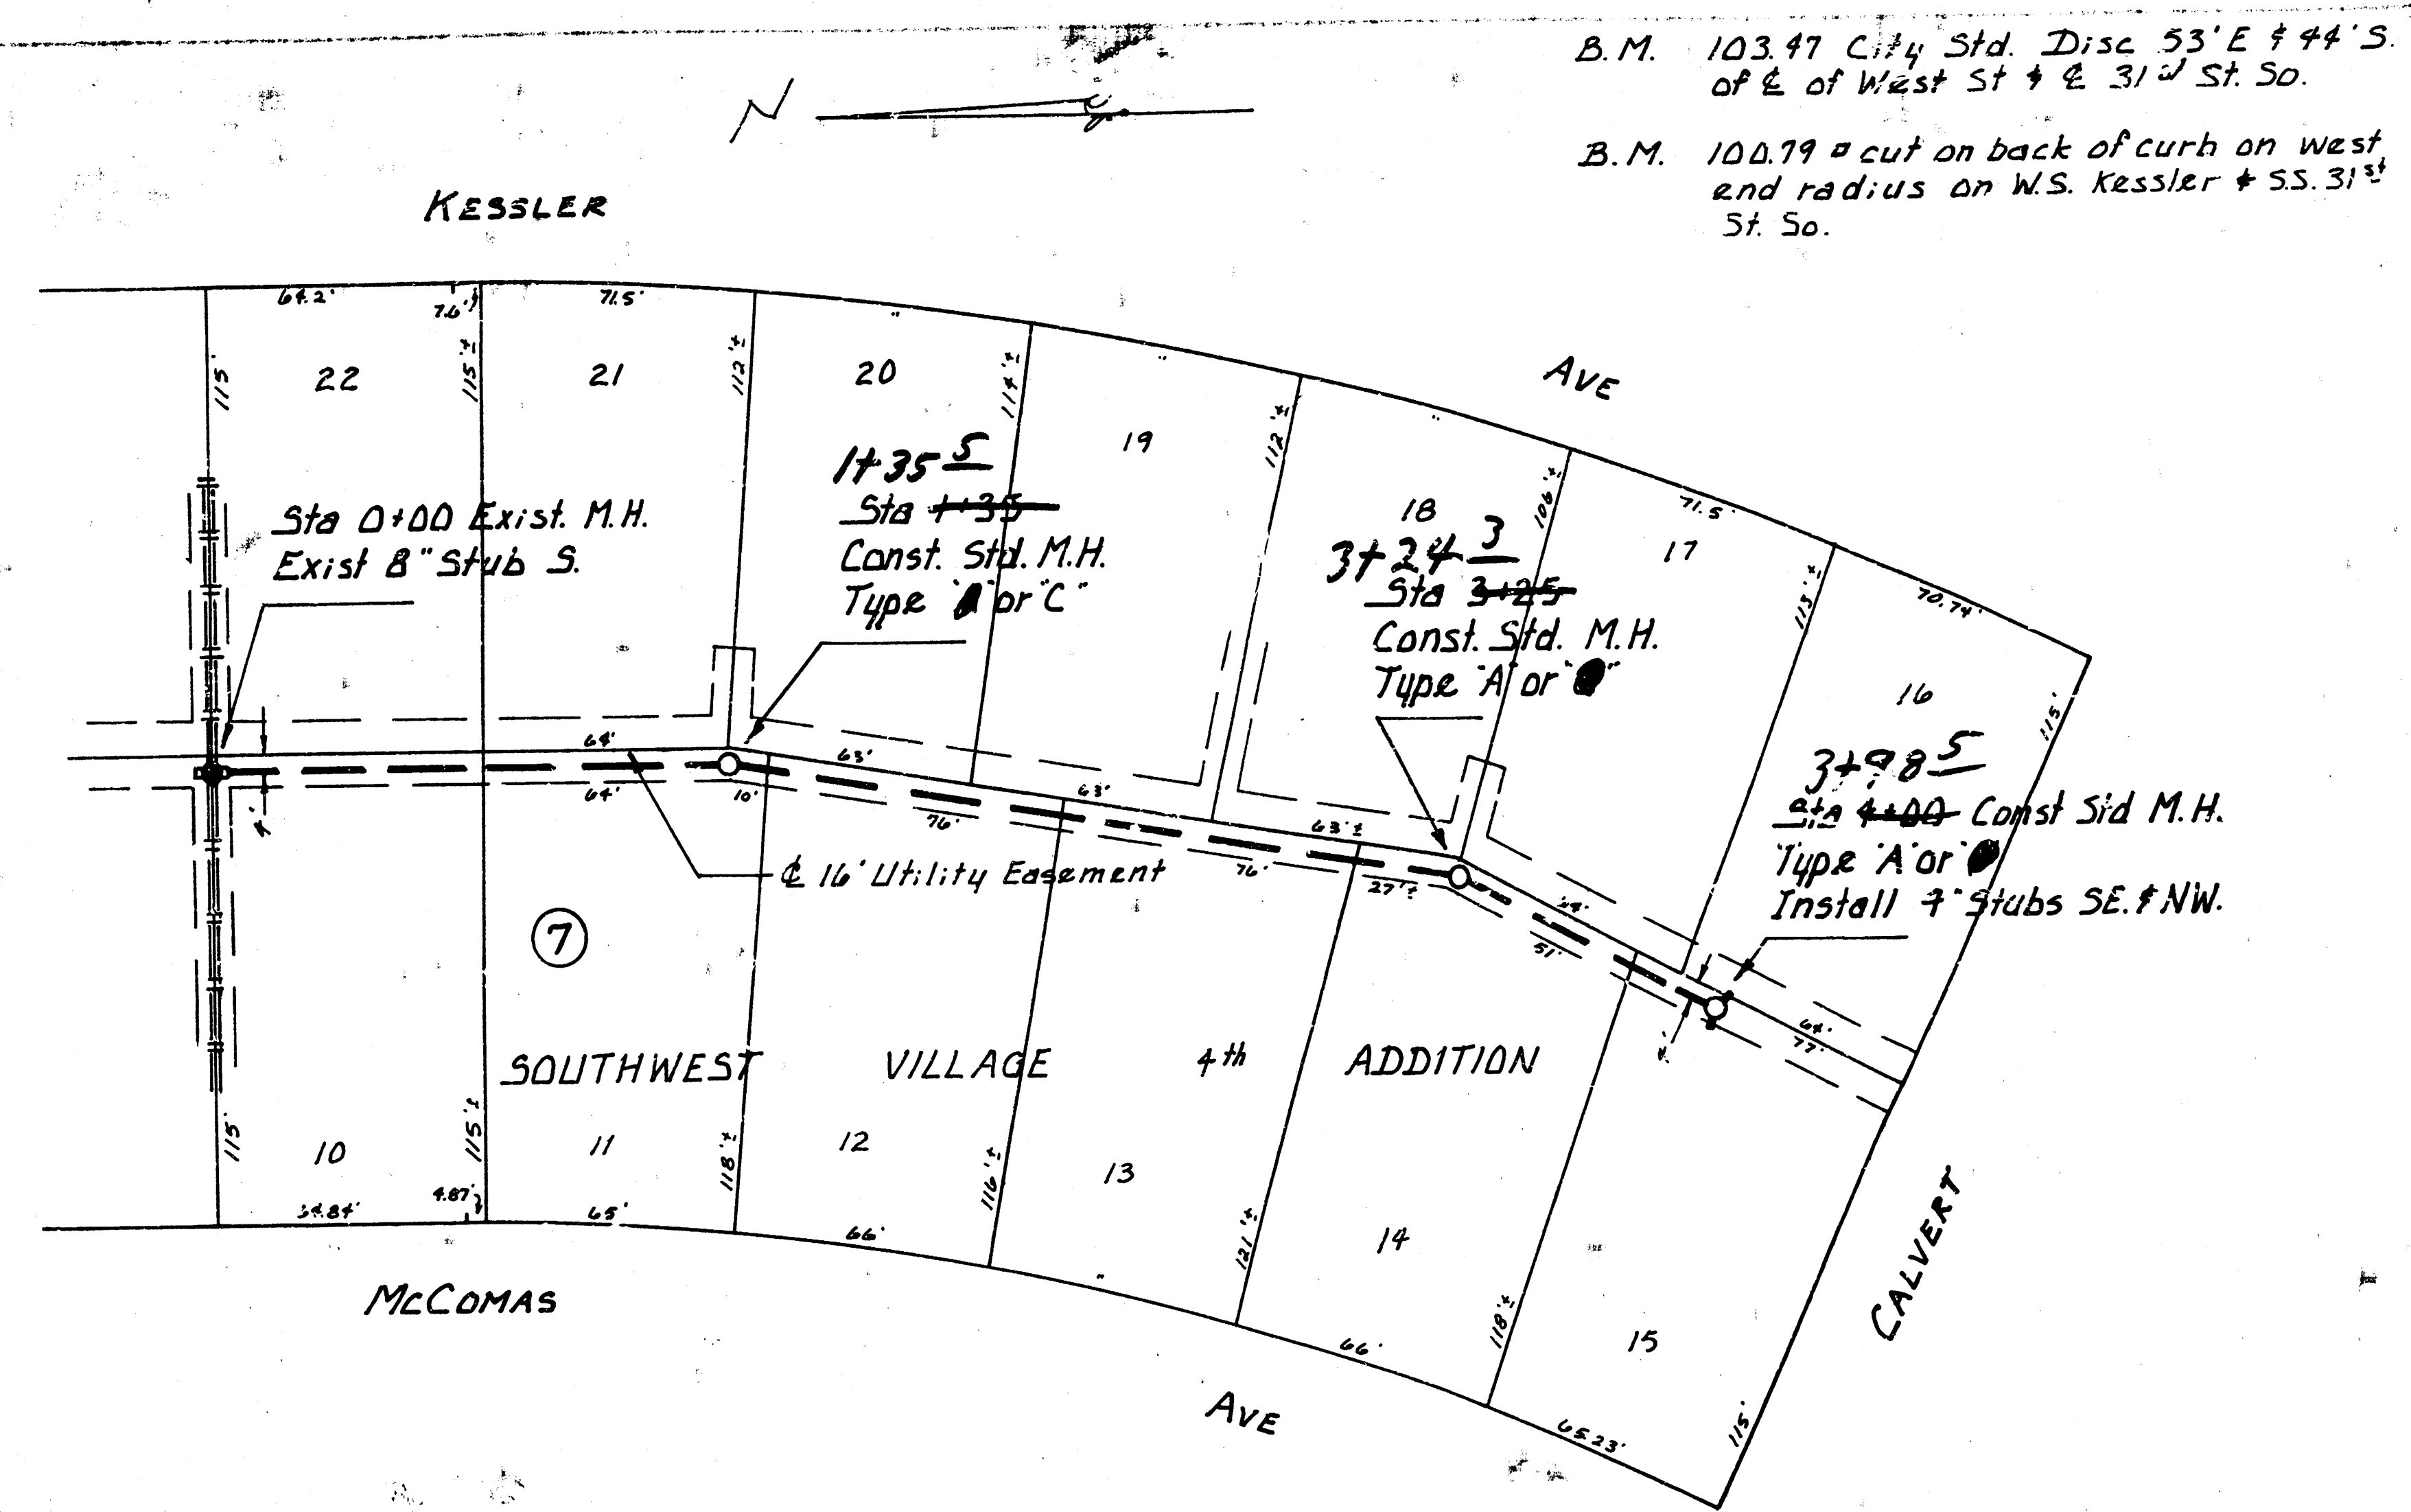

14 10 3 18 1/2