



D. M. 182.28 S.W. cor. conc. step  
 No. 4800 24th St. North.  
 3. M. 174.49 City Sid. 41' west of 32' N.  
 of 24th 23th & Oliver.  
 D. M. 186.38 S.W. cor. conc. porch 4914  
 E. 24th St. North.

D. L. K. W.  
 79  
 7/31

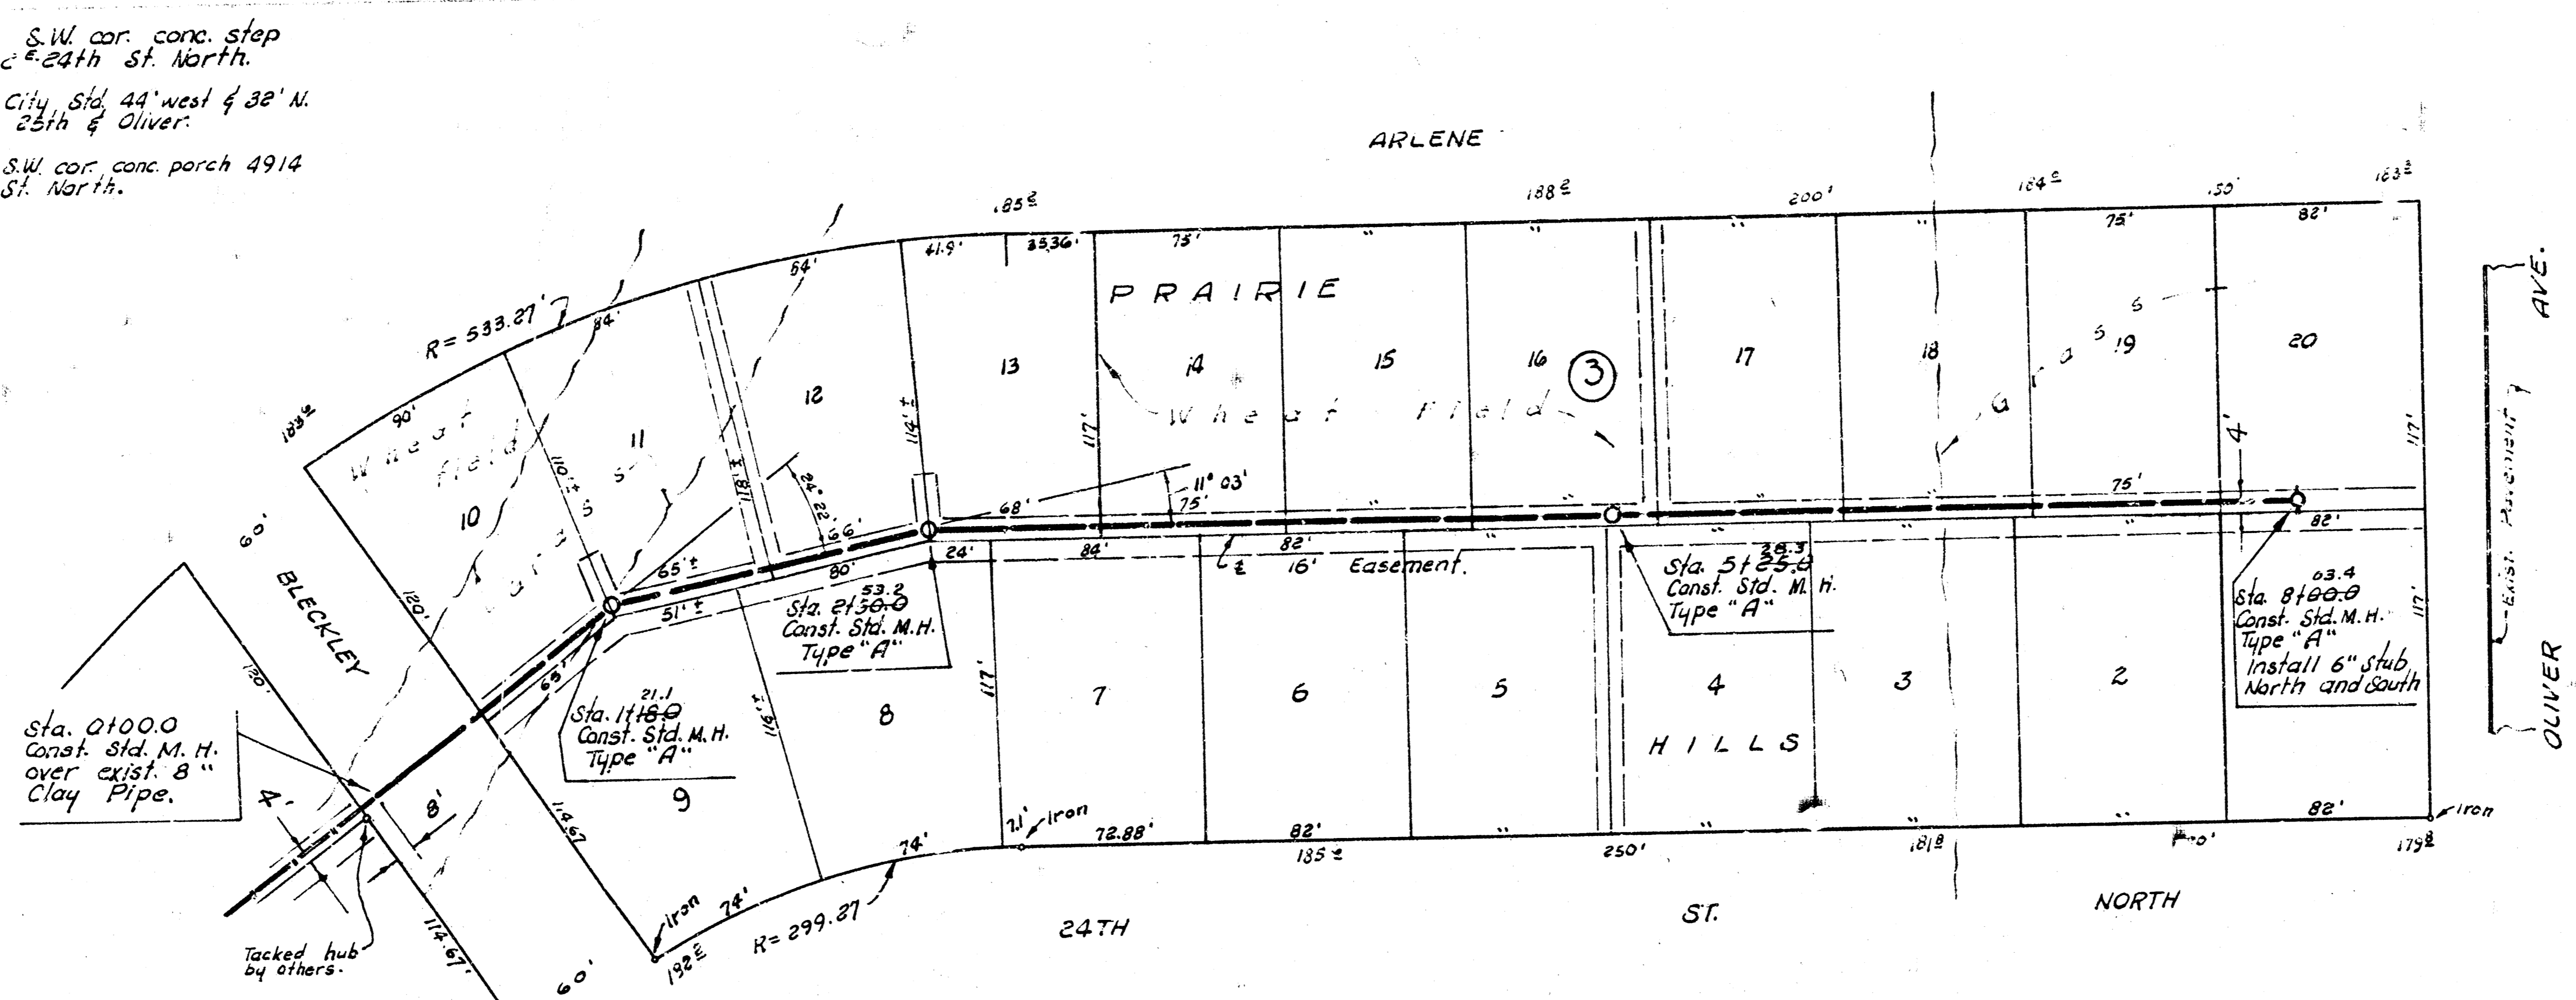

Plan Scale 1" = 40'  
 Profile Scale 1" = 40' Horiz.  
 1" = 5' Vert.

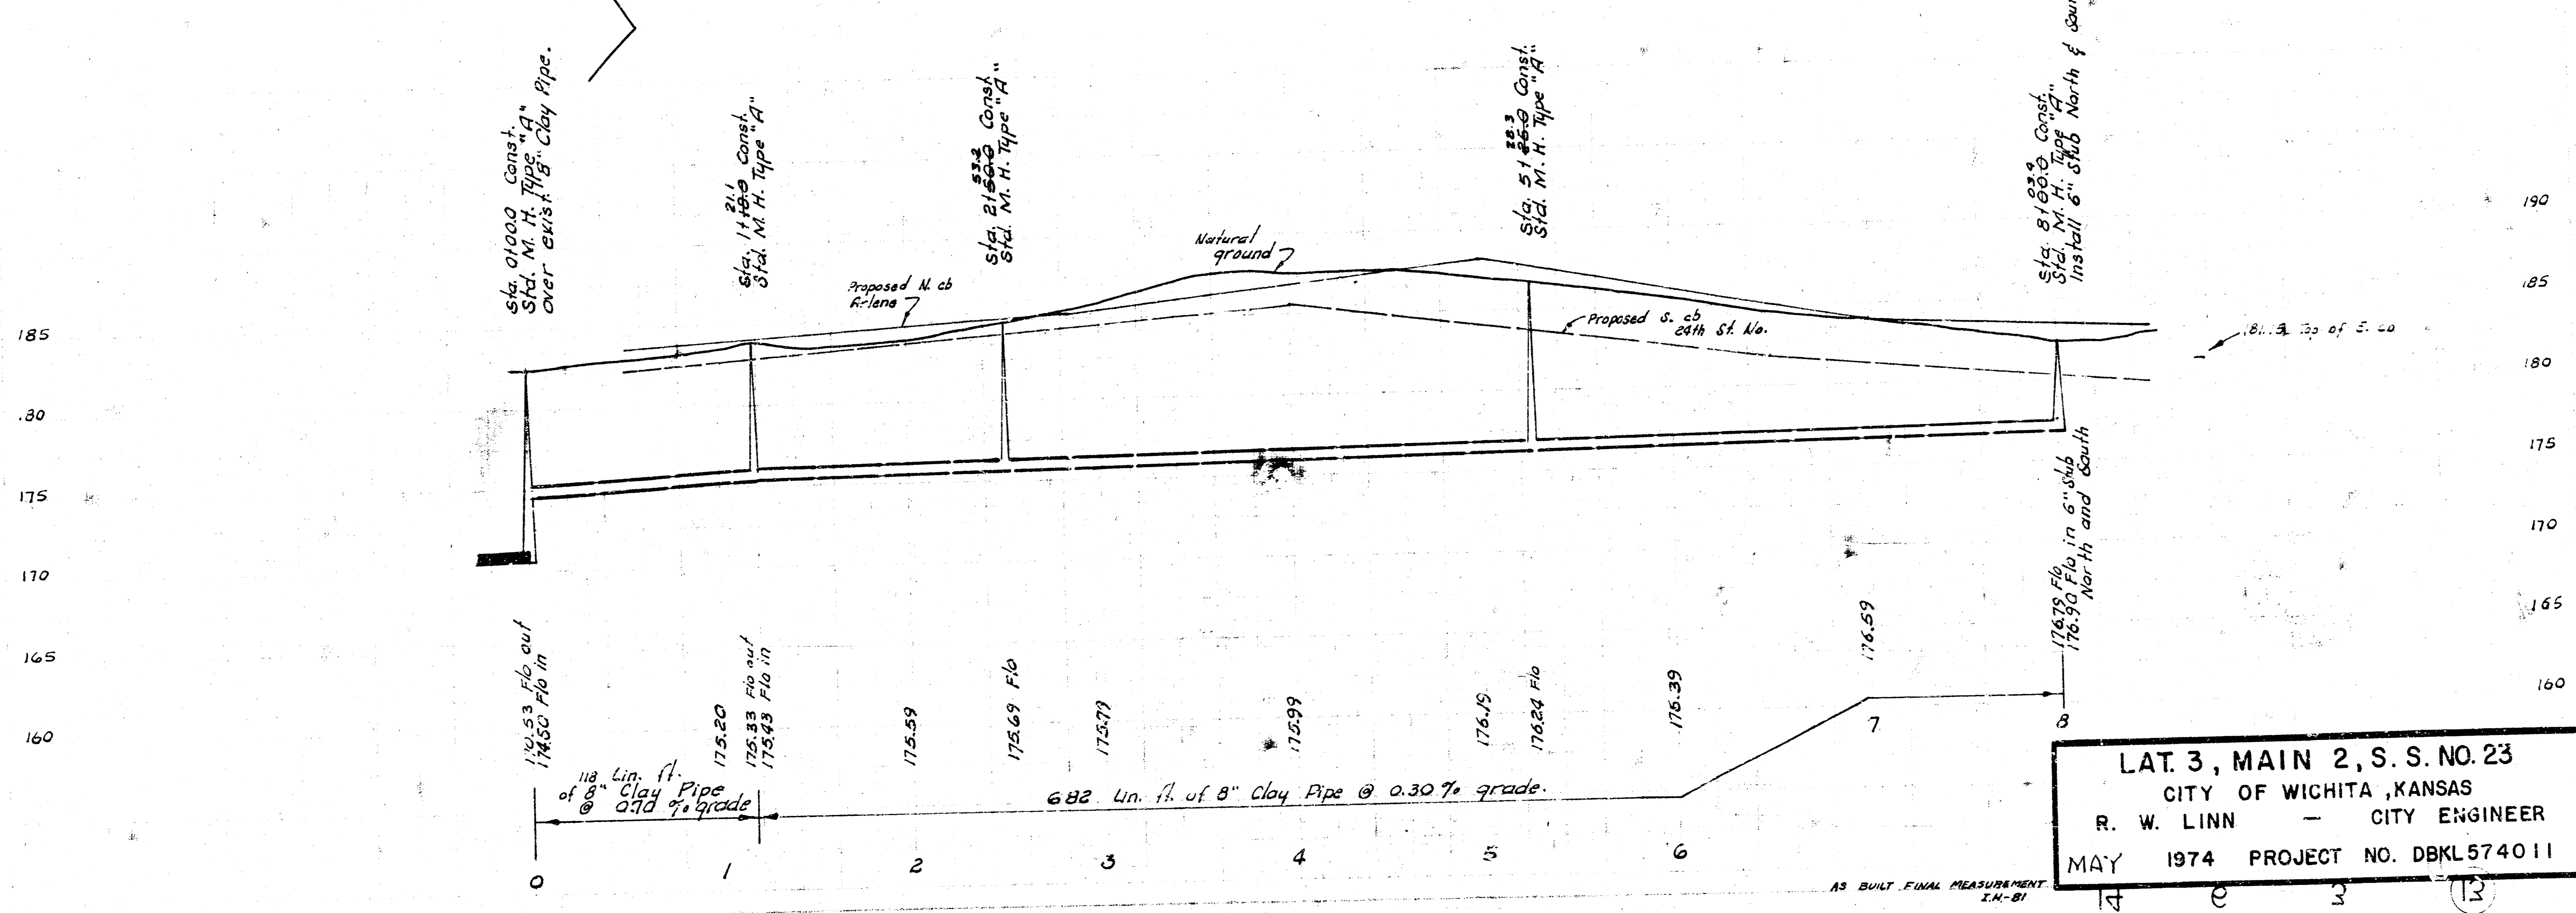

**LAT. 3, MAIN 2, S. S. NO. 23**  
**CITY OF WICHITA, KANSAS**  
**R. W. LINN - CITY ENGINEER**  
**MAY 1974 PROJECT NO. DBKL574011**

AS BUILT FINAL MEASUREMENT IN-81