




Checked by V.M. 2-23-54
 Checked by V.M. 2-23-54

B. M. 133.46 "M" in Mueller on Fire Hyd. 33rd and Market.

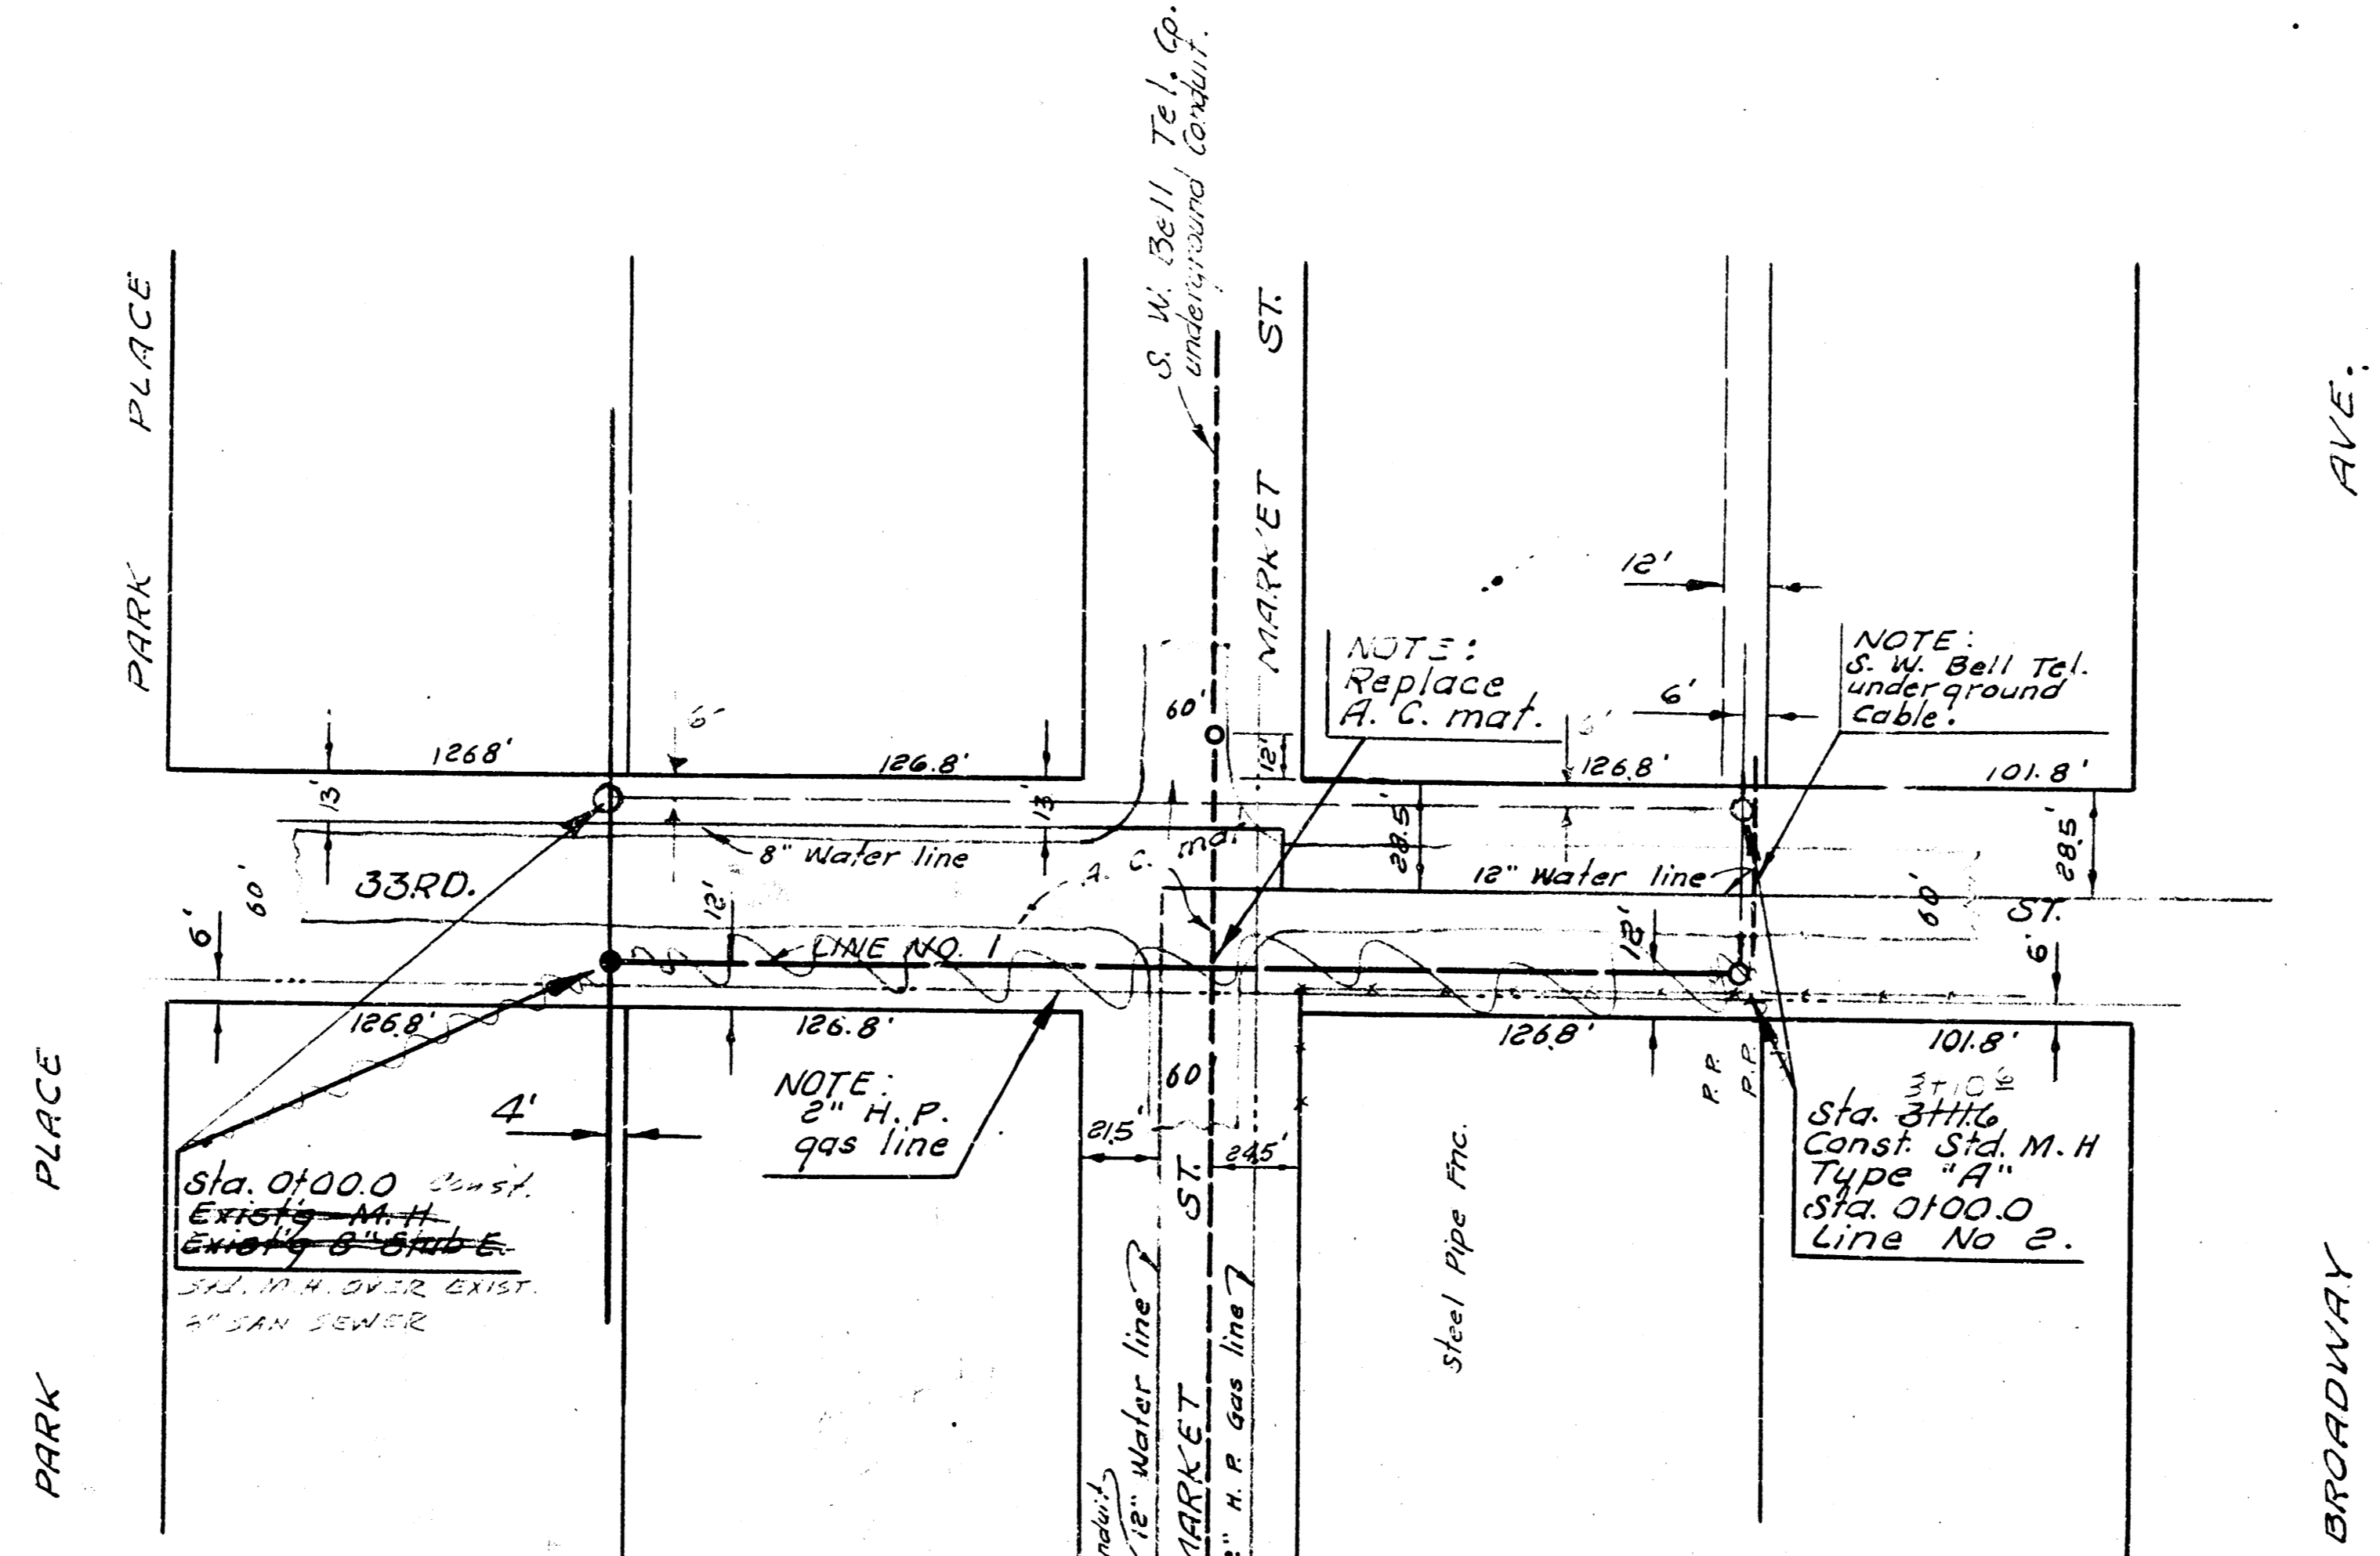

Plan Scale 1" = 40'
 Profile Scale 1" = 4' Vert.

NOTE TO CONTRACTOR:
 The removal of grape arbor is to be incidental to the project.
 Repair or replacement of septic tank laterals shall be included in bid price of pipe.
 Replace all fences.

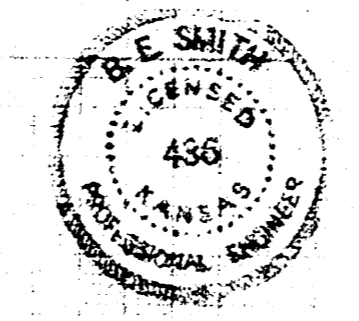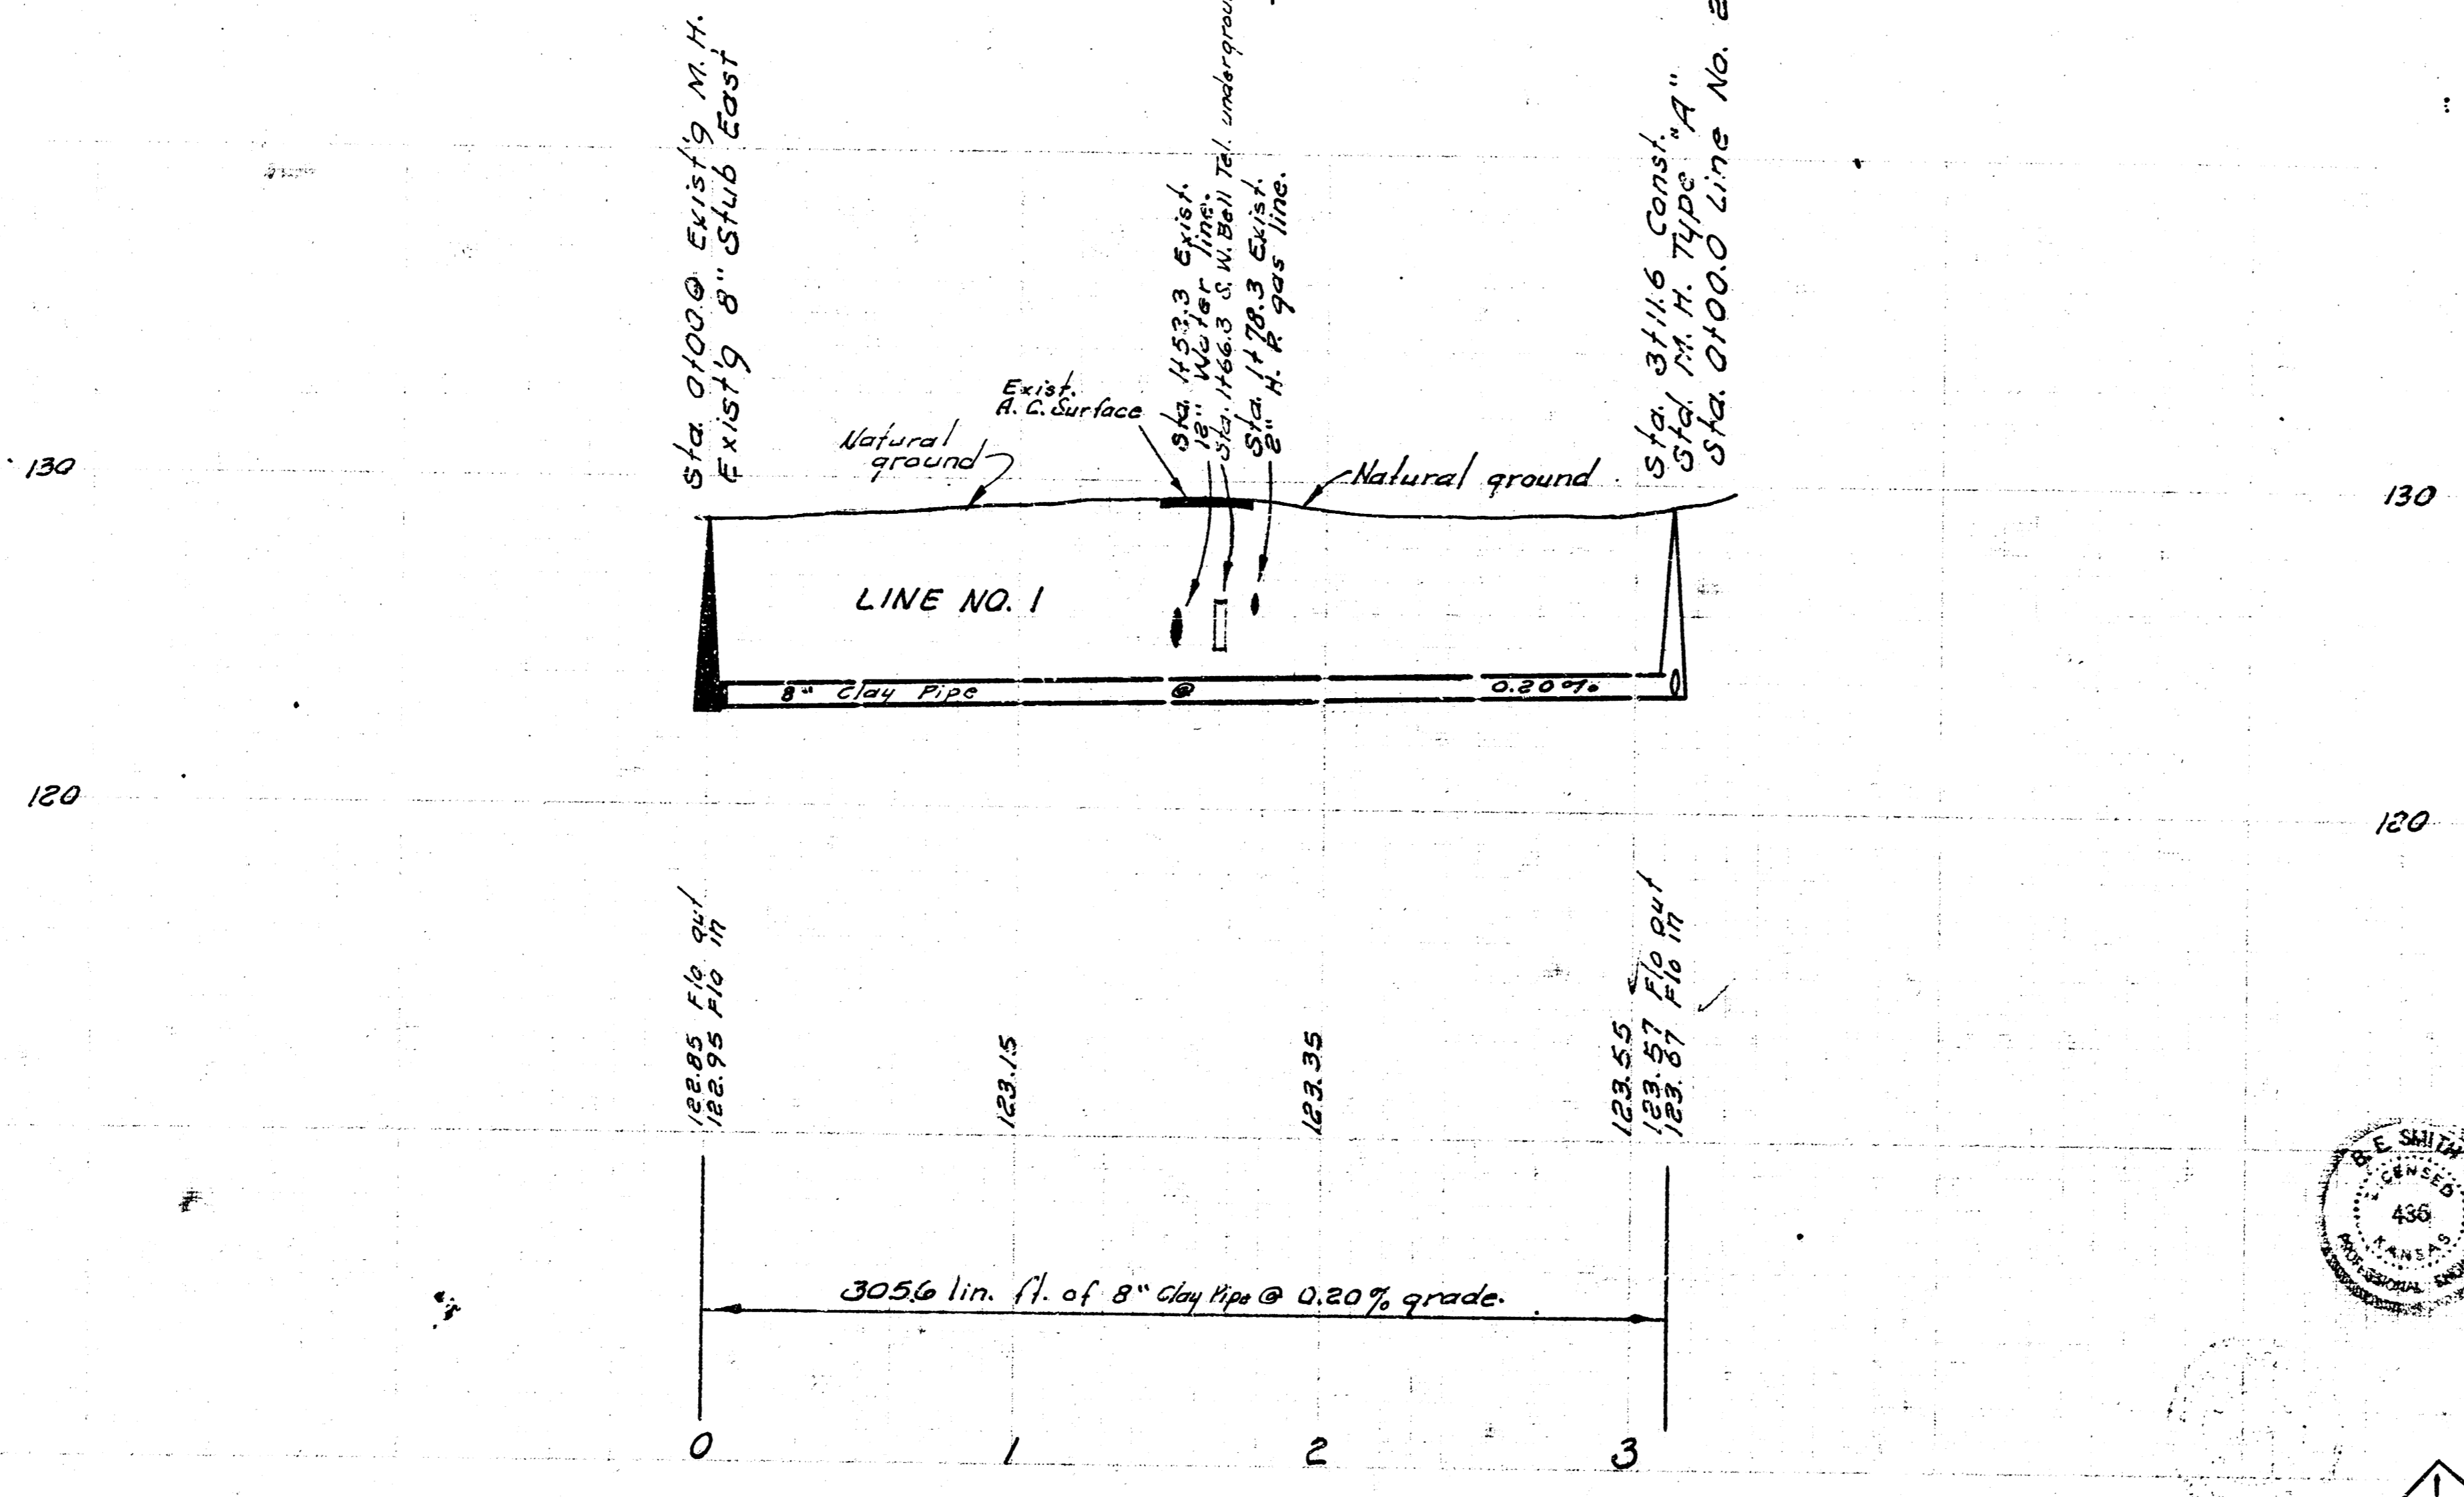

AS BUILT 1970
LAT. 12, SUBMAIN 4, S. S. NO. 23
 CITY OF WICHITA, KANSAS
 B. E. SMITH CITY ENGINEER
 FEB. 1970 PROJECT NO. C23-64

