

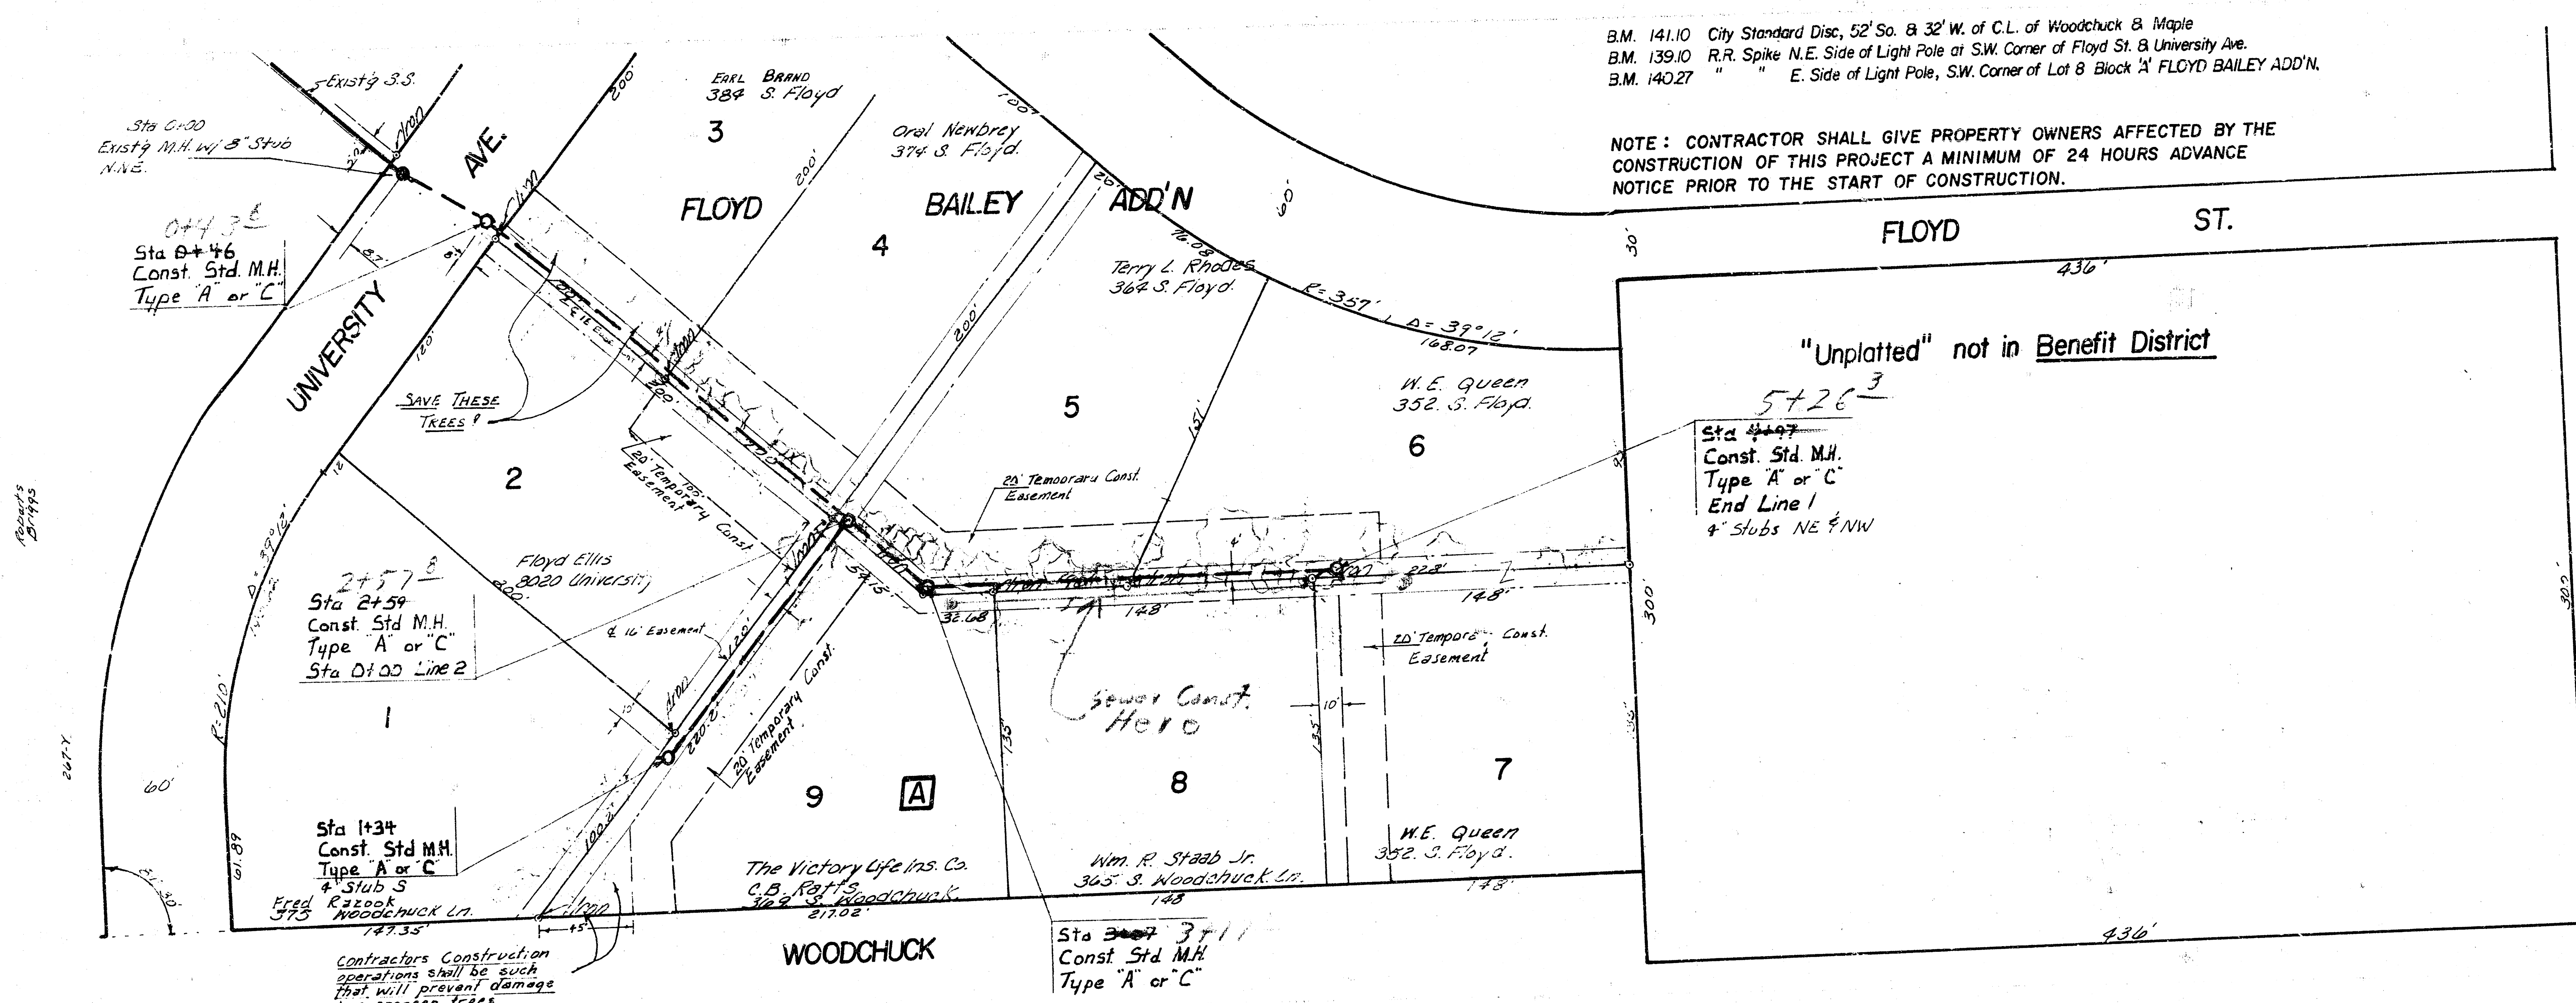


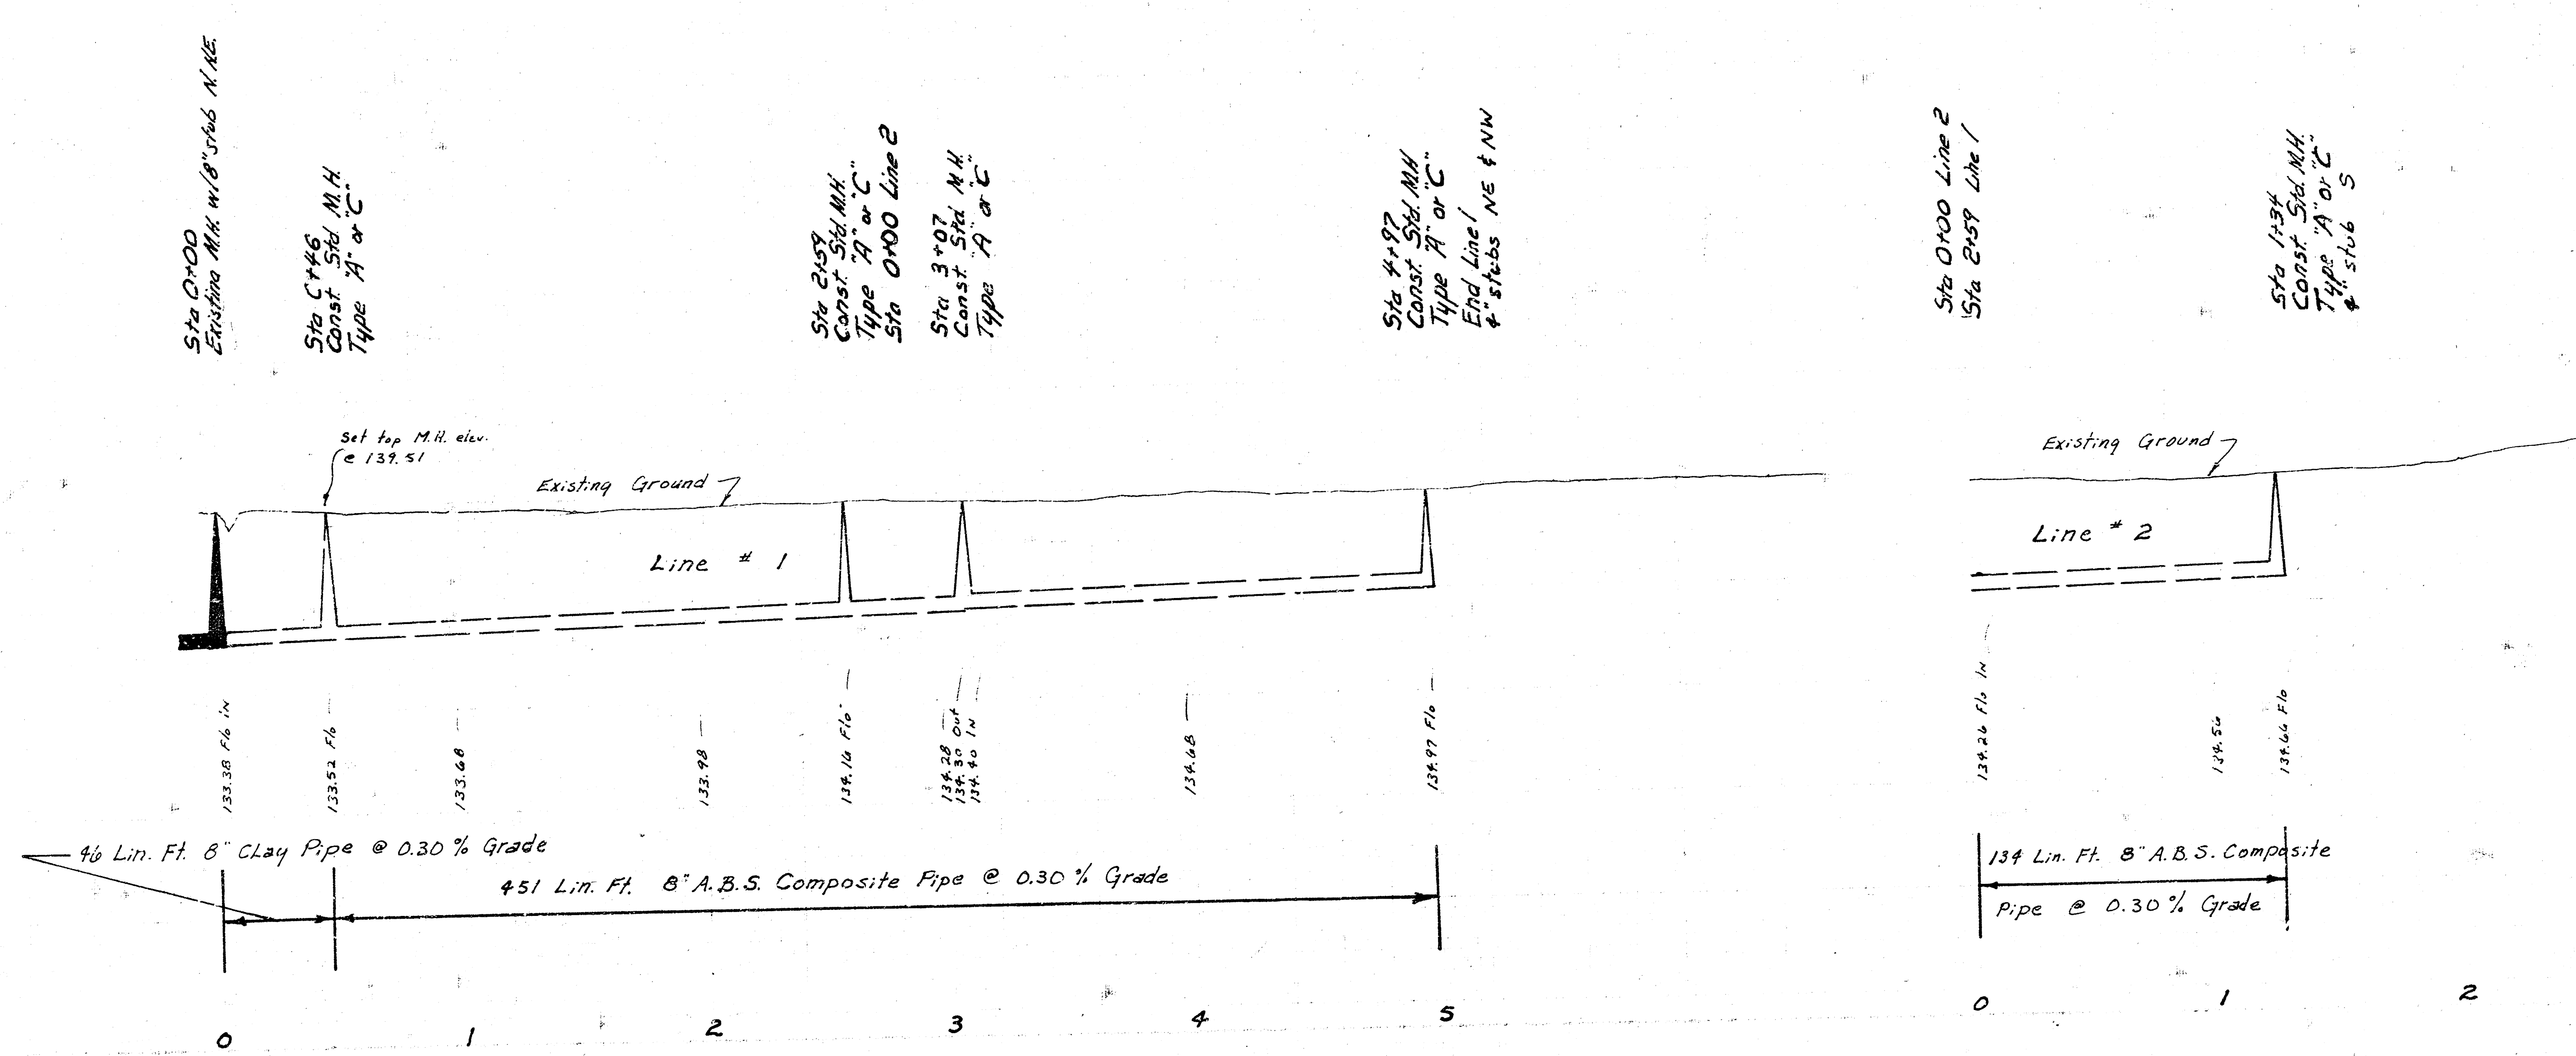

B.M. 141.10 City Standard Disc, 52' So. & 32' W. of C.L. of Woodchuck & Maple
 B.M. 139.10 R.R. Spike N.E. Side of Light Pole at SW Corner of Floyd St. & University Ave.
 B.M. 140.27 " " E. Side of Light Pole, S.W. Corner of Lot 8 Block 'A' FLOYD BAILEY ADD'N.

NOTE: CONTRACTOR SHALL GIVE PROPERTY OWNERS AFFECTED BY THE CONSTRUCTION OF THIS PROJECT A MINIMUM OF 24 HOURS ADVANCE NOTICE PRIOR TO THE START OF CONSTRUCTION.

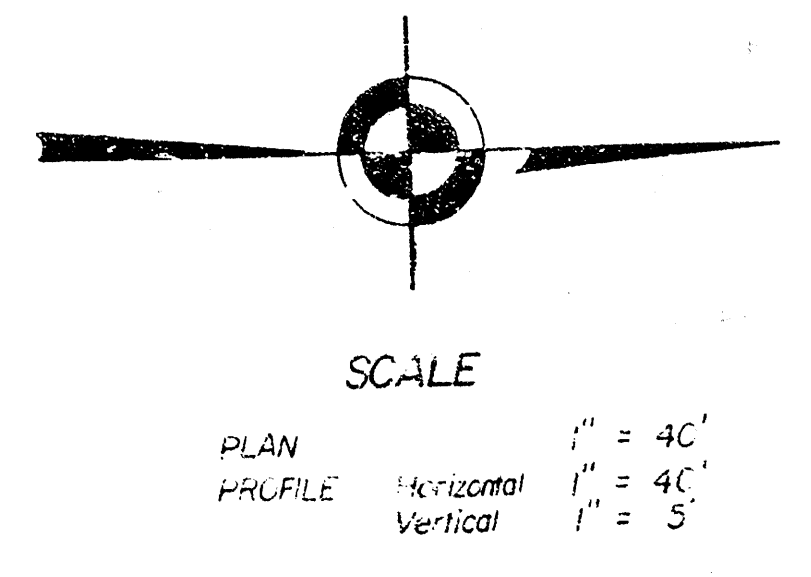

As built 7-22-77
 LAT. 23 MAIN 4 S.W.1.
 BLOCK "A" FLOYD BAILEY ADDITION
CITY OF WICHITA, KANSAS
 R.W. LINN CITY ENGINEER
 DATE 7-22-77 PROJ. NO. DBKL 576C17

14 5 1 2